


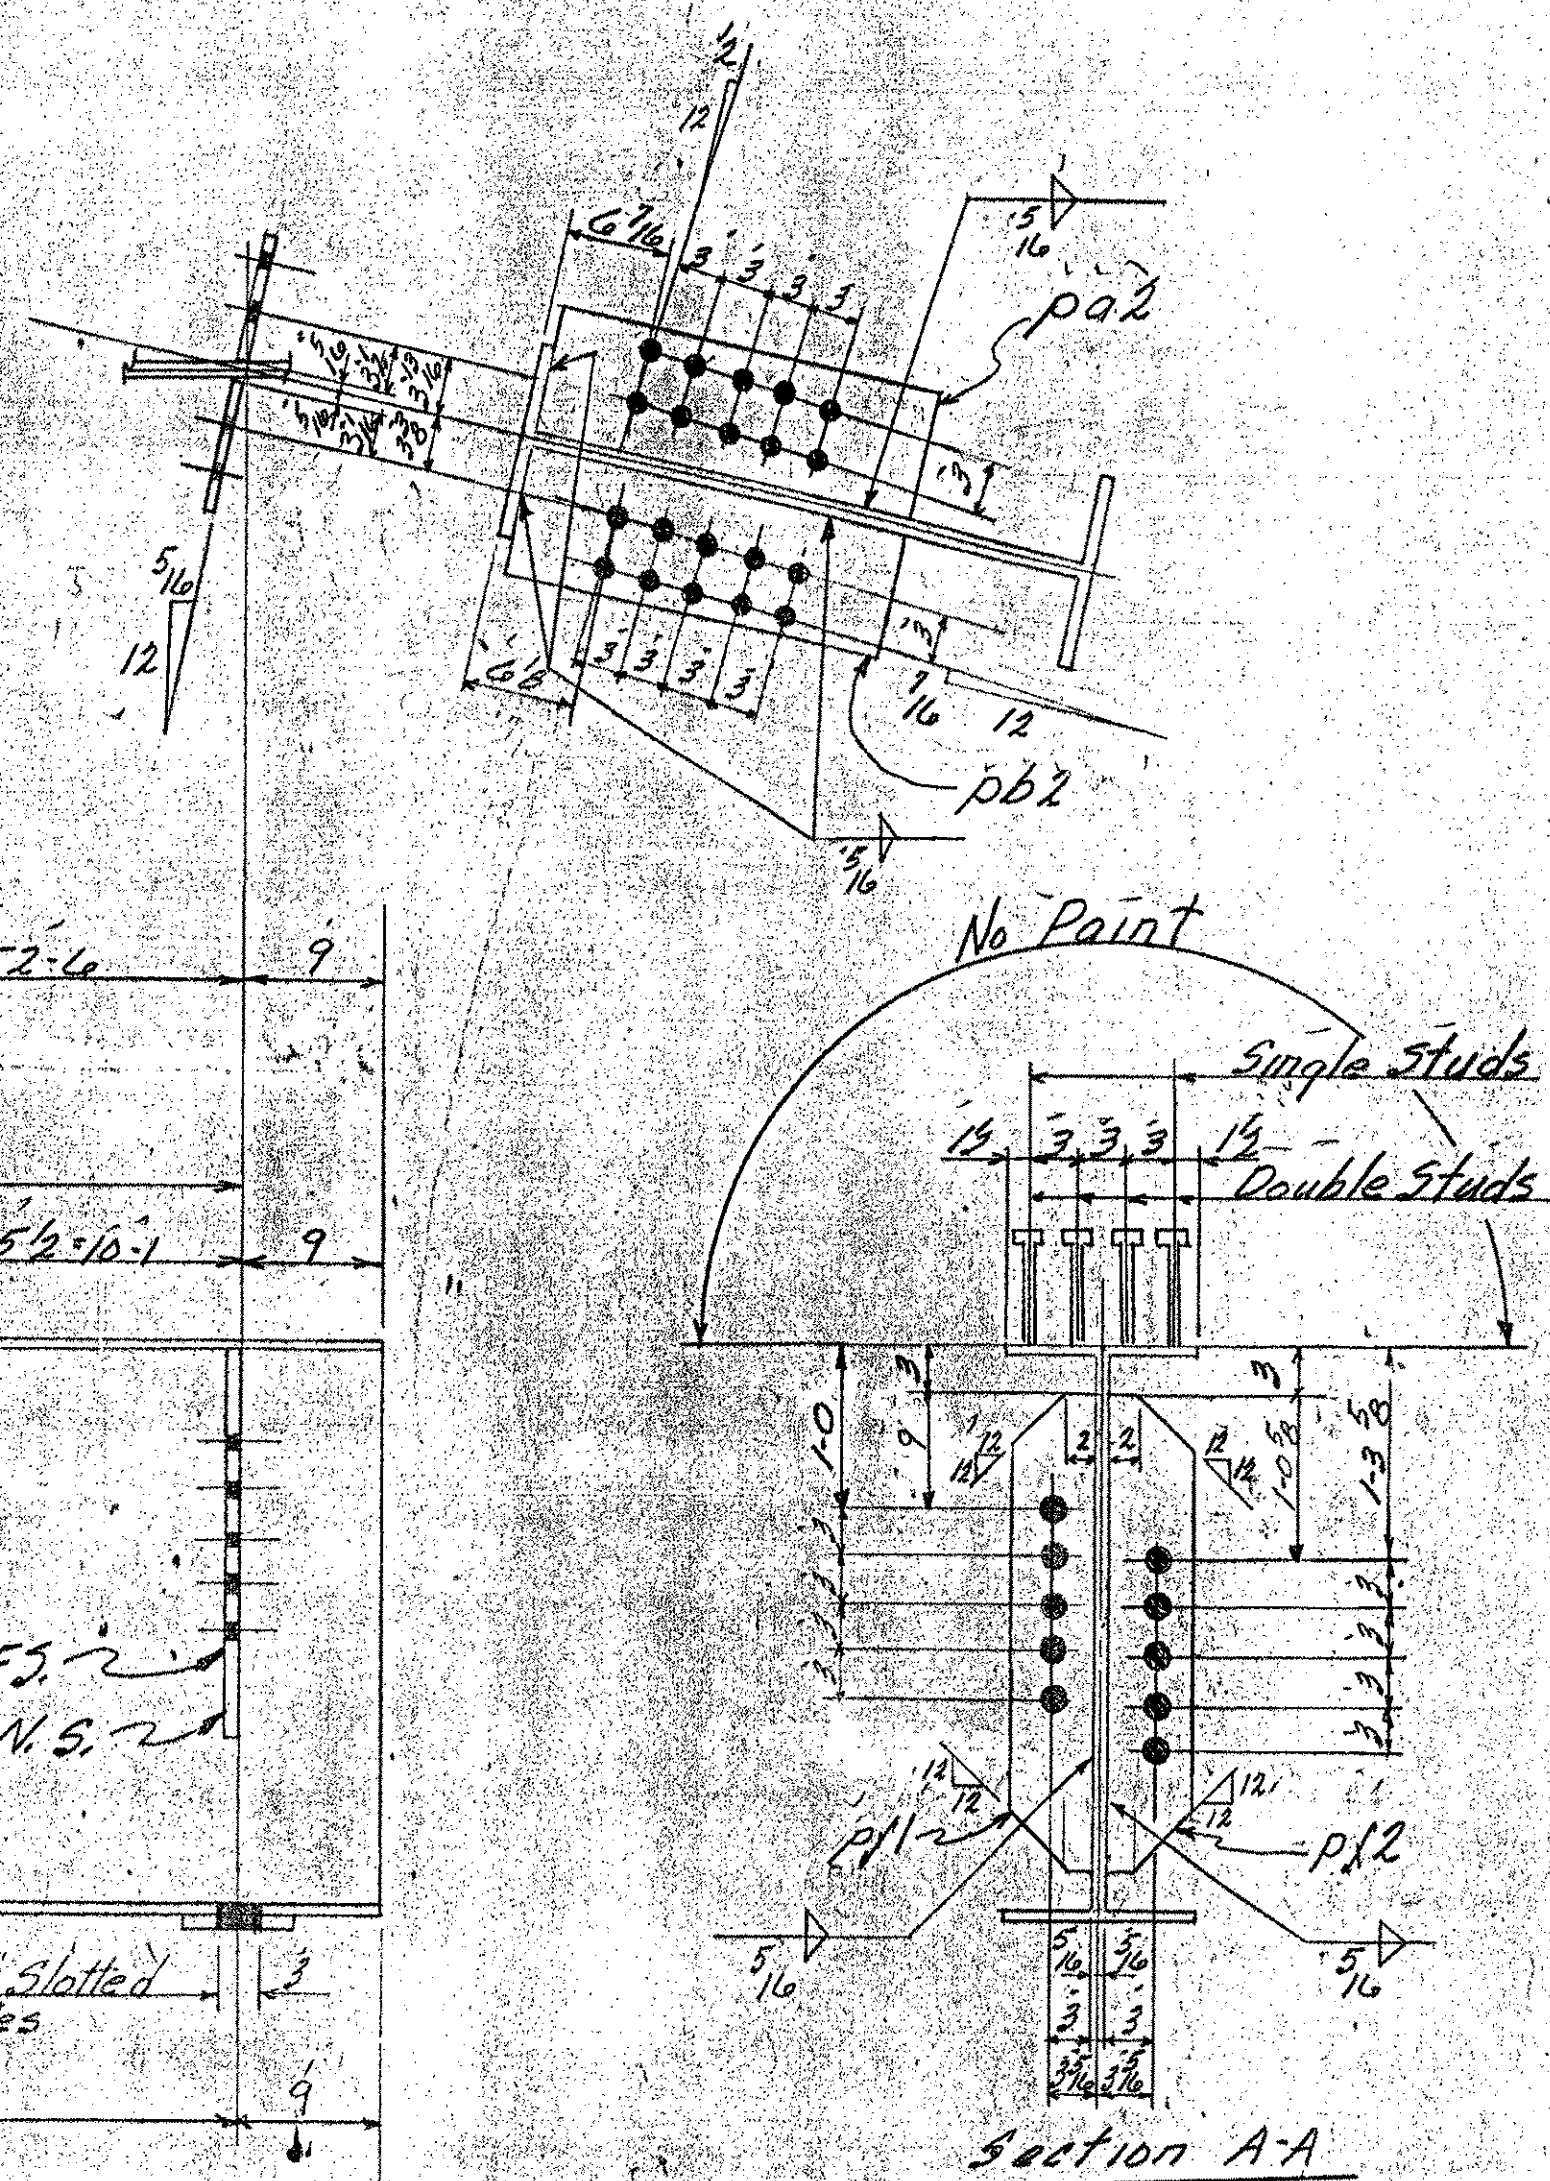

BRIDGE SHEET BR466
REFERENCE SHEET 12 OF 37
SHEET 218 OF 370

[illegible]

JOB NO.		SHEET NO.		
BILL OF MATERIAL				
(17)				
NO. PIECES	MARK	DESCRIPTION	LENGTH FT. IN.	WEIGHT
		Beam		
1	AB2	3Lx W 135	53 3	ord BB66B2 7189
1	pal	Bar 3x 3	27 1	ord BB6679 368
1	pal	Bar 7x 1	1 1	RES @ 20-0
1	pal	do	1 1	
1	pal	Bar 3x 4	1 7	RES 3x 4x 10-0 13
1	pal	Bar 3x 2	2 0	ord 20-0
1	pal	do	2 0	BB6679 54
2	pal	Bar 5x 1/2	2 6	RES @ 20-0 85
2	pal	do	2 6	
		2x Weld	2 4	2 1/2
		2x Weld	2 4	3 1/2
				7784
		Cont. 46-1184-226		
366		3/4" Shear Studs	0 7	STK 368
				8162

VERMONT STRUCTURAL STEEL CORPORATION BURLINGTON, VT.				PROJECT NO. 107-3(35) 2	
DATE		PROJECT	PRINT RECORD		
DRAWN BY	LC 11-8-66	LOCATION	I-89 Over Approach Road Georgia Carfax Fairfield St. Hills		
OK'D BY	RLM 11-8-66	CUSTOMER	Lane Constr. Co.		
HOLES		ARCHITECT	NO.	APP.	DATE
1/2" (As Noted)		State of VT. Dept. of High.	2	5 HOR	11-24
BOLTS		JOB NO. 66-1184-200 SITE SHEET NO. 2	20	SLUG	12-5
PAINT		66-1184-220 Shear Studs	2	STATE	12-8
1/2" (As Noted)			2	LANE	12-28