
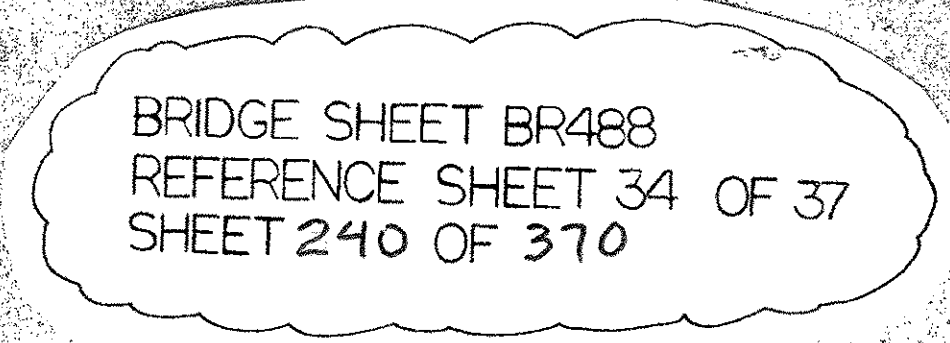
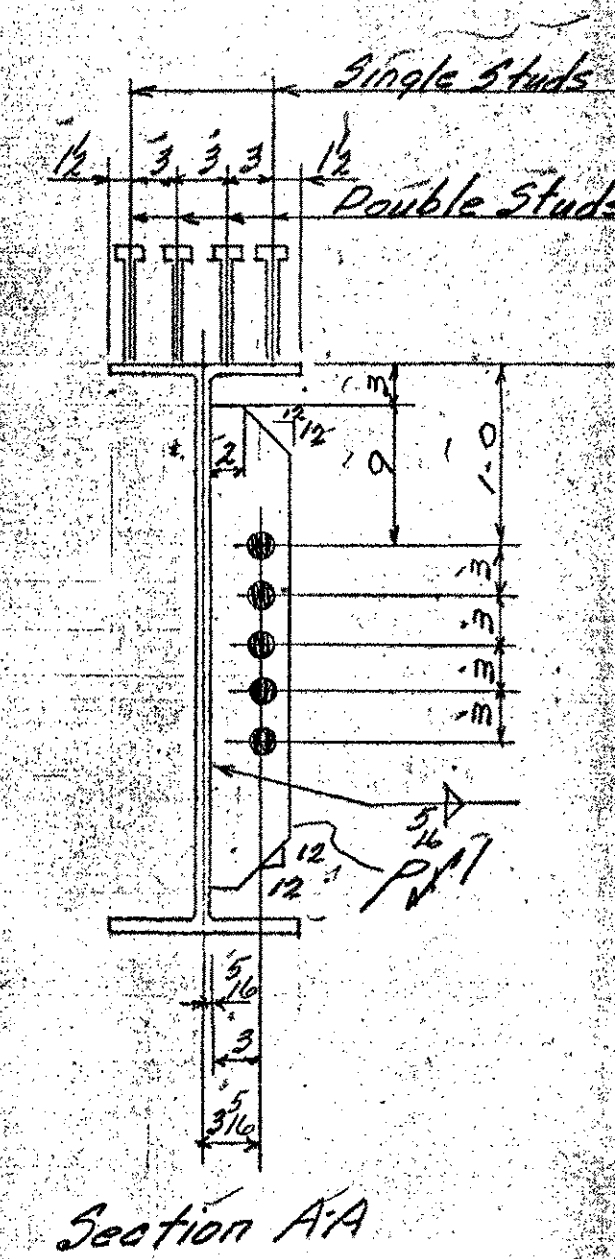


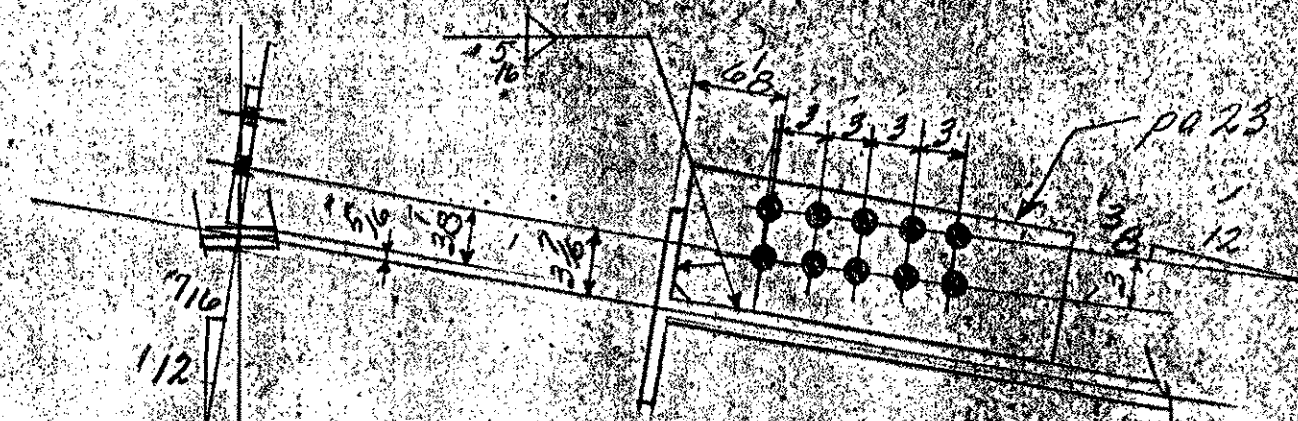

JOB NO.		SHEET NO.	
BILL OF MATERIAL			
<i>ASTM A36</i>			
NO. PIECES	MARK	DESCRIPTION	WEIGHT
		LENGTH FT. IN.	
		<i>Beam</i>	
1 NBG		26 WF 150	68 lb
1	psl	Bar 7x1	1 1
1	psl	do	1 1
2	psl	Bar 5x2	2 6
2	psl	Bar 5x2	2 0
1	psl	12 10x3q	41 3
		<i>2" Weld</i>	2 4
		<i>5/8" Weld</i>	103 6
			2 ✓
			37 ✓ 26
			11,533 ✓
			11,522
470		Cont 667 HBA-226 3/4" Shear Studs	0 7 STK
			472
			472 ✓
			12,005 ✓

VERMONT STRUCTURAL STEEL CORPORATION BURLINGTON, VT.			Proj. No. 189-2135-72	
			PRINT RECORD	
	DATE		NO.	FOR
DRAWN BY	L.E. 11-21-66	PROJECT	1	A PP 11-29
CHECKED BY	R.E.M. 11-29-66	LOCATION	2	SHOP 11-29
		CUSTOMER	3	SLIP 12-5
			2	STATE 12-8
			2	LATE 12-28