

PROPERTY LINE FENCE W/STEEL
POSTS, MOD. ITEM 583-II
S.B. 3380+00-3396+00 Lt.
N.B. 3380+00-3396+00 Rt.

*THREE CABLE GUARD RAIL w/LIGHT
STEEL POSTS. ITEM 538
NB 3380+00 Lt. - 3383+54 Lt.
NB 3394+68 Lt. - 3396+00 Lt.
SB 3380+00 Lt. - 3382+43 Lt.
SB 3394+28 Lt. - 3396+00 Lt.
TREATED TIMBER CURB, ITEM 558
*BITUMINOUS CONCRETE CURB
ITEM 555 TYPE II
NB 3380+00 Lt. - 3383+54 Lt.
1+08

*JUTE MATTING-ITEM 623
N.B. 3380+00-3387+00 Rt.
S.B. 3380+00-3390+00 Rt.


NOTE: * DENOTES ITEMS TO BE INCLUDED
IN STAGE II CONSTRUCTION.

INDIVIDUAL WATER SOURCES
DUG SPRING S.B.L. 3386+90 - 190' Lt.
FARM POND S.B.L. 3395+15 - 25' Lt.

*STANDARD STEEL BEAM GUARD RAIL
w/STEEL POSTS. ITEM 545-A (26" C/C)
NB 3395+00 - 3396+00 Rt.
SB 3395+40 - 3396+00 Rt.

CONTROL OF ACCESS IS COMPLETE ON THIS SHEET.

APPROX. AERIAL UTILITIES RELOC.
ROUTE BY NET & T CO.

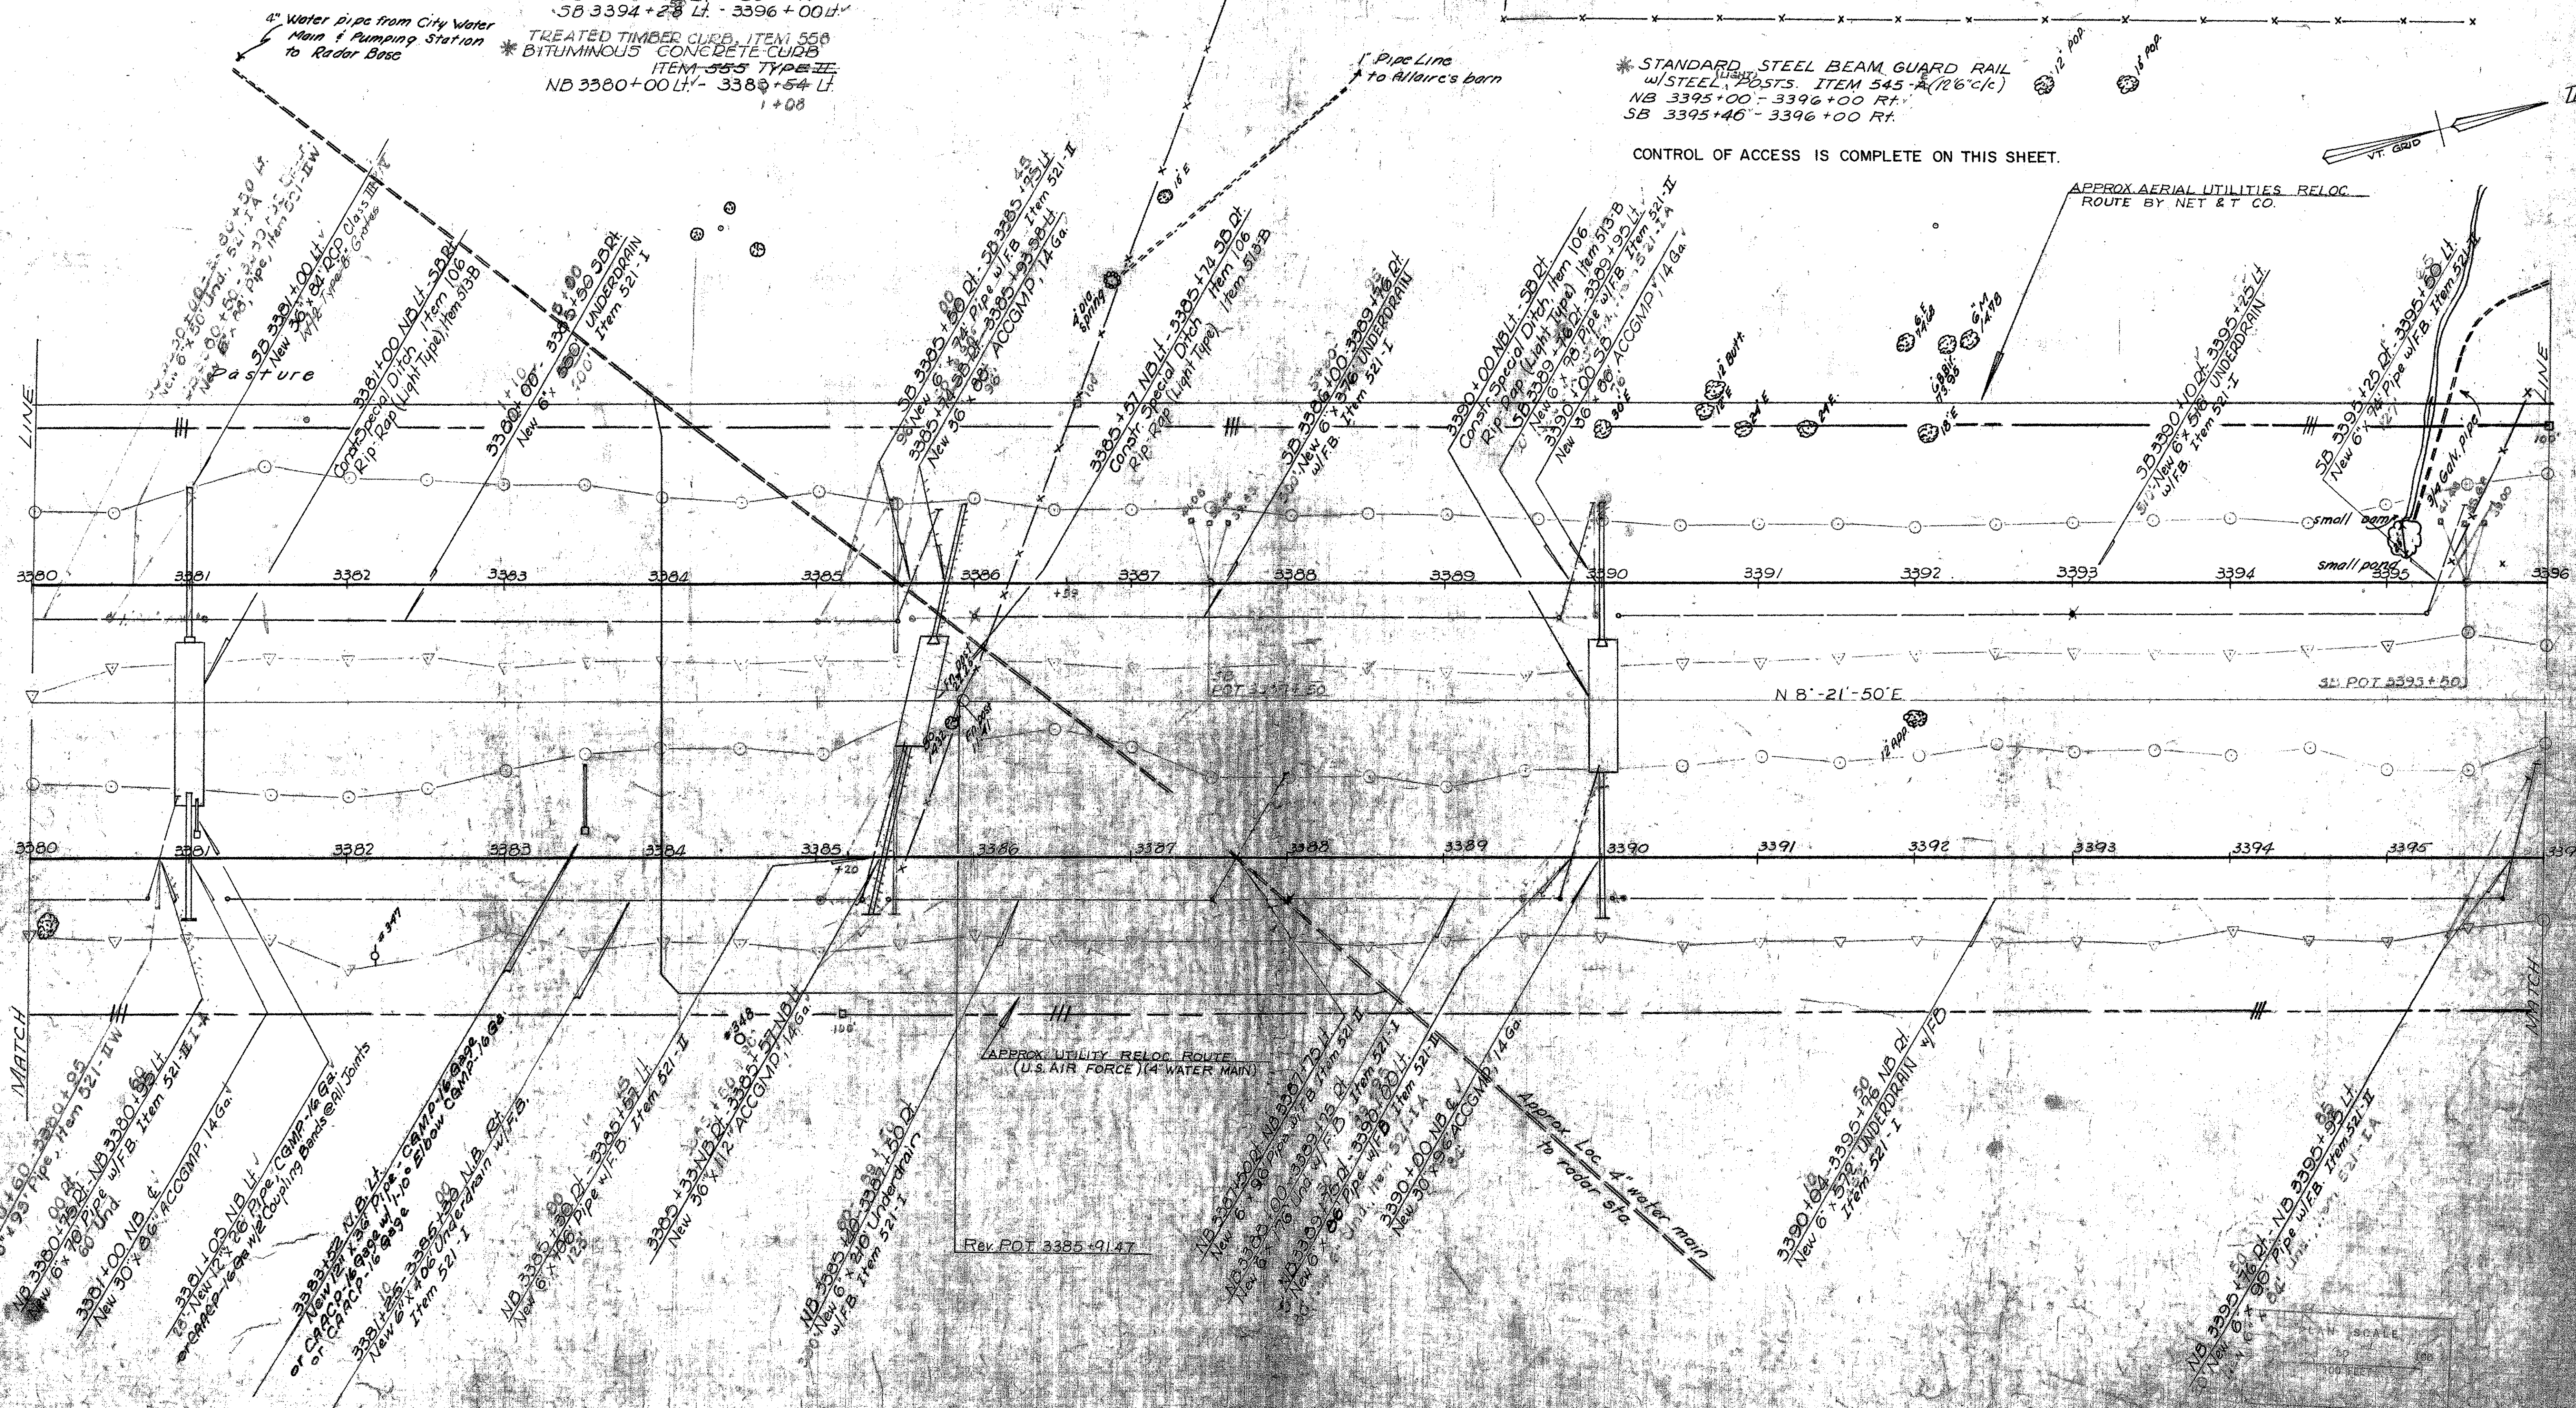

GEORGIA FAIRFAX-FARFIELD-STALBANS

189-3 (4)

Sheet 73 of 73

STA. 3380 = MM 112.90