



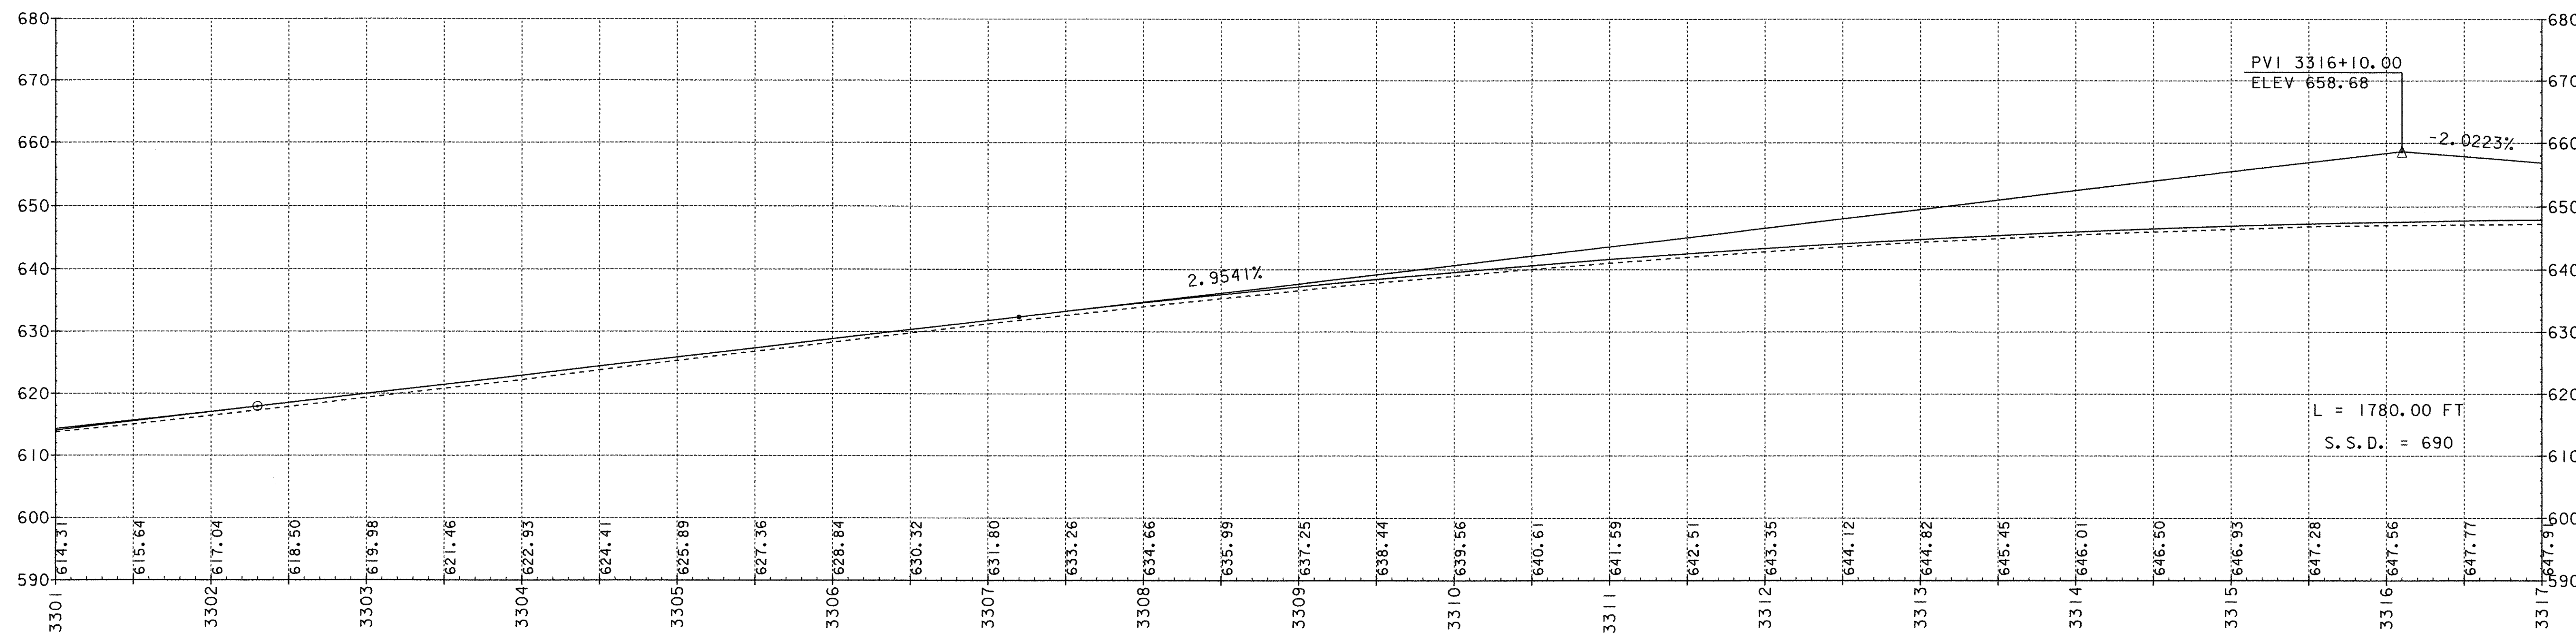


SOUTHBOUND GRADE PROFILE ALONG MEDIAN SIDE (REFER TO TYPICAL SHEET)
STA. 3301+00 - 3317+00

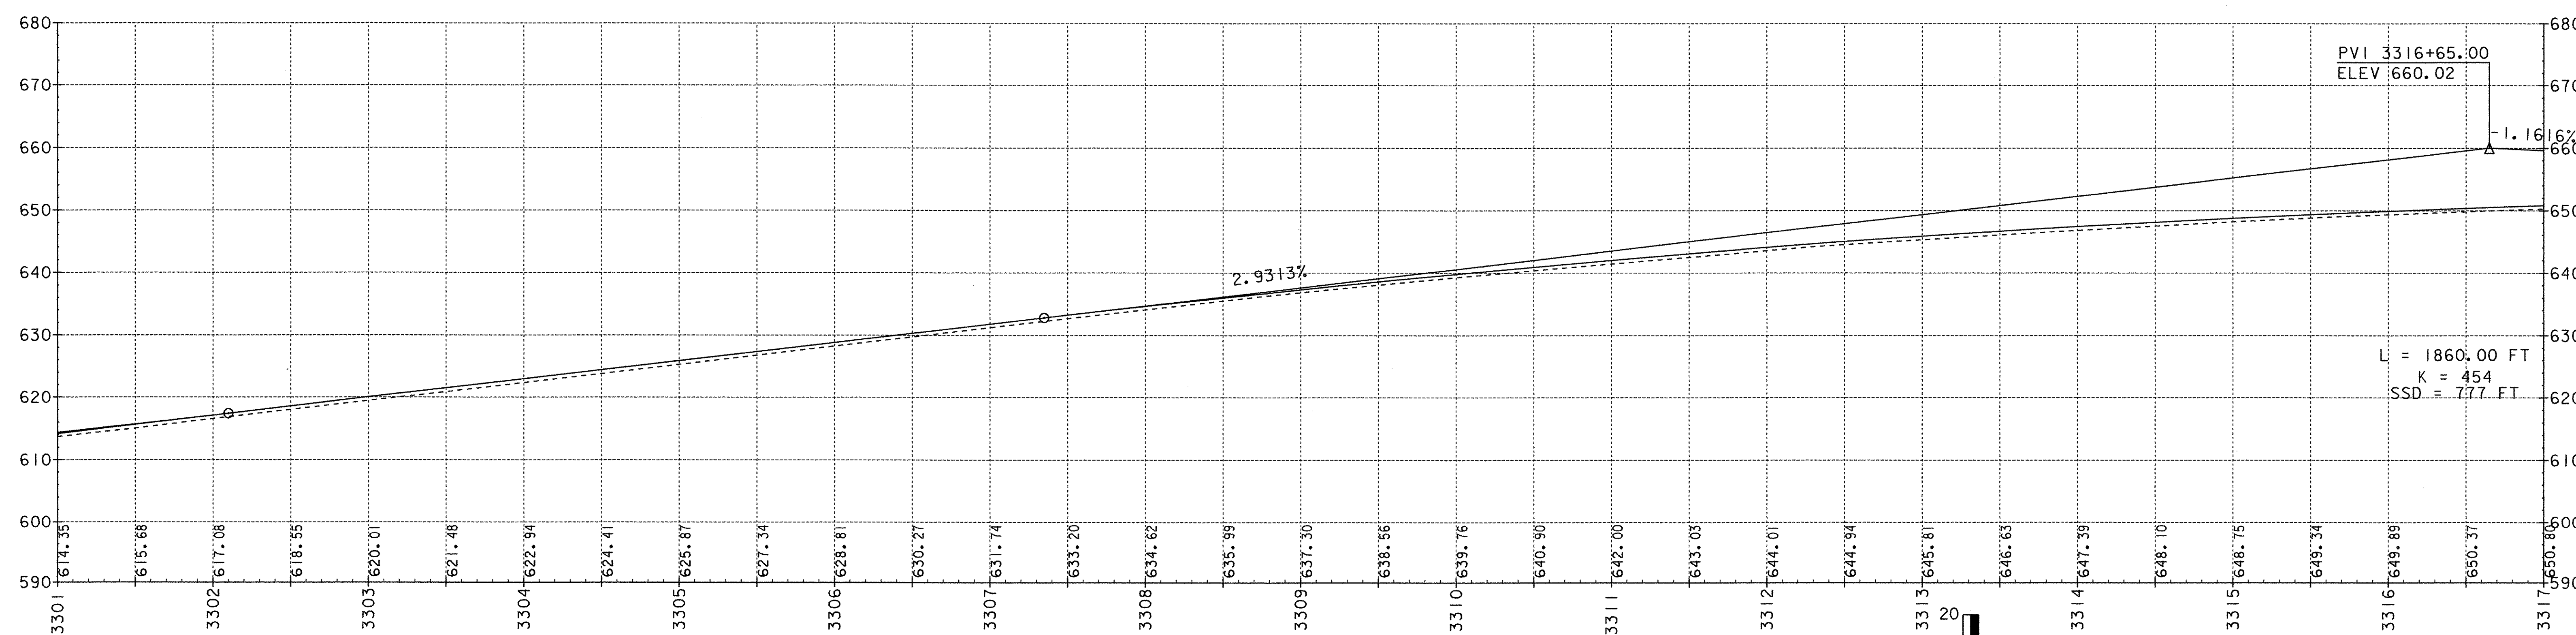

NORTHBOUND GRADE PROFILE ALONG MEDIAN SIDE (REFER TO TYPICAL SHEET)
STA. 3301+00 - 3317+00

DATUM	
VERTICAL	NAVD88
HORIZONTAL	NAD83(92)

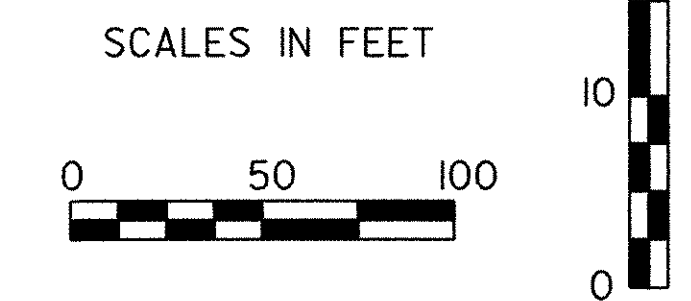

PROJECT: FAIRFAX - FAIRFIELD - ST. ALBANS		PROJECT NO. : IM 089-3(27)	
DESIGN FILE NAME: /87A007B/DESIGN/DA007XSI.DGN			
IPARM FILE NAME: DA007P03		PLOT DATE: 04-OCT-2000	
SURVEYED BY: ORVIS		SURVEY DATE: 6/98	
SQUAD LEADER: DELLA SANTA		DRAWN BY: SQUAD B	
		SHEET: 54 OF 370	