
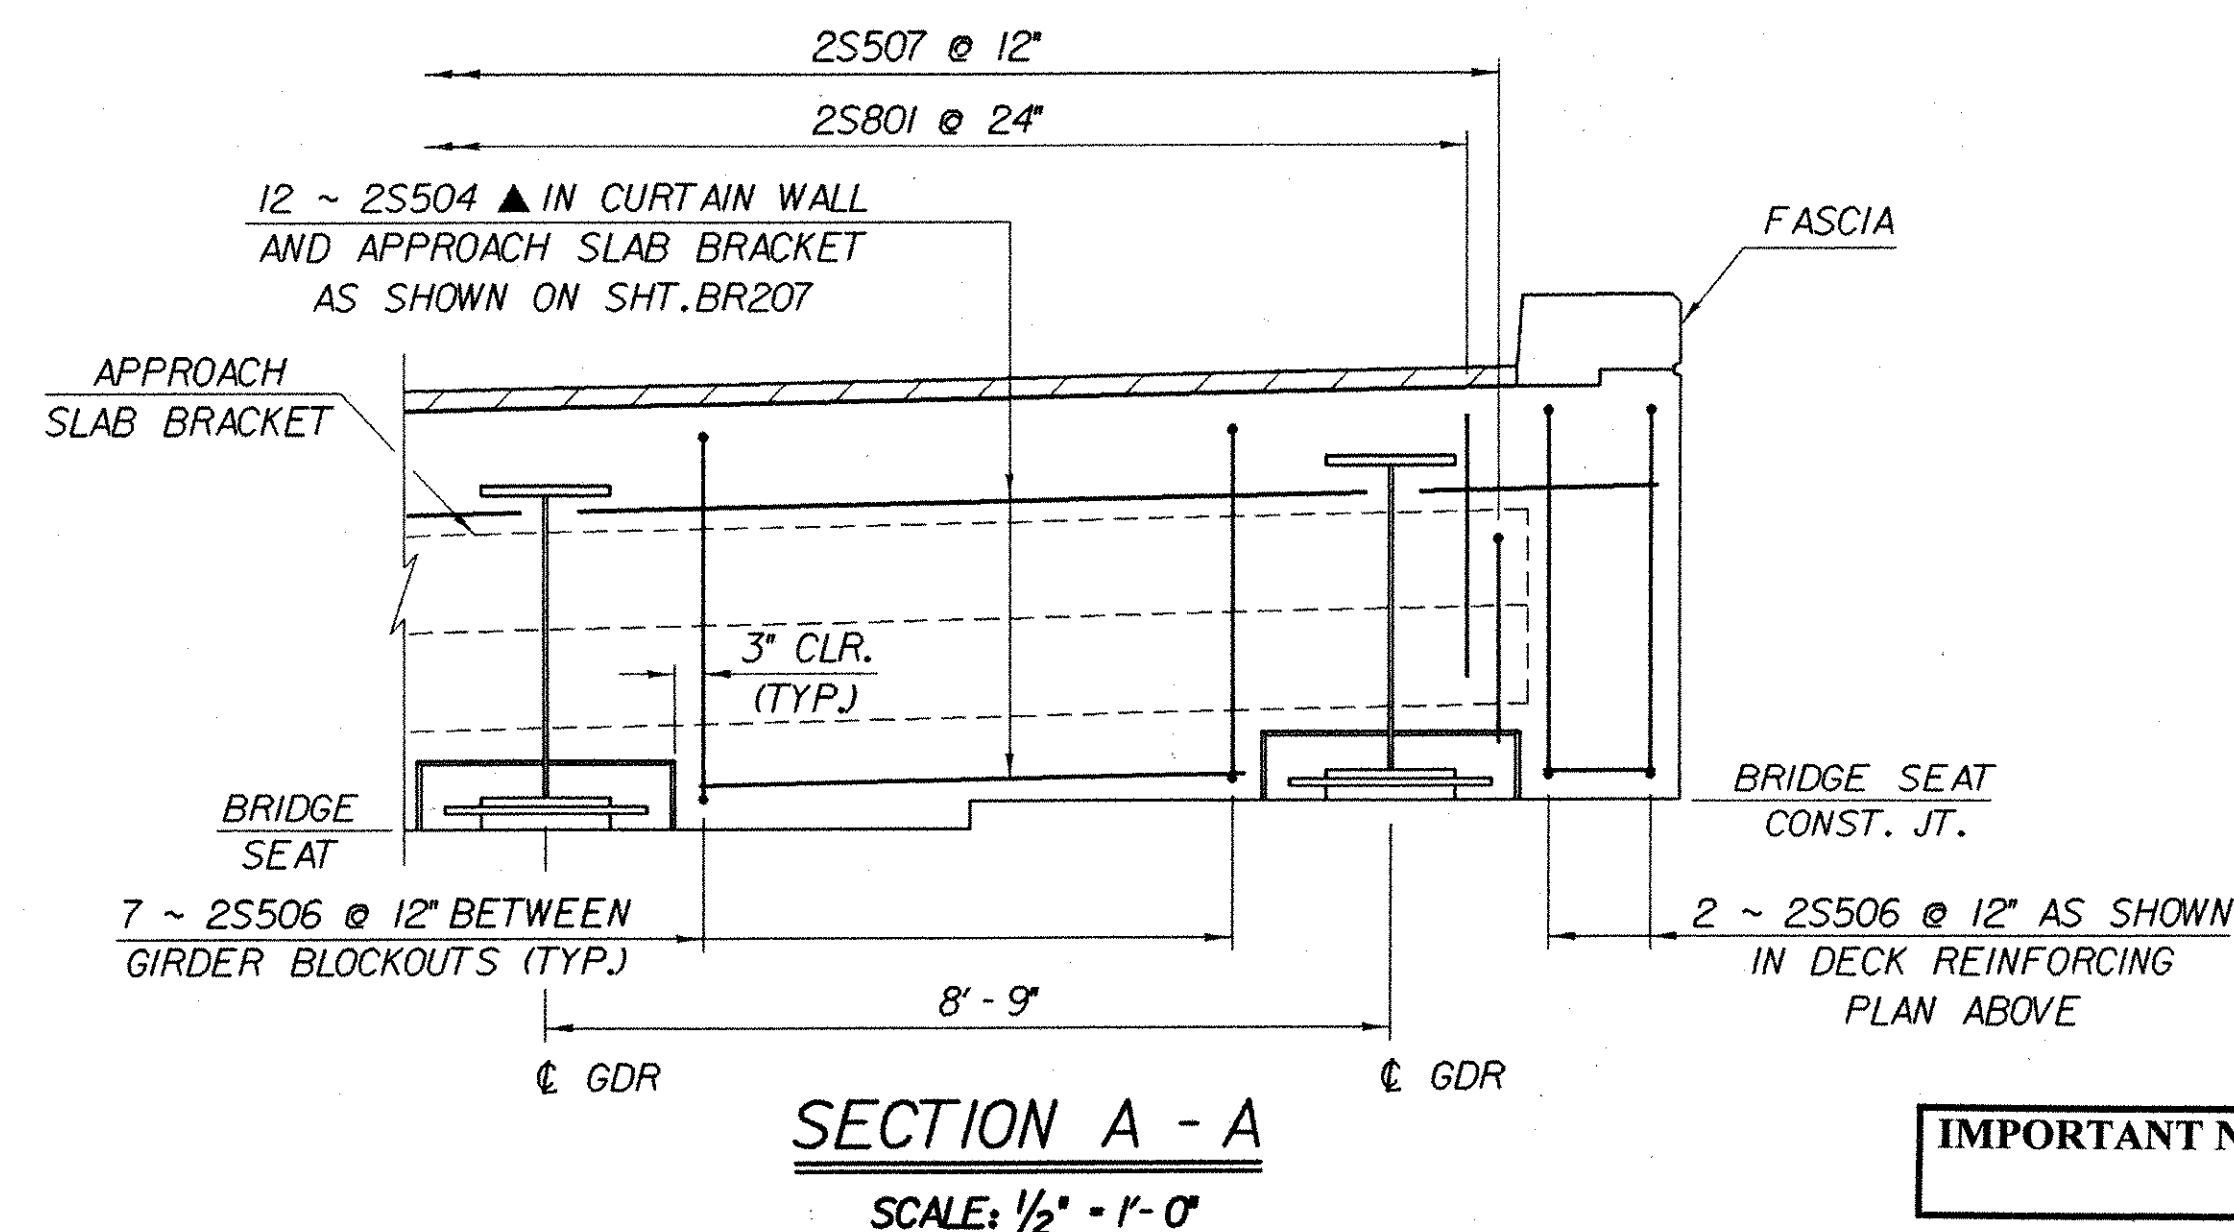
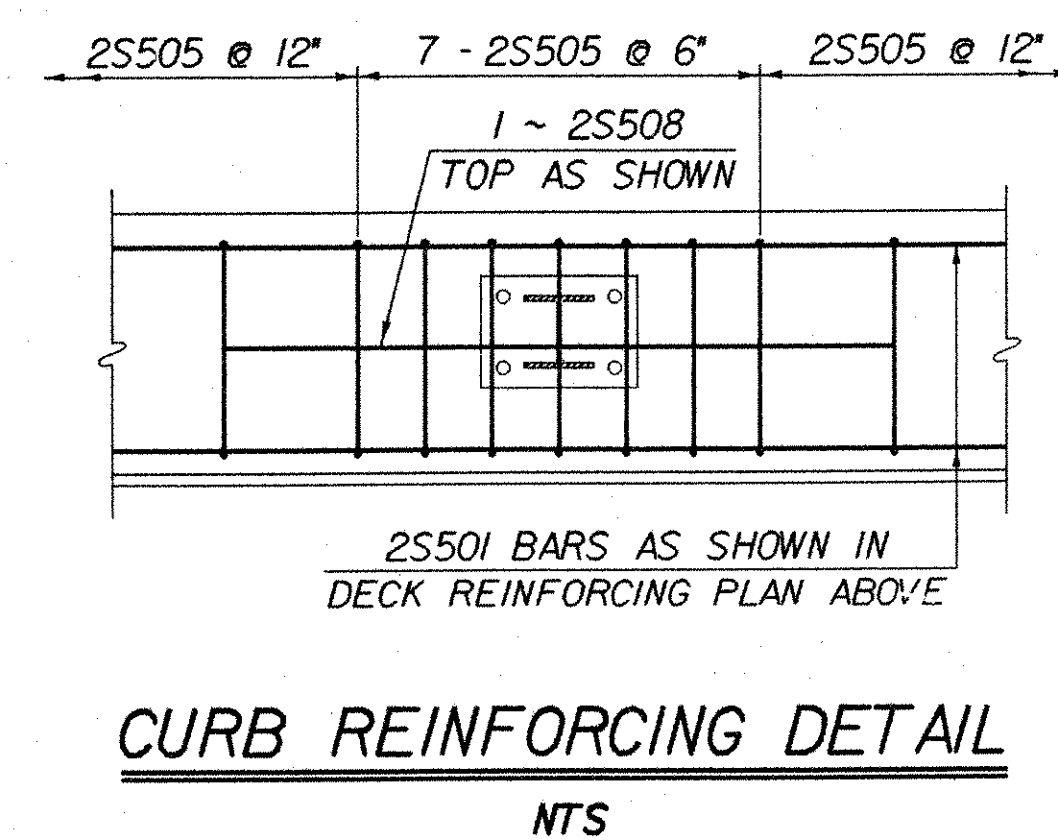


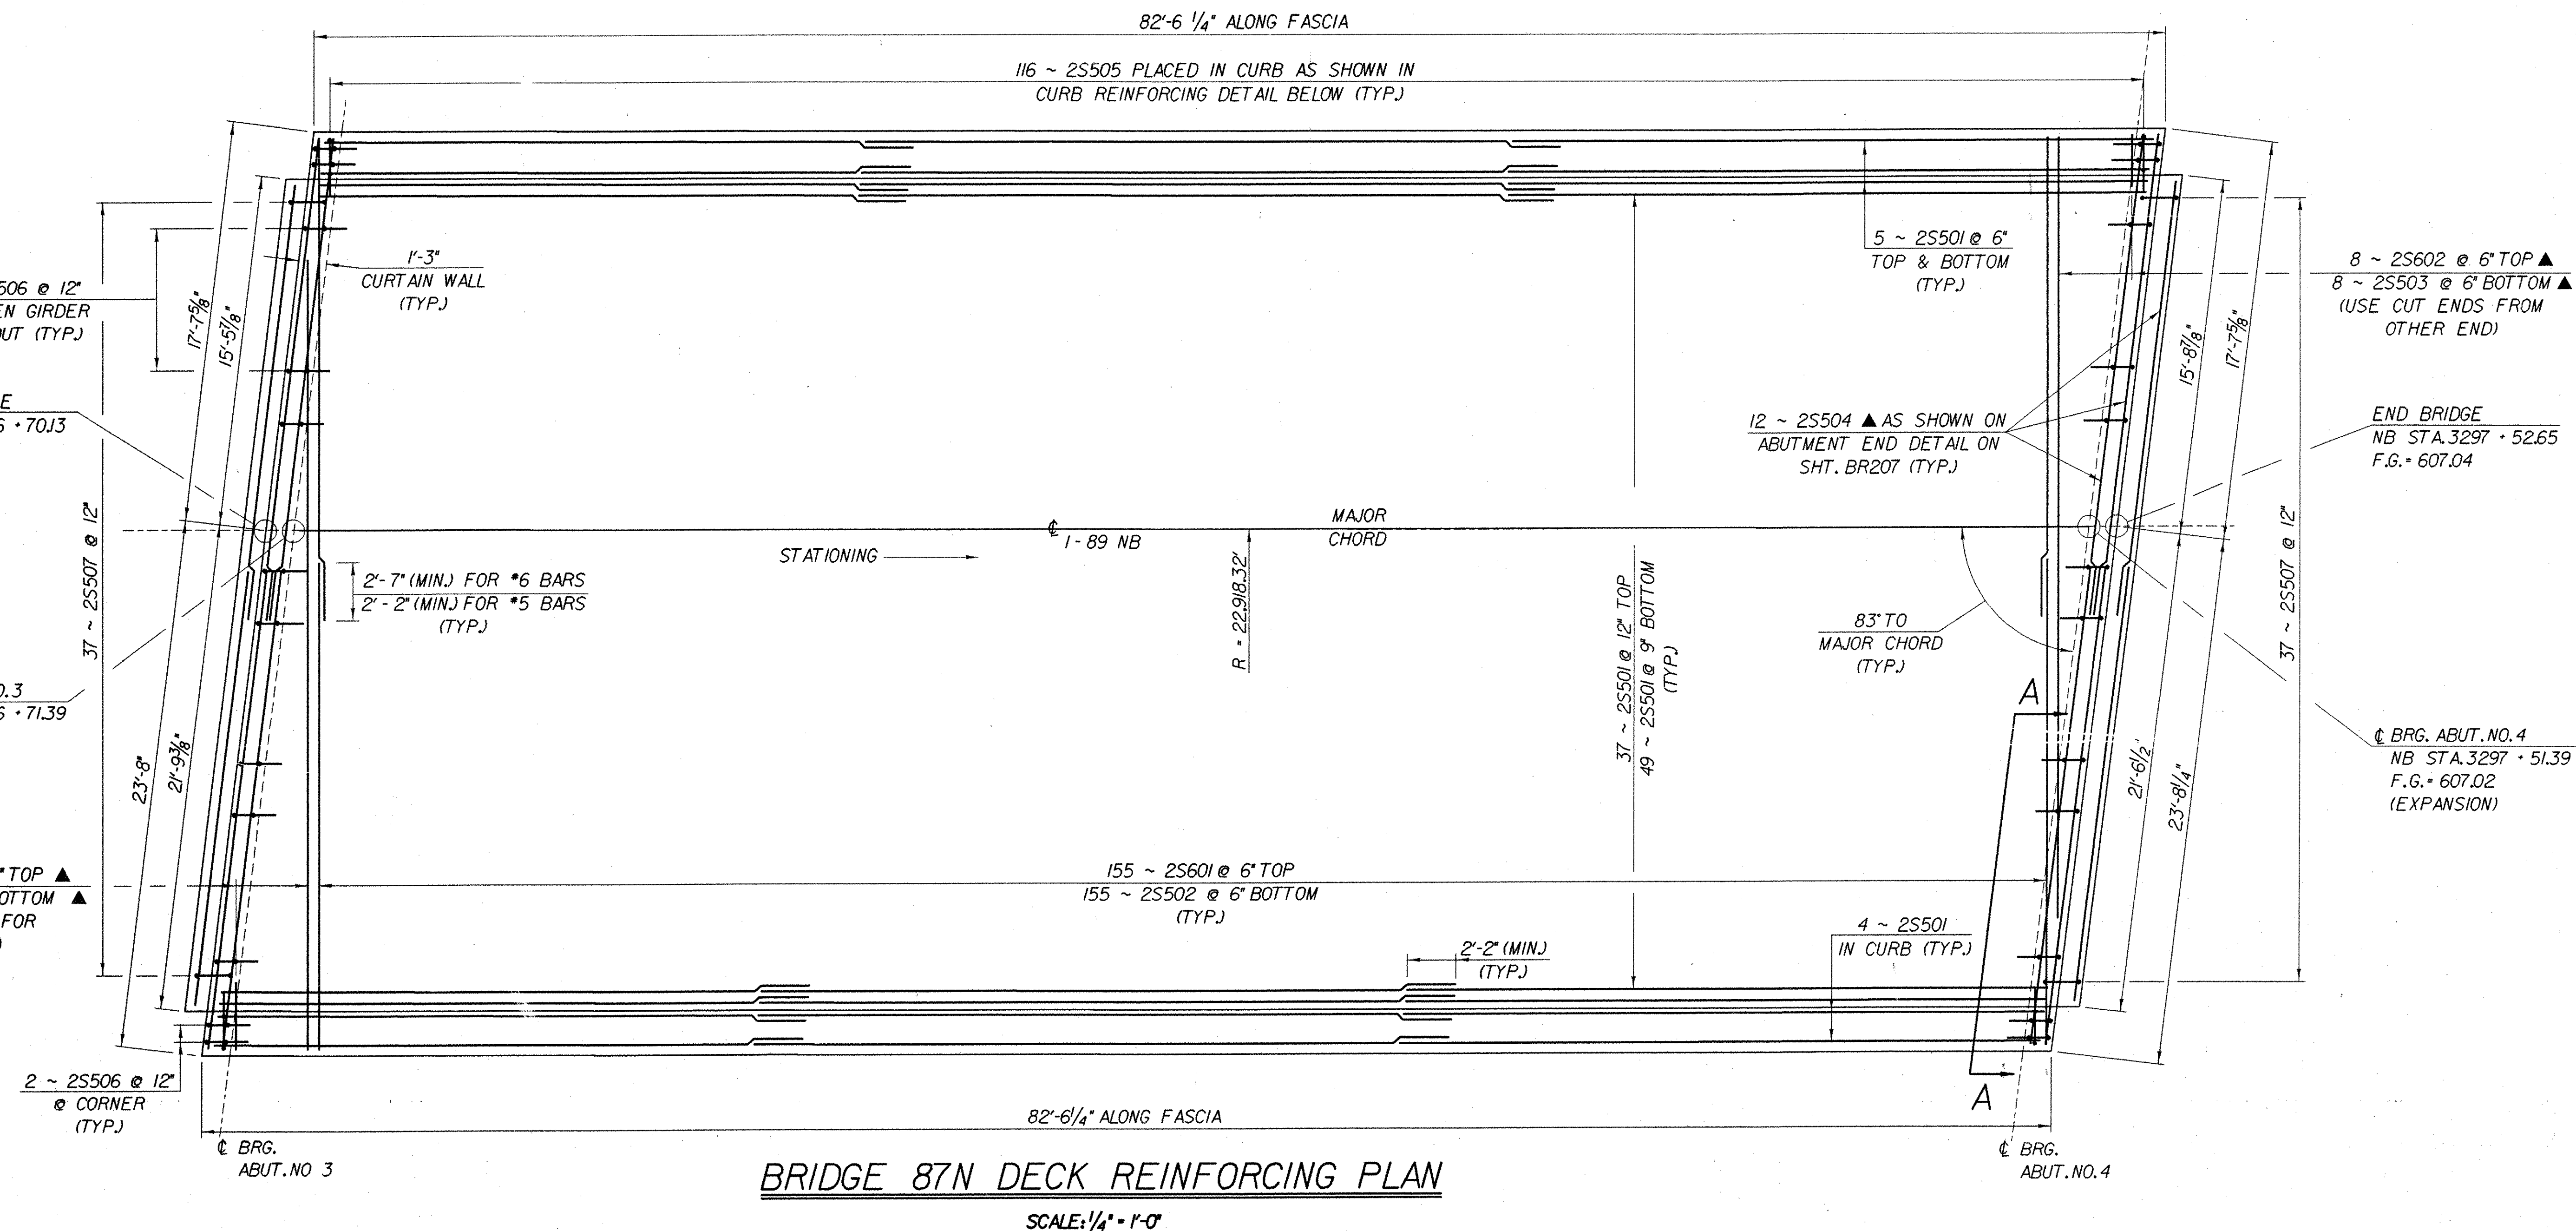

IMPORTANT NOTE: BRIDGE FINISHED GRADES ARE CENTERLINE GRADES.

STATE OF VERMONT AGENCY OF TRANSPORTATION

Town Of FAIRFAX-FAIRFIELD-ST. ALBANS	Bridge No. 87 N
Highway No. 1-89	Log Sta. Surv. Sta.

1-89 NB OVER VT 104

87N DECK REINFORCING PLAN

Designed By M. LOZIER	Drawn By K. CHISHOLM
Checked By G. ROY	Bridge Design Supervisor Date 11/99

PROJECT FAIRFAX-FAIRFIELD-ST. ALBANS	PROJECT NO. 1M 089 - 3 (27)
I.G.C. Info. 96a056/Structures/sa056spl.dgn	sa056spl.dgn

Bridge Sheet No. BR208	Sheet 86 of 370
---------------------------	--------------------

PLOTTED 21-SEP-2000