
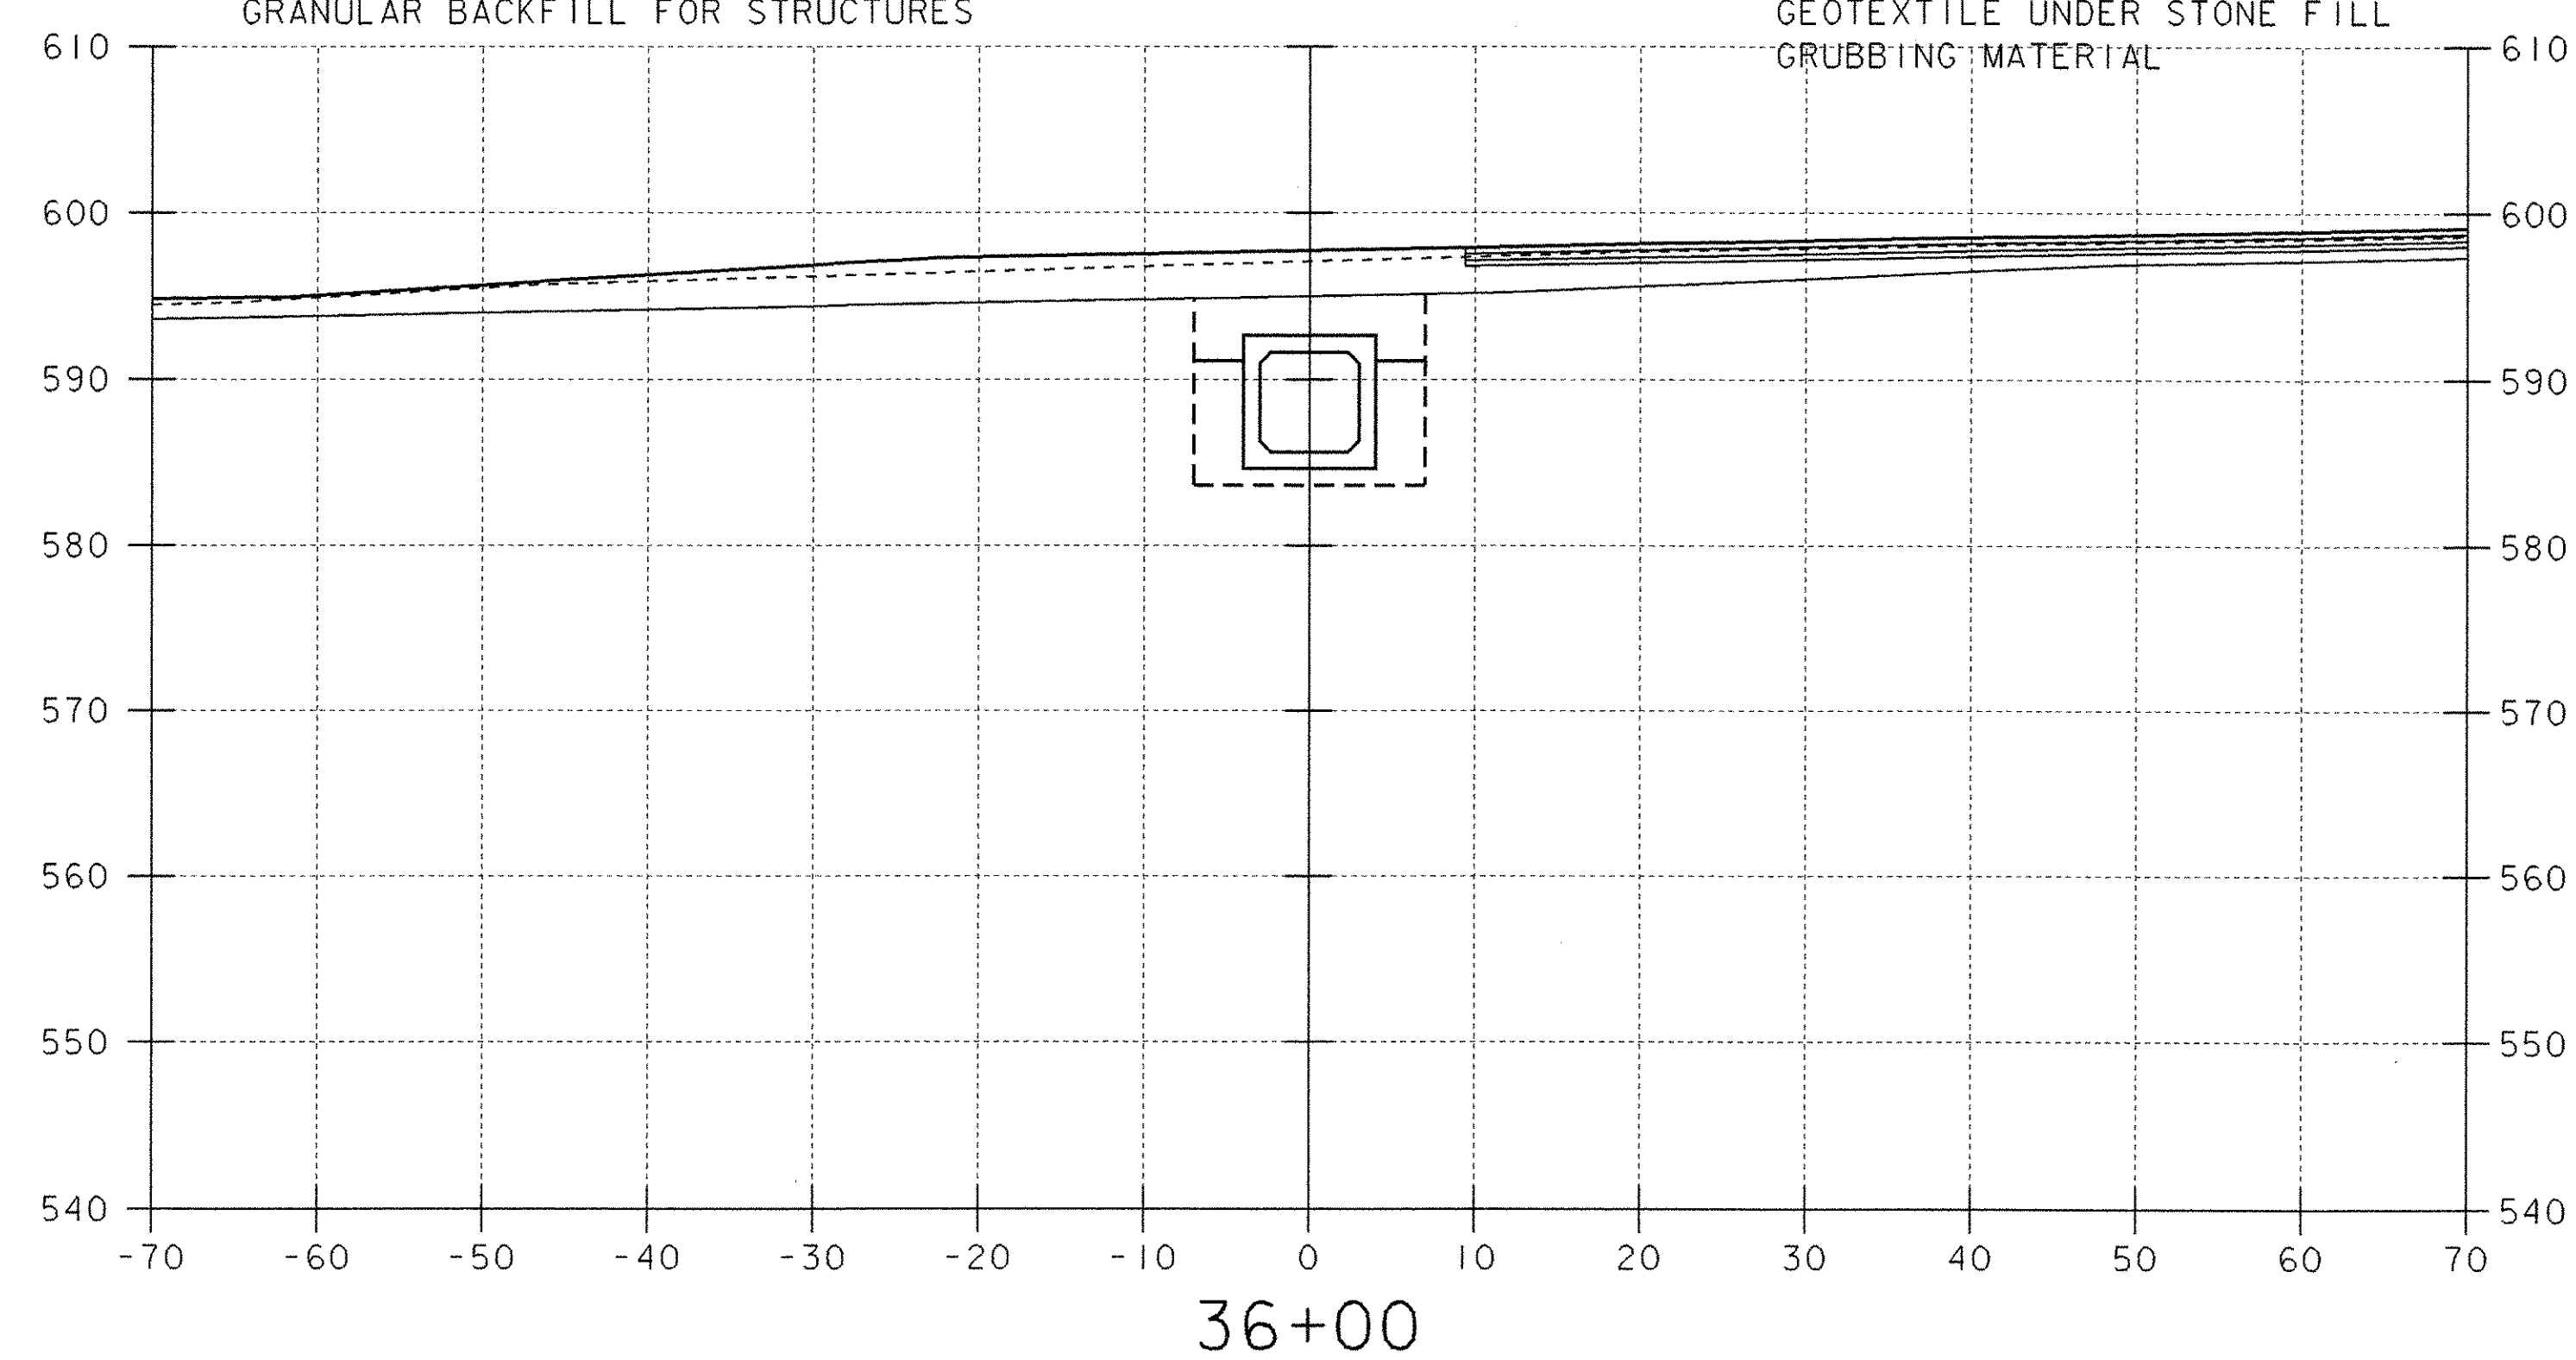
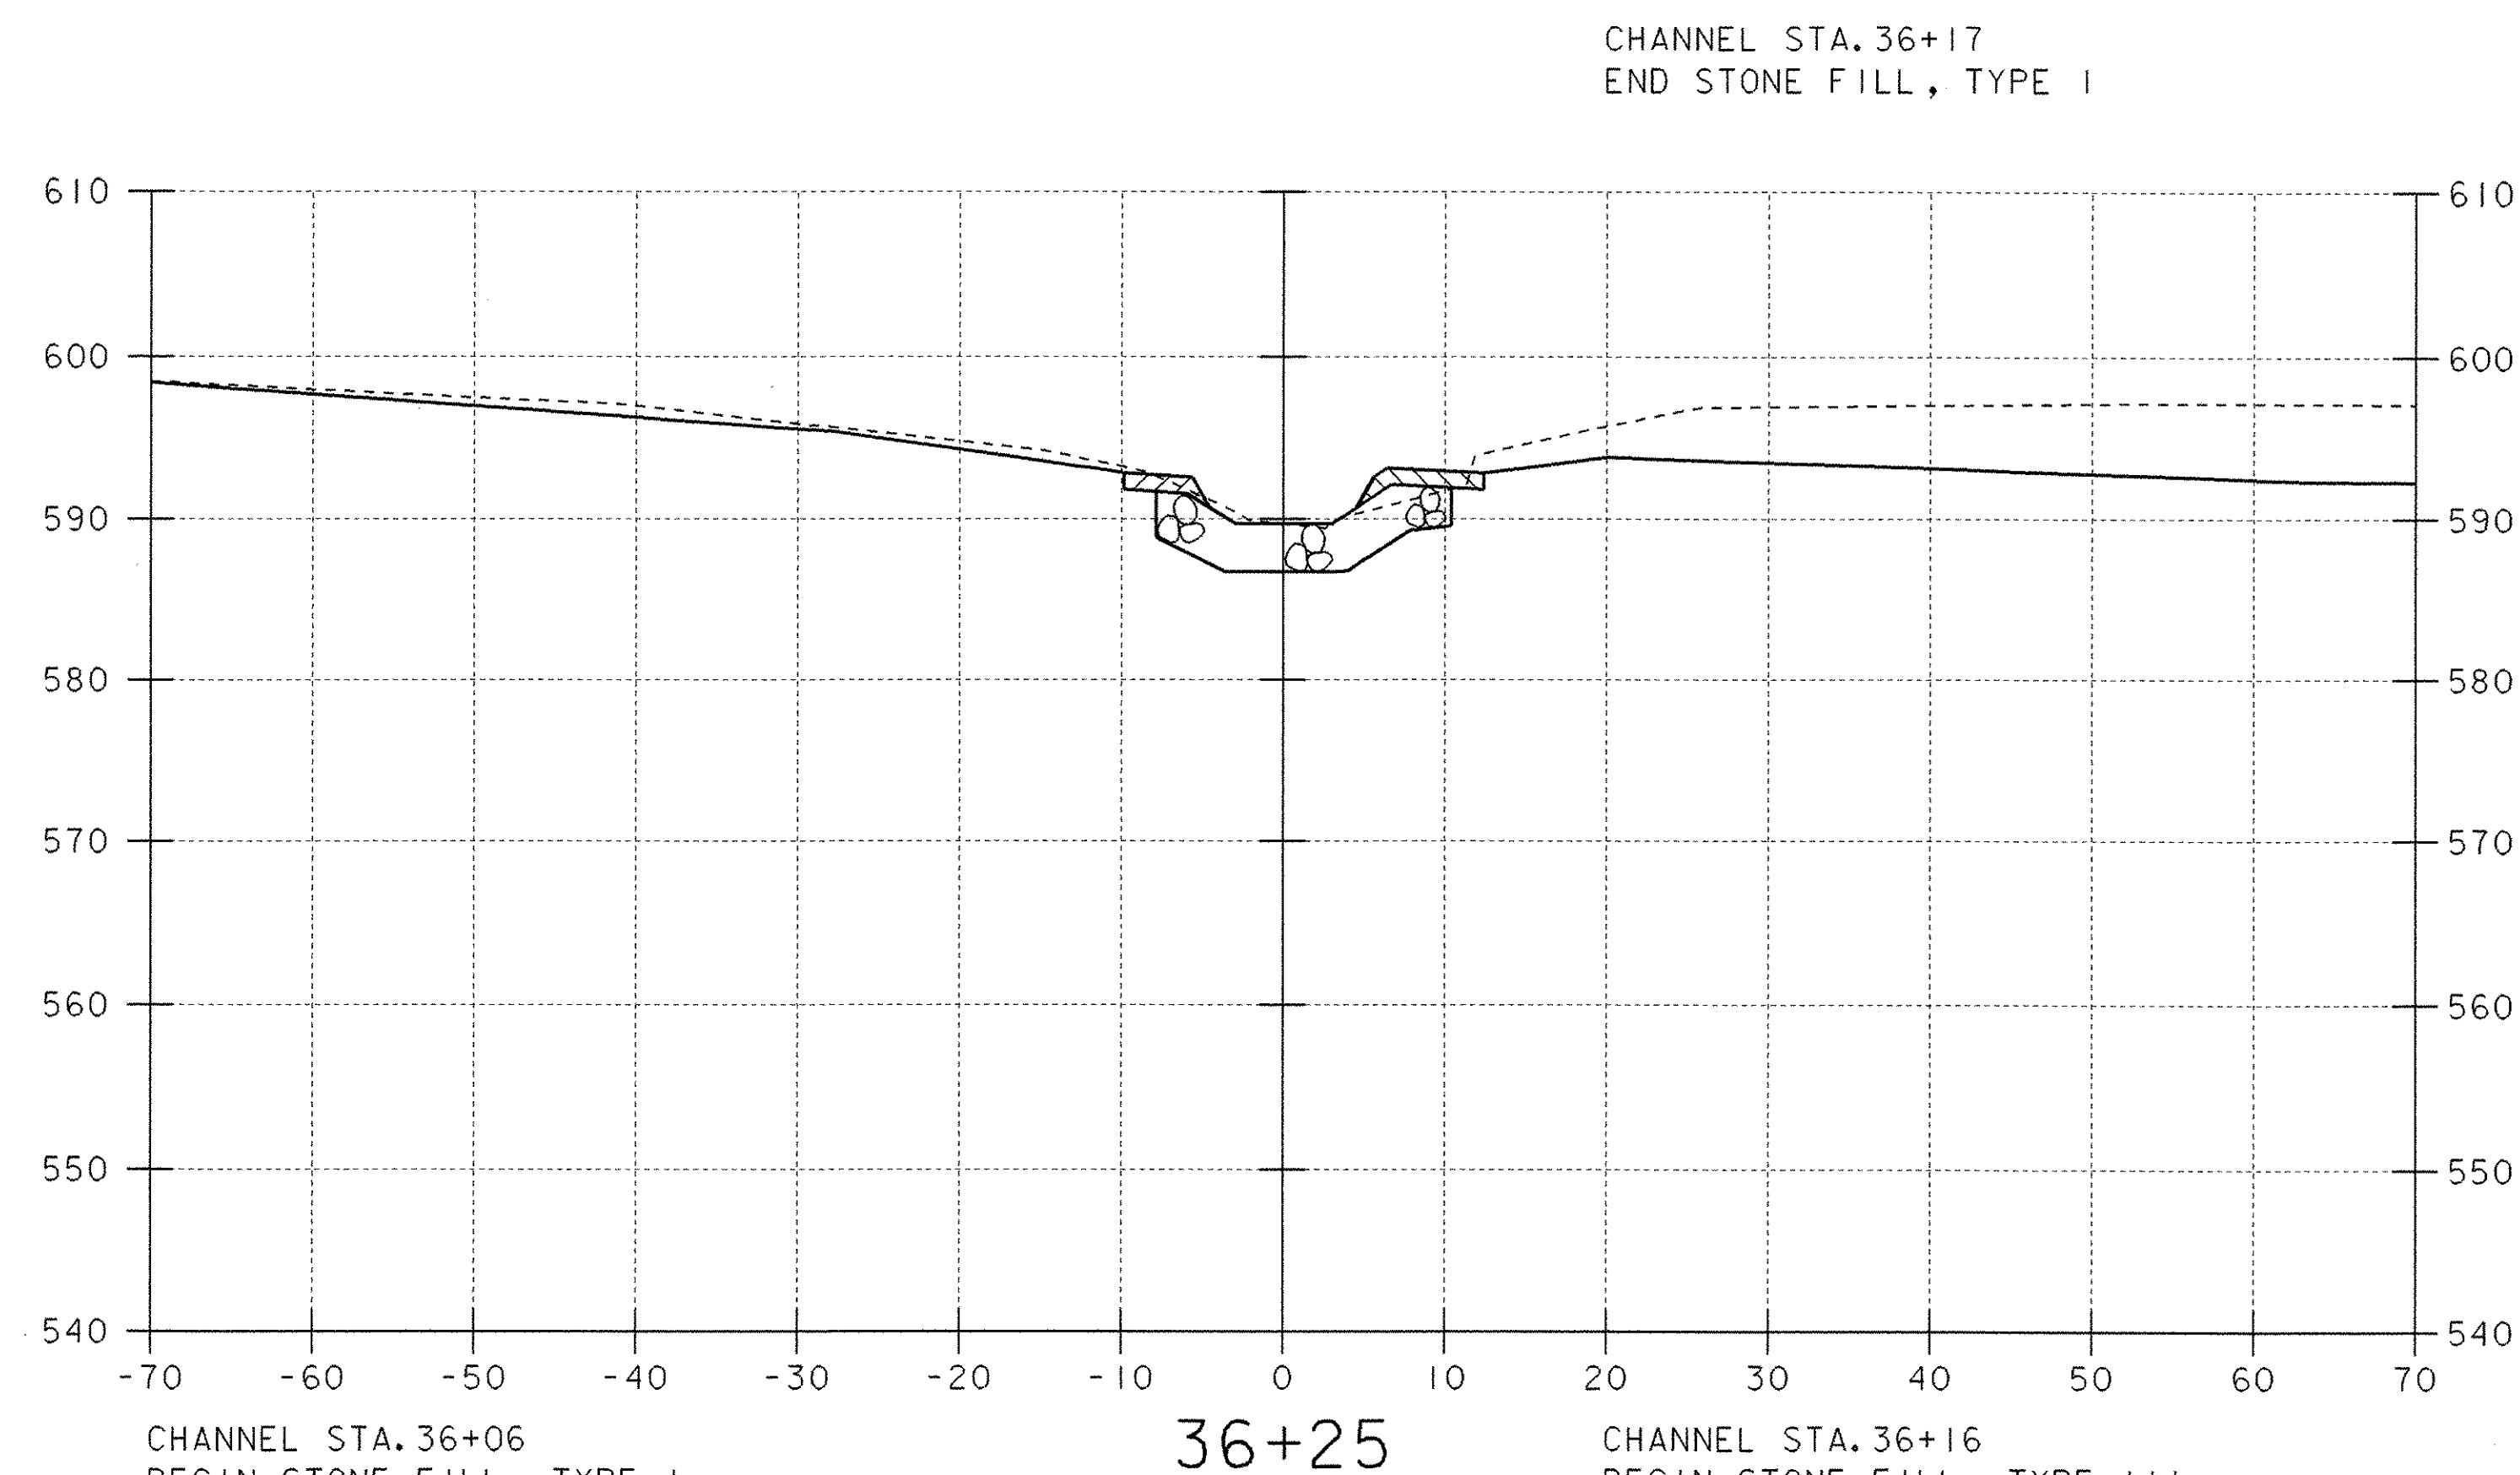
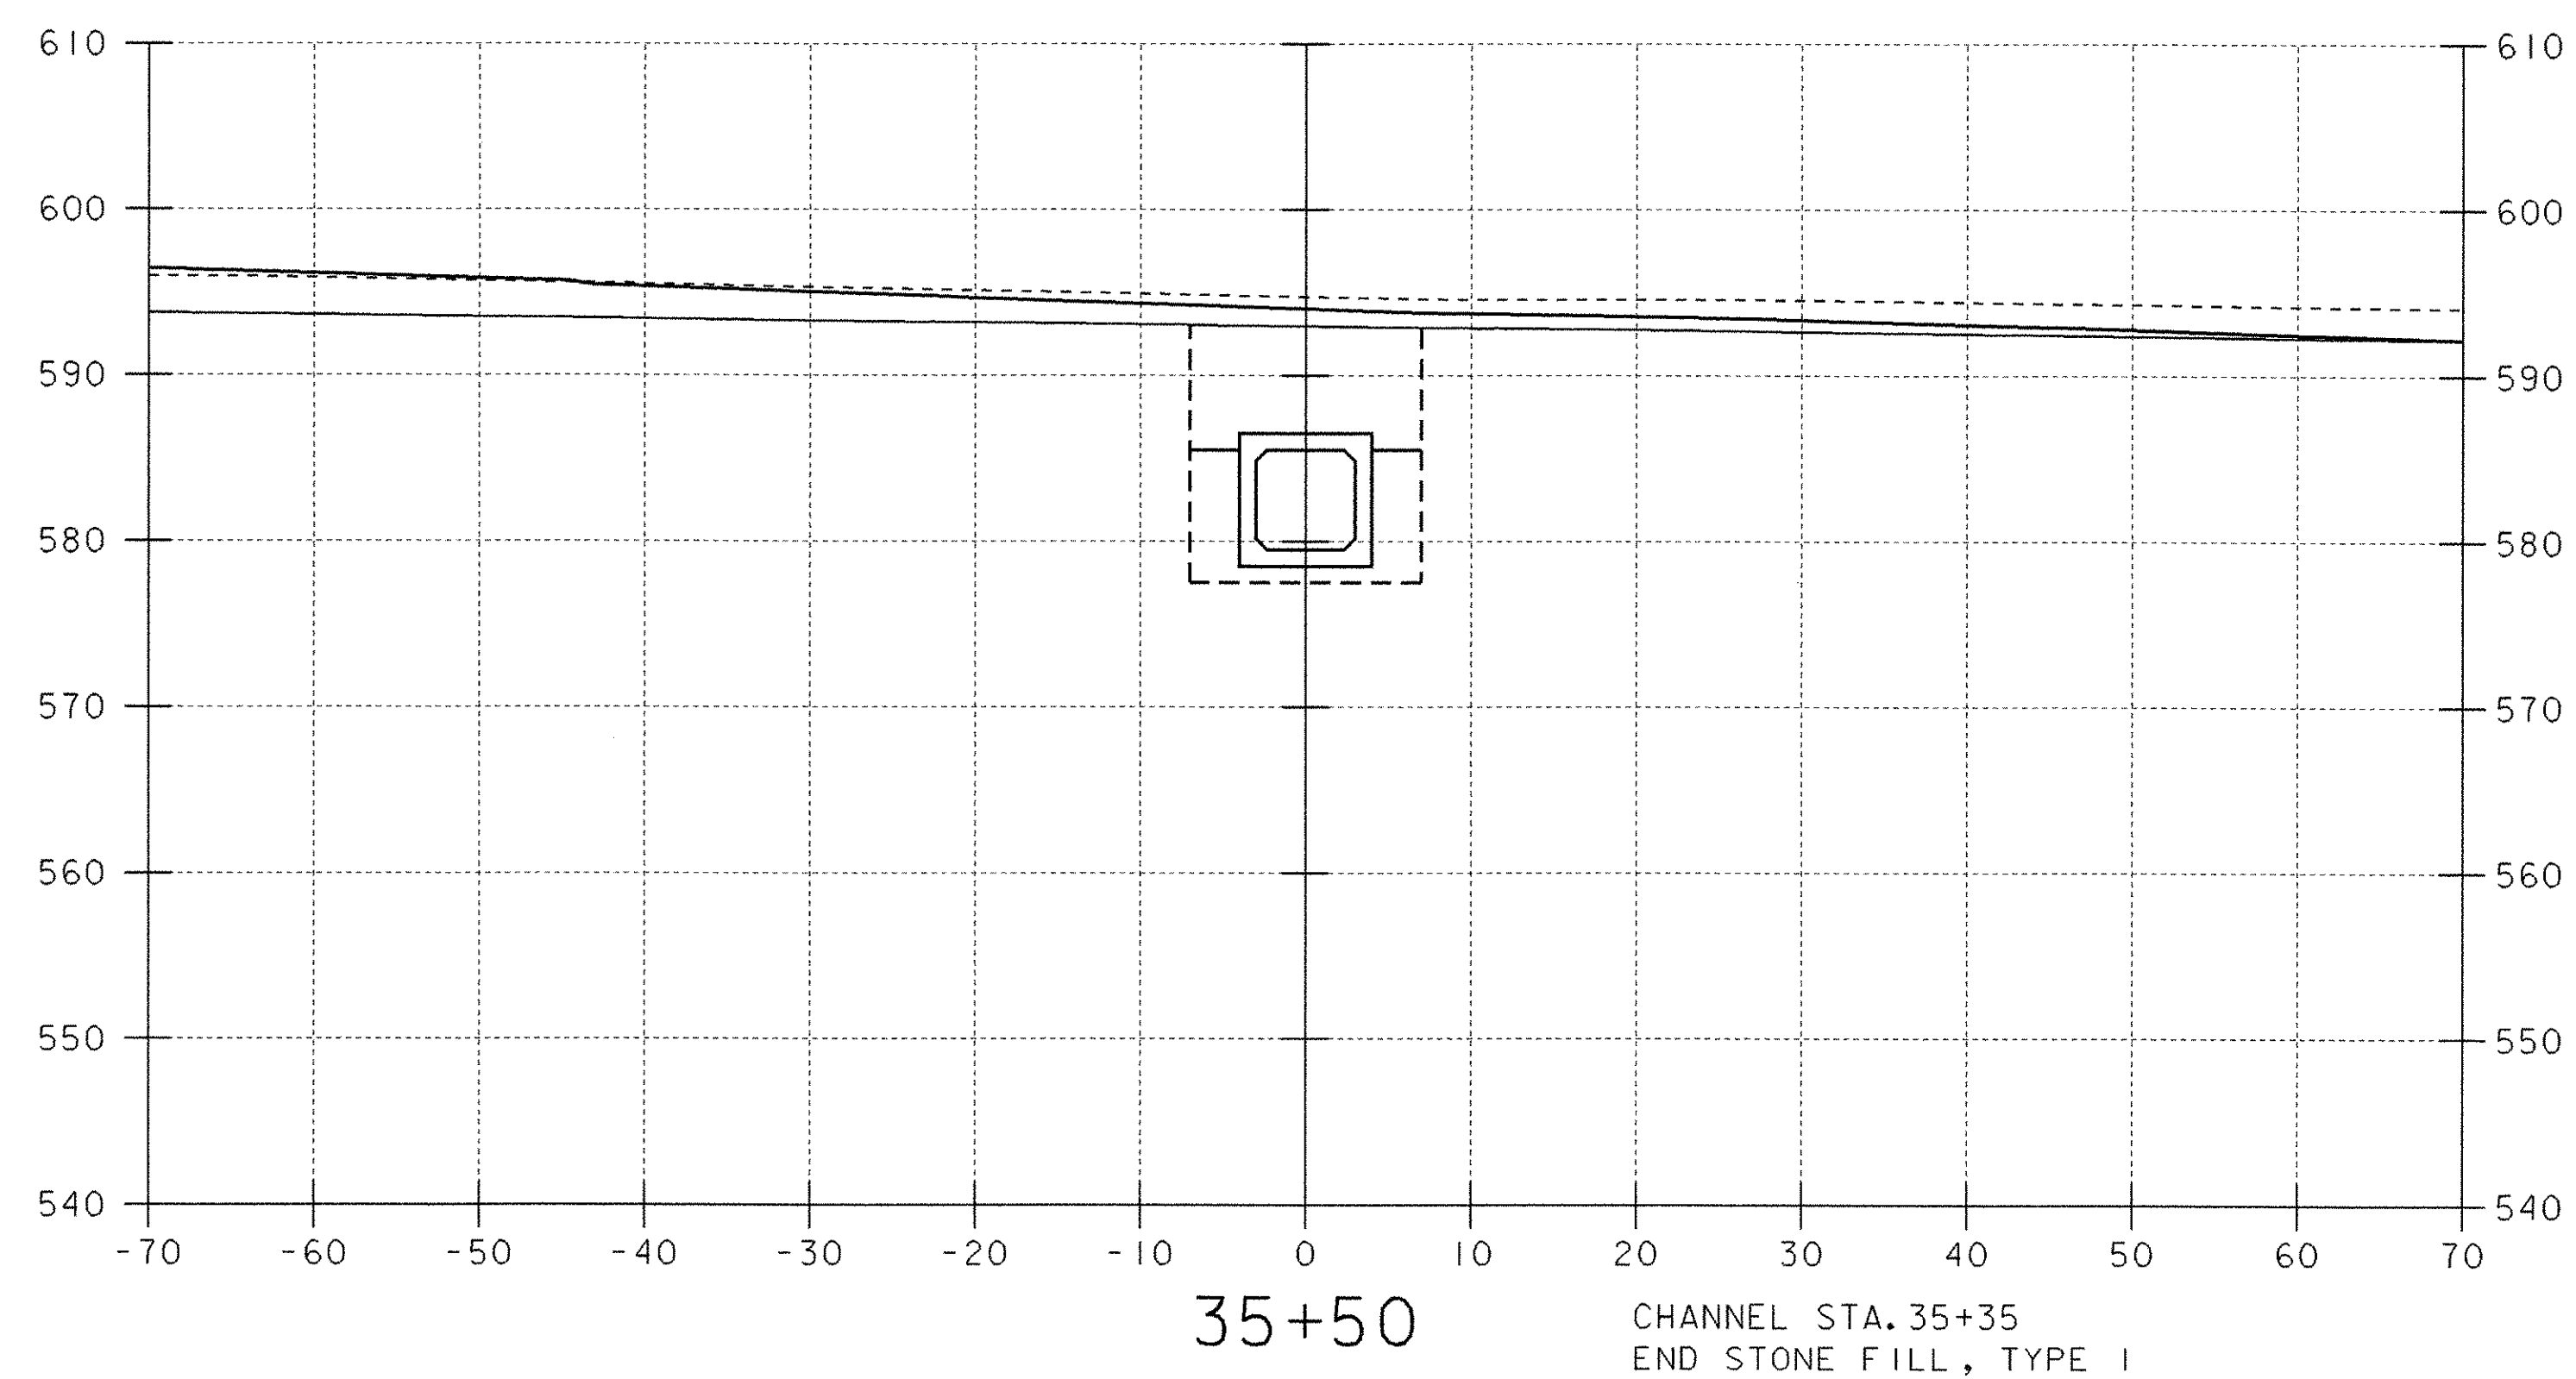


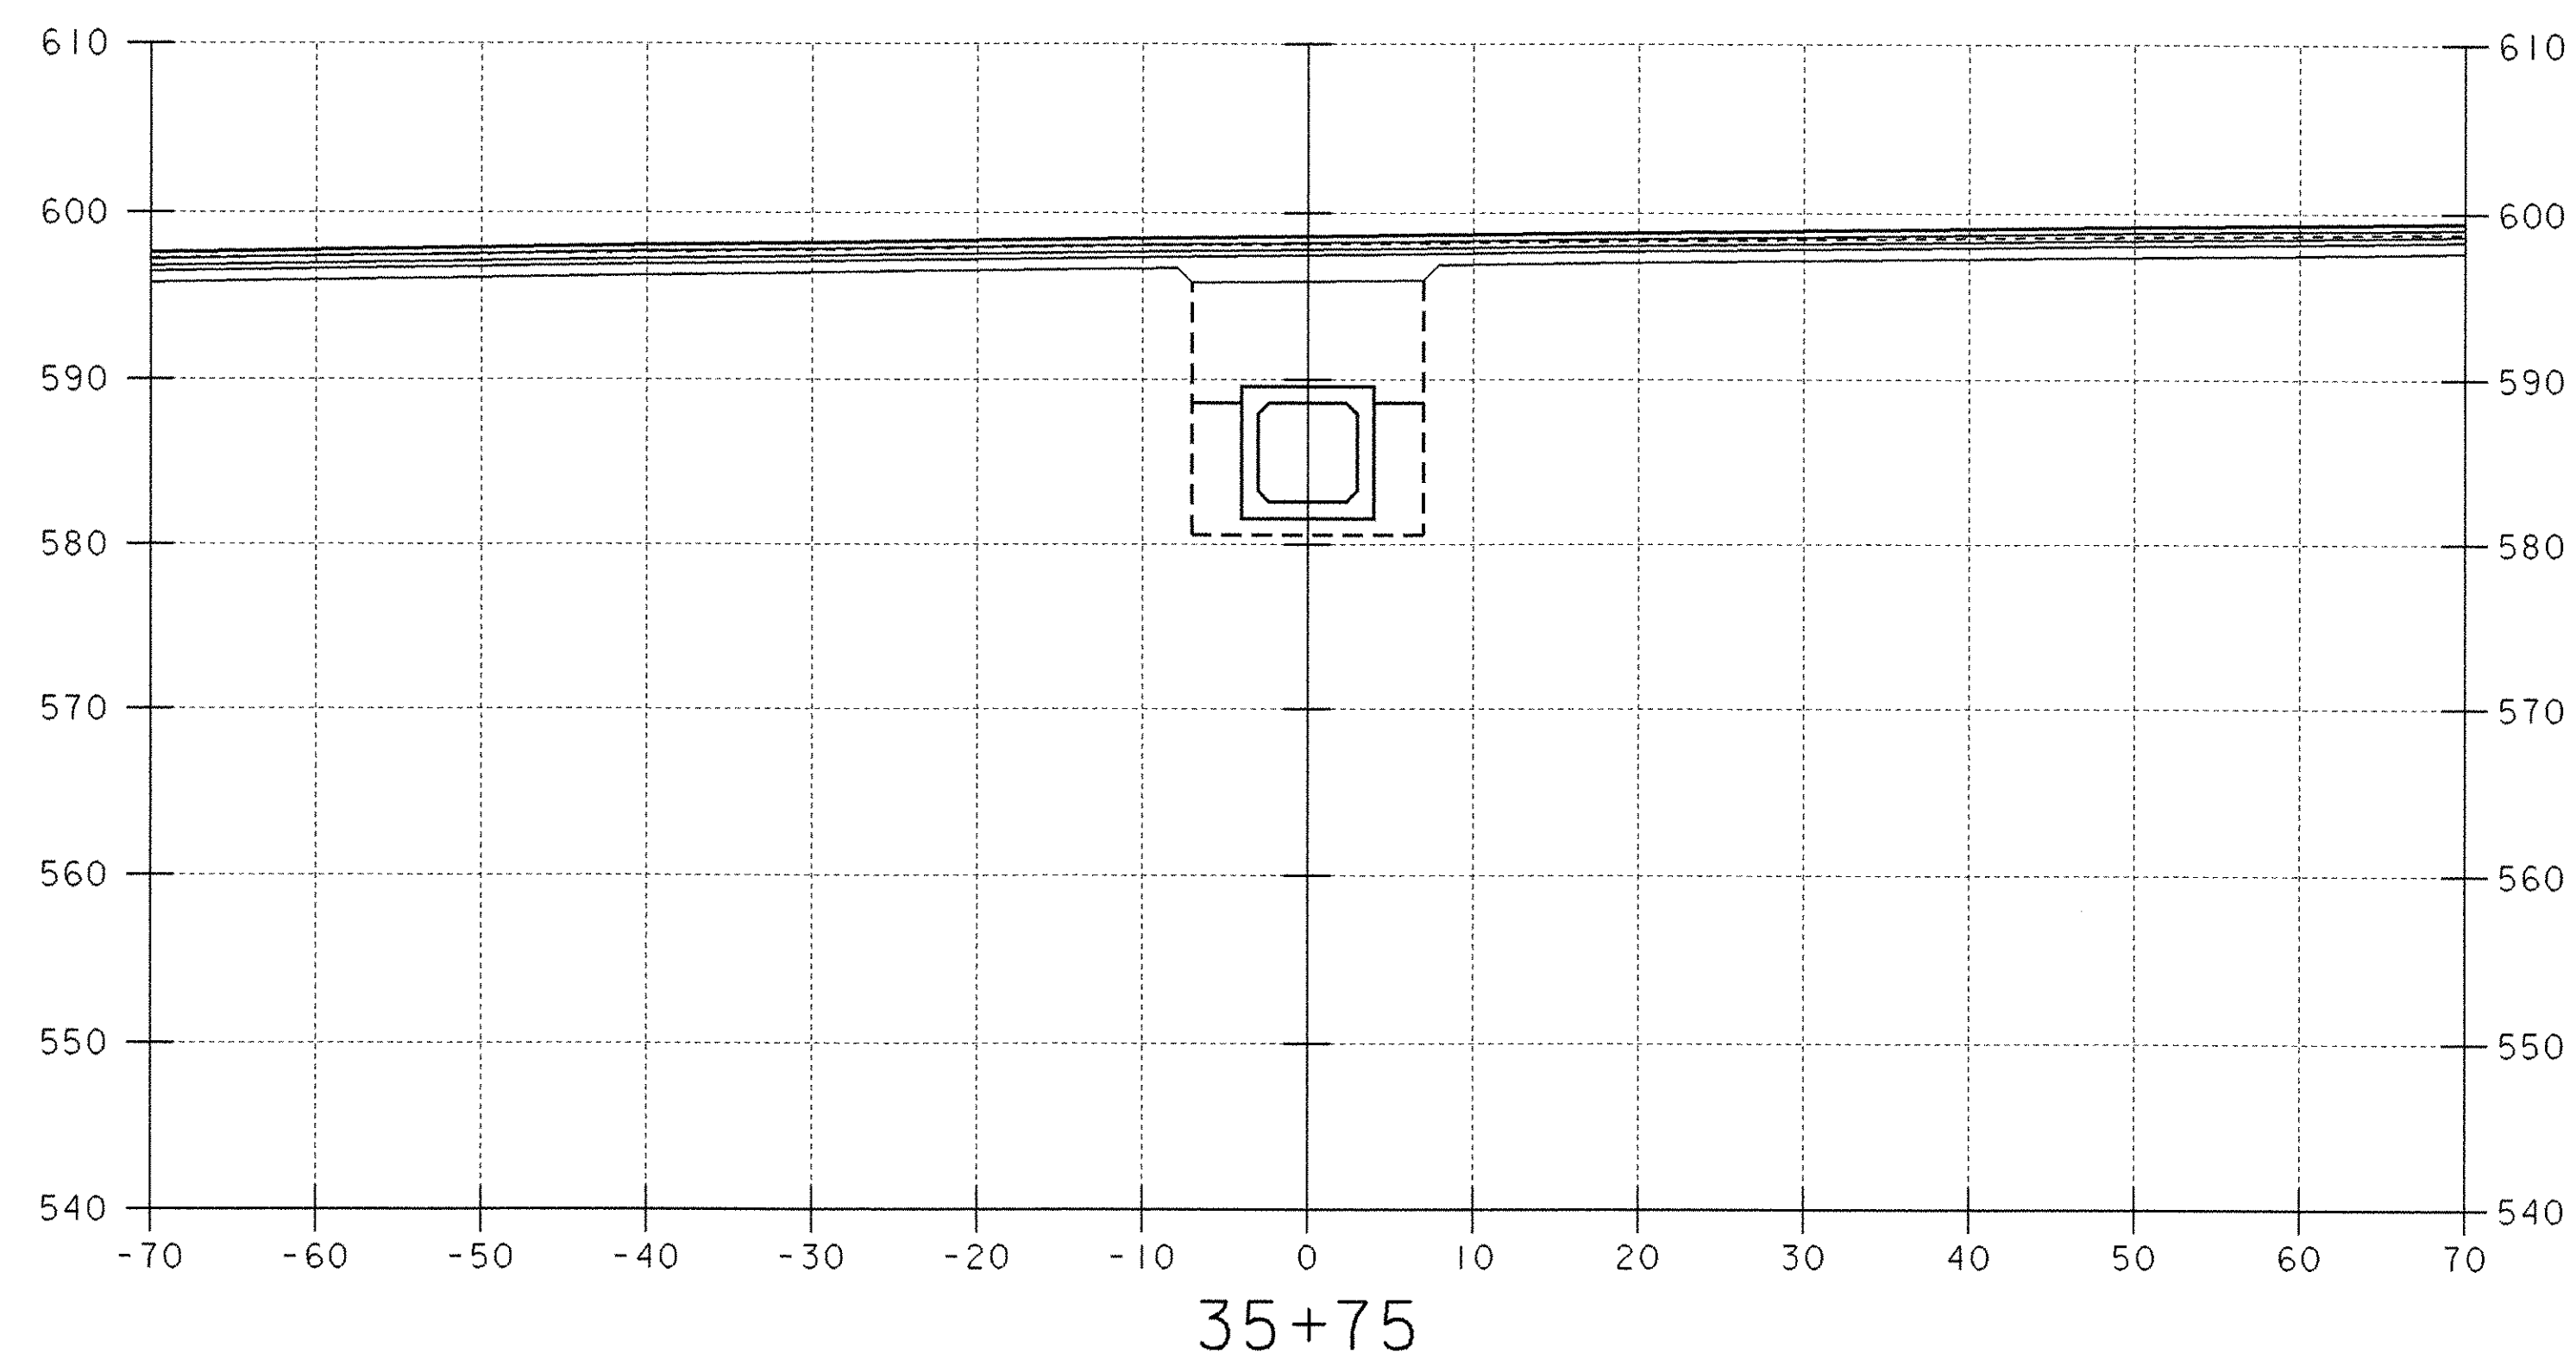

DATUM
VERTICAL _____
HORIZONTAL _____

SCALE 1" = 10'-0"
10 0 10

PROJECT: FAIRFAX-FAIRFIELD-ST. ALBANS	PROJECT NO.: IM 089-3 (27)
DESIGN FILE NAME: \\96a056\Structures\sa056xs4.dgn	PLOT DATE: 21-SEP-2000
IPARM FILE NAME: sa056c07.i	BRIDGE SHEET BR322
CHANNEL CROSS SECTIONS (6)	SHEET: 148 OF 370
STA. 35+50 TO STA. 36+25	