
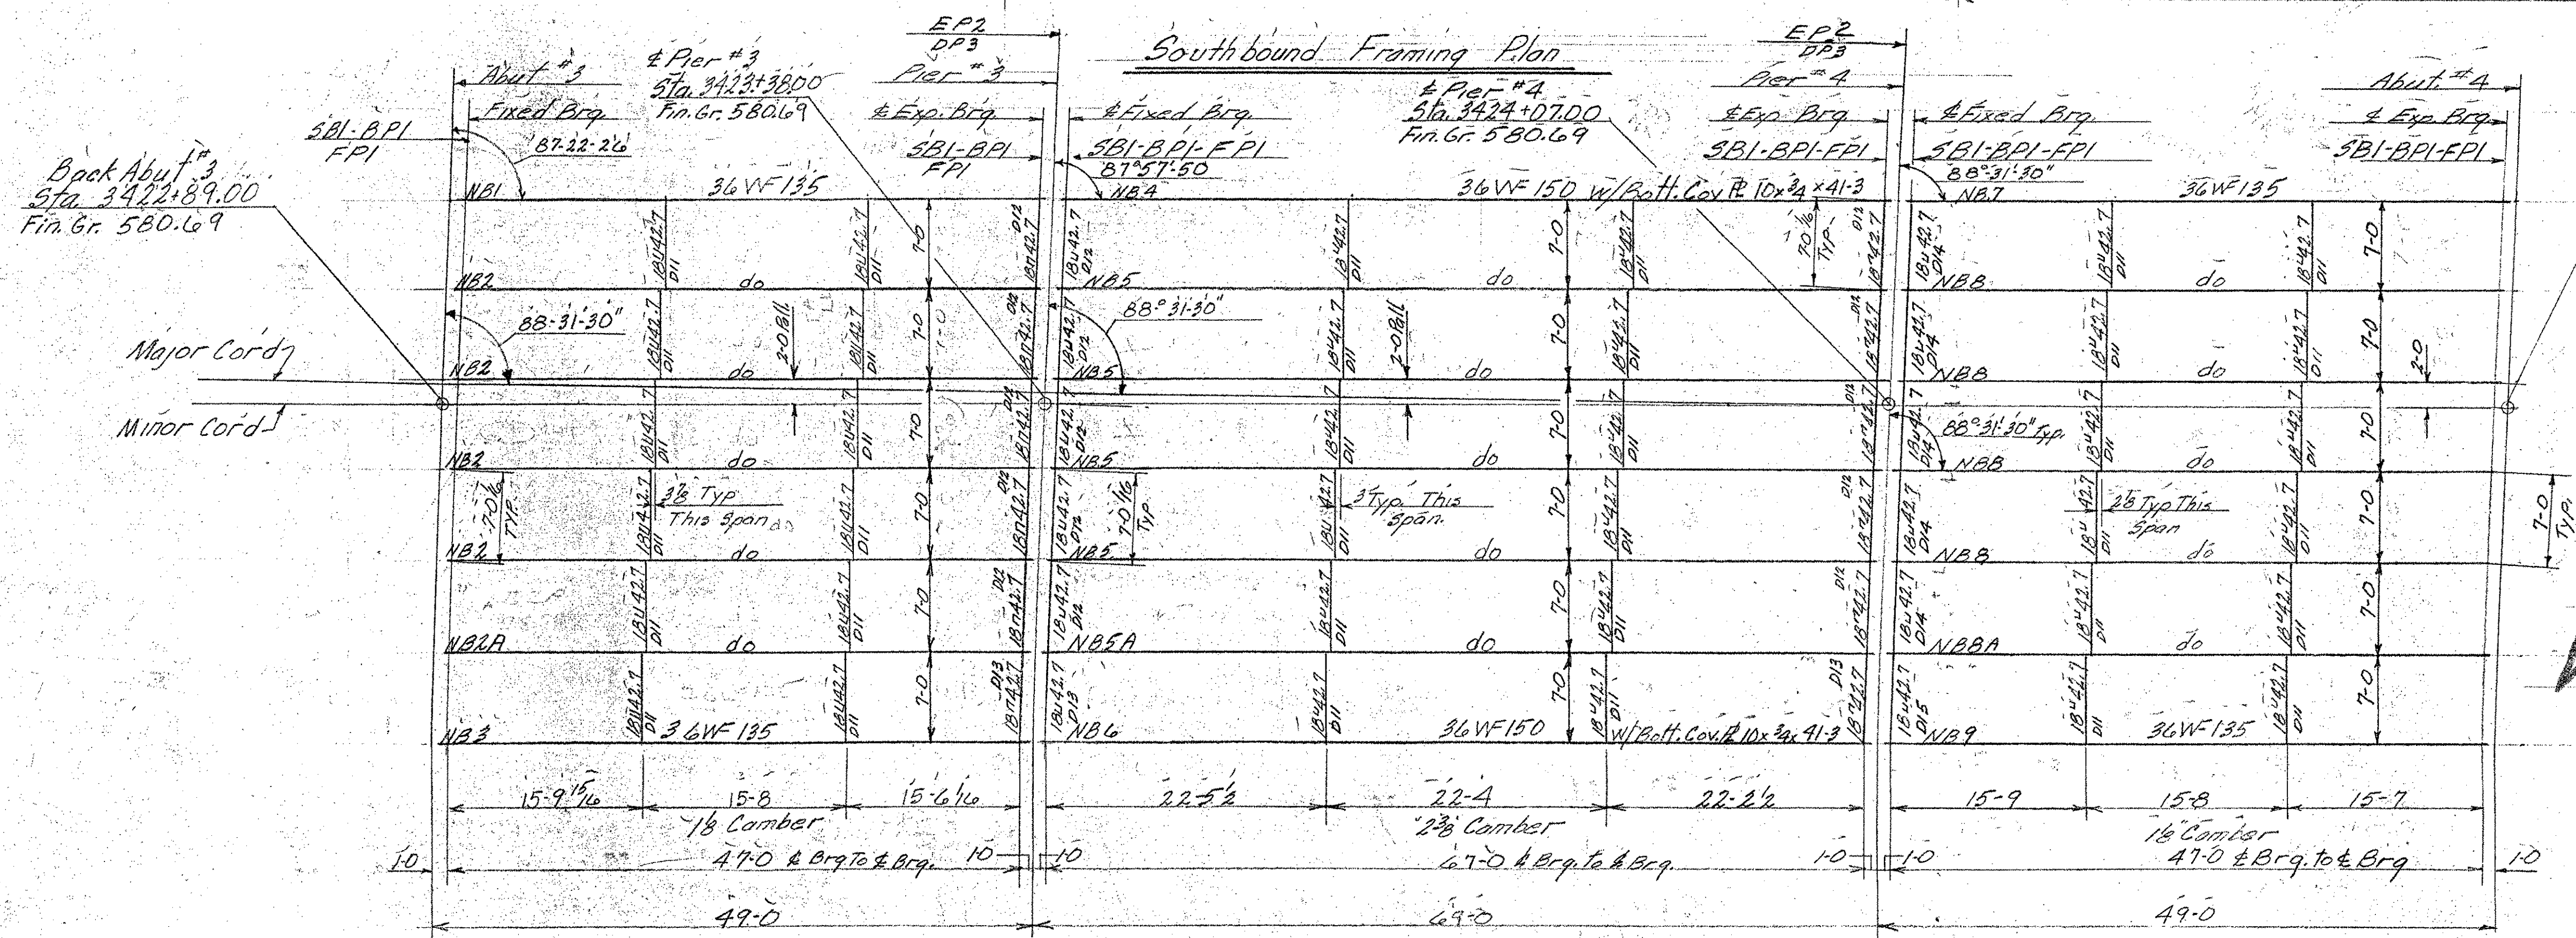
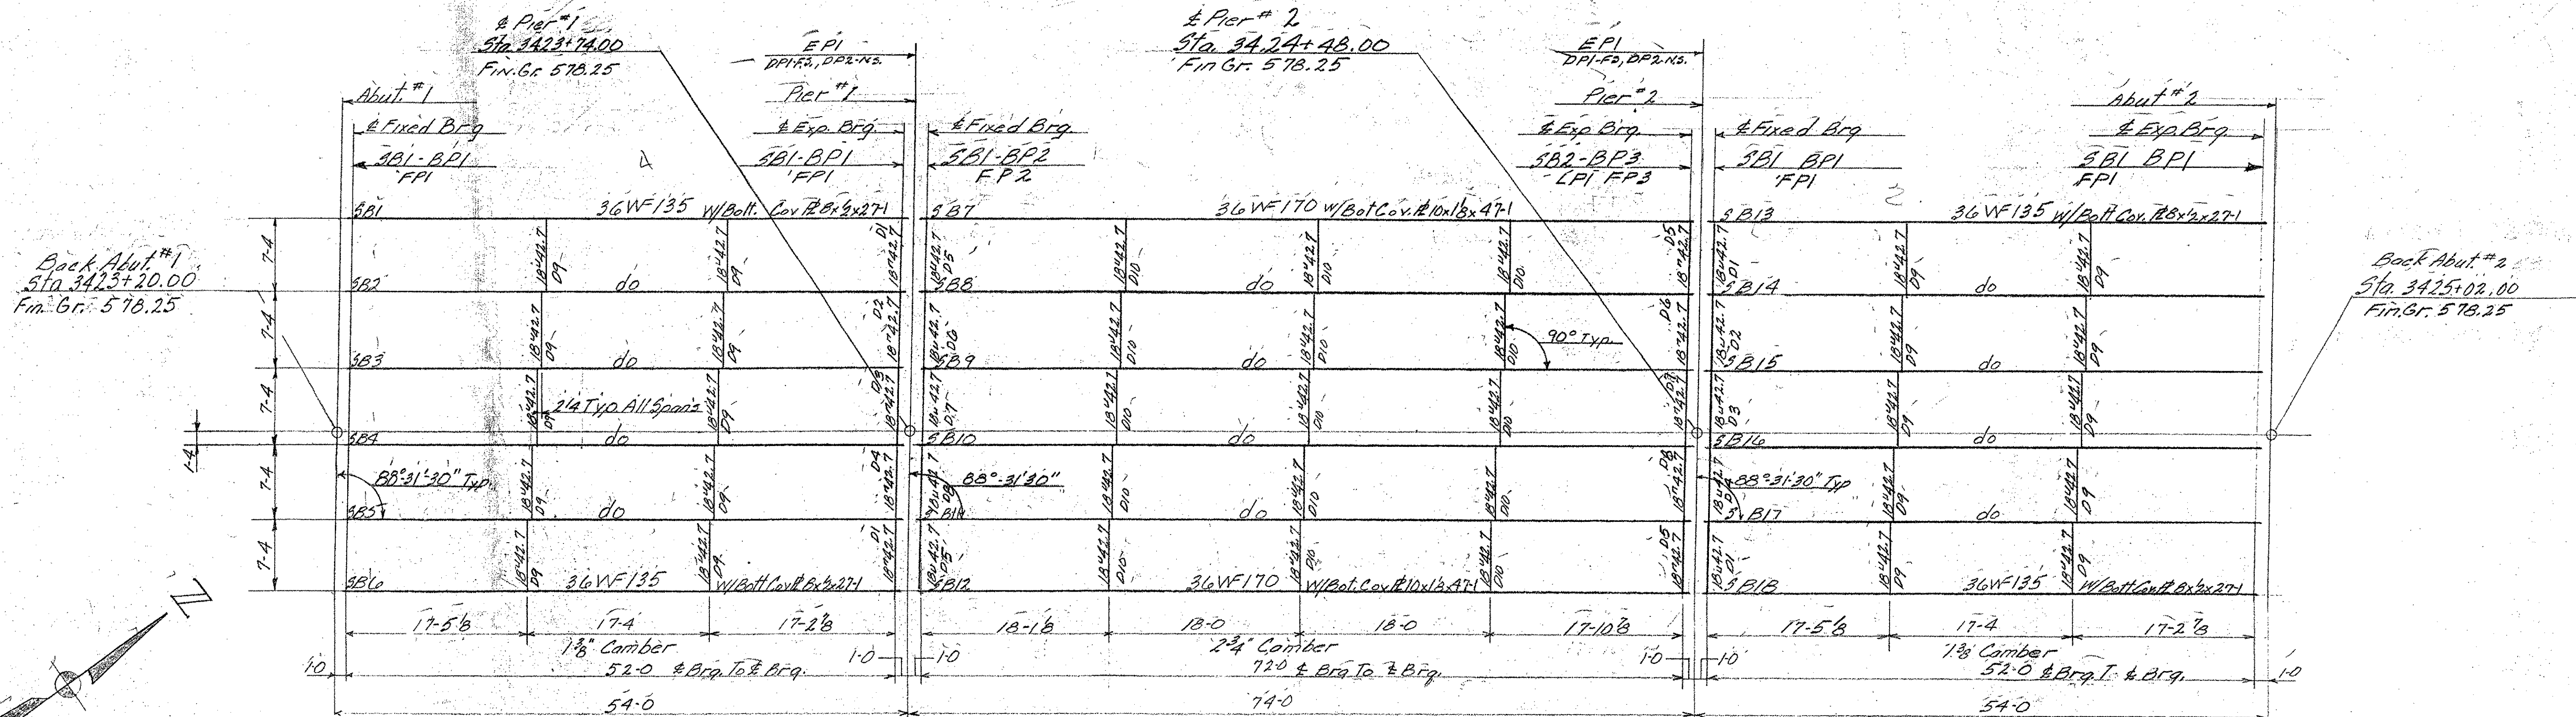


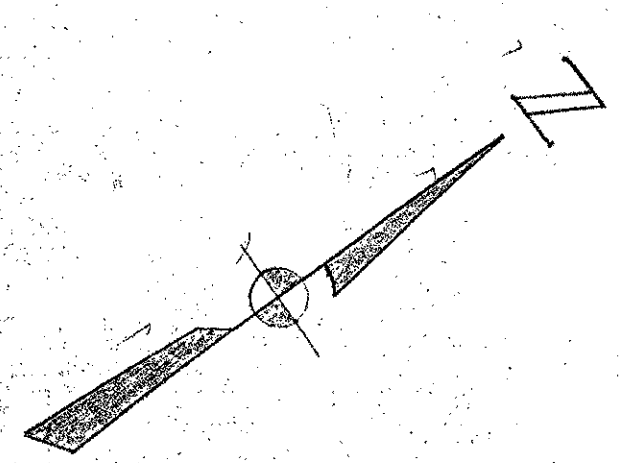

BRIDGE SHEET BR464  
REFERENCE SHEET 10 OF 37  
SHEET 216 OF 370

Ext. Wgts. with  
Weld corrections

Northbound Framing Plan

To be filed with Record Plans

| VERMONT STRUCTURAL STEEL CORPORATION<br>BURLINGTON, VT. |  |                                               |  |
|---------------------------------------------------------|--|-----------------------------------------------|--|
| DATE 11-7-66                                            |  | PROJECT T-89 Over Approach Road               |  |
| DRAWN BY L.C.                                           |  | LOCATION Georgia-Fairfax-Fairfield-St. Albans |  |
| CHK'D BY R.M.                                           |  | CUSTOMER Lane Constr. Co.                     |  |
| HOLES                                                   |  | ARCHITECT State of Vermont Dept. of Highways  |  |
| BOLTS                                                   |  | JOB NO. 66-1184-220 SHEET NO. E1              |  |
| PAINT R.L. (VT. Spec.)                                  |  | PRINT RECORD                                  |  |
|                                                         |  | NO. FOR DATE                                  |  |
|                                                         |  | 3 APP 11-21                                   |  |
|                                                         |  | 2 SHOR 11-21                                  |  |
|                                                         |  | 3 DES 11-21                                   |  |
|                                                         |  | 2 SHOP 11-21                                  |  |
|                                                         |  | 3 APP 12-21                                   |  |

2 LANE 12-28  
DWEL 12-7-66  
2 LANE 12-7-66