

PROPERTY LINE FENCE W/STEEL POSTS, MOD.
Item 583-II
S.B. 3332+00-3343+00 Lt.
N.B. 3332+00-3343+00 Rt.

*THREE CABLE GUARD RAIL
W/STEEL POSTS, ITEM 542
N.B. 3332+00-3343+00 Lt.
S.D. 3332+00-3343+00 Lt.
Beaver & Farm Pond (Approx. 300' x 600')

*STD STEEL BEAM GUARD RAIL W/LIGHT
STEEL POSTS, ITEM 545-AE (126' c/c)
S.D. 3333+00-3335+40 Rt.
N.B. 3333+00-3335+40 Lt.


STONE FILL FOR SLOPE
PROTECTION ITEM 512
S.B. 3334+16-3334+36 Rt.
S.B. 3334+44-3334+64 Rt.
N.B. 3335+20-3335+50 Lt.

RIPRAP (light type) Item 513-B
S.B. 3334+36-3334+44 Rt.
S.B. 3339+00-3339+10 Rt.


INDIVIDUAL WATER SOURCES
BEAVER & FARM POND S.B.L. 3334 - 375' LT
BEAVER & FARM POND S.B.L. 3337 - 410' LT
BEAVER & FARM POND S.B.L. 3340 - 440' LT

NOTE: * DENOTES ITEMS TO BE INCLUDED
IN STAGE II CONSTRUCTION.

CONTROL OF ACCESS IS COMPLETE ON THIS SHEET.

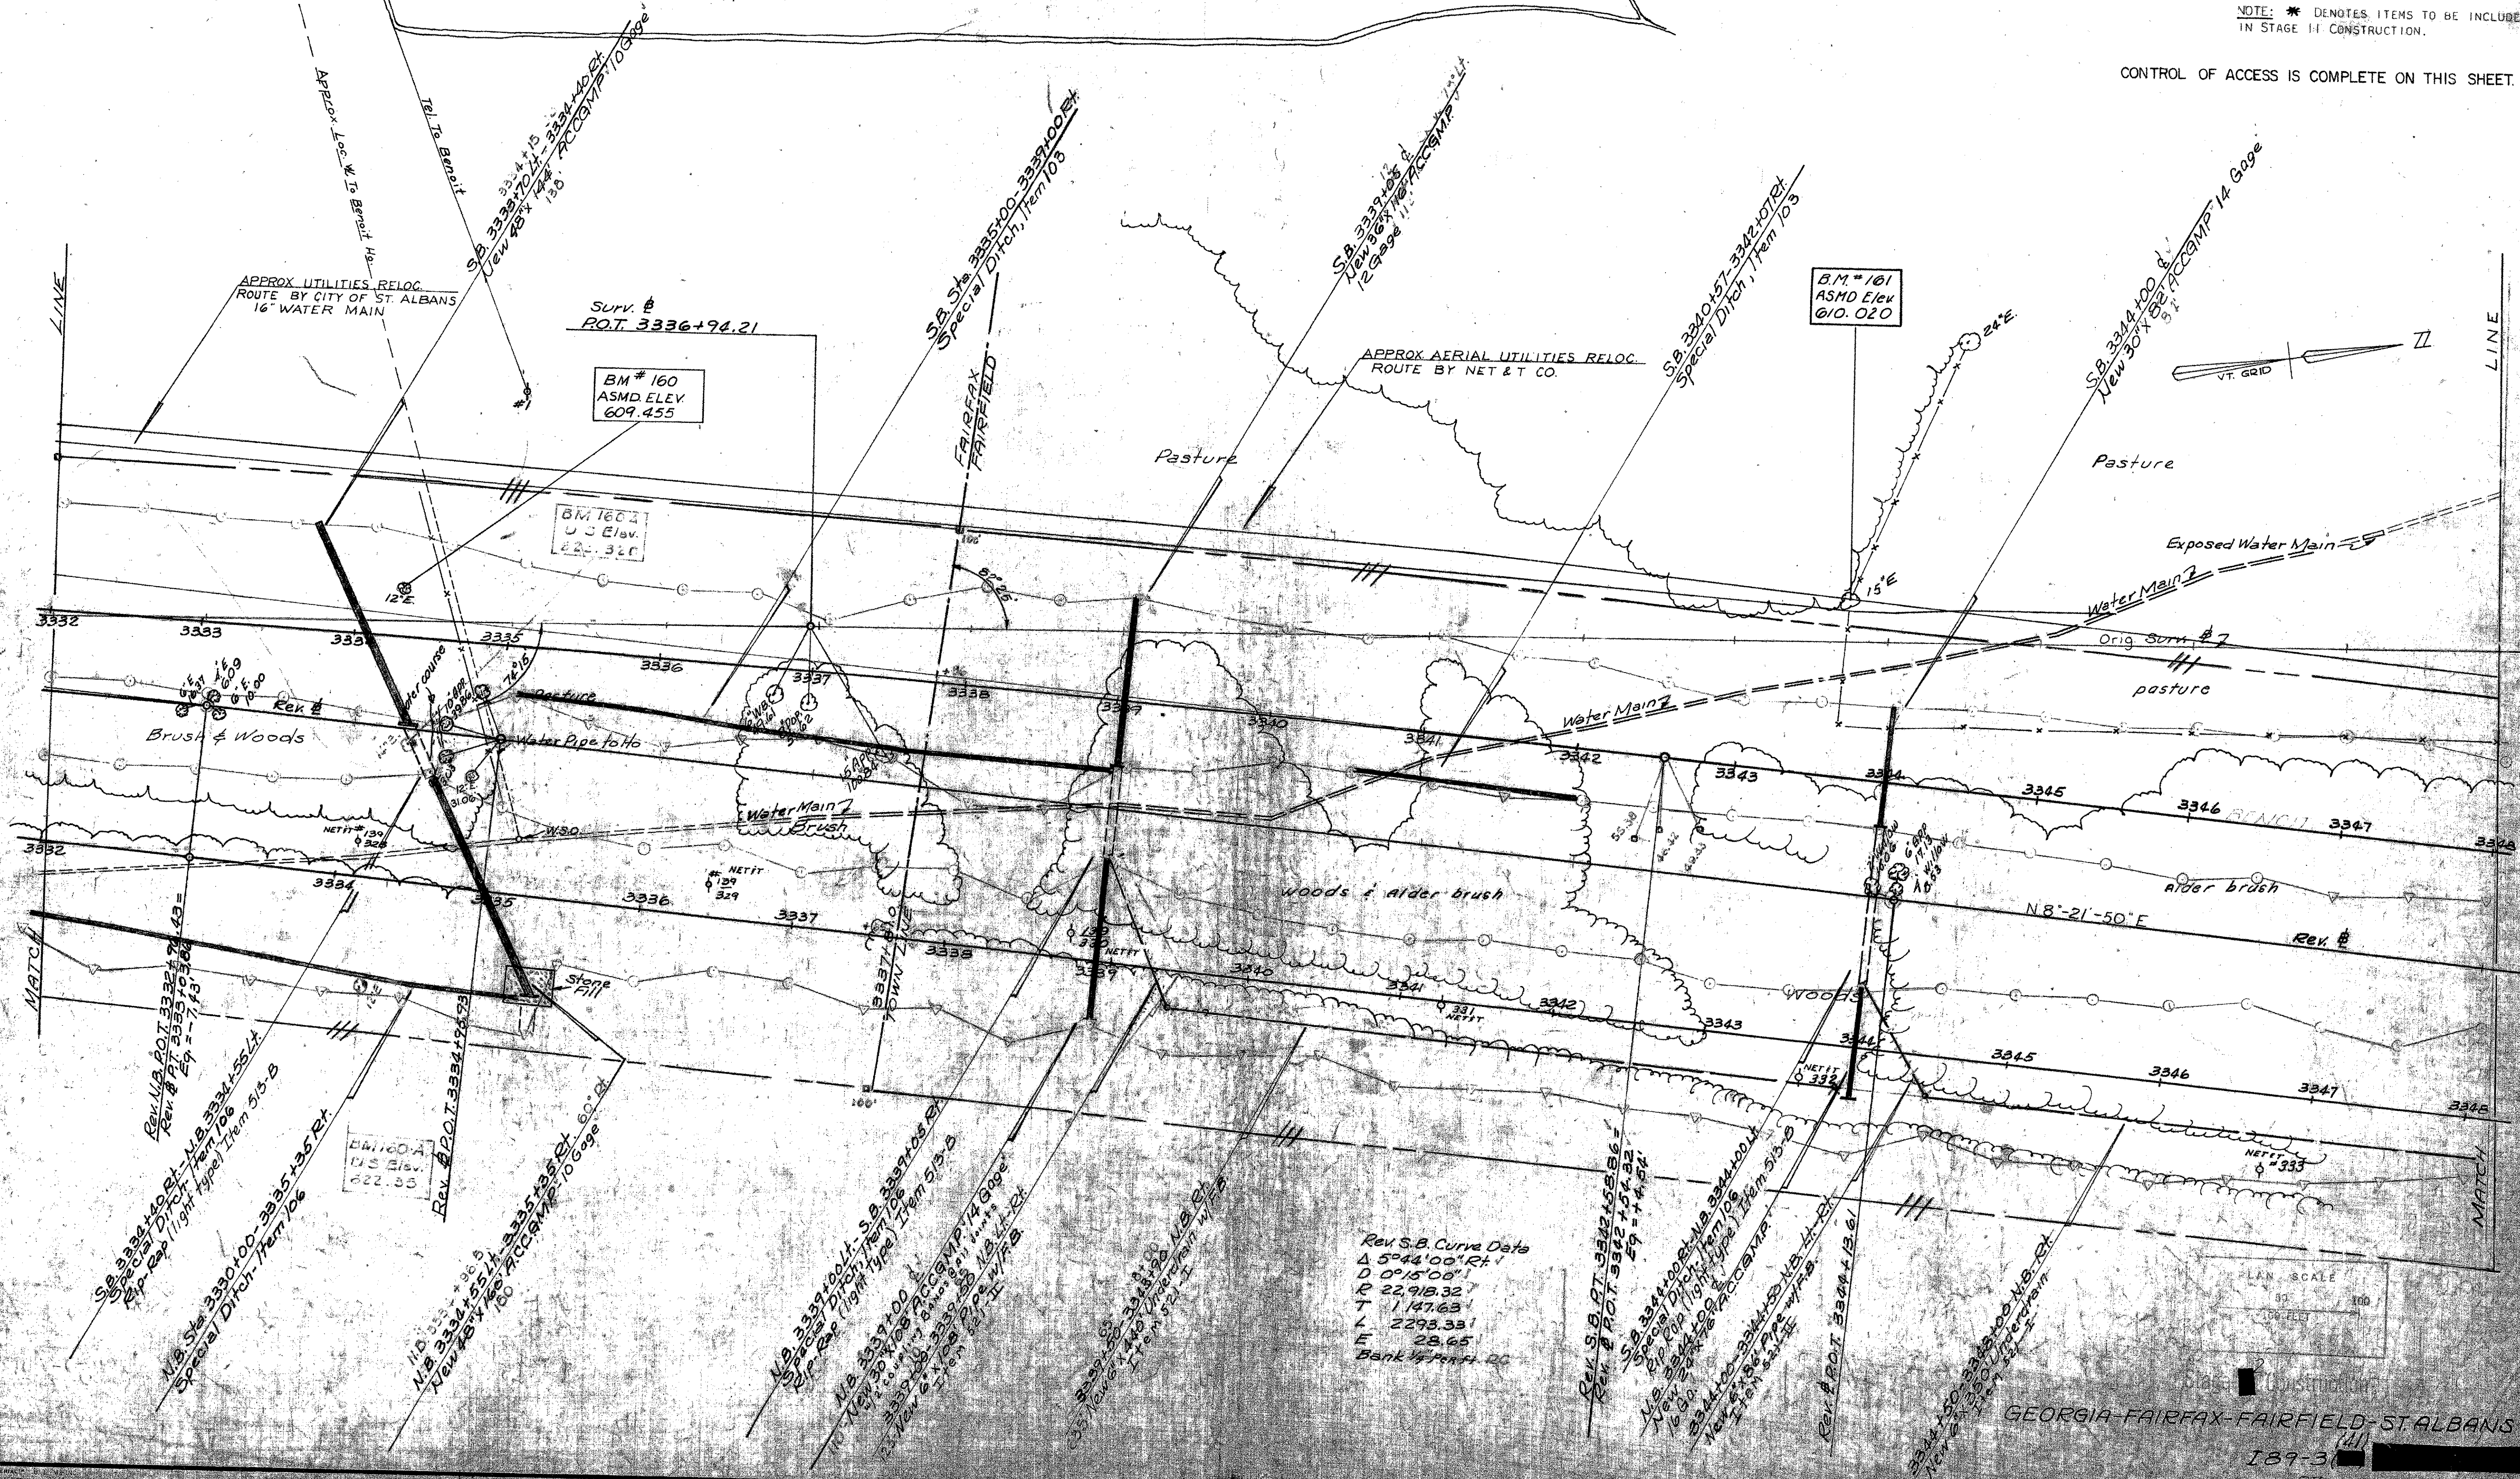

Rev S.B. Curve Data
Δ 5°44'00\"/>

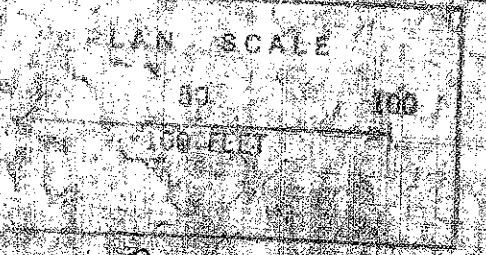

GEORGIA-FAIRFAX-FAIRFIELD-STALBANS

189-3

Sheet 351 of 352

S7A 3332 = MM 11/99