


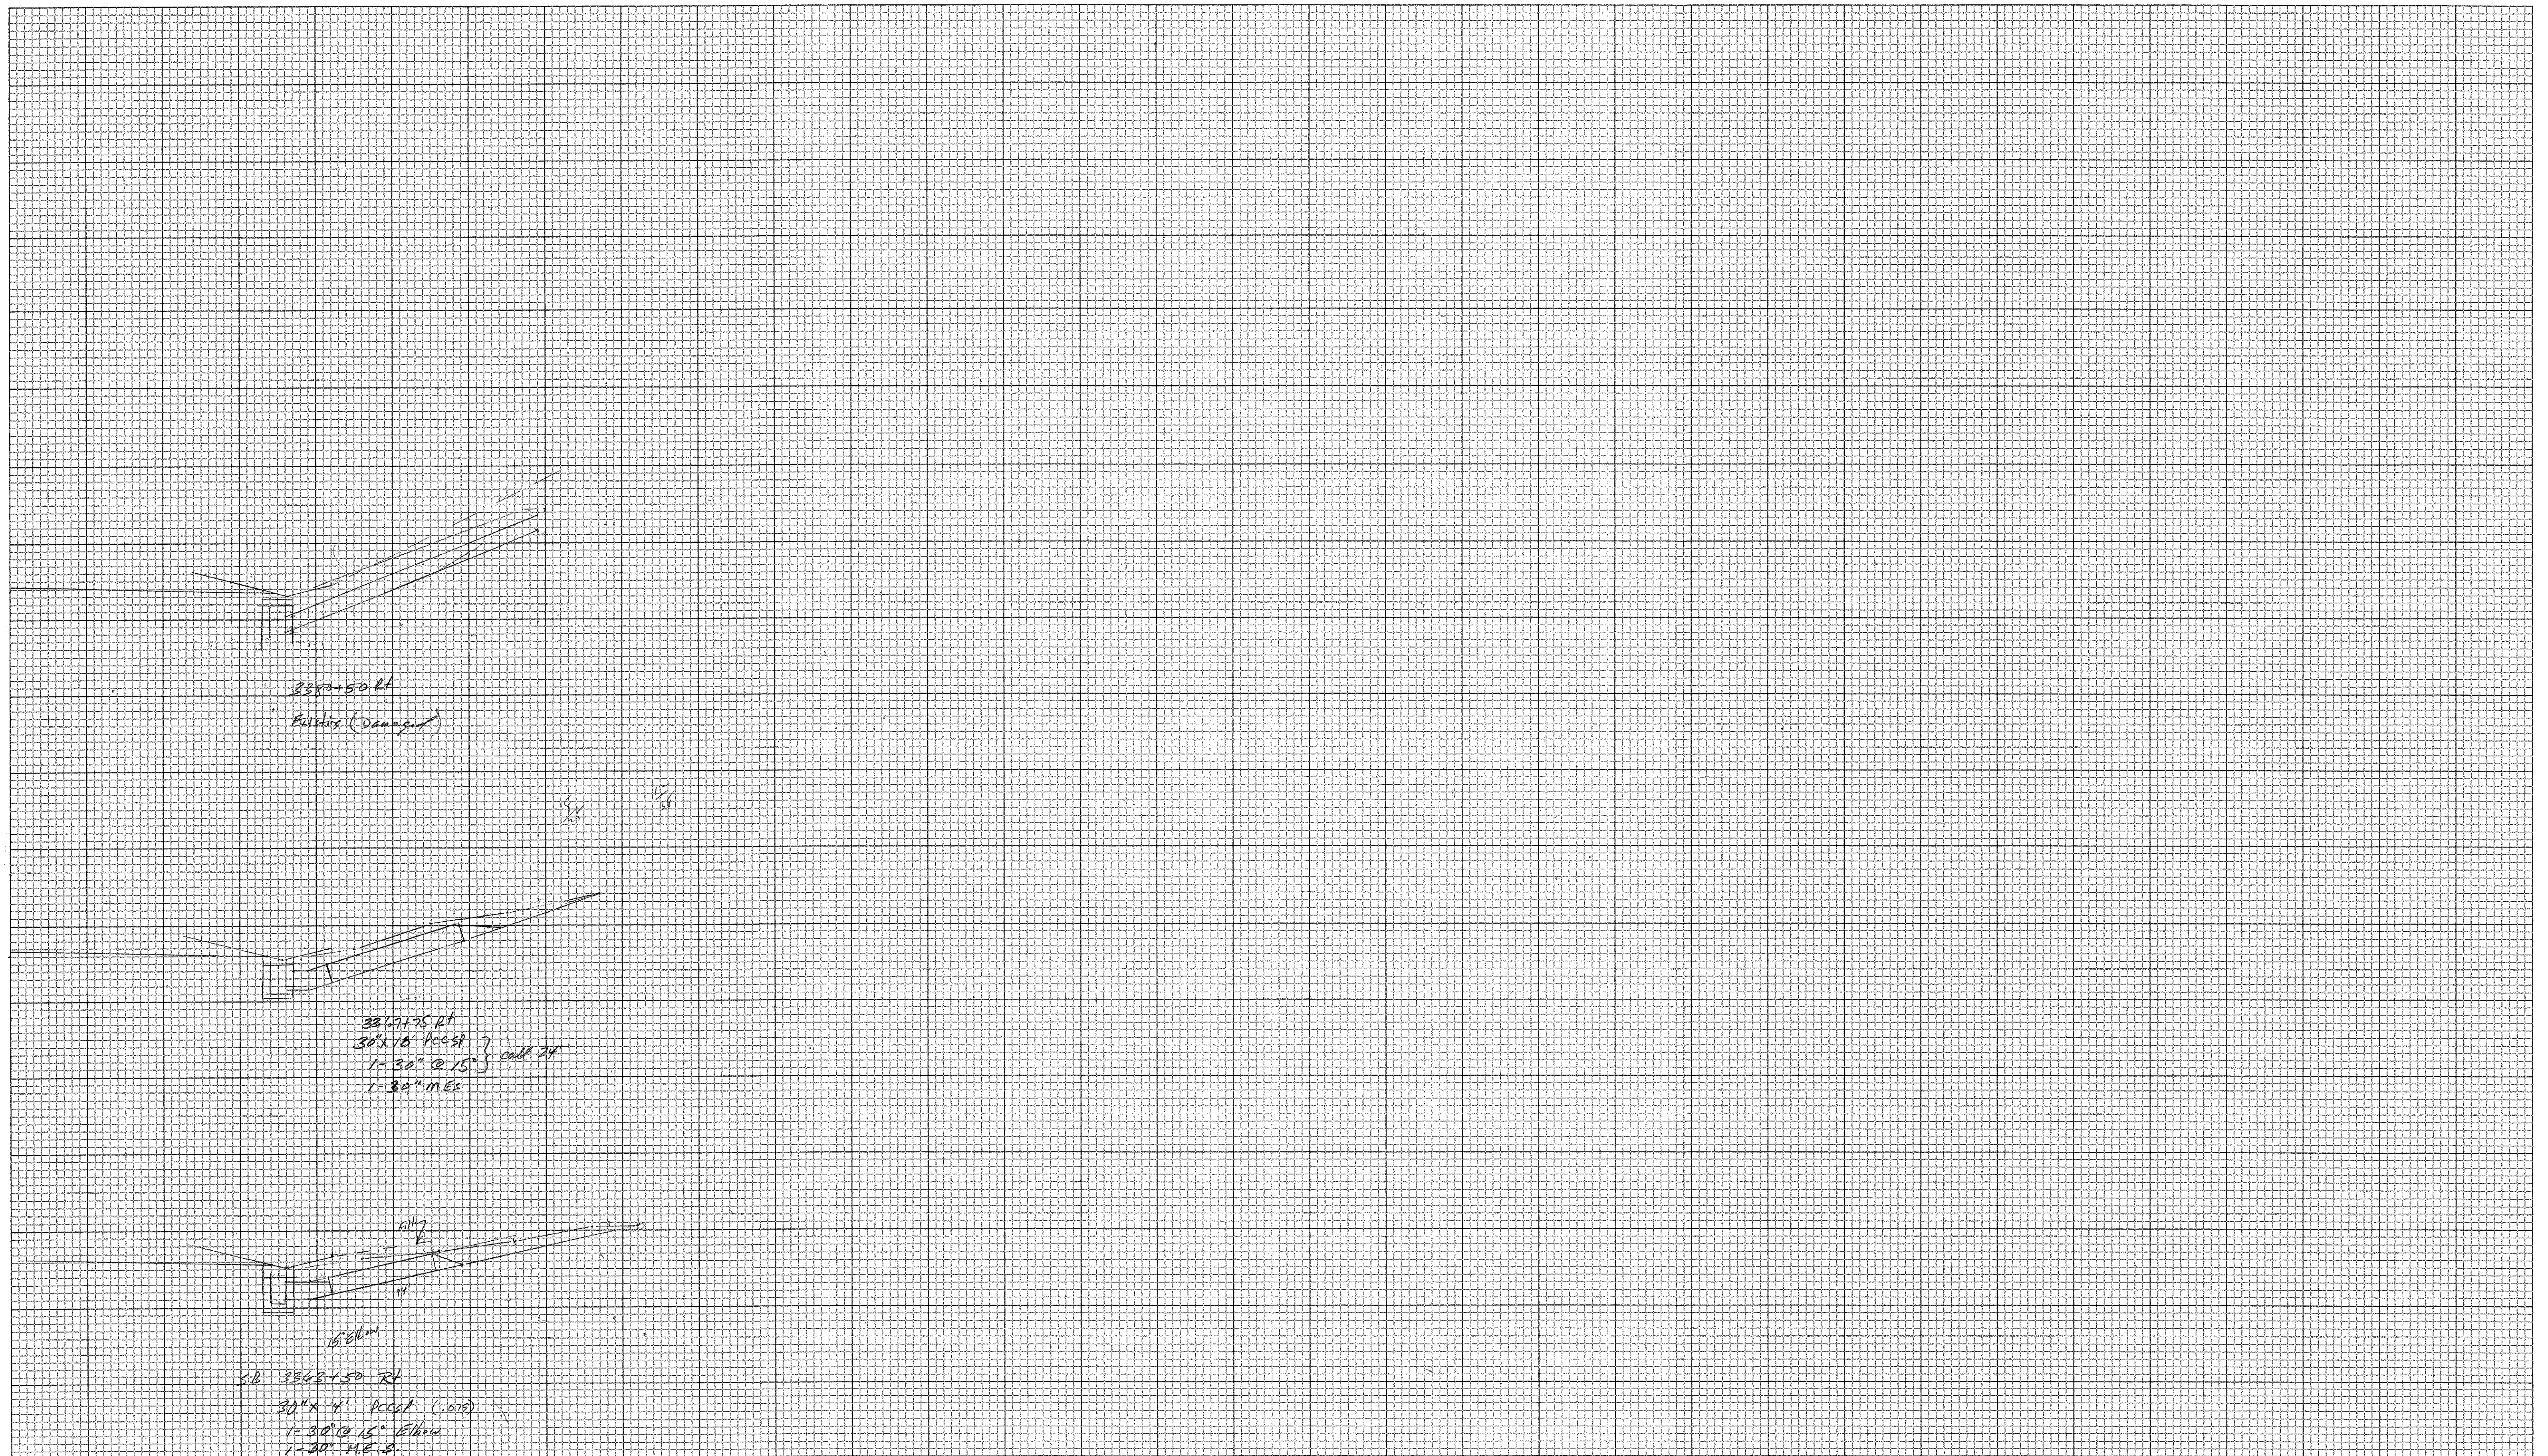

CROSS SECTION SHEET

PROJECT NAME: ST ALBANS
PROJECT NUMBER: IM 089-3(27)
FILE NAME: _____ PLOT DATE: 05-JUN-2000 09
PROJECT LEADER: _____ DRAWN BY: _____
DESIGNED BY: _____ CHECKED BY: _____
const: g:/common/cadd/e-xsection.dgn SHEET 385 OF _____