


PANEL COLUMN NO. (TYP.) → 5 10 15 20 25 30 35 40 45

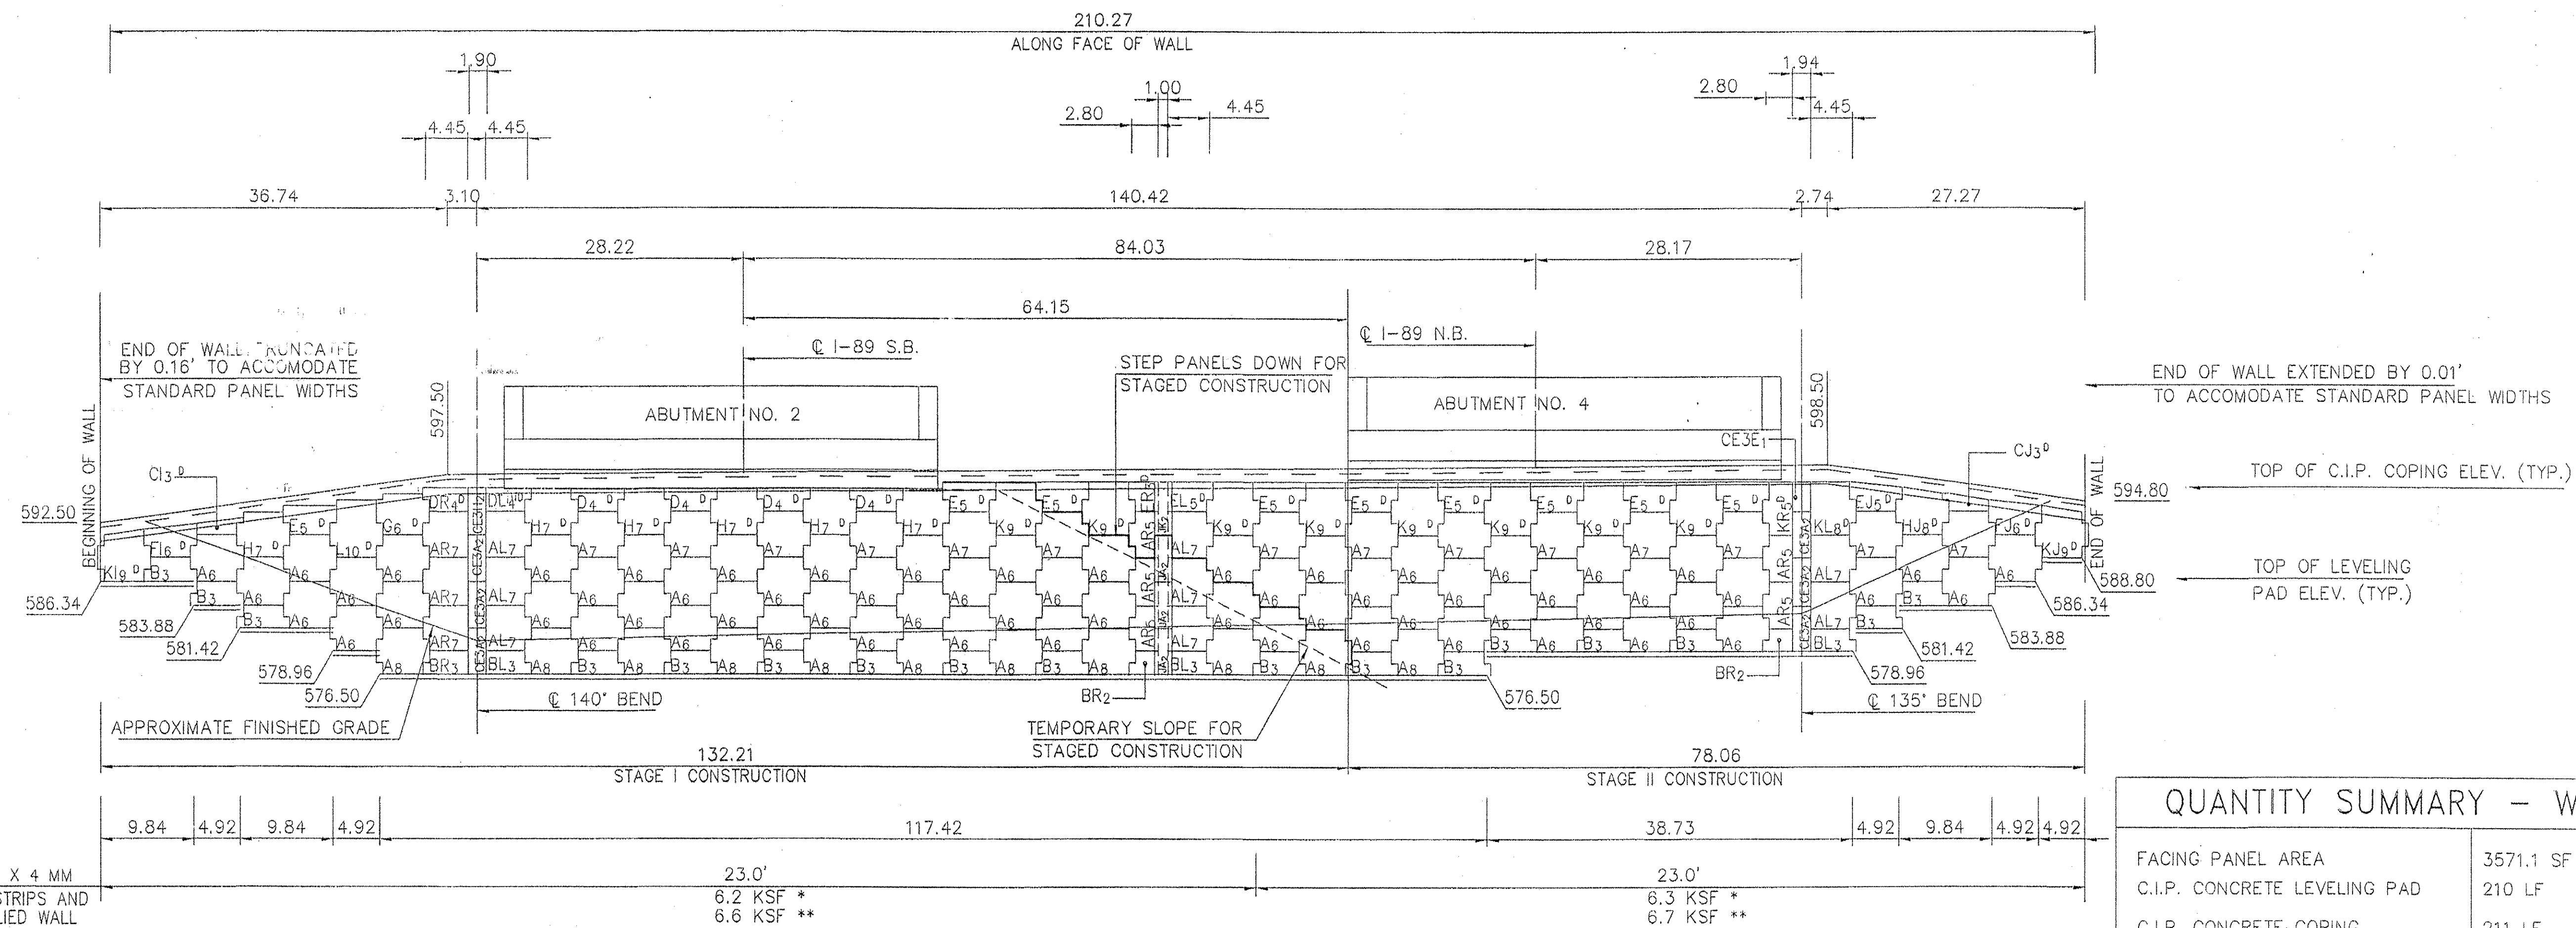

ELEVATION - FRONT FACE - WALL NO. 2

SCALE: 1" = 10'

SCALE: 1" = 10'

QUANTITY SUMMARY - WALL NO. 2

FACING PANEL AREA	3571.1 SF
C.I.P. CONCRETE LEVELING PAD	210 LF
C.I.P. CONCRETE COPING	211 LF
SELECT GRANULAR BACKFILL ***	3175 CY


*** SEE NOTE 22 ON SHEET 1 OF 6.

NOTES: * BEARING PRESSURE USING SERVICE LOADS
** BEARING PRESSURE USING SPECIFIED LOADS

LENGTH OF LEVELING PAD IS BASED ON INDIVIDUAL PANEL WIDTHS, @ OF EAR TO @ OF EAR. USE THE STEP DETAIL ON SHEET No. 5 TO DETERMINE THE ACTUAL LEVELING PAD STEP LOCATION.

FOR CORNER DETAILS SEE SHEET No. 5.
FOR TYPICAL WALL SECTIONS SEE SHEET No. 5.
FOR COPING DETAILS, SEE SHEET No. 5.
FOR ABUTMENT DETAILS, SEE CONTRACT PLANS.


KEY: PANEL NAME H₄ NO. OF TIE STRIPS

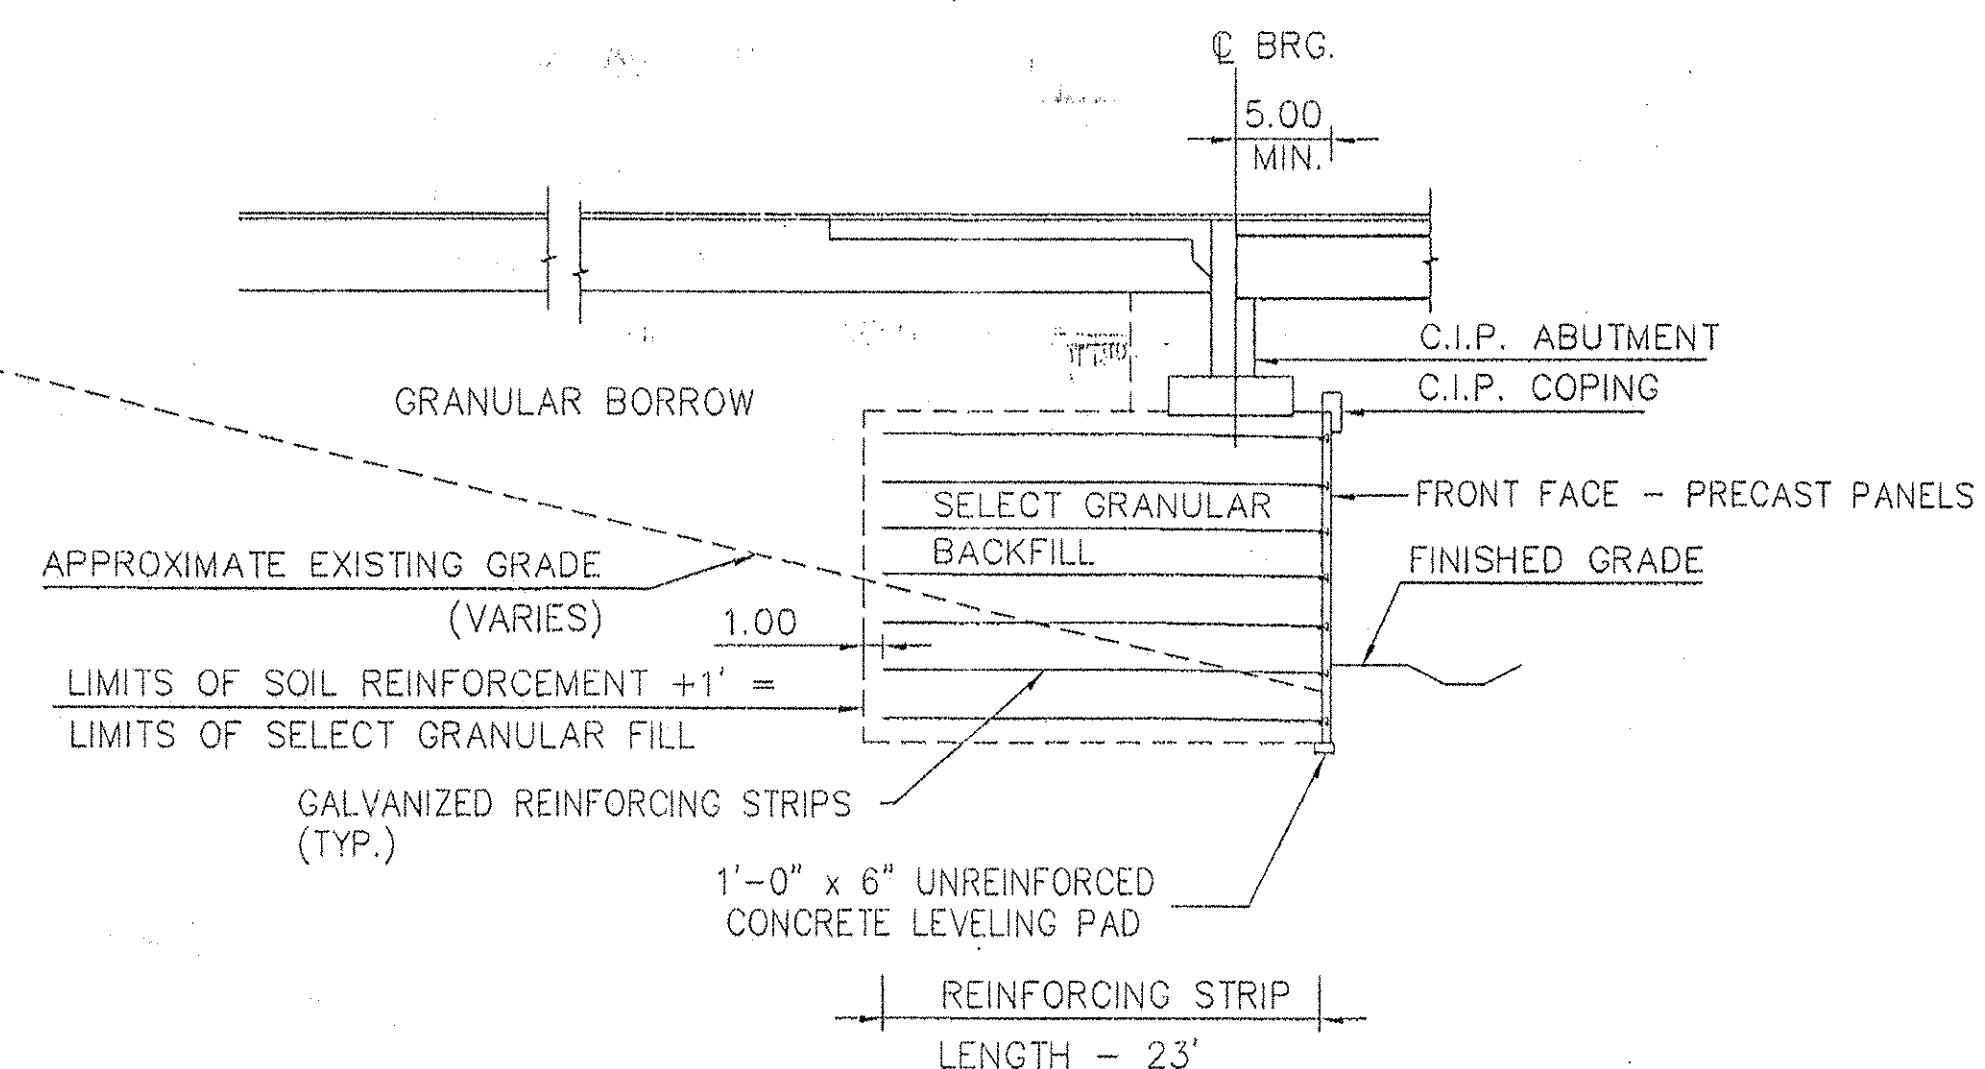

TYPICAL SECTION - R.E. WALLS AT ABUTMENTS

SCALE: 1" = 10'

NOTE: SEE SHEET 109 OF 370 FOR ADDITIONAL INFORMATION

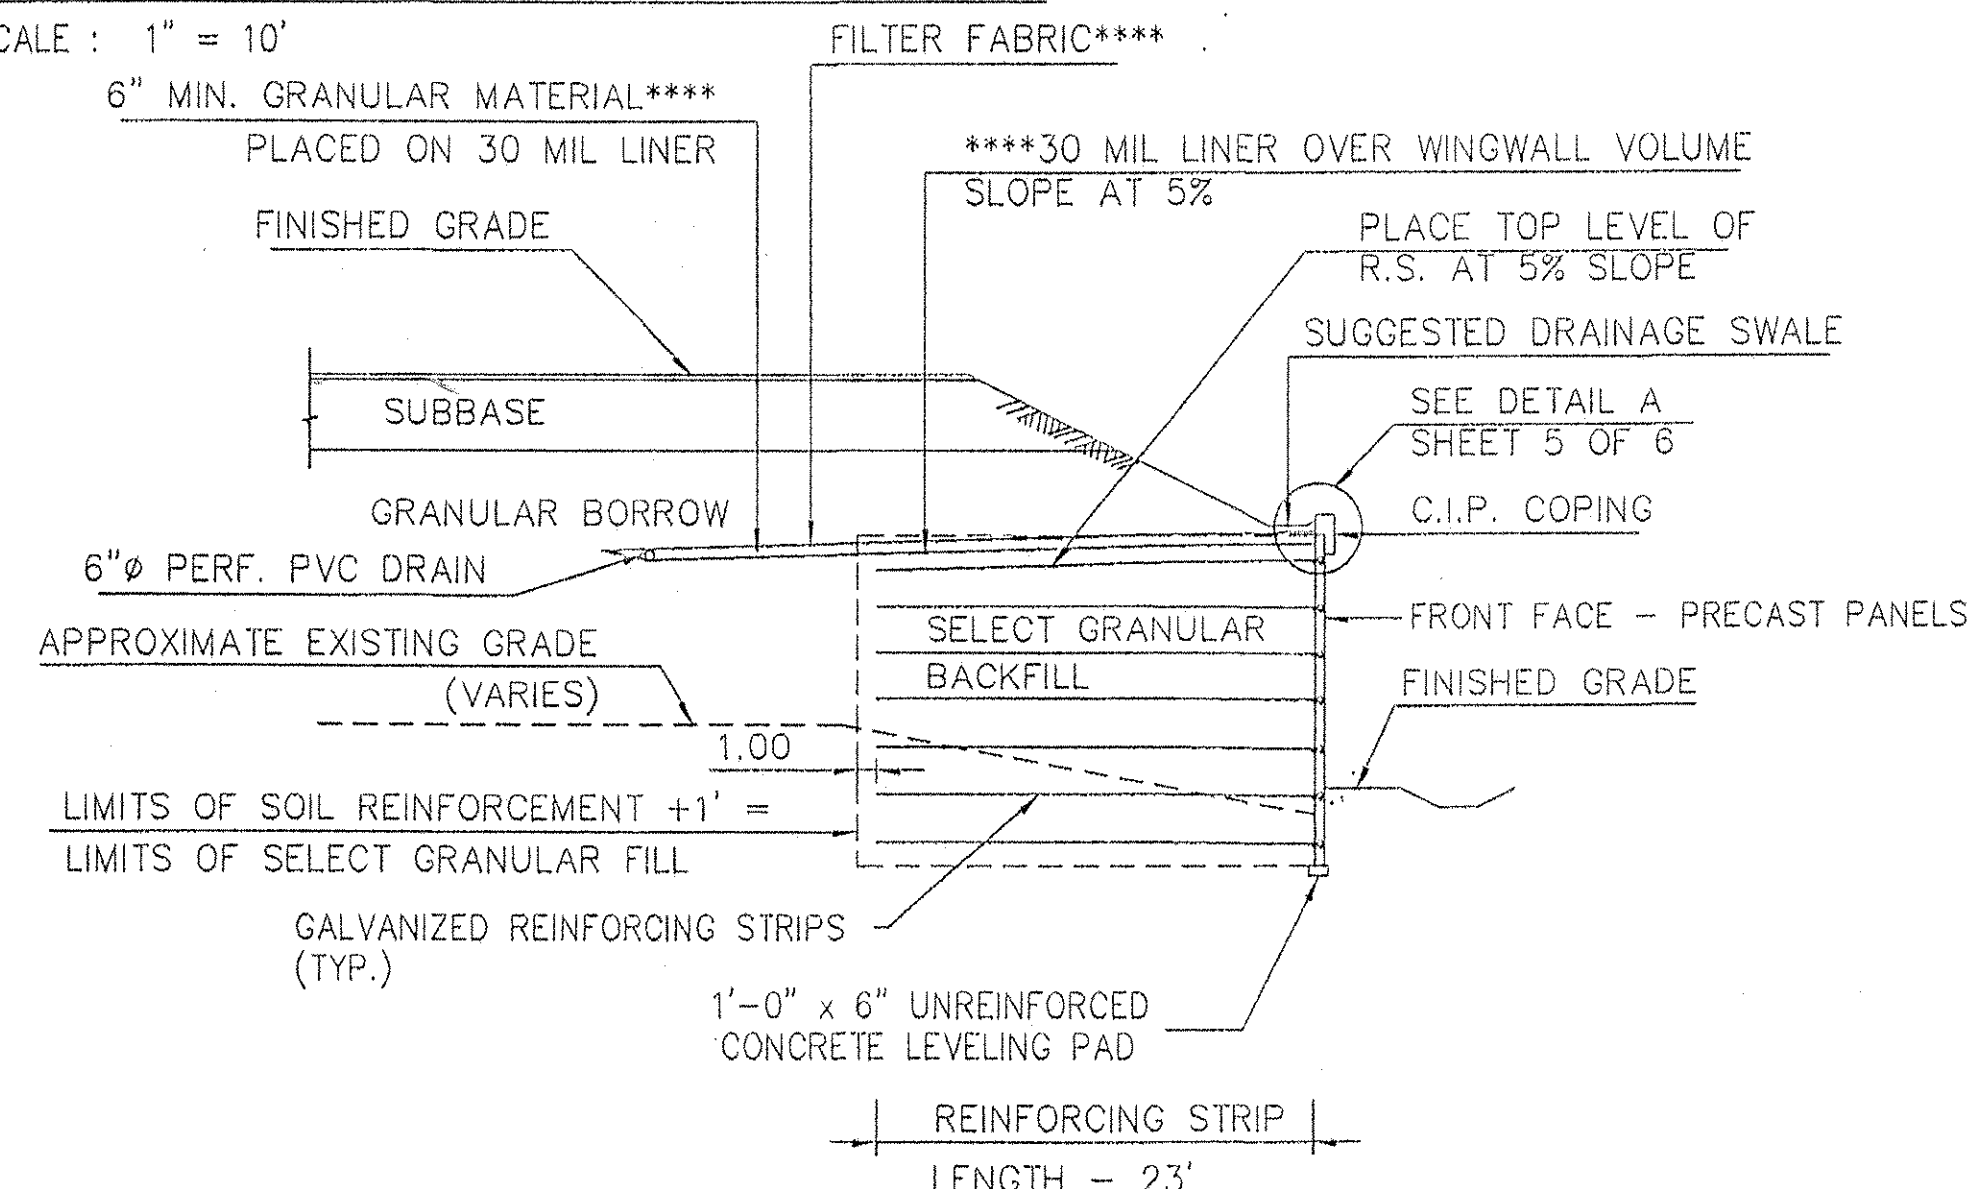

TYPICAL SECTION - R.E. WING WALLS

SCALE: 1" = 10'

NOTE: SEE SHEET 110 OF 370 FOR ADDITIONAL INFORMATION

**** SEE NOTE NO. 4 ON SHEET BR231.

This drawing contains information proprietary to the Reinforced Earth Company, and is being furnished for the use of VERMONT AGENCY OF TRANSPORTATION only in connection with this project, and the information contained herein is not to be transmitted to any other organization unless specifically authorized in writing by The Reinforced Earth Company. The Reinforced Earth Company is exclusive licensee in the United States under patents issued to Henri Vidal, and the furnishing of this drawing does not constitute an expressed or implied license under the Vidal patents.

The design contained on these drawings is based on information provided by the owner. On the basis of this information, The Reinforced Earth Company has designed, and is responsible for the internal stability of the structure only. External stability, including foundation (bearing capacity and settlement) and slope (global) stability, is the responsibility of the owner.

The Reinforced Earth Company
8614 Westwood Center Drive Suite 1100, Vienna, Virginia 22182 (703) 821-1175
"REINFORCED EARTH" is the registered trademark of The Reinforced Earth Company.

DESIGNED BY:	KPB	PROJECT ENGR:	KPB	CHECKED BY:	PLA	ENG. MANAGER	REV.	DATE	DESCRIPTION	PROJECT NAME	FAIRFAX-FAIRFIELD-ST. ALBANS I-89 OVER VT 104	DATE	2-15-01
LOCATION	FAIRFAX-FAIRFIELD-ST. ALBANS VERMONT	OWNER	VT AOT	DRAWING NO.	4024	SCALE	AS SHOWN						
DRAWING COVERS	ELEVATION - WALL NO. 2												

