
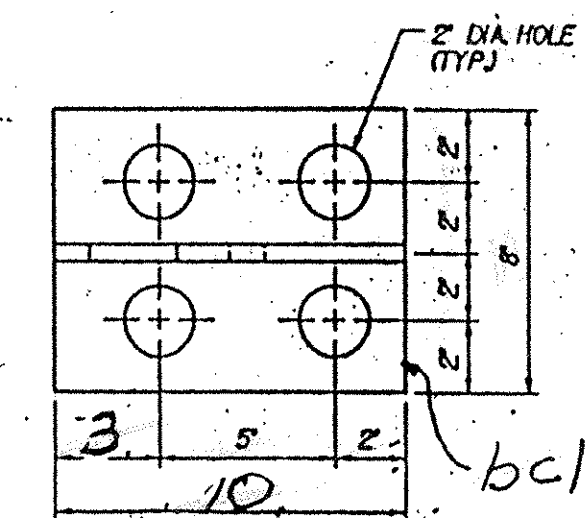
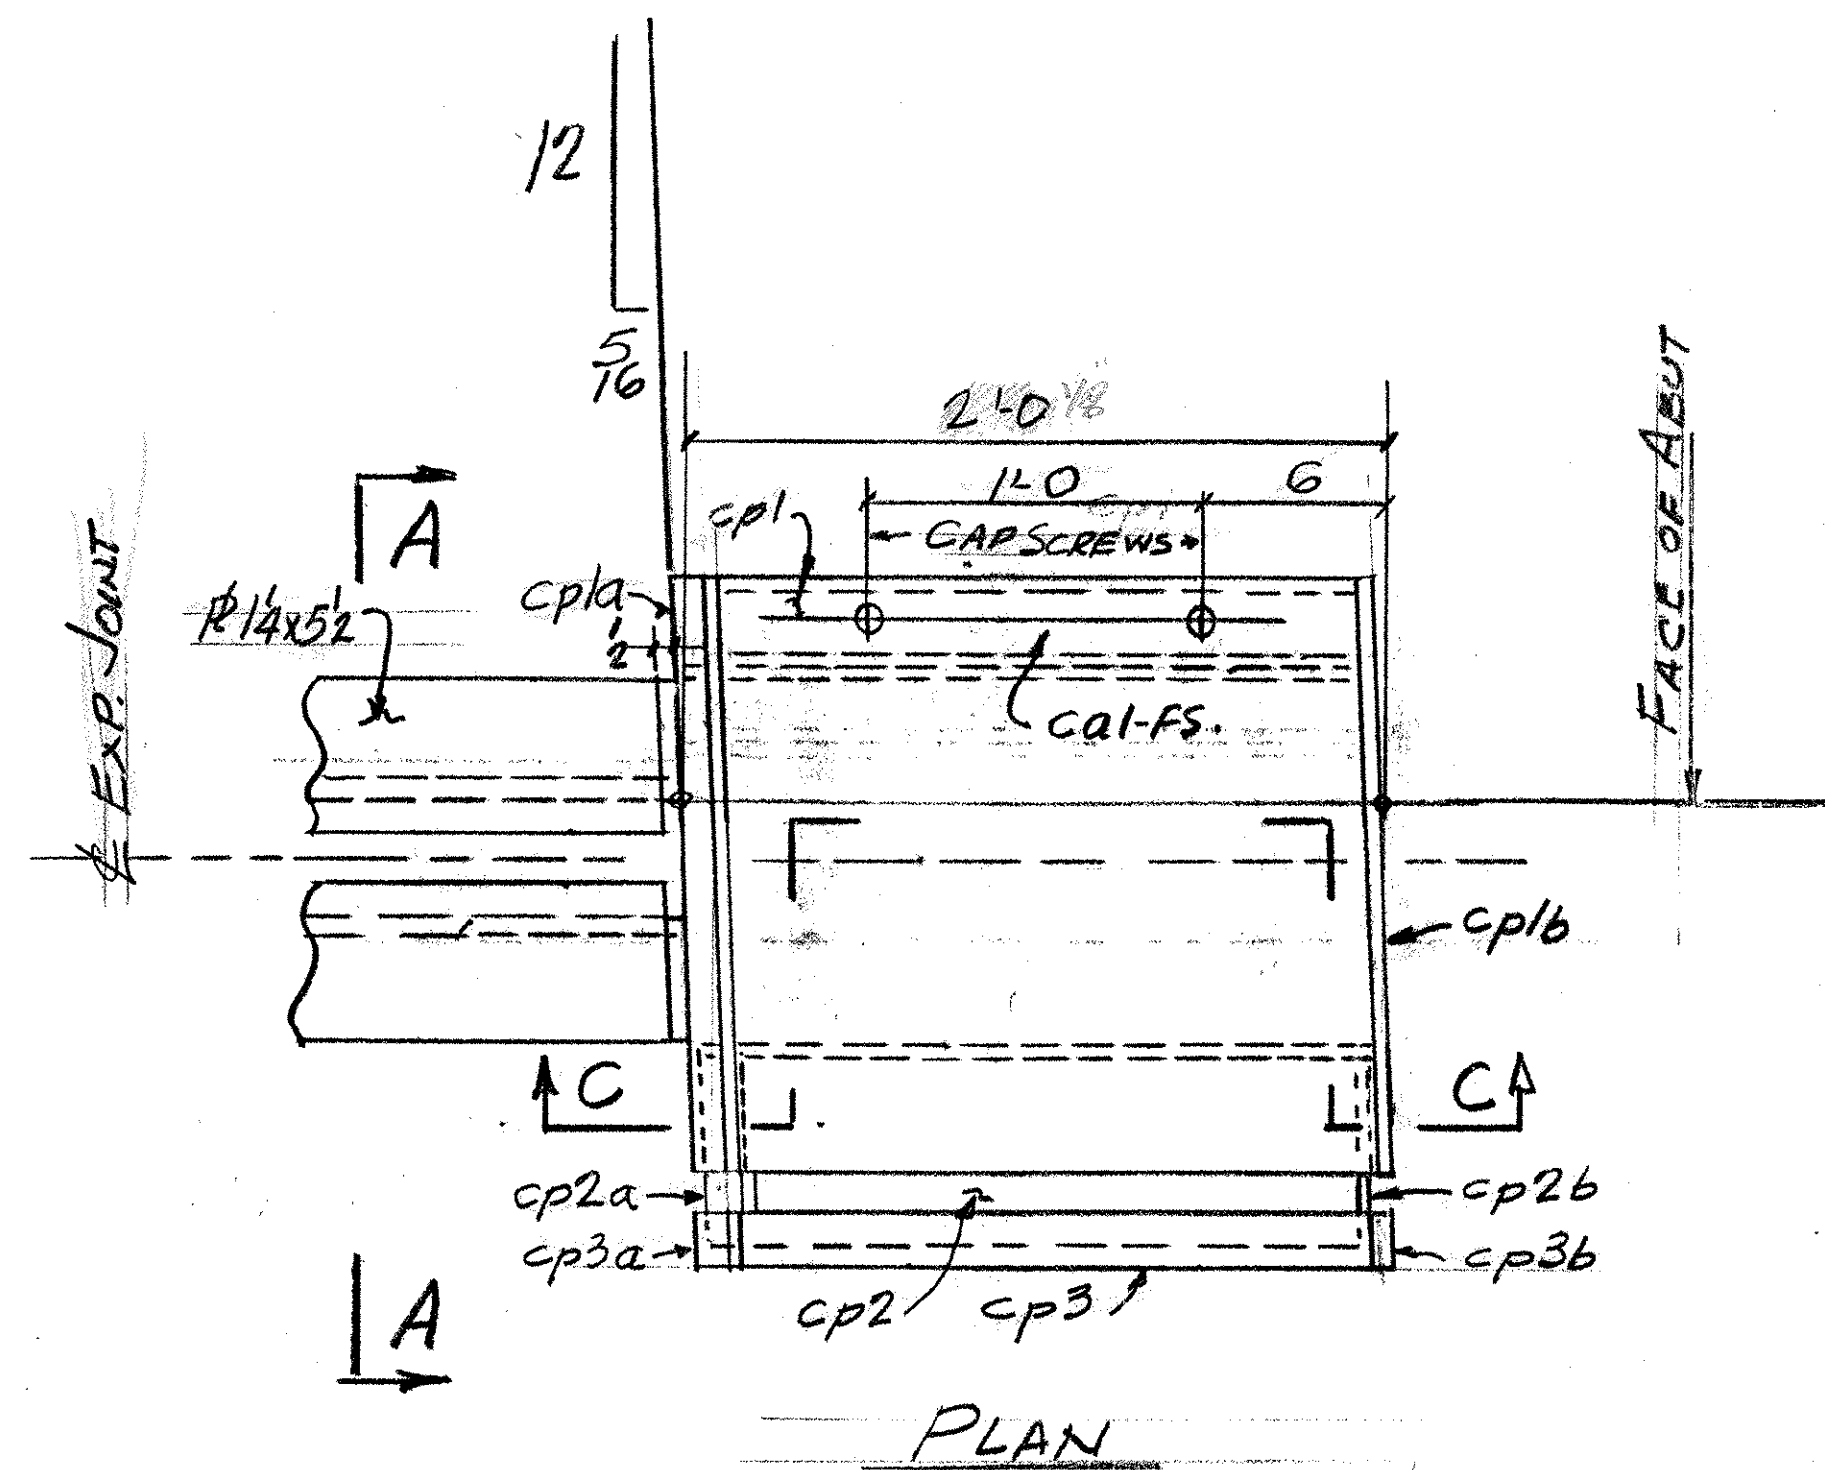
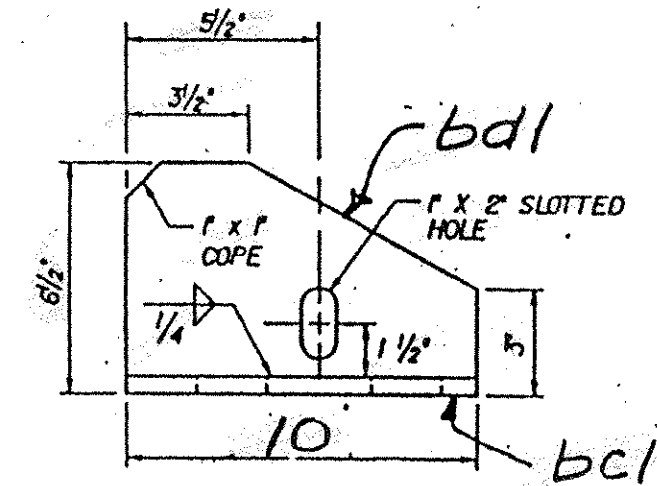
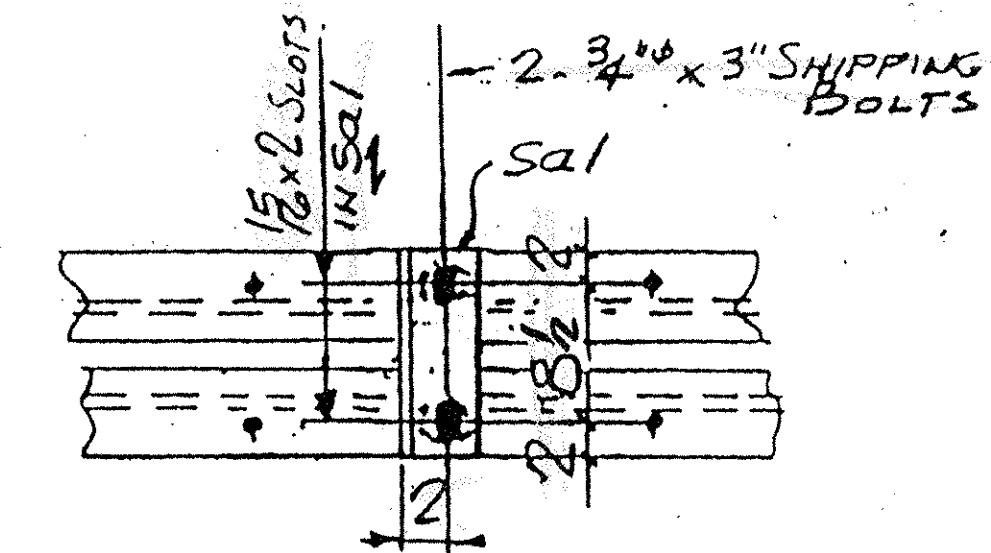



BRACKET PLANBRACKET ELEVATION

SHIPPING DEVICE
SPACED 540.00 MAX. (8 REQ'D)

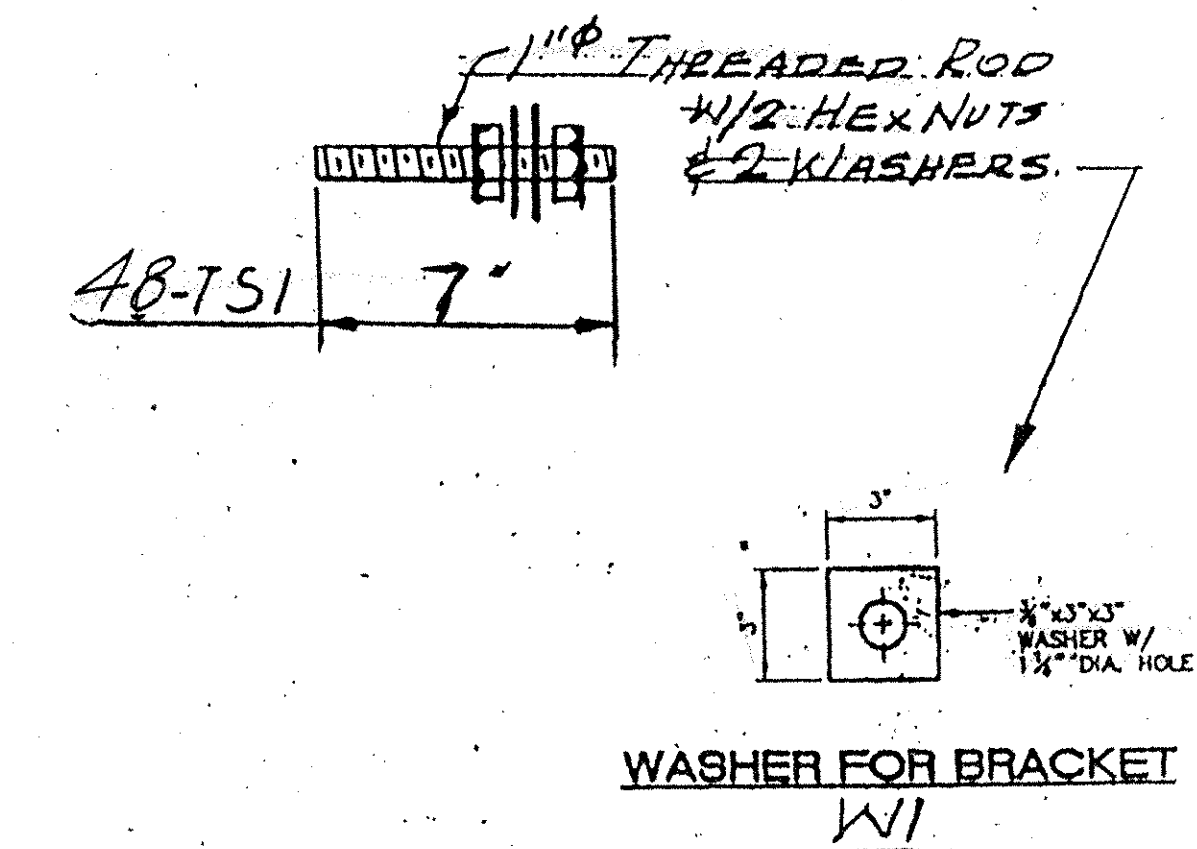


WASHER FOR BRACKET
WI

WORK THIS DWG. W/ DWG. 11

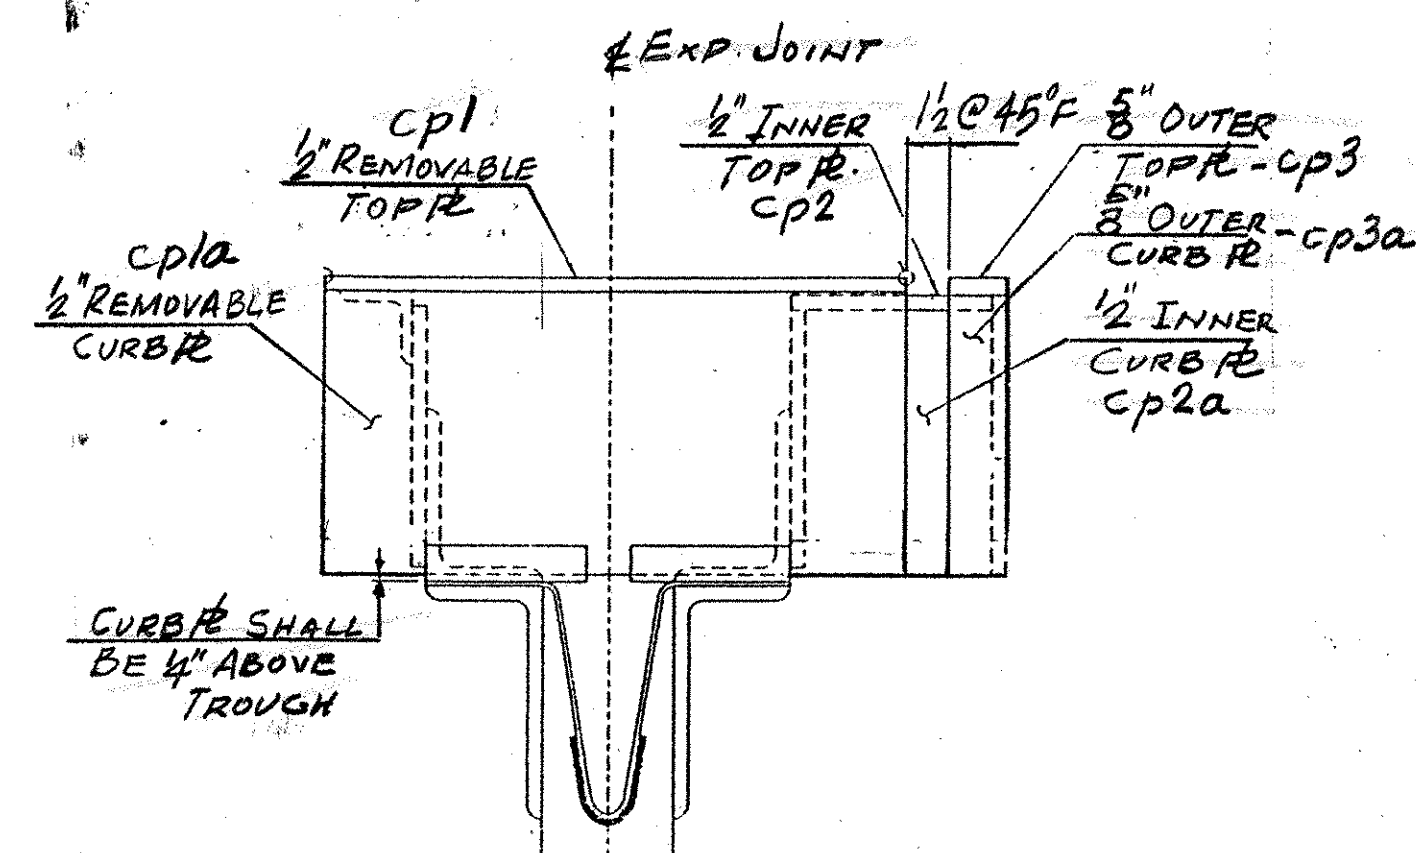


SECTION A-A

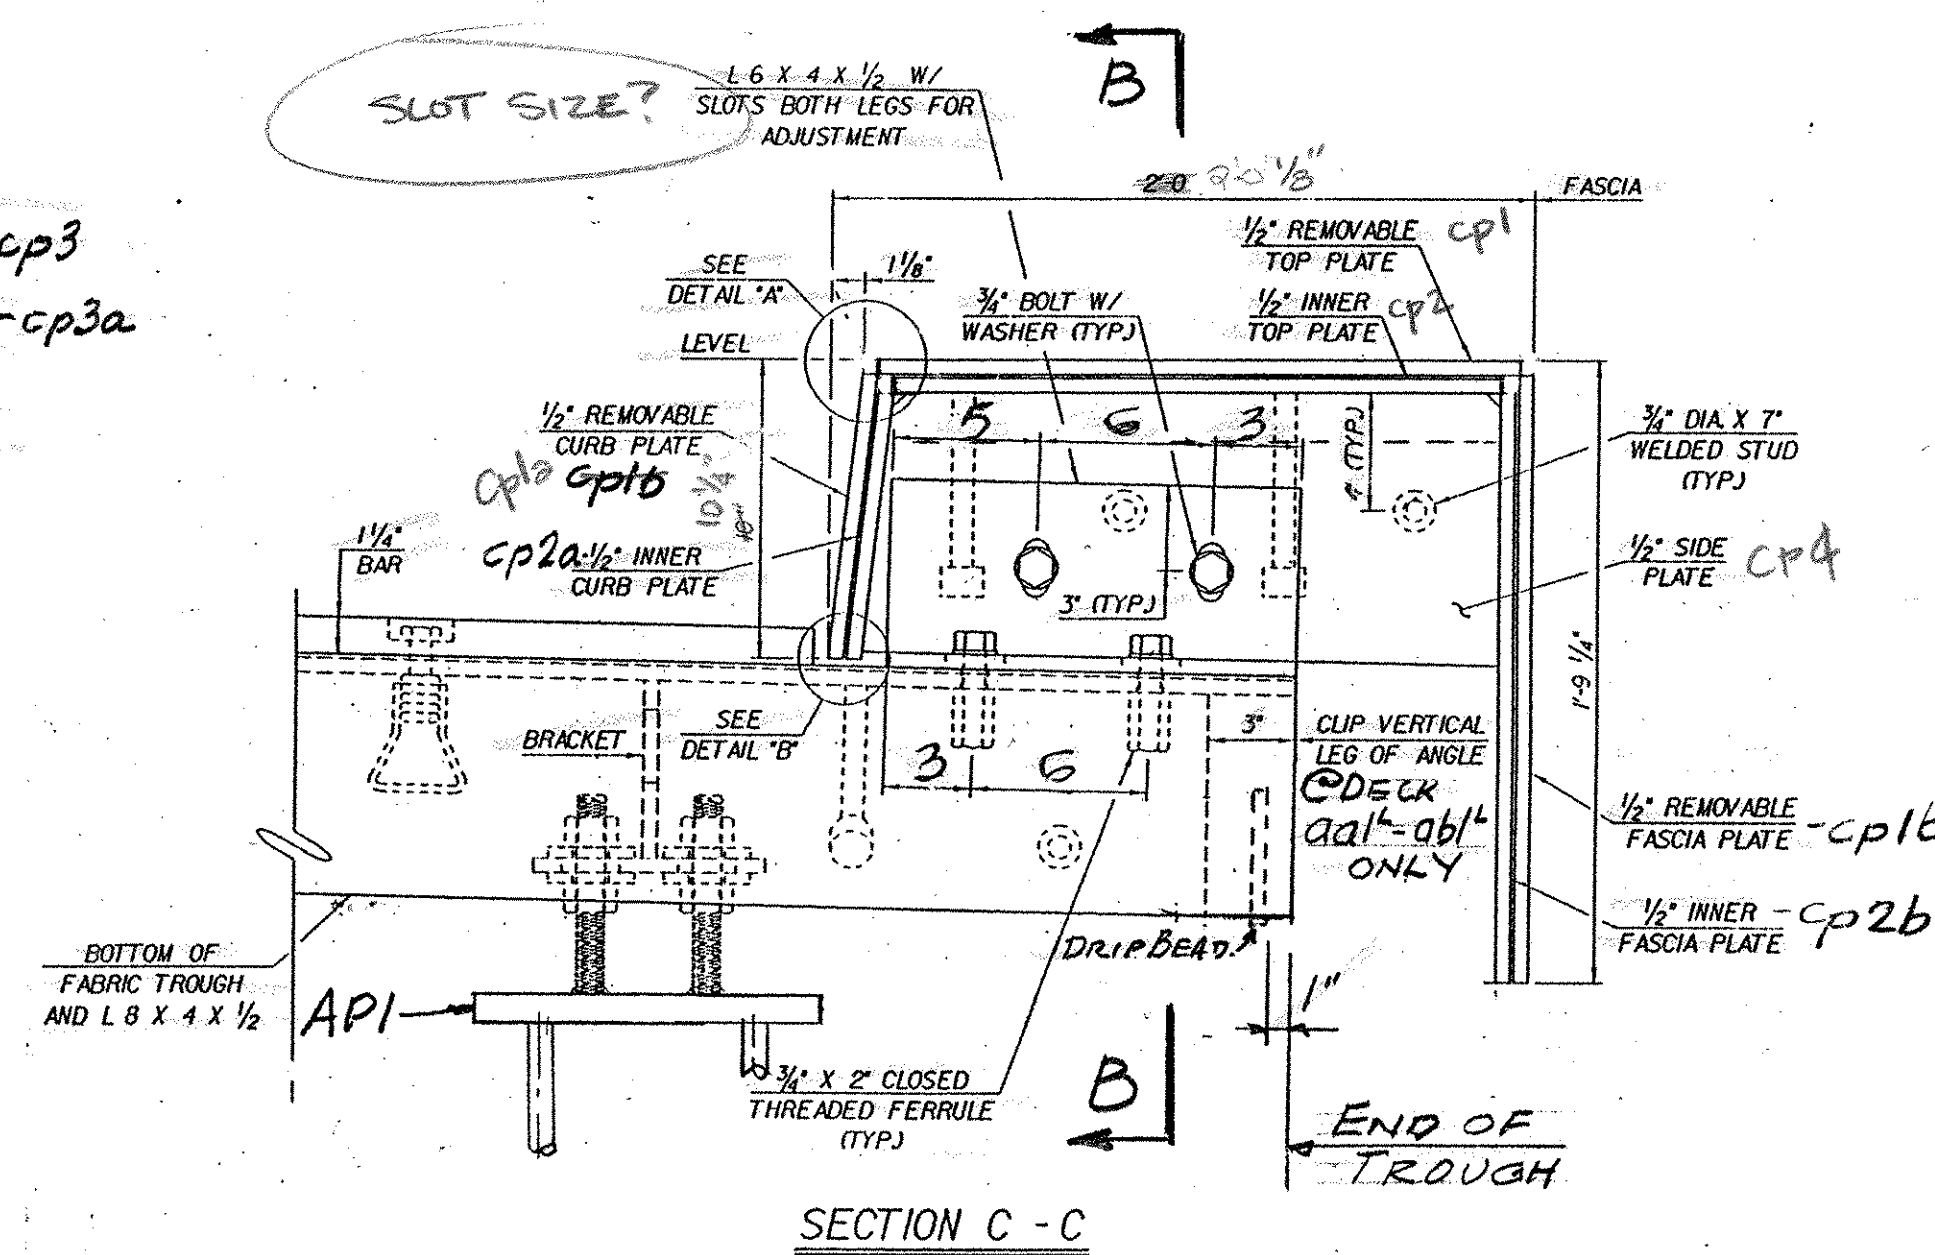


SECTION C - C

RIGHT END BRUSH CURB SHOWN
LEFT END - OPP HAND.

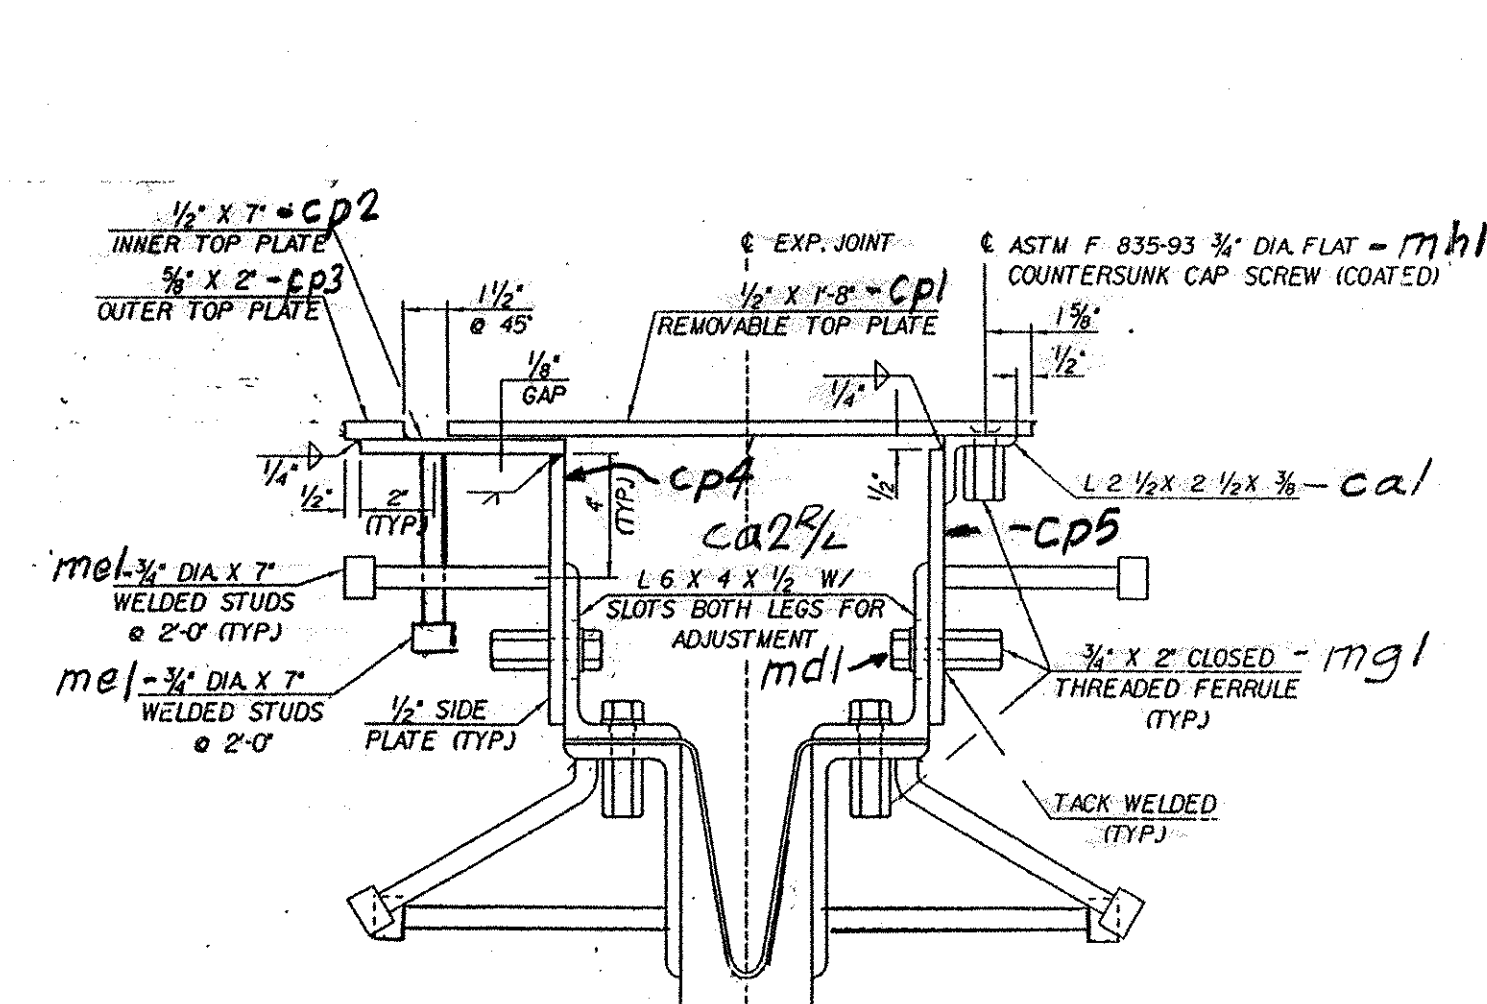

SECTION B-B

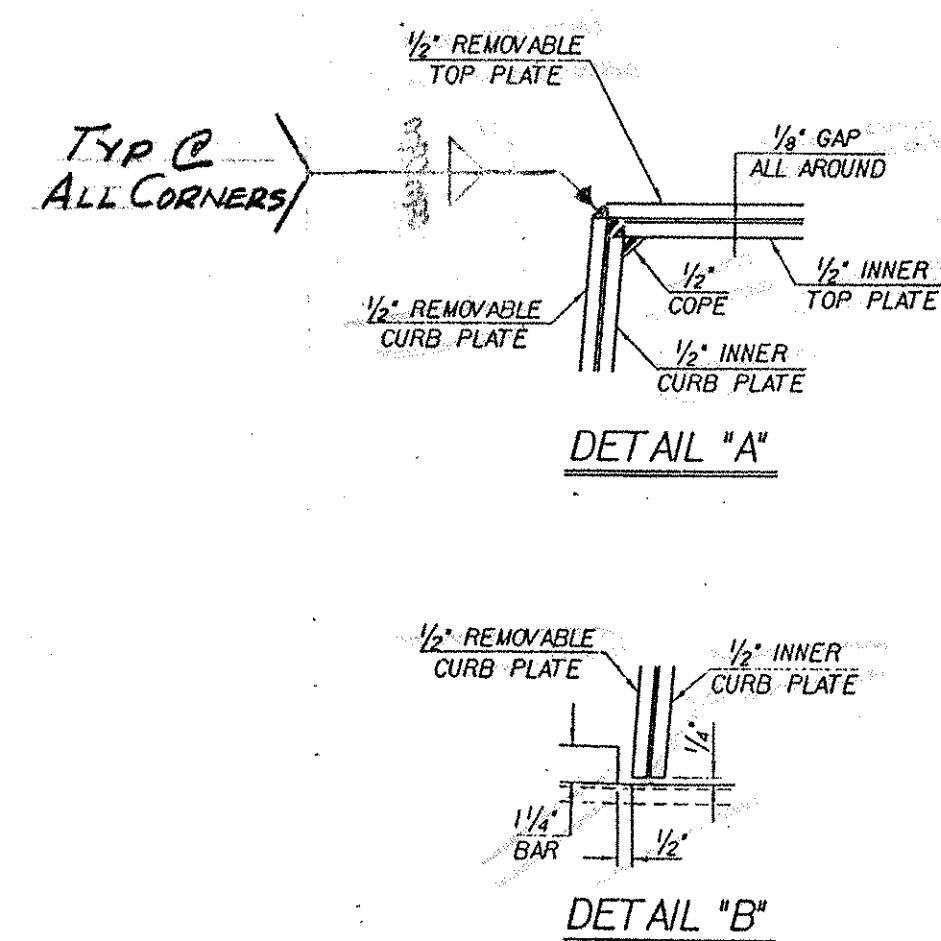

DETAIL "B"

API-6-REQ'D
DO NOT GALVANIZE

VAOT
RECEIVED
CK'D BY SEL OK'D BY C. Roy
4-3-01
MAR 29 2001
RESUBMIT _____ APPROVED VA NOTED
BY mel DATE 4-17-01

OUT FOR APPROVAL	3-23-01														
OUT FOR APPROVAL															
ISSUED TO SHOP															
FIELD & OFFICE															
REV.	REMARKS	DATE	DWN	CHK	APP	Q.A.	NO.	DIA.	LGT	TYPE	WASHER				
	PROJECT NO. <u>IM-089-3(27)</u> STATE <u>BRIDGENO.</u> <u>88S</u>														
	MATERIAL <u>AS SHD</u> ELECTRODES: <u>PER</u> HOLES: <u>AS NOTED</u> SHOP BOLTS: <u>7/16</u>														
	<u>M20x60</u> <u>FRG.</u> <u>17-164</u>														
SURFACE PREP. & PAINT:															
<u>GALVANIZED AFTER FAB. - U.N.</u>															
DESCRIPTION: <u>EXP. JOINT - ABUT. NO. 6</u>												DRAWN BY		DATE	
JOB: <u>BRIDGE 88S</u>												JPf		3-01	
<u>T-89 OVER ST. ALBANS SO. STATE HIGHWAY</u>												CHKD BY			
<u>FAIRFAX - FAIRFIELD - ST. ALBANS, VT.</u>												APPROV BY			
												Q.A.			
CUSTOMER: <u>J.A. McDONALD</u>															
CASCO BAY STEEL STRUCTURES, INC.												JOB NO.		DRG. NO.	
75 SPRING HILL ROAD												132		JIA	
PHONE (207) 282-7360												437		REV. ☒	
SACO, MAINE 04072															
FAX. (207) 282-1179															