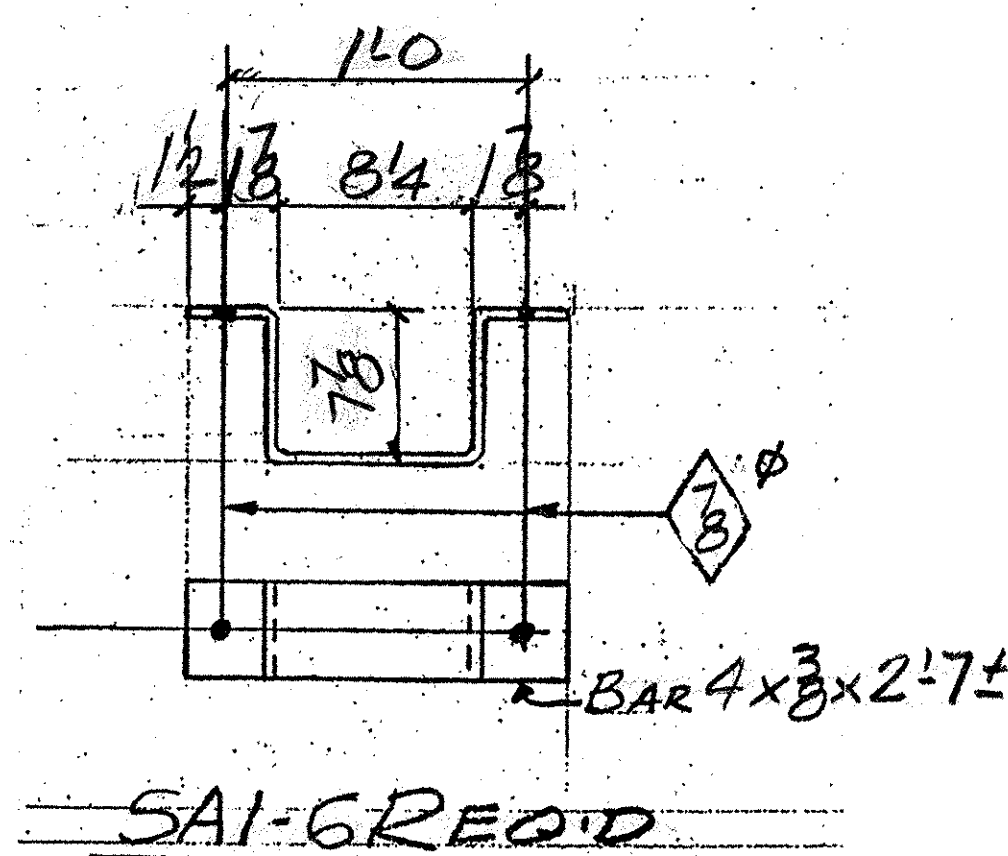
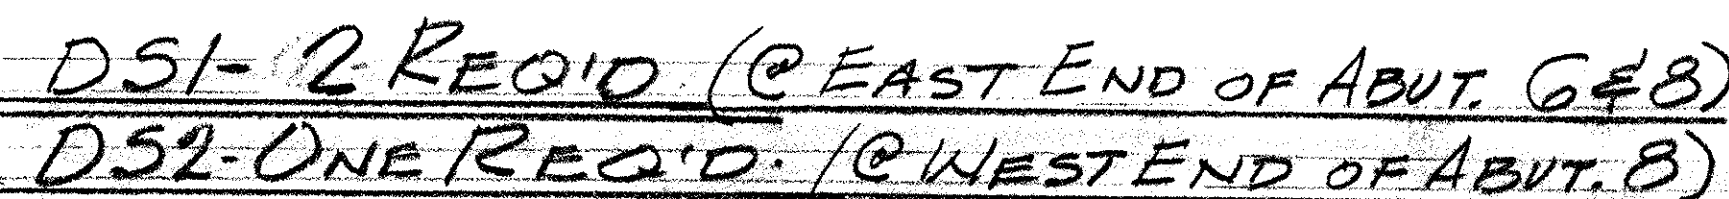


PAY ITENI 506.60

REV.	REMARKS	DATE	DWN	CHK	APP	Q.A.	NO.	DIA.	LGT	TYPE	WASHE
PROJECT NO. <i>IM-089-3(27)</i> STATE BRIDGE NO. <i>885E 88N</i>											
MATERIAL: <i>AASHTO</i>		ELECTRODES: <i>PER</i>		HOLES: <i>AS NOTED</i>		SHOP BOLTS: <i>—</i>					
M270-6230		PROC. —									
SURFACE PREP. & PAINT:											

GALVANIZED AFTER FAB.
PER ASTM-A-123

DESCRIPTION: <u>DOWNSPOUTS ABUT. 1648</u>	DRAWN BY	DATE
JOB: <u>BRIDGE 885488N</u>	JPF	3-01
<u>I-89 OVER ST. ALBANS SO. STATE HIGHWAY</u>	CHKD BY	
<u>FAIRFAX - FAIRFIELD - ST. ALBANS, VT.</u>	EU	
	APPROV BY	
	Q.A.	
CUSTOMER: <u>J.A. McDONALD</u>		
CASCO BAY STEEL STRUCTURES, INC.	JOB NO.	DRG. NO.
75 SPRING HILL ROAD	132	DI
SACO, MAINE 04072	440	REV. 1
PHONE (207) 282-7360		
FAX. (207) 282-1179		