

CONSTRUCTION SPECIFICATIONS


- ## DESIGN SPECIFICATIONS

- ## MATERIAL SPECIFICATIONS

- 4). "BUY AMERICA" PROVISIONS OF VERMONT SPEC. 107.22: AS MODIFIED
IN SPECIAL PROVISIONS ITEM 54 (DATED ~~2-8-93~~
5-4-99)

2). STUDS ARE FURNISHED AND FIELD APPLIED BY OTHERS.

3). PIECE MARKS WILL BE LOCATED AS SHOWN ON ERECTION DRAWINGS.

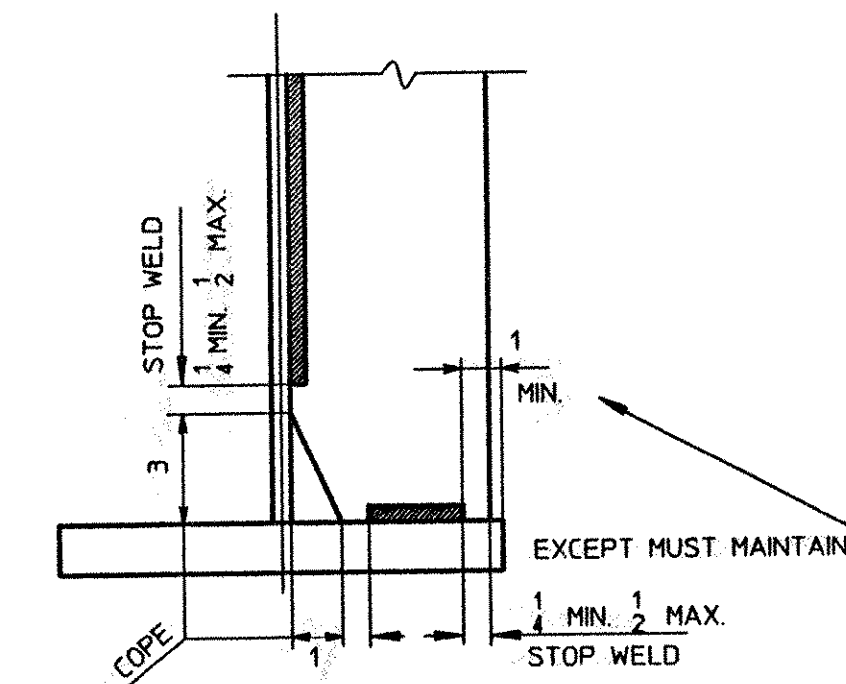

DETAIL 'WS1'

DESCRIPTION:	GENERAL NOTES	DRAWN BY	DATE
JOB:	1-89 OVER VT 104 BRIDGE 875 & 87 N 1-89 IMPROVEMENTS FAIRFAX FRANKLIN COUNTY	JAK CHKD BY WMJ APPROV BY SUPERVISOR	3/12/0 3/15/0 W. J. GATTI
			
PROJ NO.	IM 089-3(27)	Q.A.	
CUSTOMER: VERMONT AGENCY OF TRANSPORTATION		SHEET GNI OF GN	
CASCO BAY STEEL STRUCTURES, INC.			
75 SPRING HILL ROAD PHONE (207) 282-7360		SACO, MAINE 04072 FAX. (207) 282-1179	
		131 443	GN1 REV. 

140T
RECEIVED
CK'D BY mgf OK'D BY C. Poy
3-30-01 4-18-01
MAR 29 2001
RESUBMIT _____ APPROVED ✓
BY mgf DATE 4-18-01