

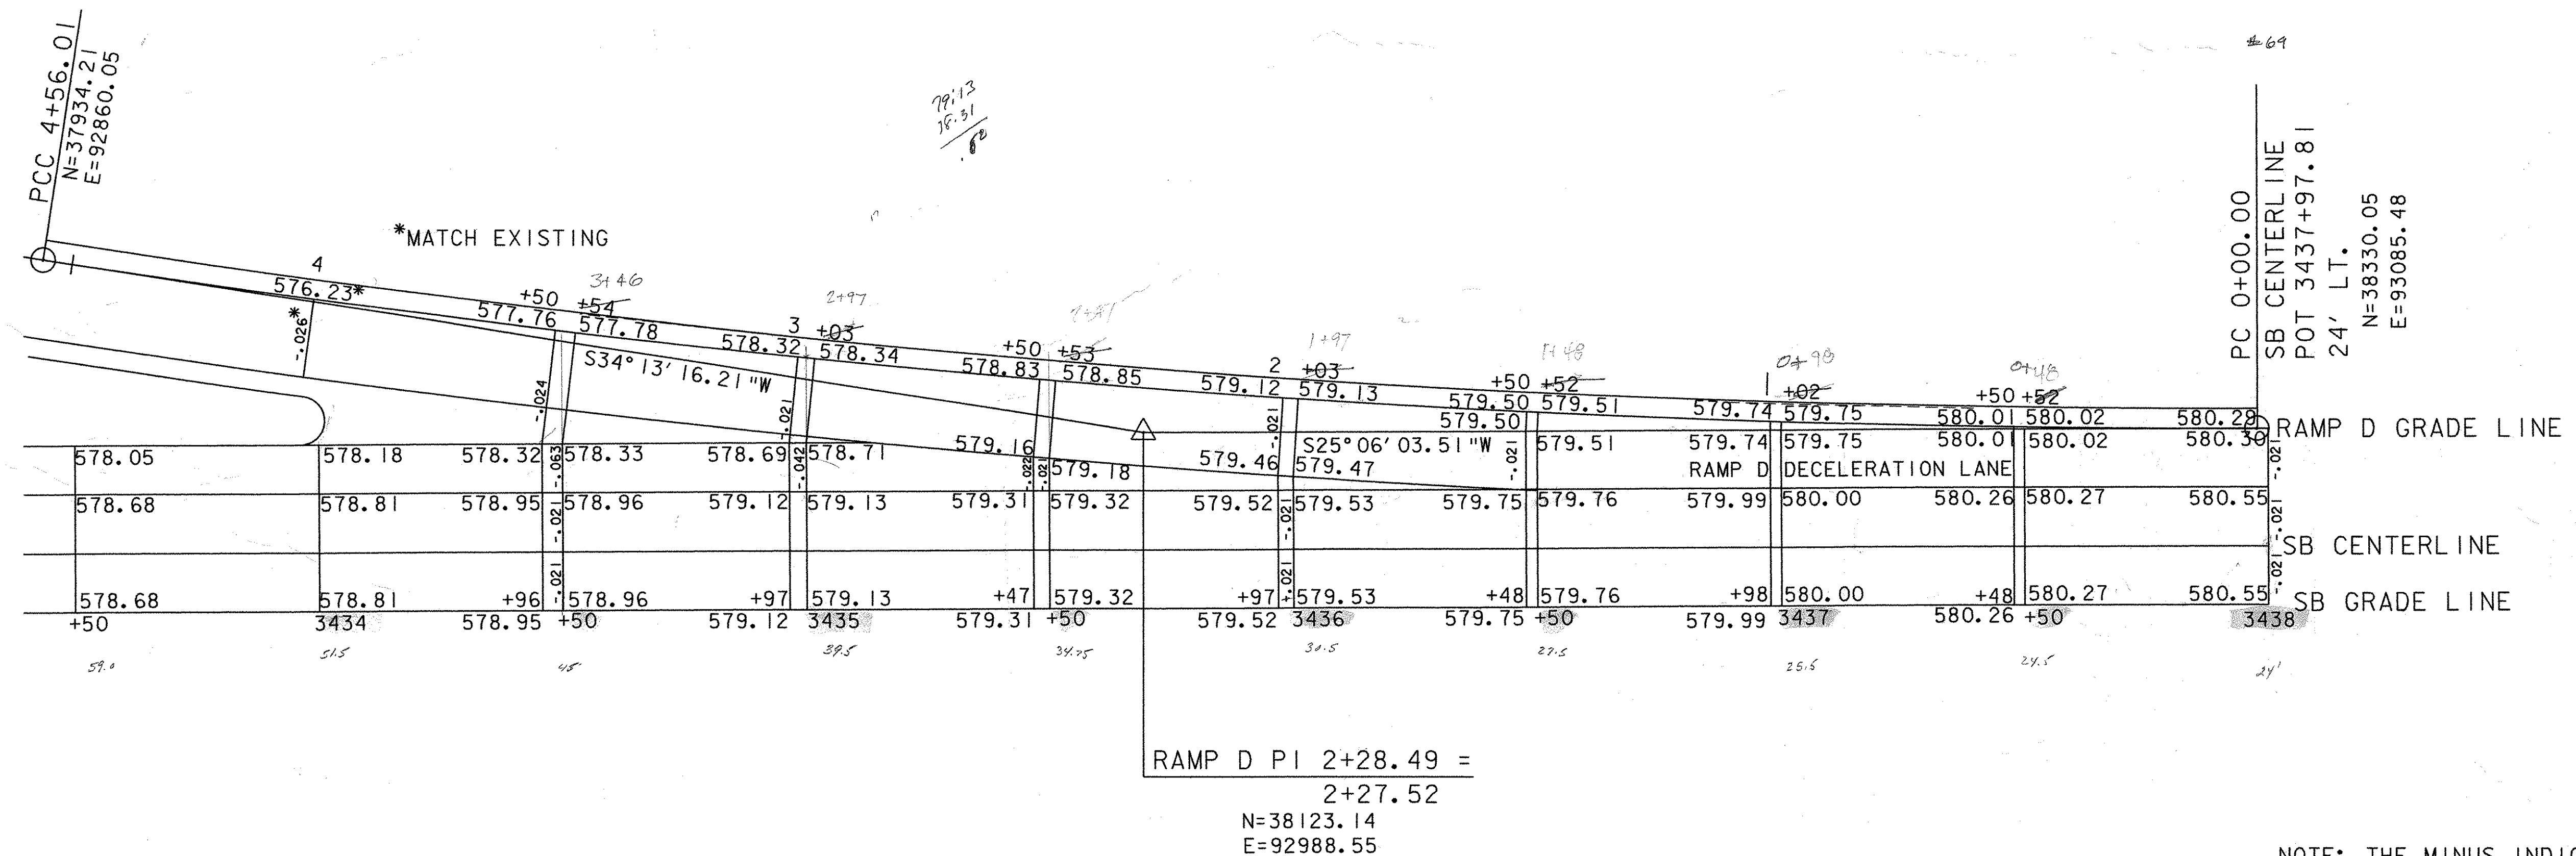


RAMP D CURVE DATA
 $\Delta = 9^{\circ}07'12.70''$ RT.
D = 2'
R = 2864.79'
T = 228.49'
L = 456.01'
E = 9.10'
BANK = 0.026 FT / FT

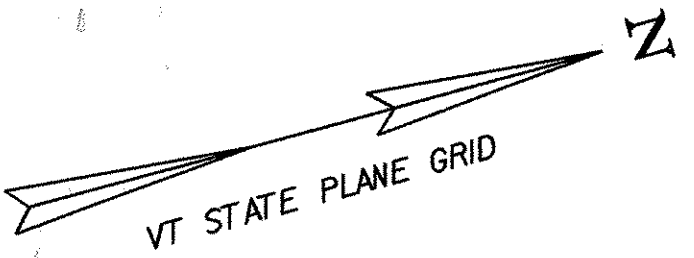

NOTE: THE MINUS INDICATION ON THE CROSS SLOPES IS IN REFERENCE TO THE SOUTHBOUND CENTERLINE.

PROJECT:	FAIRFAX - FAIRFIELD - ST. ALBANS	PROJECT NO.:	IM 089-3(27)
DESIGN FILE NAME:	/87A007B/DESIGN/DA007NUL.DGN	PLOT DATE:	17-MAY-2001
IPARM FILE NAME:	DA007DSP	SURVEY DATE:	6/98
SURVEYED BY:	ORVIS	DRAWN BY:	SQUAD B
SQUAD LEADER:	DELLA SANTA		

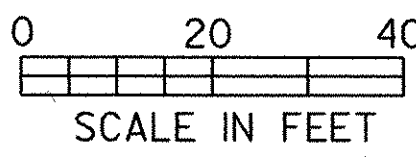

SPLINE SHEET FOR RAMP D MERGING WITH SOUTHBOUND