


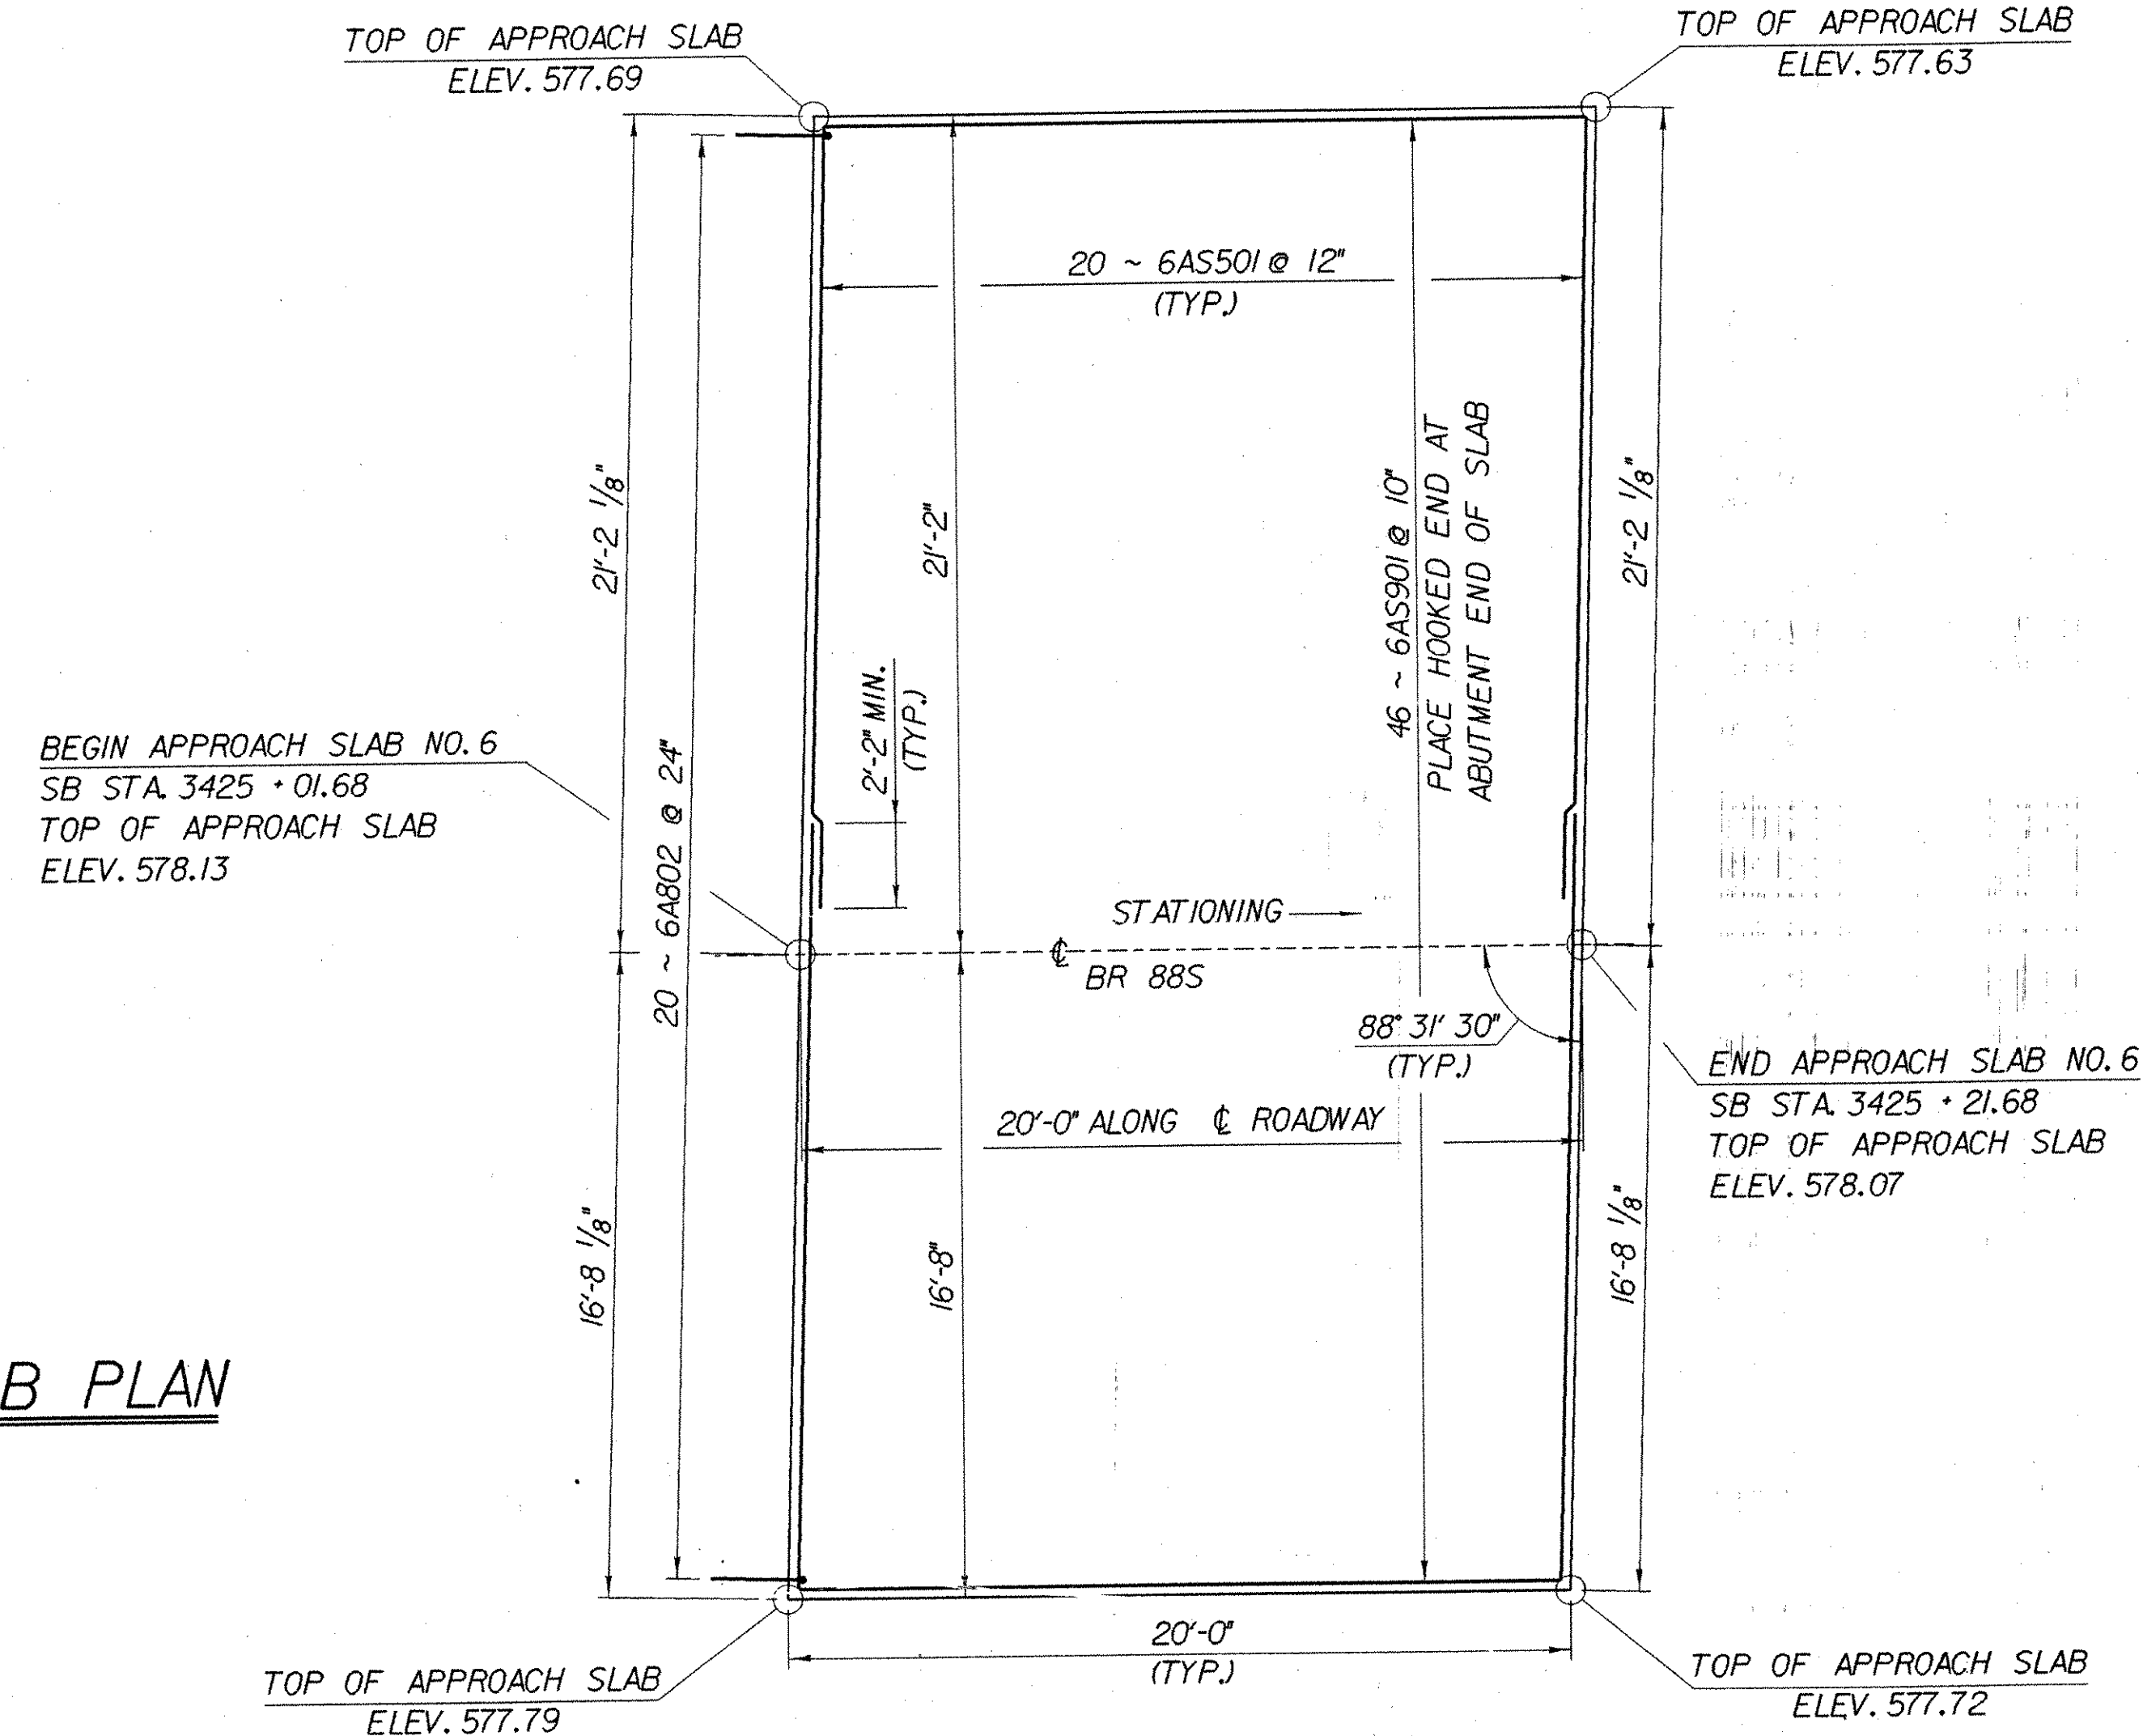


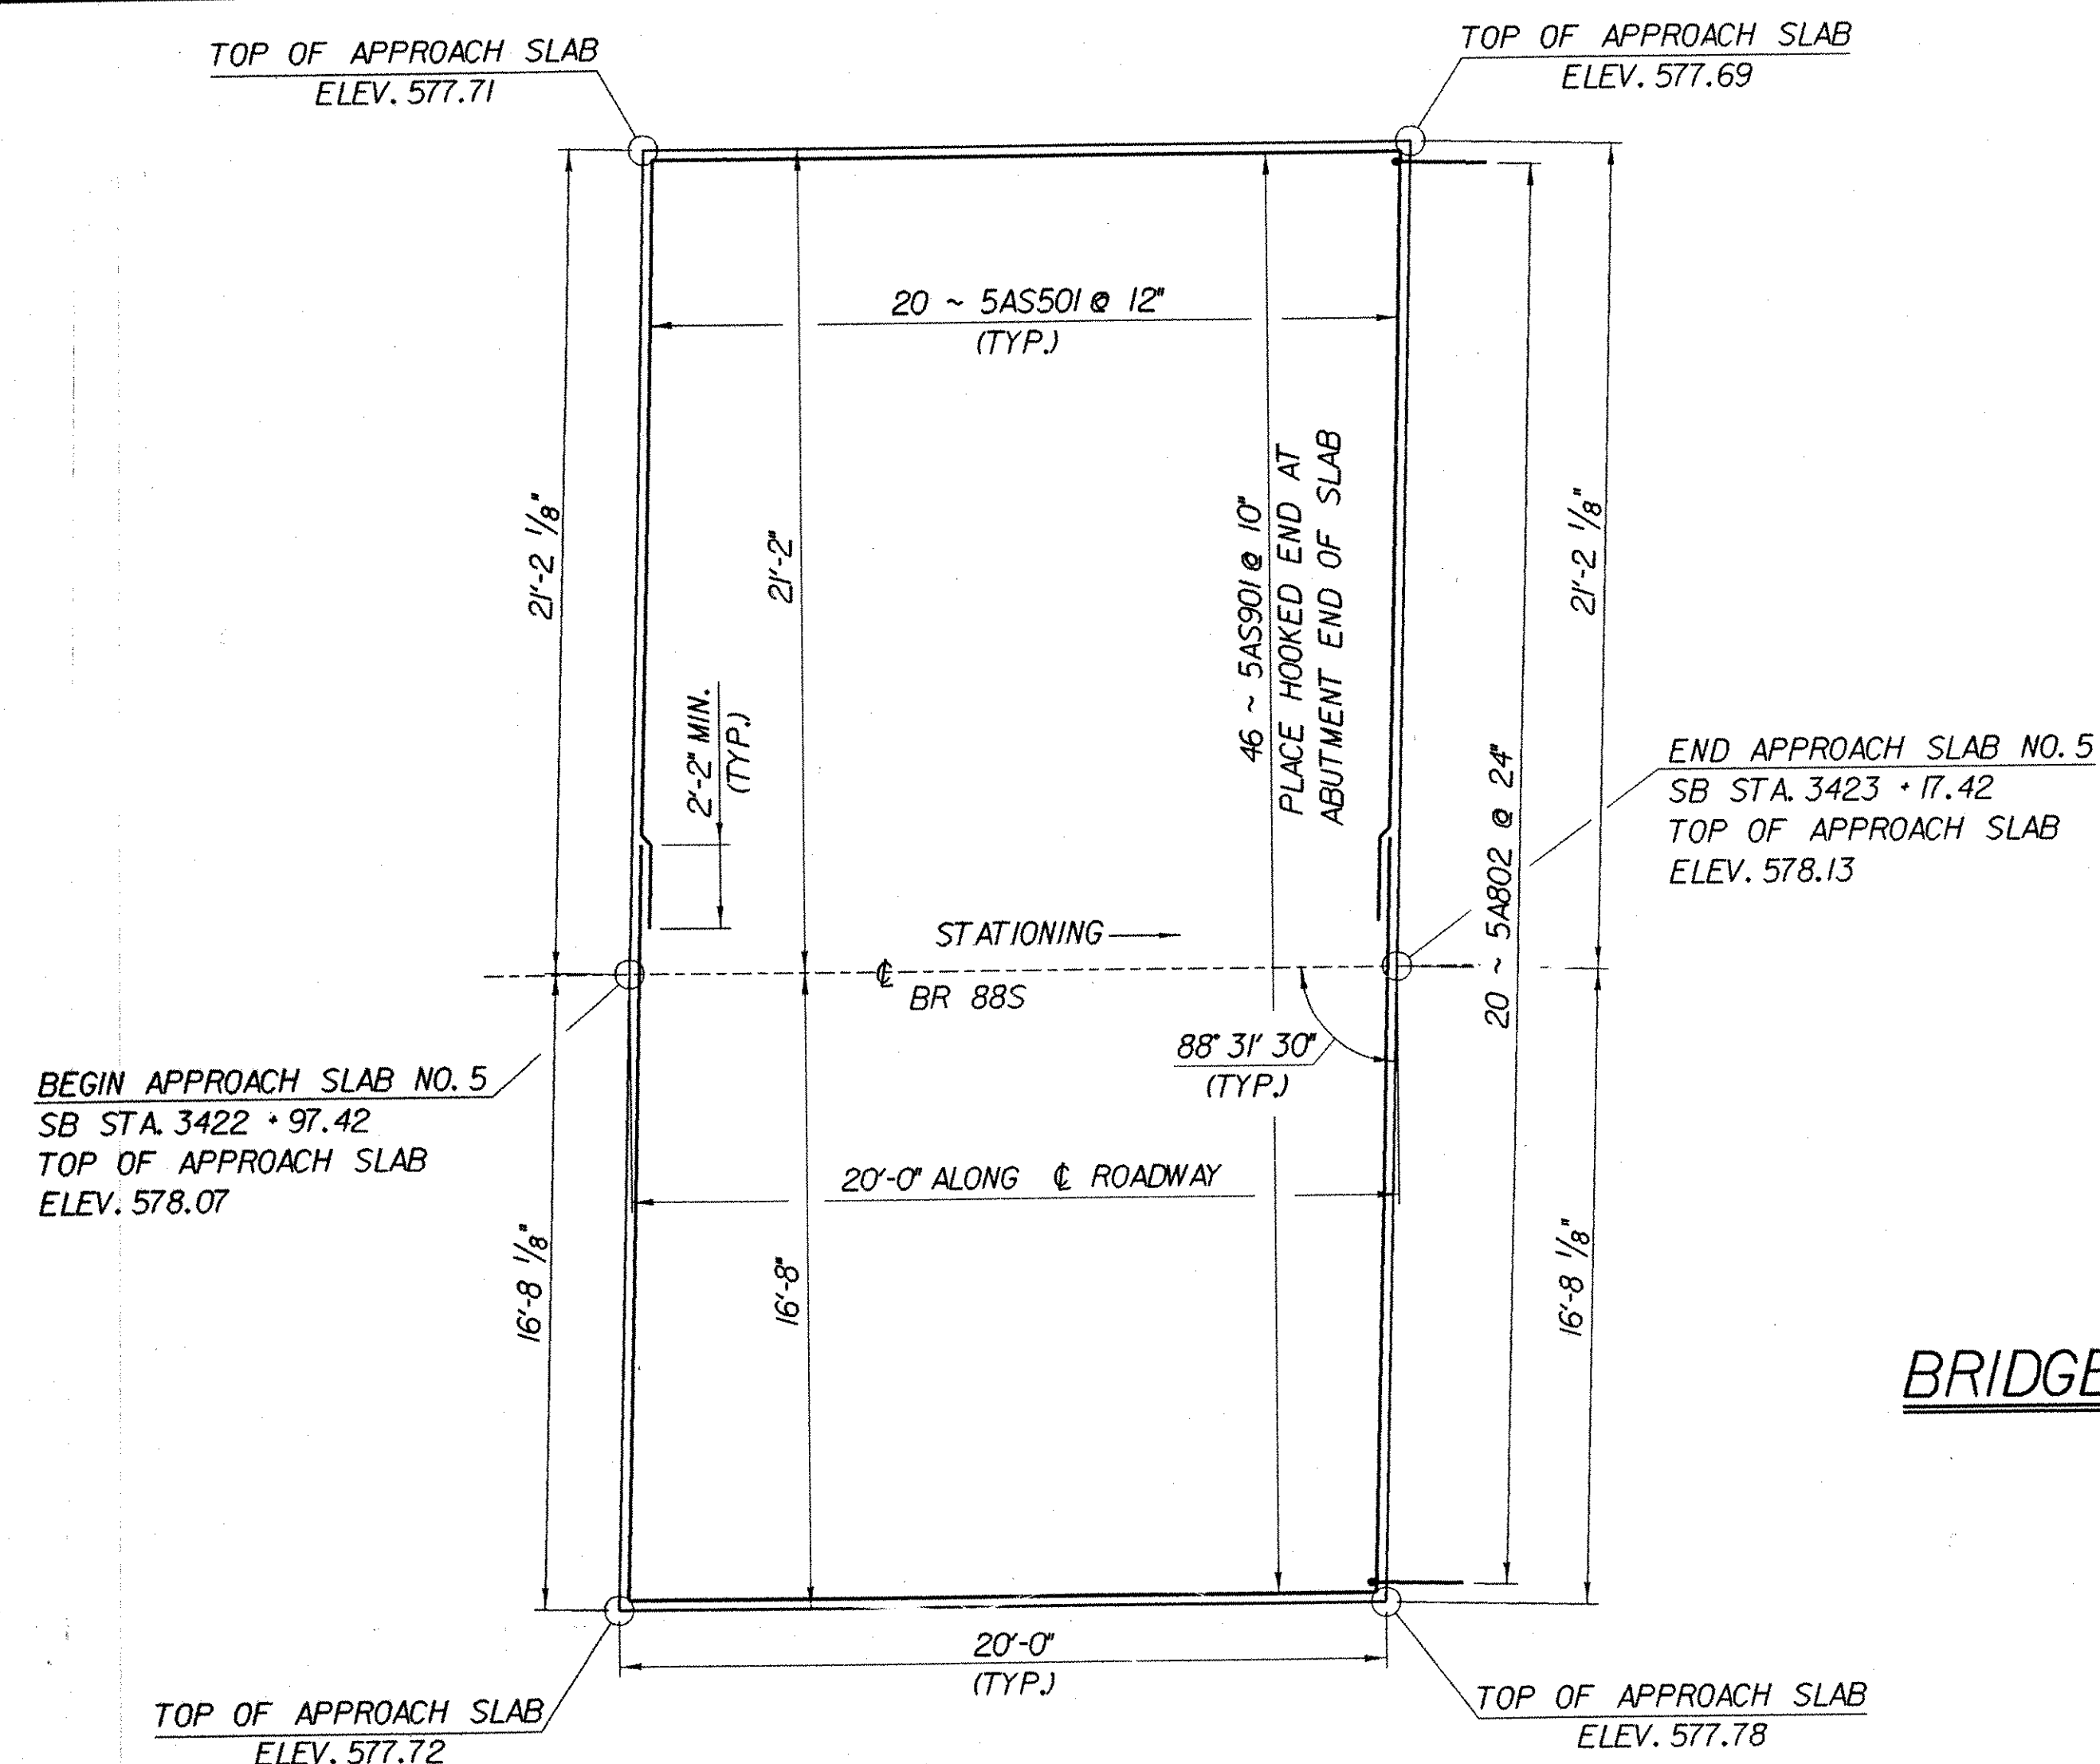


BRIDGE 88S APPROACH SLAB PLAN
SCALE: 1/4" = 1'-0"

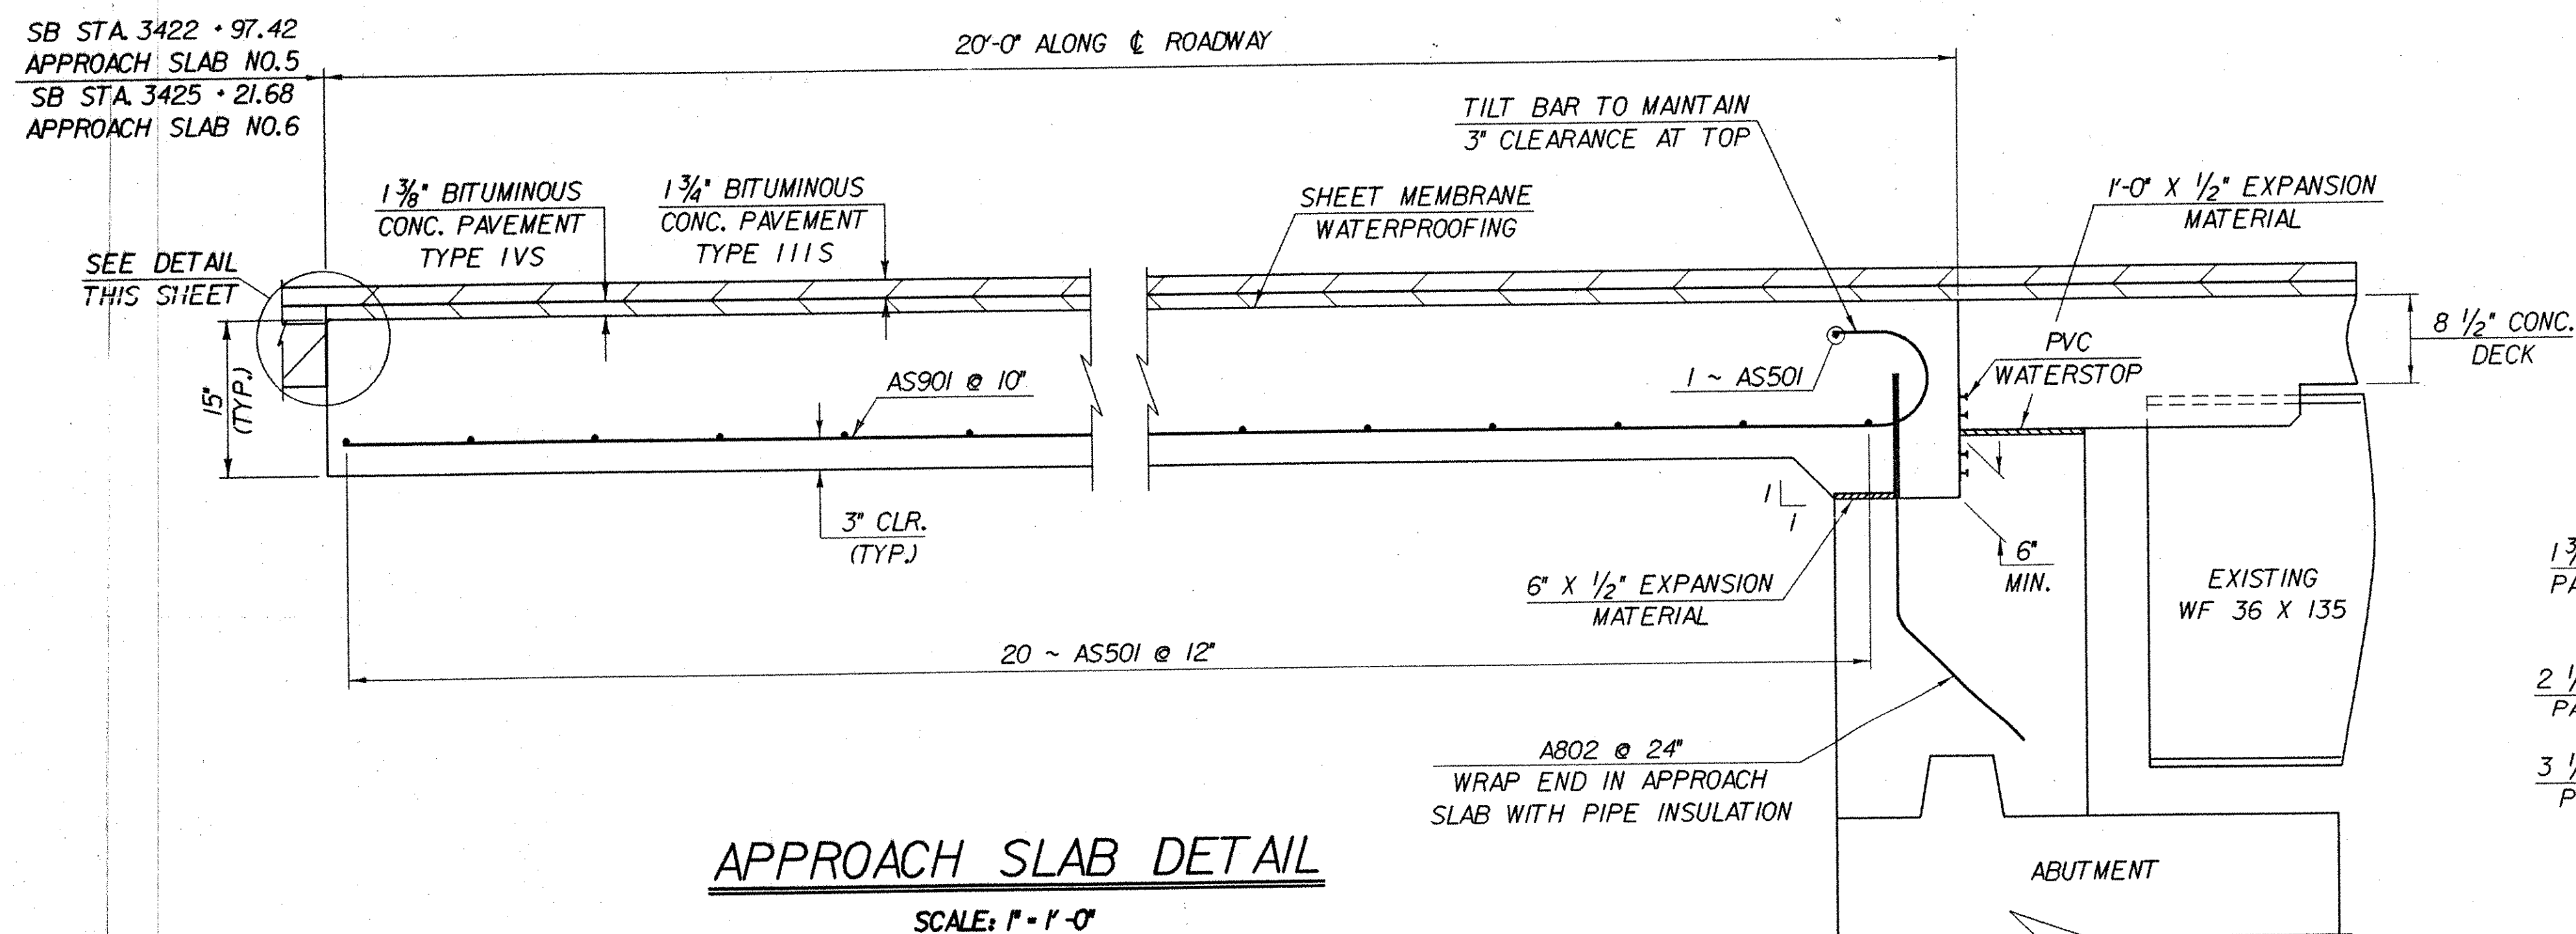

APPROACH SLAB DETAIL
SCALE: 1" = 1'-0"

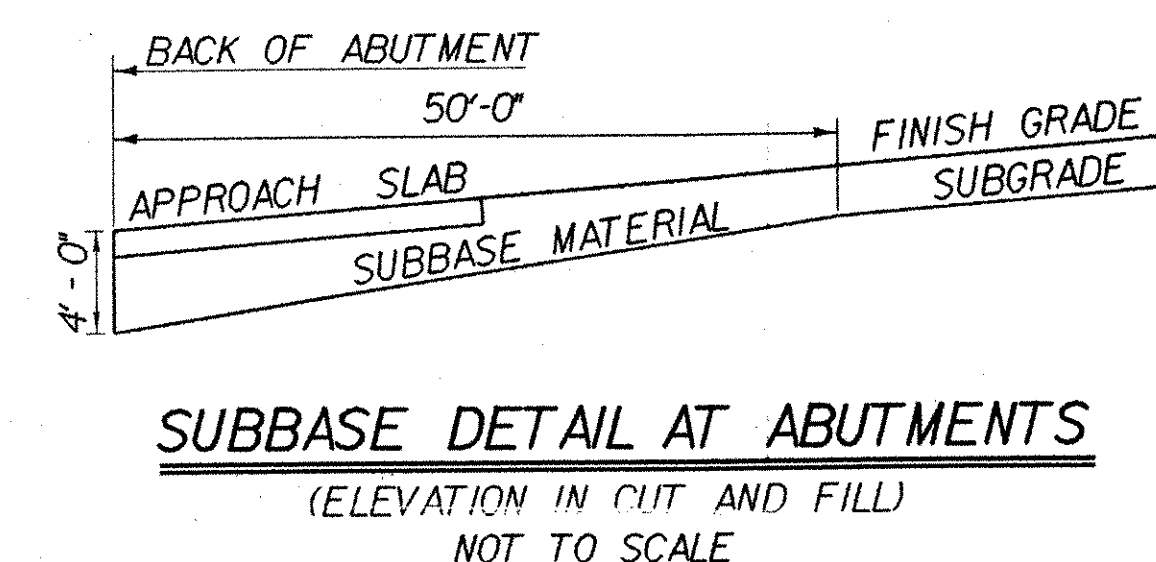

SUBBASE DETAIL AT ABUTMENTS
(ELEVATION IN CUT AND FILL)
NOT TO SCALE

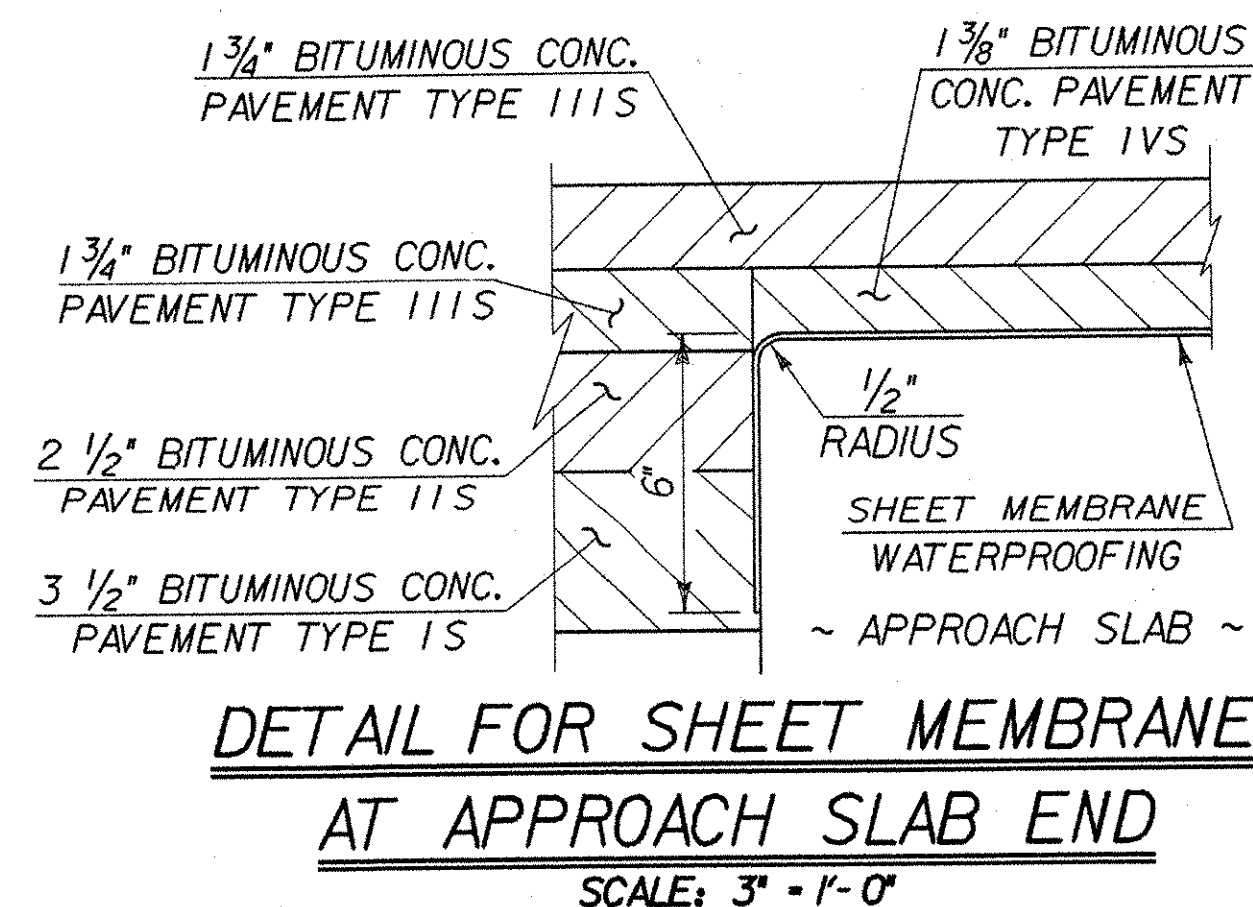

DETAIL FOR SHEET MEMBRANE AT APPROACH SLAB END
SCALE: 3" = 1'-0"

IMPORTANT NOTE: BRIDGE FINISHED GRADES ARE CENTERLINE GRADES.			
STATE OF VERMONT AGENCY OF TRANSPORTATION			
Town Of FAIRFAX-FAIRFIELD-ST. ALBANS	Bridge No. 88S		
Highway No. 1-89	Log Sta. Surv. Sta.		
1-89 OVER ST. ALBANS SOUTH STATE HIGHWAY (EXIT 19)			
88S APPROACH SLAB DETAILS			
Designed By M. LOZIER	Date 2/00	Drawn By K. CHISHOLM	Date 2/00
Checked By M. LOZIER	Date 2/00	Bridge Design Supervisor R. R. WHITCOMB	Date 2/00
PROJECT FAIRFAX-FAIRFIELD-ST. ALBANS		PROJECT NO. 1 M 089 - 3 (27)	
I.G.C. Info. 96a056Structures\sa056sp3.dgn		sa056apl	
Bridge Sheet No. BR429		Sheet 181 of 370	
PLOTTED 21-SEP-2000			