

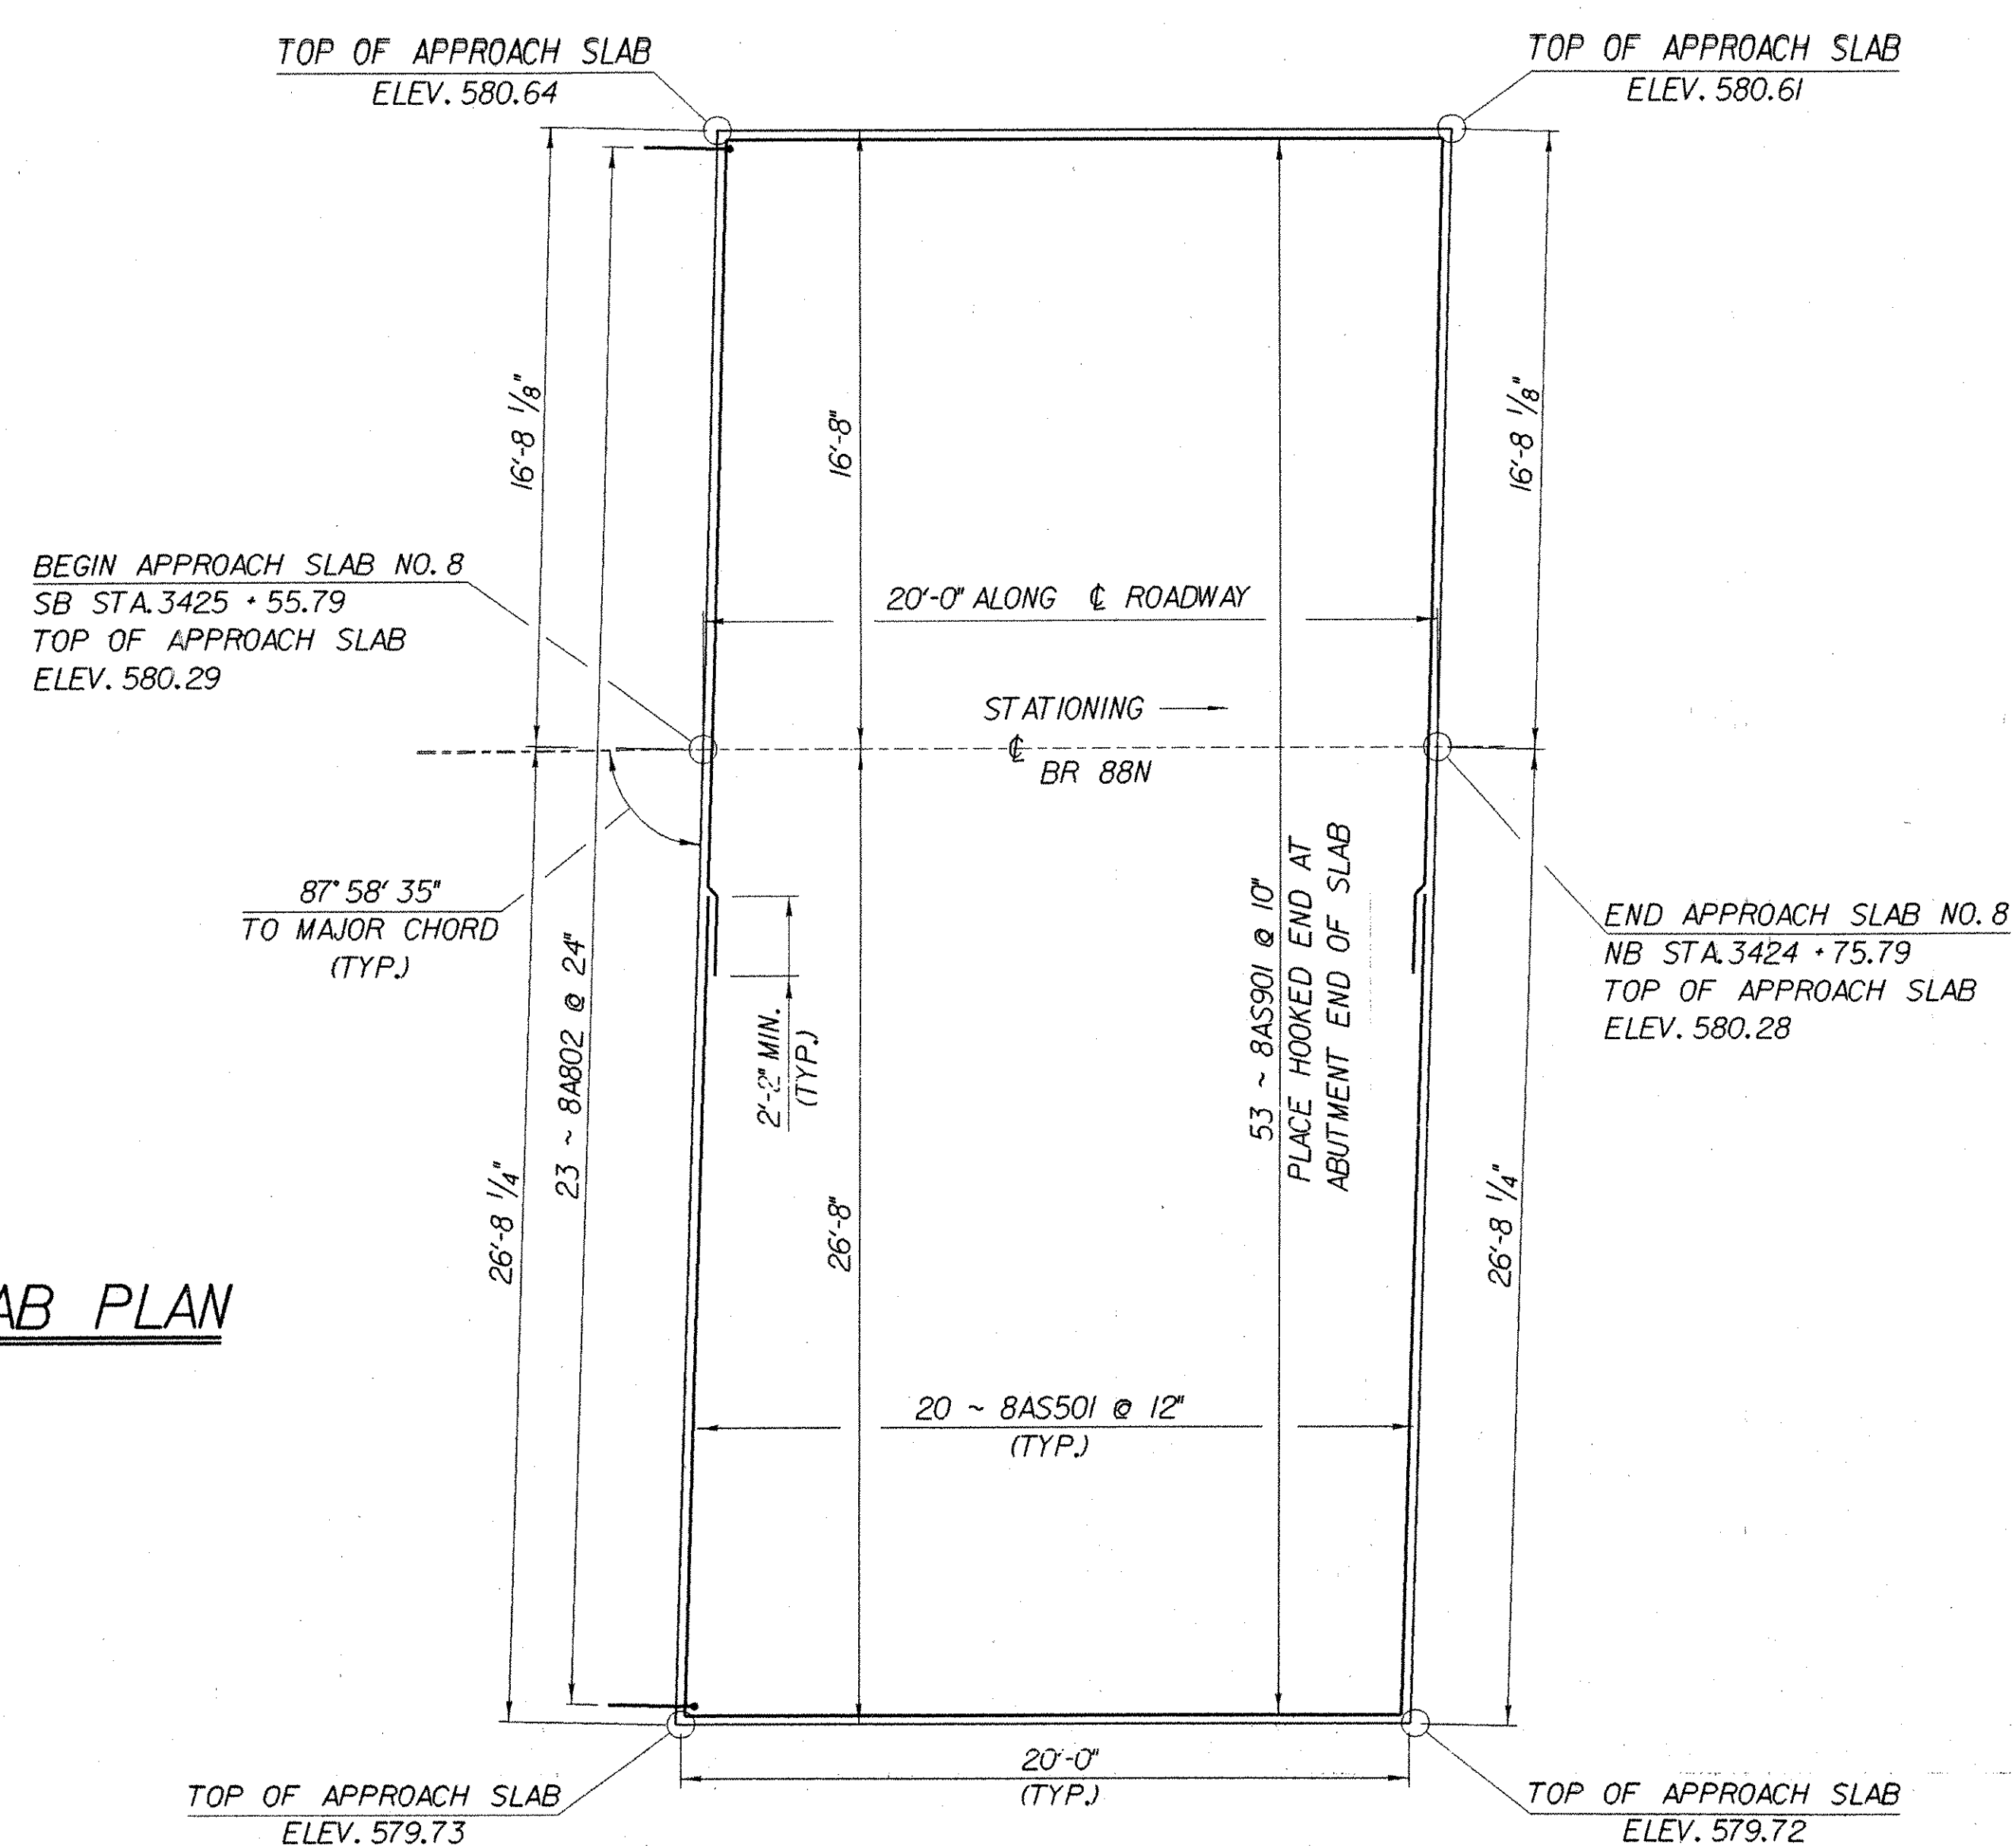


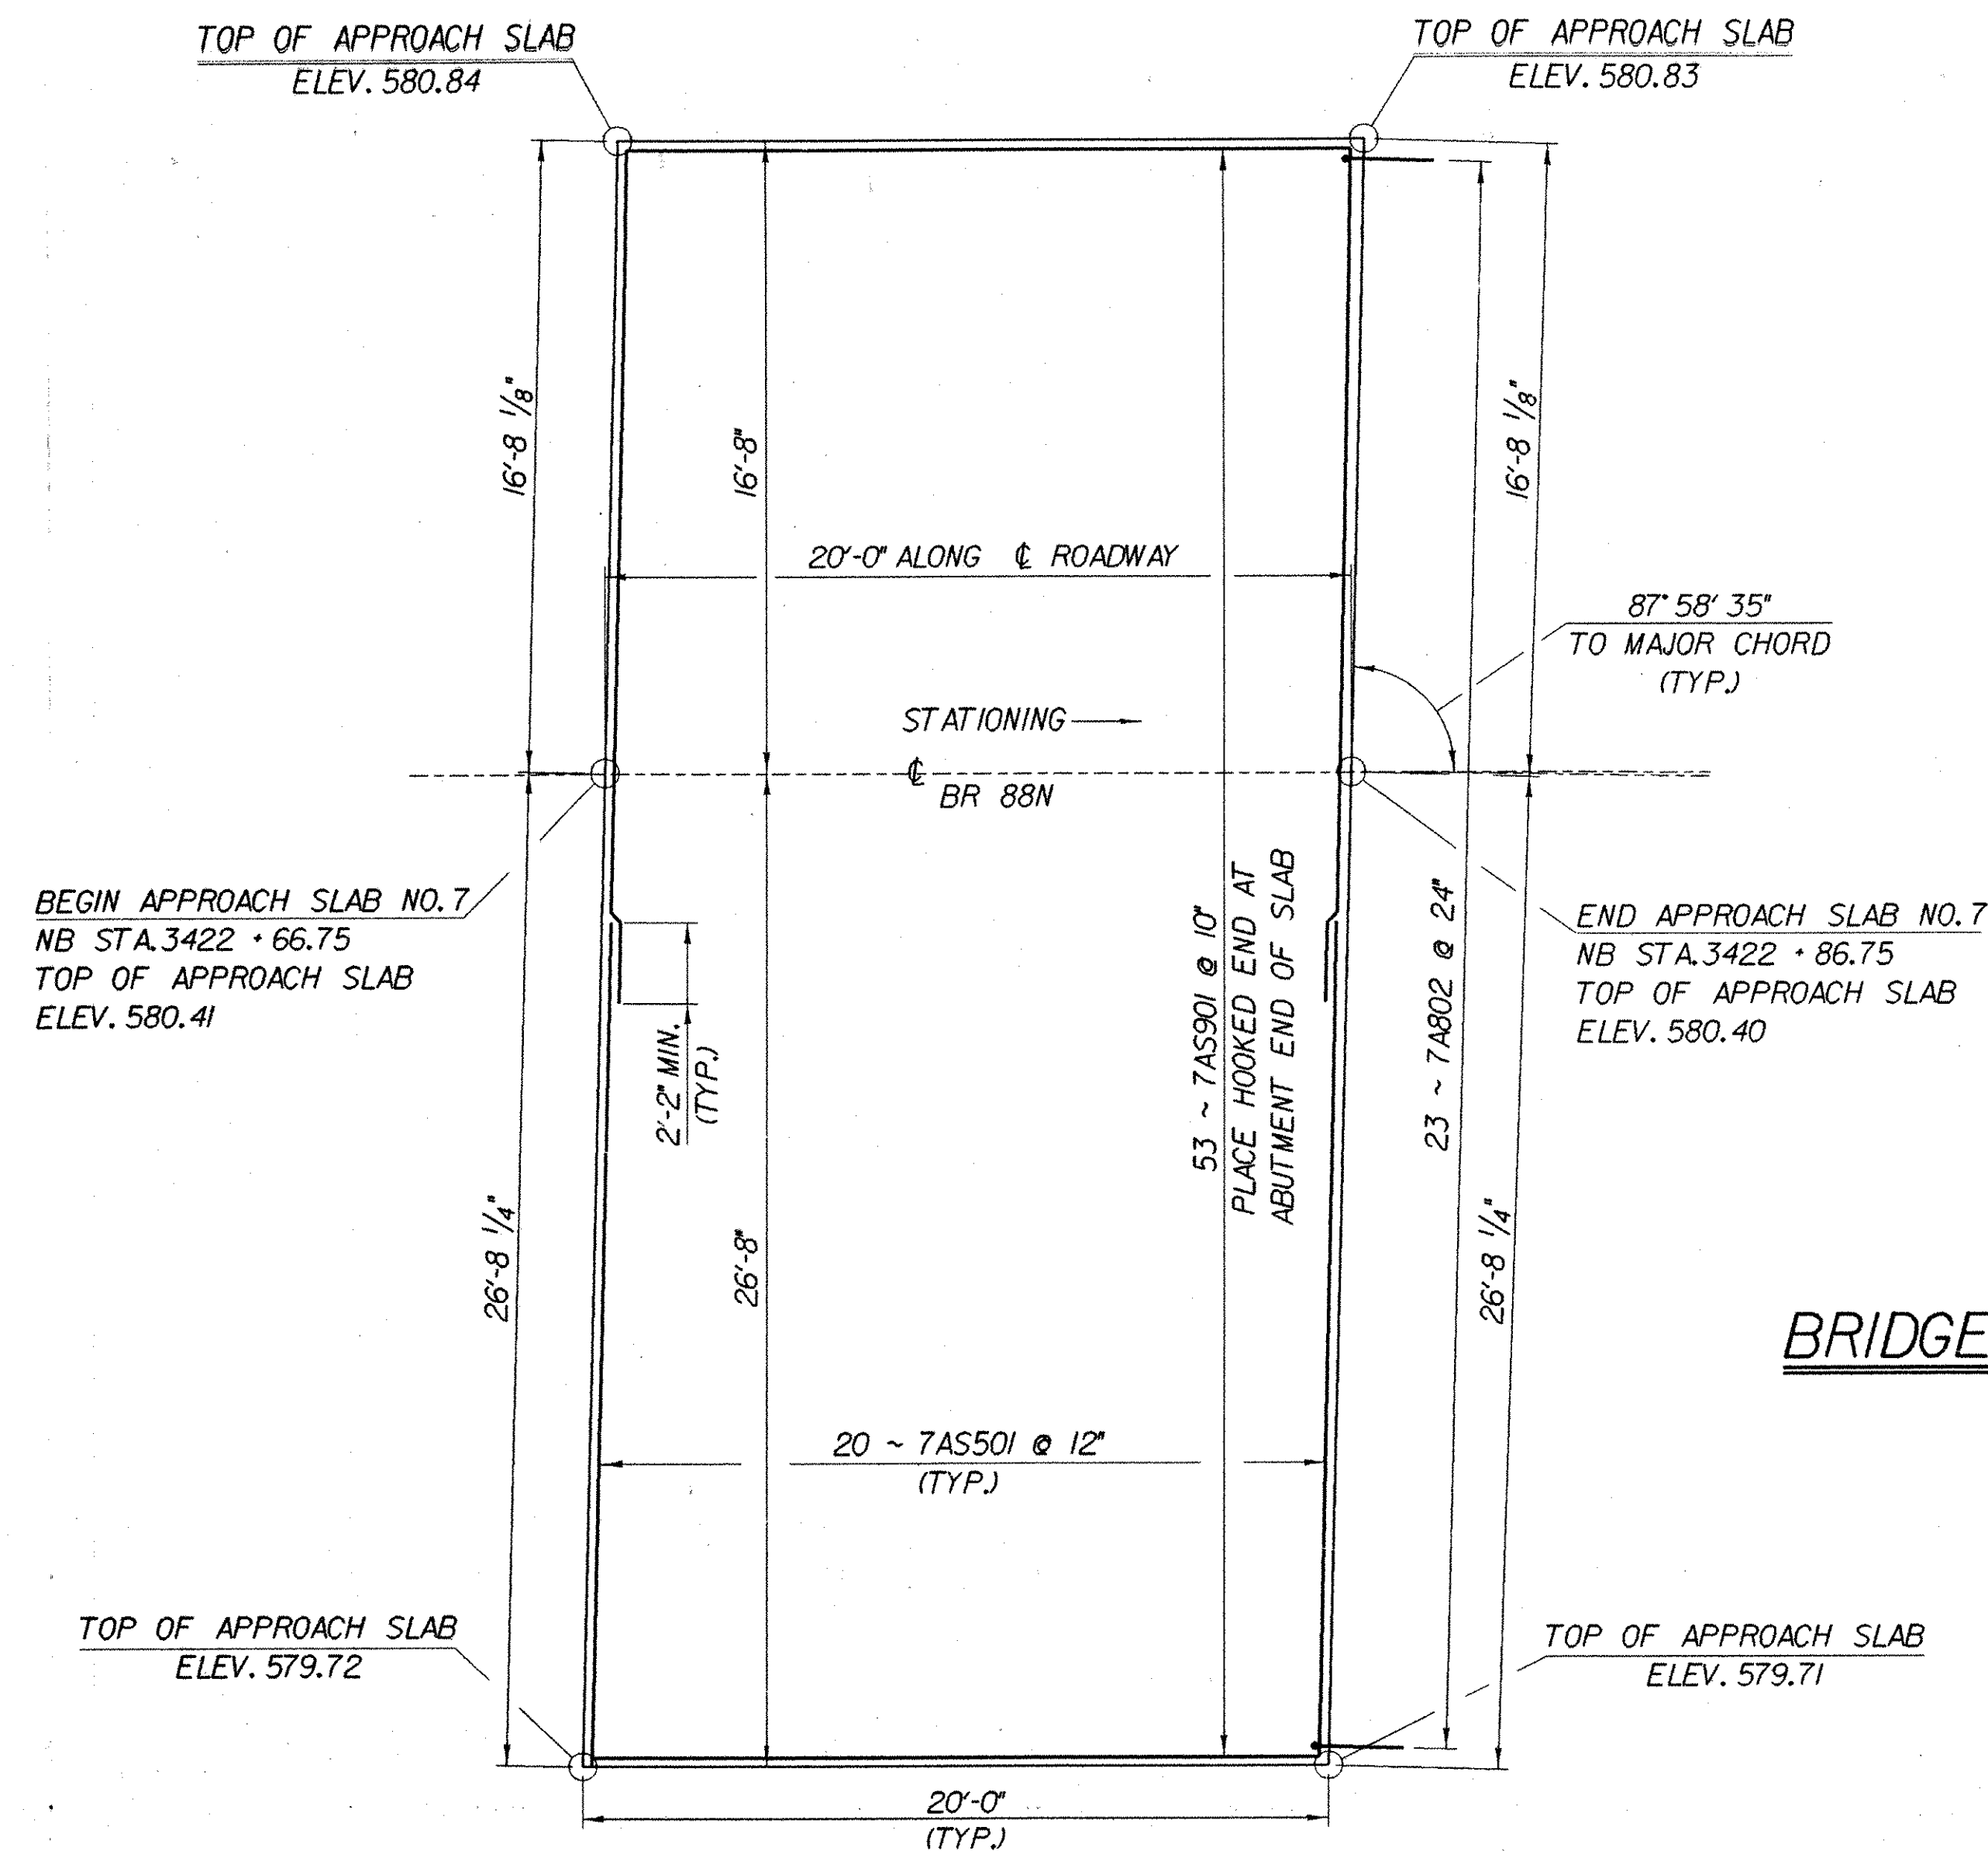


BRIDGE 88N APPROACH SLAB PLAN
SCALE: 1/4" = 1'-0"

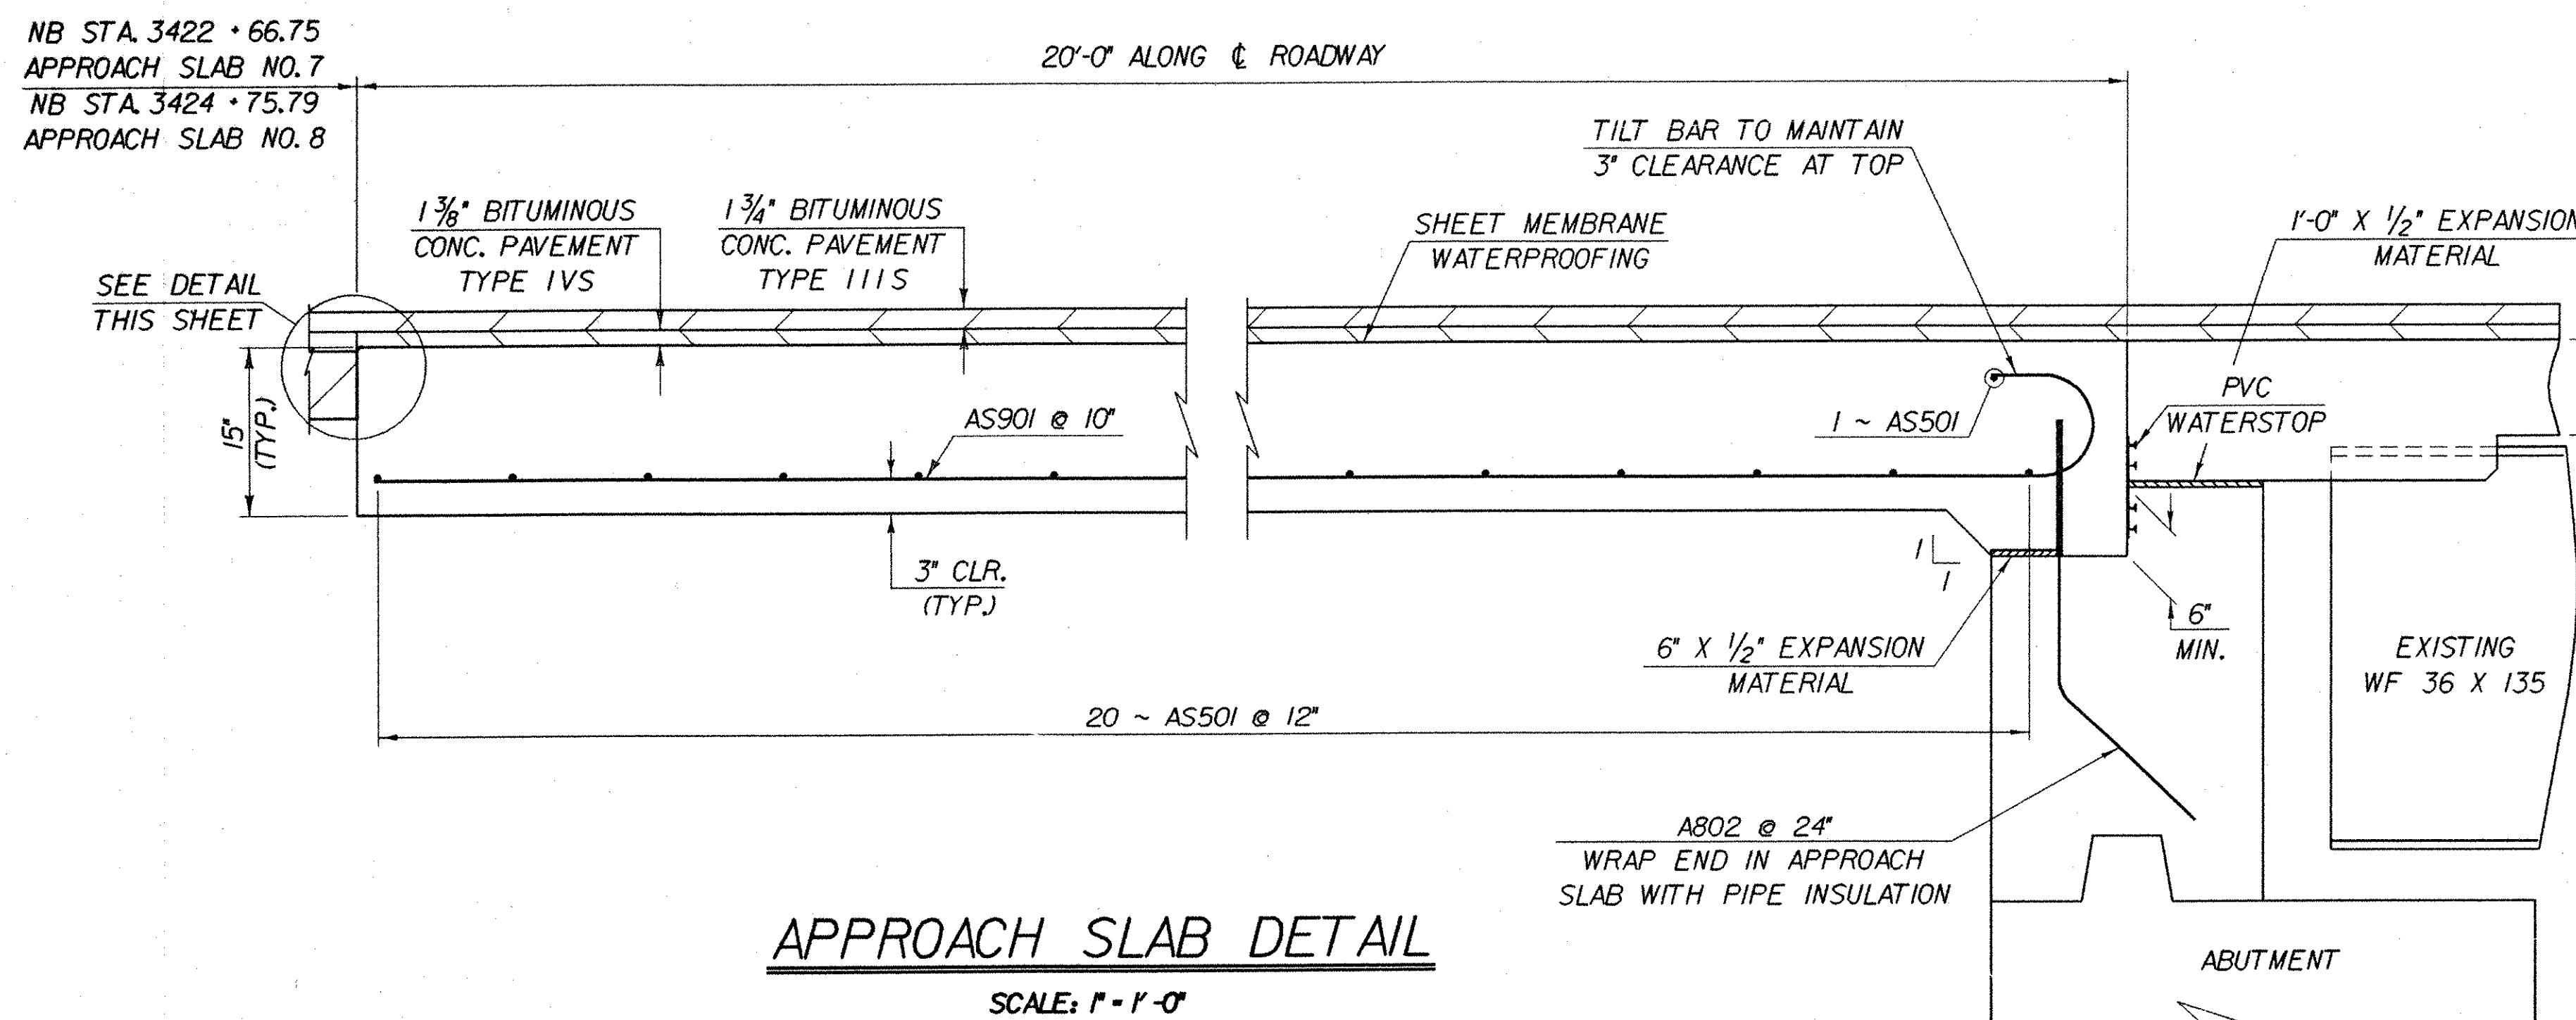


APPROACH SLAB DETAIL
SCALE: 1" = 1'-0"

IMPORTANT NOTE: BRIDGE FINISHED GRADES ARE CENTERLINE GRADES.

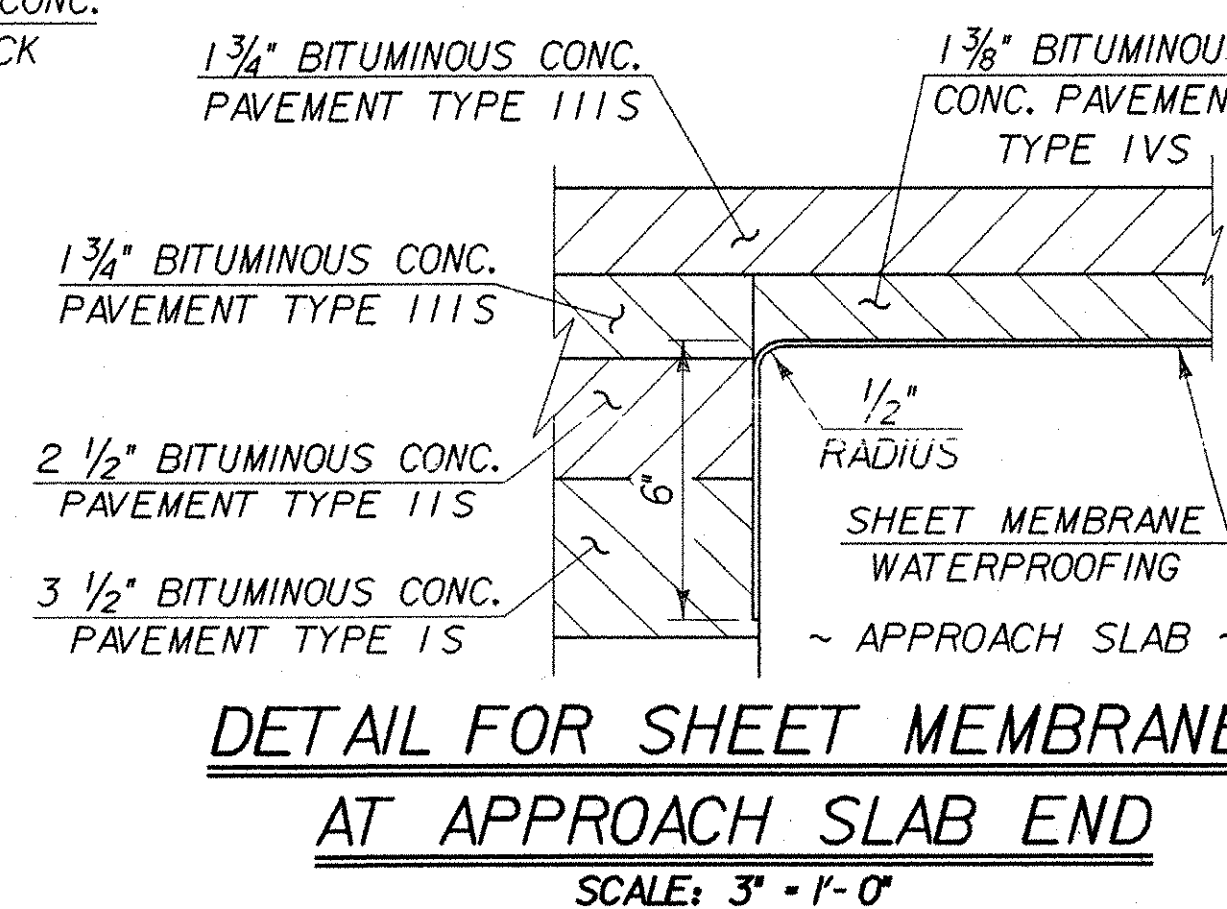

**DETAIL FOR SHEET MEMBRANE
AT APPROACH SLAB END**
SCALE: 3" = 1'-0"

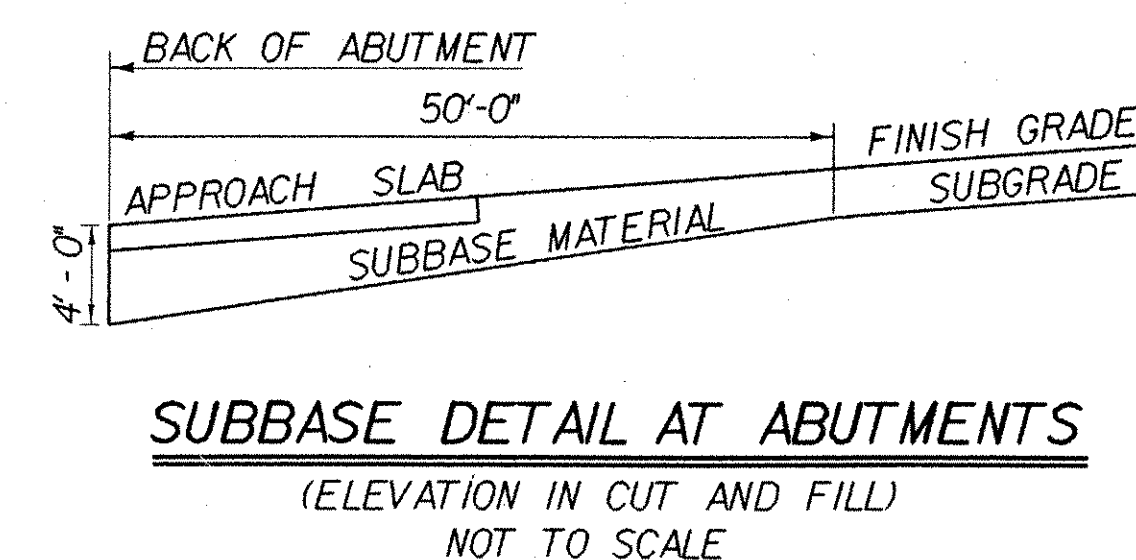

SUBBASE DETAIL AT ABUTMENTS
(ELEVATION IN CUT AND FILL)
NOT TO SCALE

STATE OF VERMONT AGENCY OF TRANSPORTATION			
Town of FAIRFAX-FAIRFIELD-ST. ALBANS		Bridge No.	88N
Highway No.		Log Sta.	
1-89		Surv. Sta.	
1-89 OVER ST. ALBANS SOUTH STATE HIGHWAY (EXIT 19)			
88N APPROACH SLAB DETAILS			
Designed By	M. LOZIER	Drawn By	K. CHISHOLM
Checked By	M. LOZIER	Date	2/00
PROJECT	FAIRFAX-FAIRFIELD-ST. ALBANS		PROJECT NO.
	1M 089 - 3 (27)		
I.G.C. Info.	96a056Structures\sa056sp4.dgn	sa056sp2.j	
Bridge Sheet No.	BR430	Sheet	182 of 370