
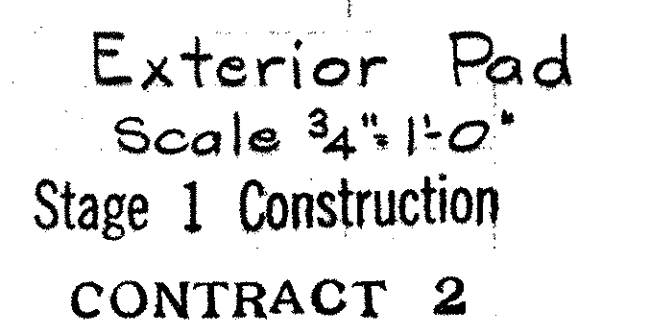
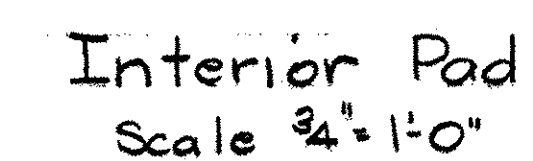
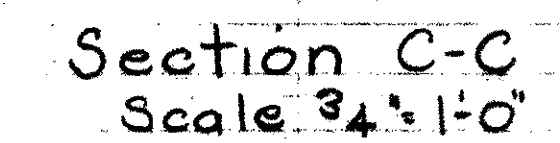
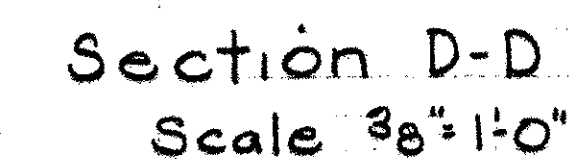
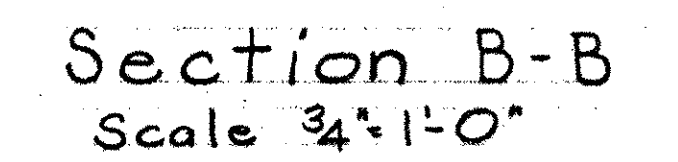
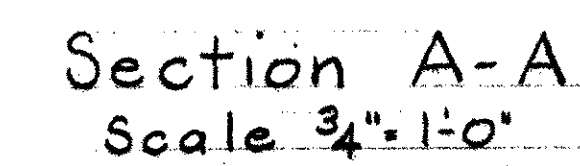


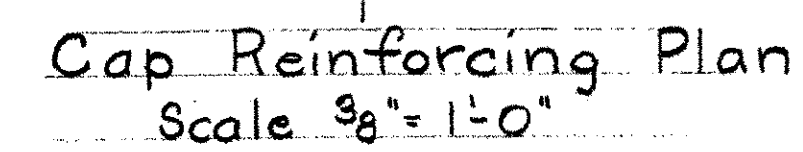

STATE OF VERMONT
DEPARTMENT OF HIGHWAYS

Georgia - Fairfax -
TOWN OF Fairfield - ST. Albans
ROUTE No. I 89 LOG STA. _____
Pier #3 & #4 Reinforcing Steel
I 89 over Approach Road
SCALE As Noted _____

DRAWN BY A.J.C. CHECKED BY J.J.C.
PROJECT NO. I 89-3(35) Cont. #2
SHEET 204 OF 467