


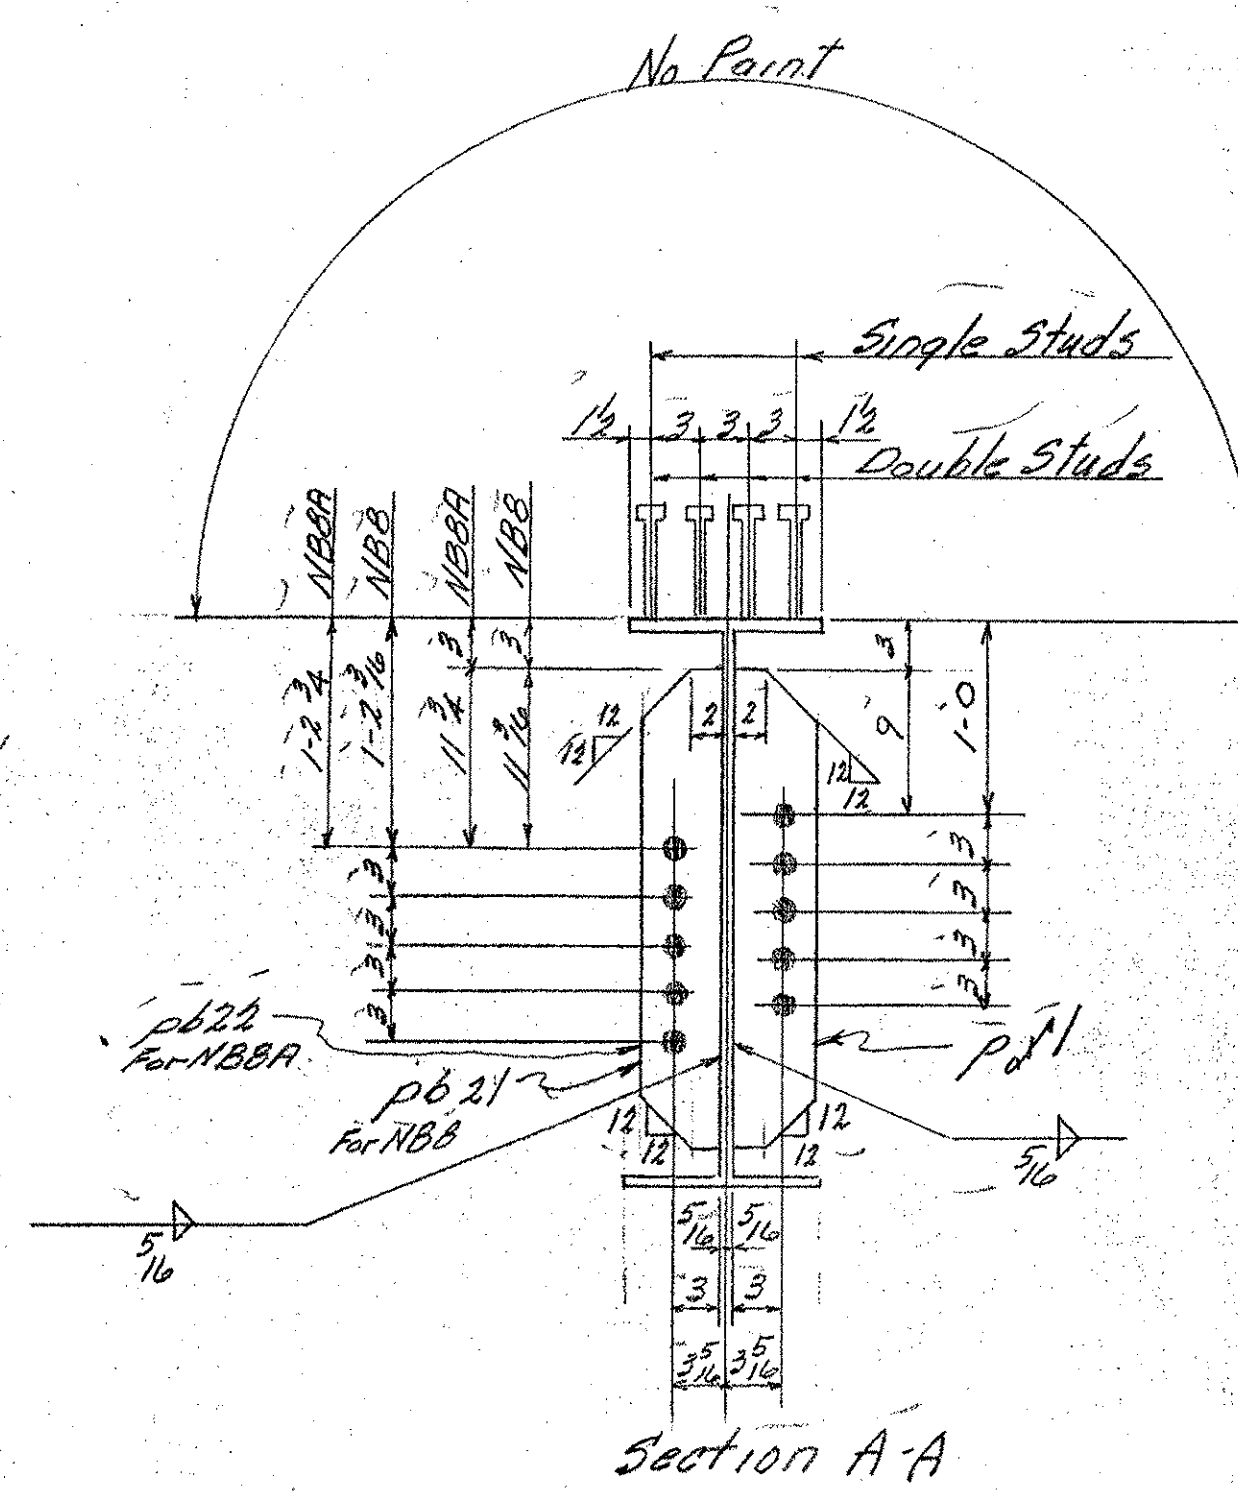

BILL OF MATERIAL

[illegible]

JOB NO. SHEET NO.

ASTM-A36

BILL OF MATERIAL

47

NO. PIECES	MARK	DESCRIPTION	LENGTH		WEIGHT
			FT.	IN.	
1	NBB	36WF 135	49	3	
4	NBB	36WF 135	48	3	32,569
5	pl	Bar 7x1	1	1	2 Res 20-0
5	pl	- do	1	1	258
5	pl	R 9x4	1	7	Res 40x4x11-0 64
4	pl	Bar 8x2	2	0	109
5	pl	Bar 5x2	2	0	Res 20-0 170
5	pl	Bar 8x2	2	0	136
3	pl	Bar 5x2	2	0	Res 20-0 113
1	pl	Bar 8x2	2	0	27
10	pl	Bar 5x2	2	0	Res 20-0 213
		2" Weld	11	8	46
		Top Weld	150	0	54
					33,633
					33,633
1690		Cont 66-1184 226	0	7	5TK
		34" shear studs			1698
					35,351

VERMONT STRUCTURAL STEEL CORPORATION
BURLINGTON, VT.

Proj No. I 89-3(35)[#] 2

DATE		PROJECT		PRINT RECORD	
DRAWN BY	LC 11-23-66	LOCATION	George Washington St. N. Ave.		
OK'D BY	RLM 11-23-66	CUSTOMER	Lane Const. Co.		
HOLES		ARCHITECT	State of W. Dept. of Highways		
BOLTS		JOB NO.	66-104-200 St. St. SHEET NO. 28		
PAINT		66-104-226		3rd St. St.	
1st Noted		2		STREET 12	
		2		1st St. 12	