




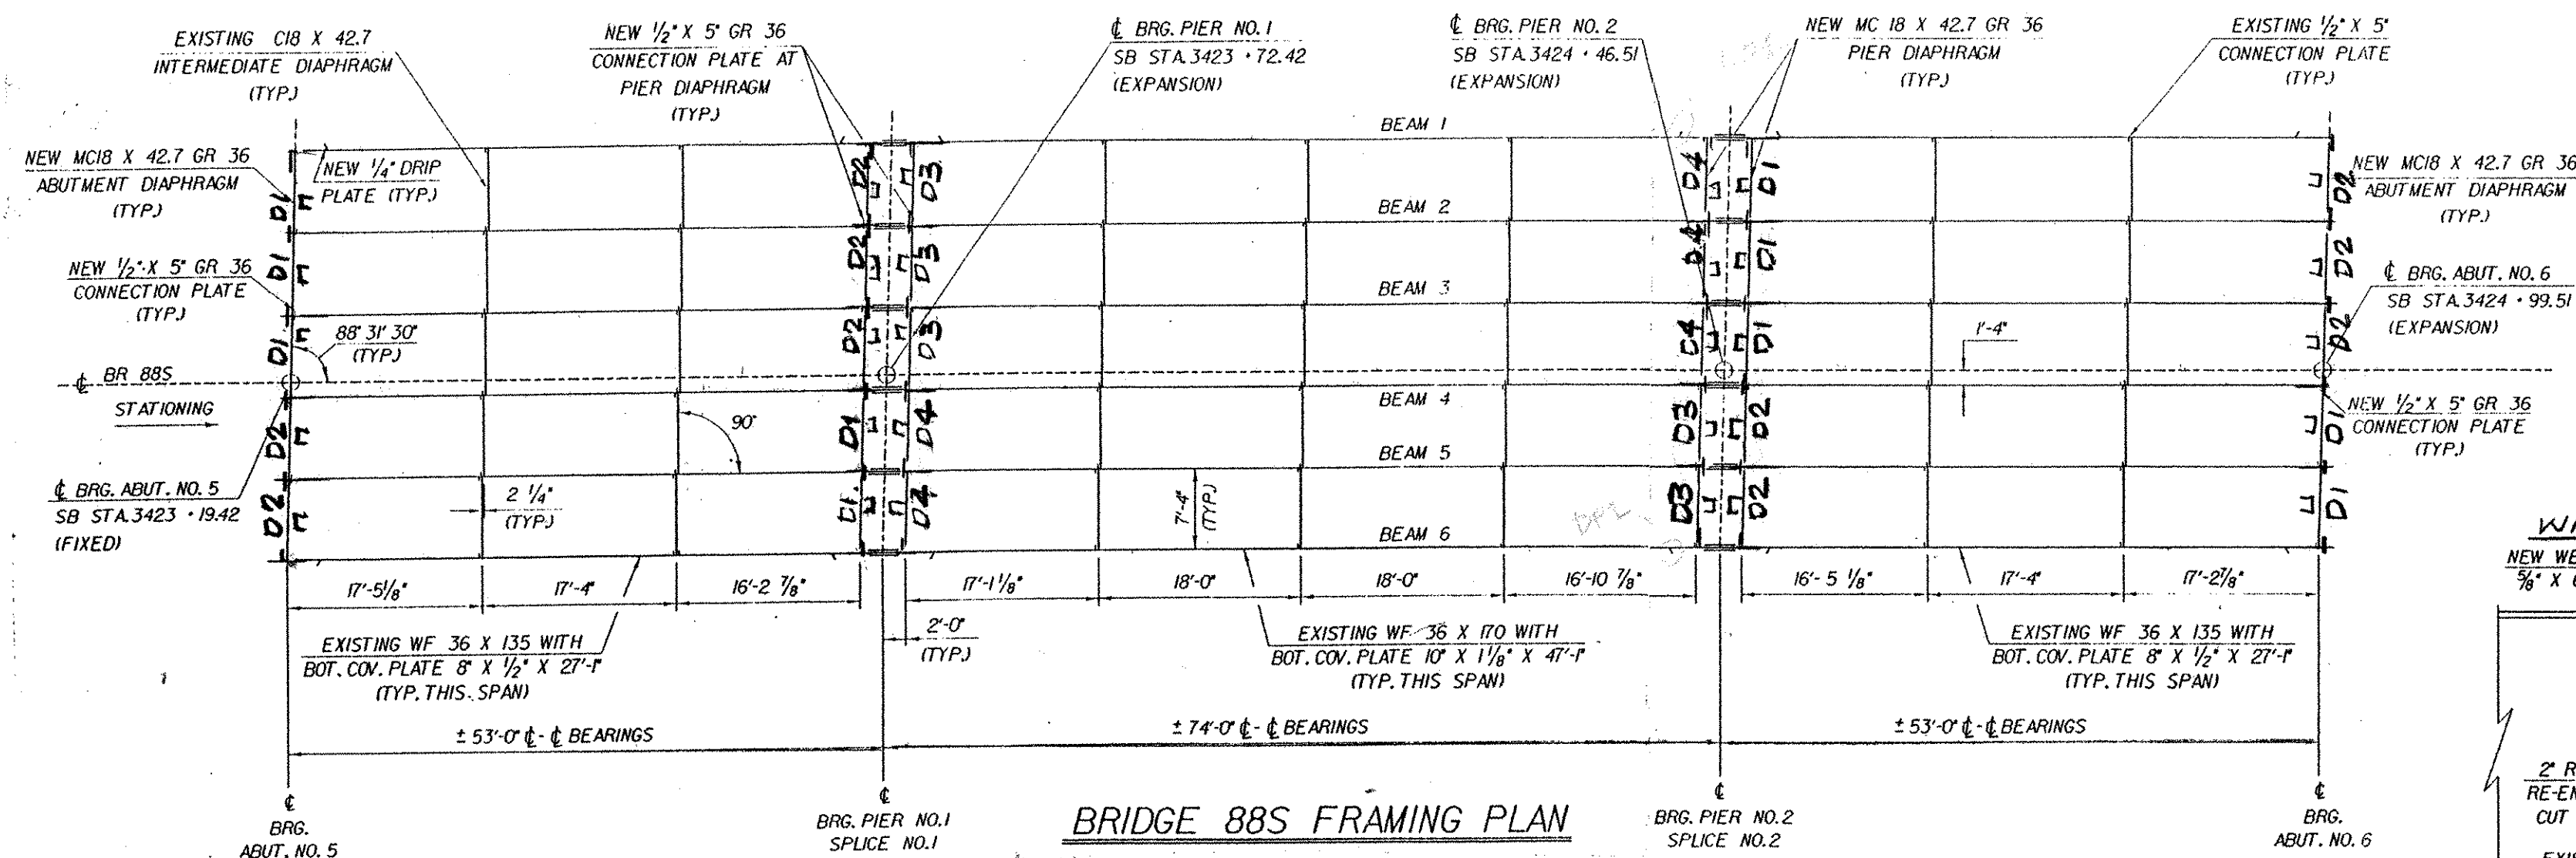


BRIDGE 88S FRAMING PLAN

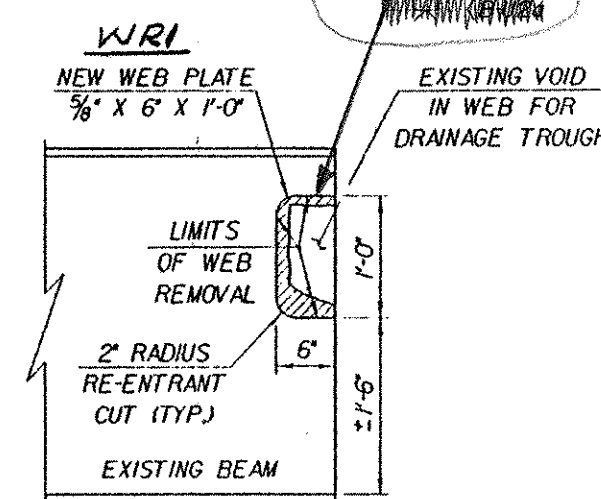


BEAM END @ PIERS REPAIR DETAIL

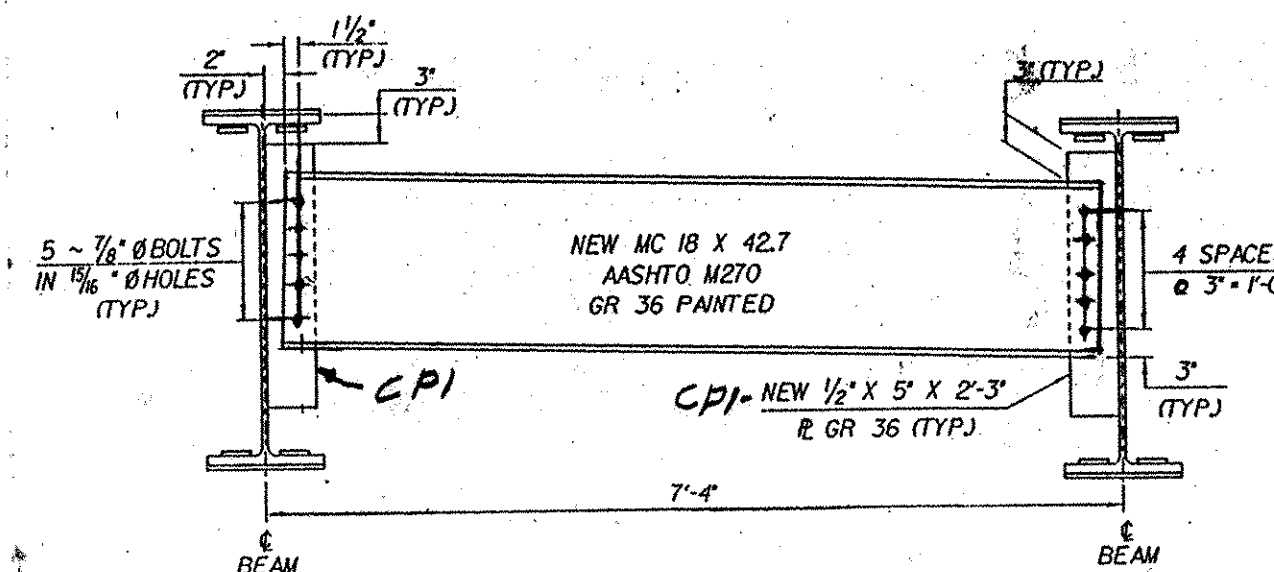


PIER DIAPHRAGM

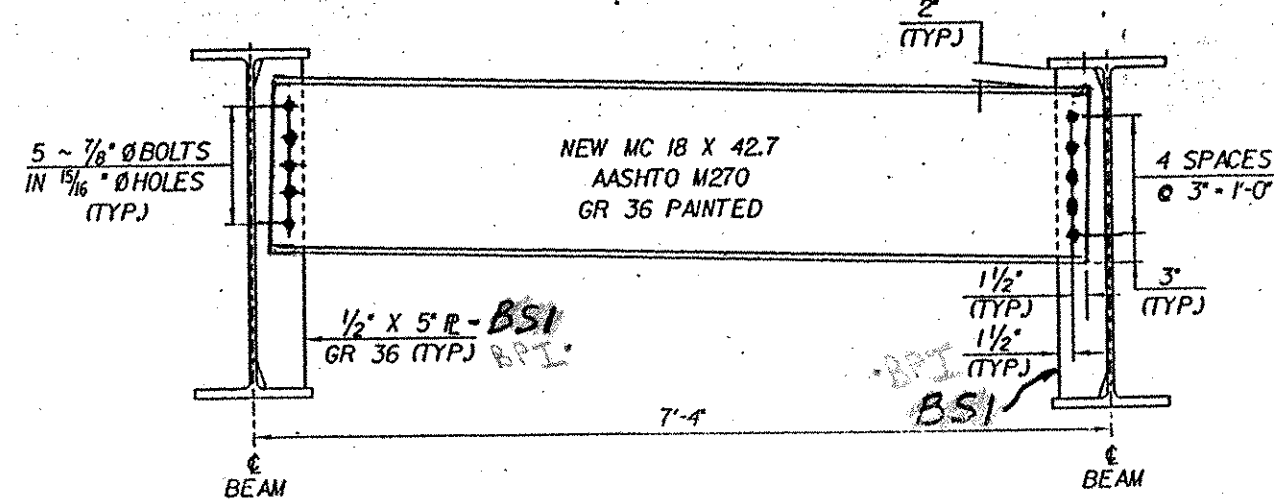


ABUTMENT DIAPHRAGM

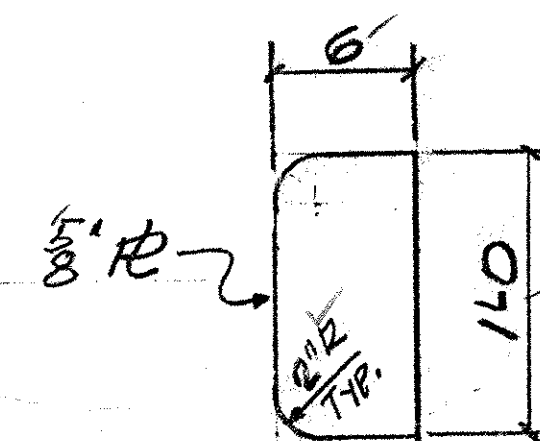




WRI-24-REQ'D.
No PAINT

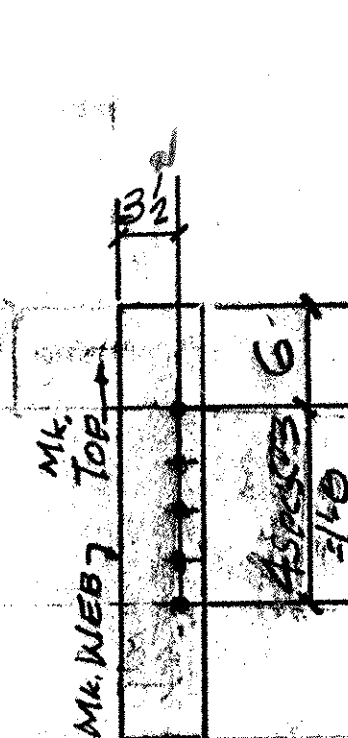

PIER DIAPHRAGM
CPI-40-REQ'D.
No PAINT

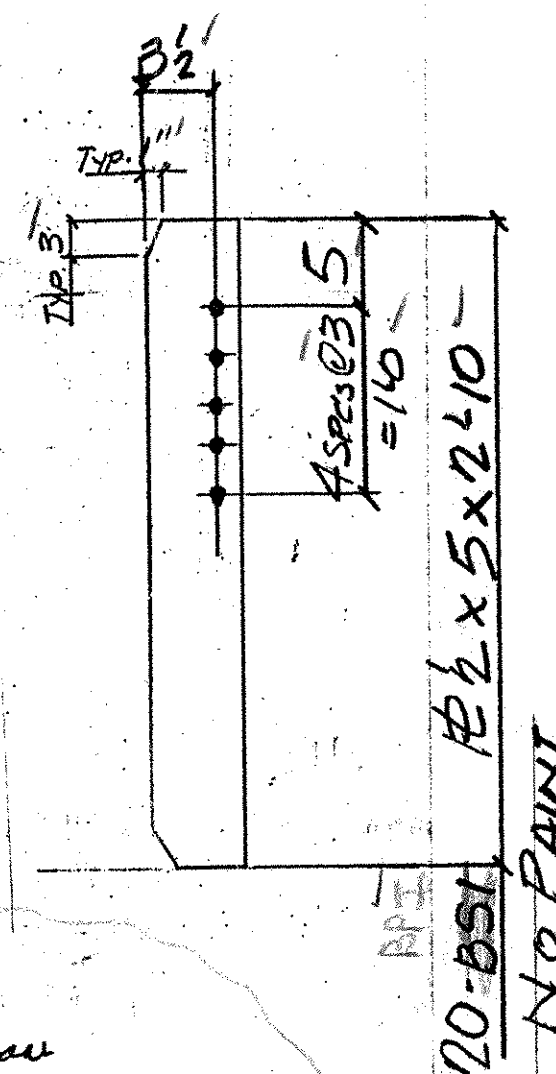

ABUTMENT DIAPHRAGM
CPI-40-REQ'D.
No PAINT

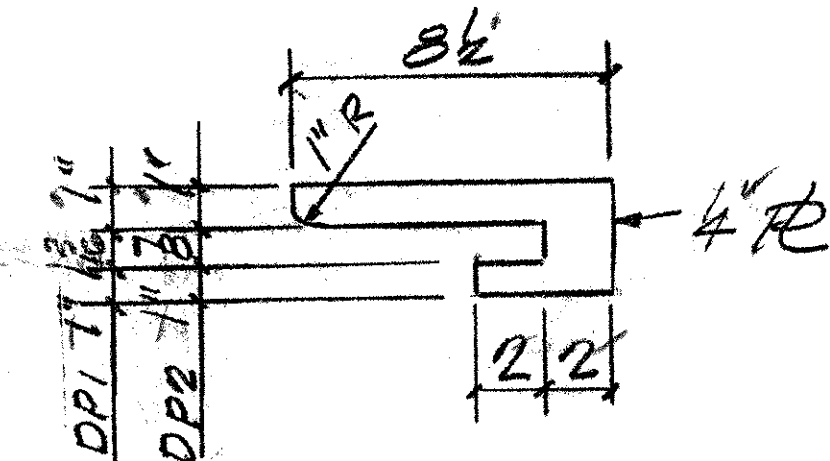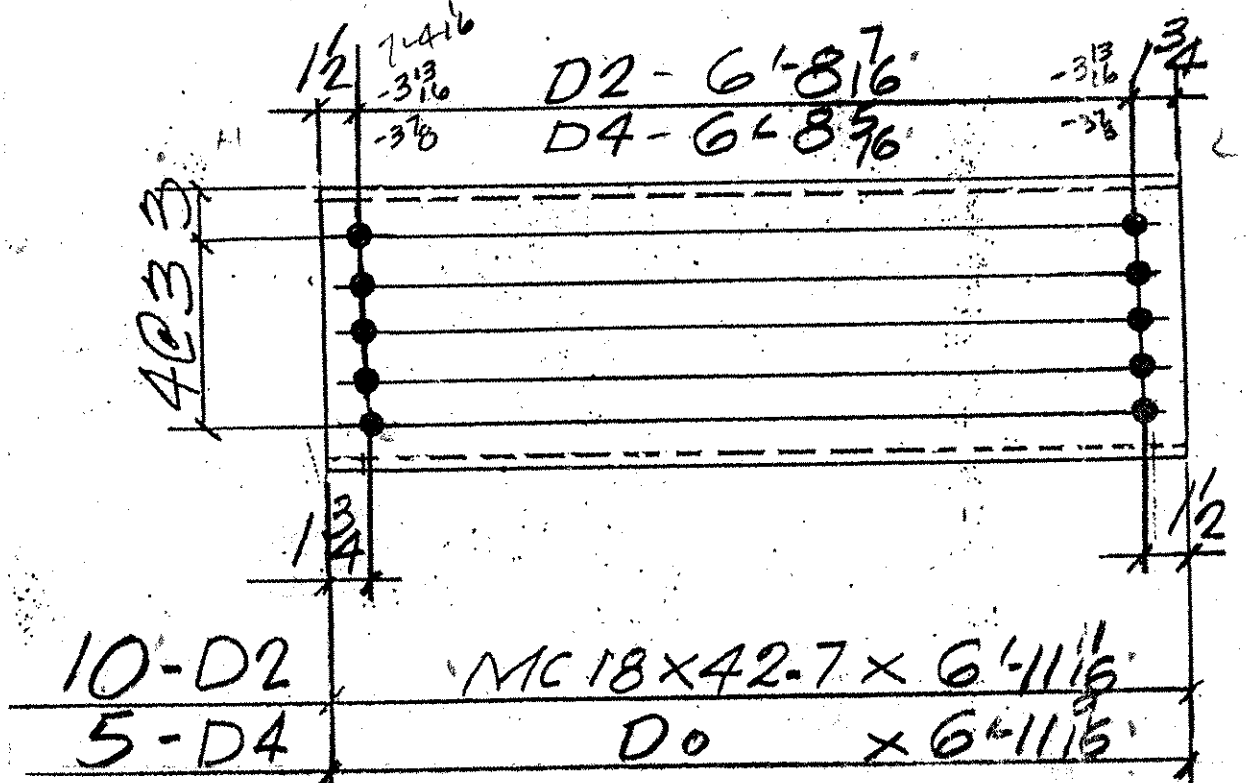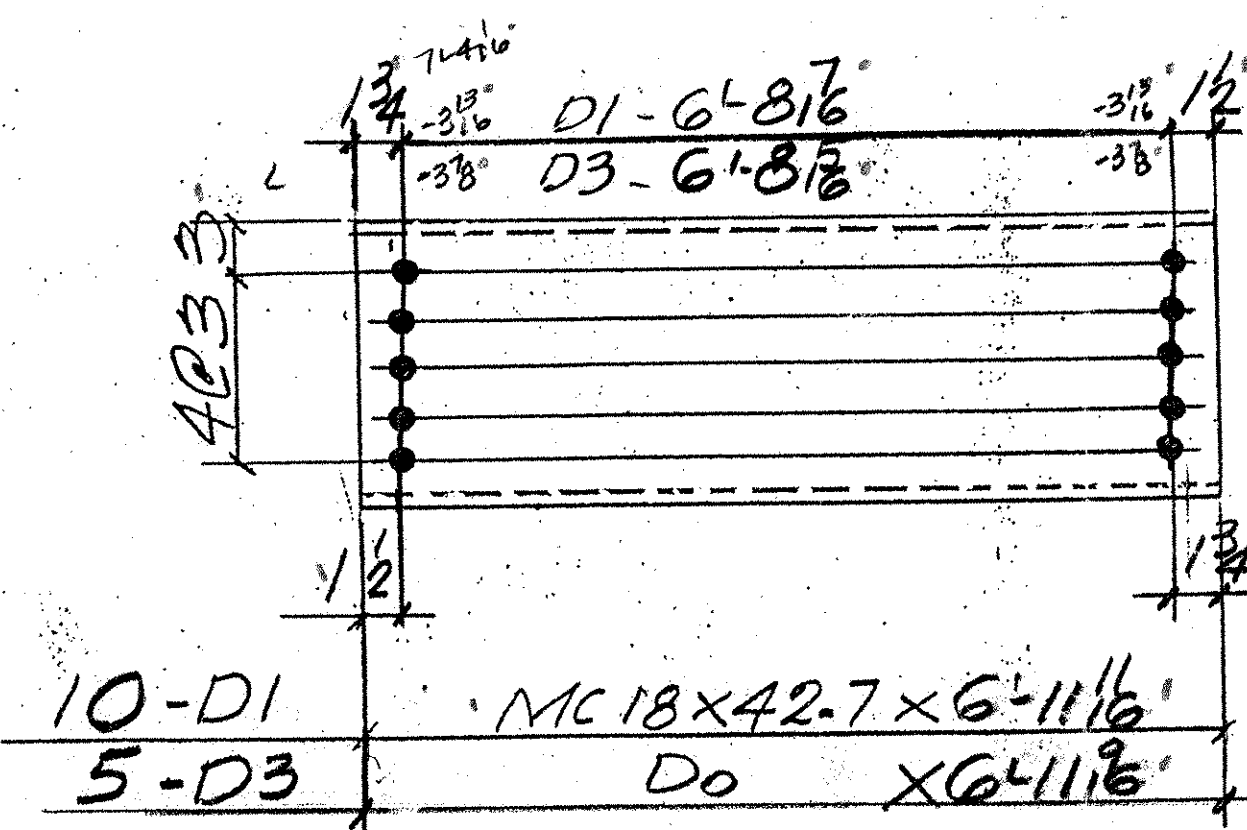

BEAM END @ PIERS REPAIR DETAIL
DPI-4-REQ'D (2W36x170)
DPI-8-REQ'D (2W36x135)
No PAINT

FIELD WELDED SEAL WELD ALL AROUND

AEM INIT O						SHOP BILL		JOB NO. 132	DRG. NO. 51
PAGE	LINE	NO.	DESCRIPTION	FT	IN	ASSEM. MARK	SHIPPING MARK	REMARKS	WEIGHT
		10	MC18x42.7	6	11 1/2		D1		
		10	DO	6	11 1/2		D2		
		15	DO	6	11 1/2		D3		
		15	DO	6	11 1/2		D4		
		40	2 1/2 x 5	2	3		CPI	NO PAINT	
		20	2 1/2 x 5	2	10		BPI	NO PAINT	
		4	2 1/2 x 3 1/2	8 1/2			DPI	NO PAINT	
		8	2 1/2 x 2 1/2	8 1/2			DP2	DO	
		24	2 1/2 x 6	1	0		WRI	NO PAINT	
		300	3/8" 4.5 BOLT3	24			FIELD	W/NEW. M164-TYPE1 GALV	
ALL MATERIALS AND CONSTRUCTION SHALL CONFORM TO STATE OF VERMONT AGENCY OF TRANSPORTATION STANDARD SPECIFICATIONS FOR CONSTRUCTION DATED 1990, AND ITS LATEST REVISIONS, AND THE AASHTO STANDARD SPECIFICATIONS FOR HIGHWAY BRIDGES, DATED 1996, AND ITS LATEST REVISIONS.									

ALL MATERIALS AND CONSTRUCTION SHALL CONFORM TO STATE OF VERMONT AGENCY OF TRANSPORTATION STANDARD SPECIFICATIONS FOR CONSTRUCTION DATED 1990, AND ITS LATEST REVISIONS, AND THE AASHTO STANDARD SPECIFICATIONS FOR HIGHWAY BRIDGES, DATED 1996, AND ITS LATEST REVISIONS.

PAY ITEM 506.60

V.A.O.T. RECEIVED
CR'D BY JEL OK'D BY G. B. 3-7-01
MAR 05 2001
RESUBMIT BY mgl APPROVED AS NOTED DATE 3-22-01

OUT FOR APPROVAL	2-26-01												
OUT FOR APPROVAL													
ISSUED TO SHOP													
FIELD & OFFICE													
REV.	REMARKS	DATE	DWN	CHK	APP	Q.A.	NO.	DIA.	LGT	TYPE	WASHER		
PROJECT NO. <u>IM-089-3 (27)</u>		STATE BRIDGE NO.		<u>885</u>									
MATERIAL: <u>AASHTO M270 GR 36</u>		ELECTRODES: <u>PER PROC</u>		HOLES: <u>15/16"</u>		SHOP BOLTS: <u>-</u>							
SURFACE PREP. & PAINT:		<u>SSPC-SP10</u>											
PRIMER:		<u>WASSER MC-ZINC</u>											
INTERMEDIATE:		<u>WASSER FERROX B</u>											
FINISH:		<u>WASSER FERROX A</u> COLOR # <u>14062</u>											
DESCRIPTION:		<u>MISC. STRUCTURAL ITEMS</u>								DRAWN BY		DATE	
JOB: <u>BRIDGE 885</u>										<u>JPF</u>		<u>2-01</u>	
										CHKD BY			
										<u>EJ.</u>			
										APPROV BY			
										Q.A.			
CUSTOMER: <u>J.A. McDONALD</u>													
CASCO BAY STEEL STRUCTURES, INC.										JOB NO.		DRG. NO.	
75 SPRING HILL ROAD		SACO, MAINE 04072								<u>132</u>		<u>51</u>	
PHONE (207) 282-7360		FAX. (207) 282-1179								<u>432</u>		REV.	△

CUSTOMER: J. A. McDONALD
CASCO BAY STEEL STRUCTURES, INC.
75 SPRING HILL ROAD SACO, MAINE 04072
PHONE (207) 282-7360 FAX. (207) 282-1179
JOB NO. 132 DRG. NO. 51
432 REV. Δ