


1AOT
RECEIVED
CK'D BY mgf OK'D BY C. Roy
4-18-01 4-18-01
MAR 29 2001
RESUBMIT _____ APPROVED ✓ AS NOTED
BY mgf DATE 4-18-01

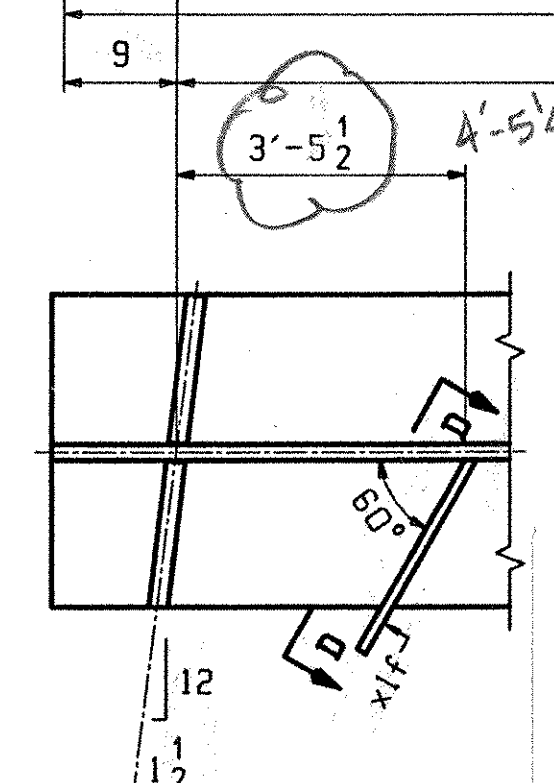

SECTION-B

CAMBER DIAGRAM

1. FOR GIRDER STANDARD DETAILS SEE DRAWING XI.
2. FOR CAMBER AND FLANGE DIAGRAMS SEE DRAWING CI.
3. FOR GENERAL NOTES SEE DRAWING GNI.

REV.	REMARKS	DATE	DWN	CHK	APP	Q.A.	NO.	DIA.	LGT	TYPE	WASHER
MATERIAL:		ELECTRODES:			HOLES:			SHOP BOLTS:			
M270 GR. 50W					15 16 U.N.						

SURFACE PREP. & PAINT:

DESCRIPTION:		GIRDER 6G10	DRAWN BY	DATE
	JOB:		JAK	3/16/01
	I-89 OVER VT 104		CHKD BY	
	BRIDGE 87S & 87 N		JB	3/22/01
	I-89 IMPROVEMENTS		APPROV BY	
	FAIRFAX FRANKLIN COUNTY		SUPERVISOR	M. J. GATTI
PROJ NO. IM 089-3(27)			Q.A.	
CUSTOMER: VERMONT AGENCY OF TRANSPORTATION				
CASCO BAY STEEL STRUCTURES, INC.			JOB NO.	DRG. NO.
75 SPRING HILL ROAD SACO, MAINE 04072			131	6
PHONE (207) 282-7360 FAX. (207) 282-1179			45	REV. /