
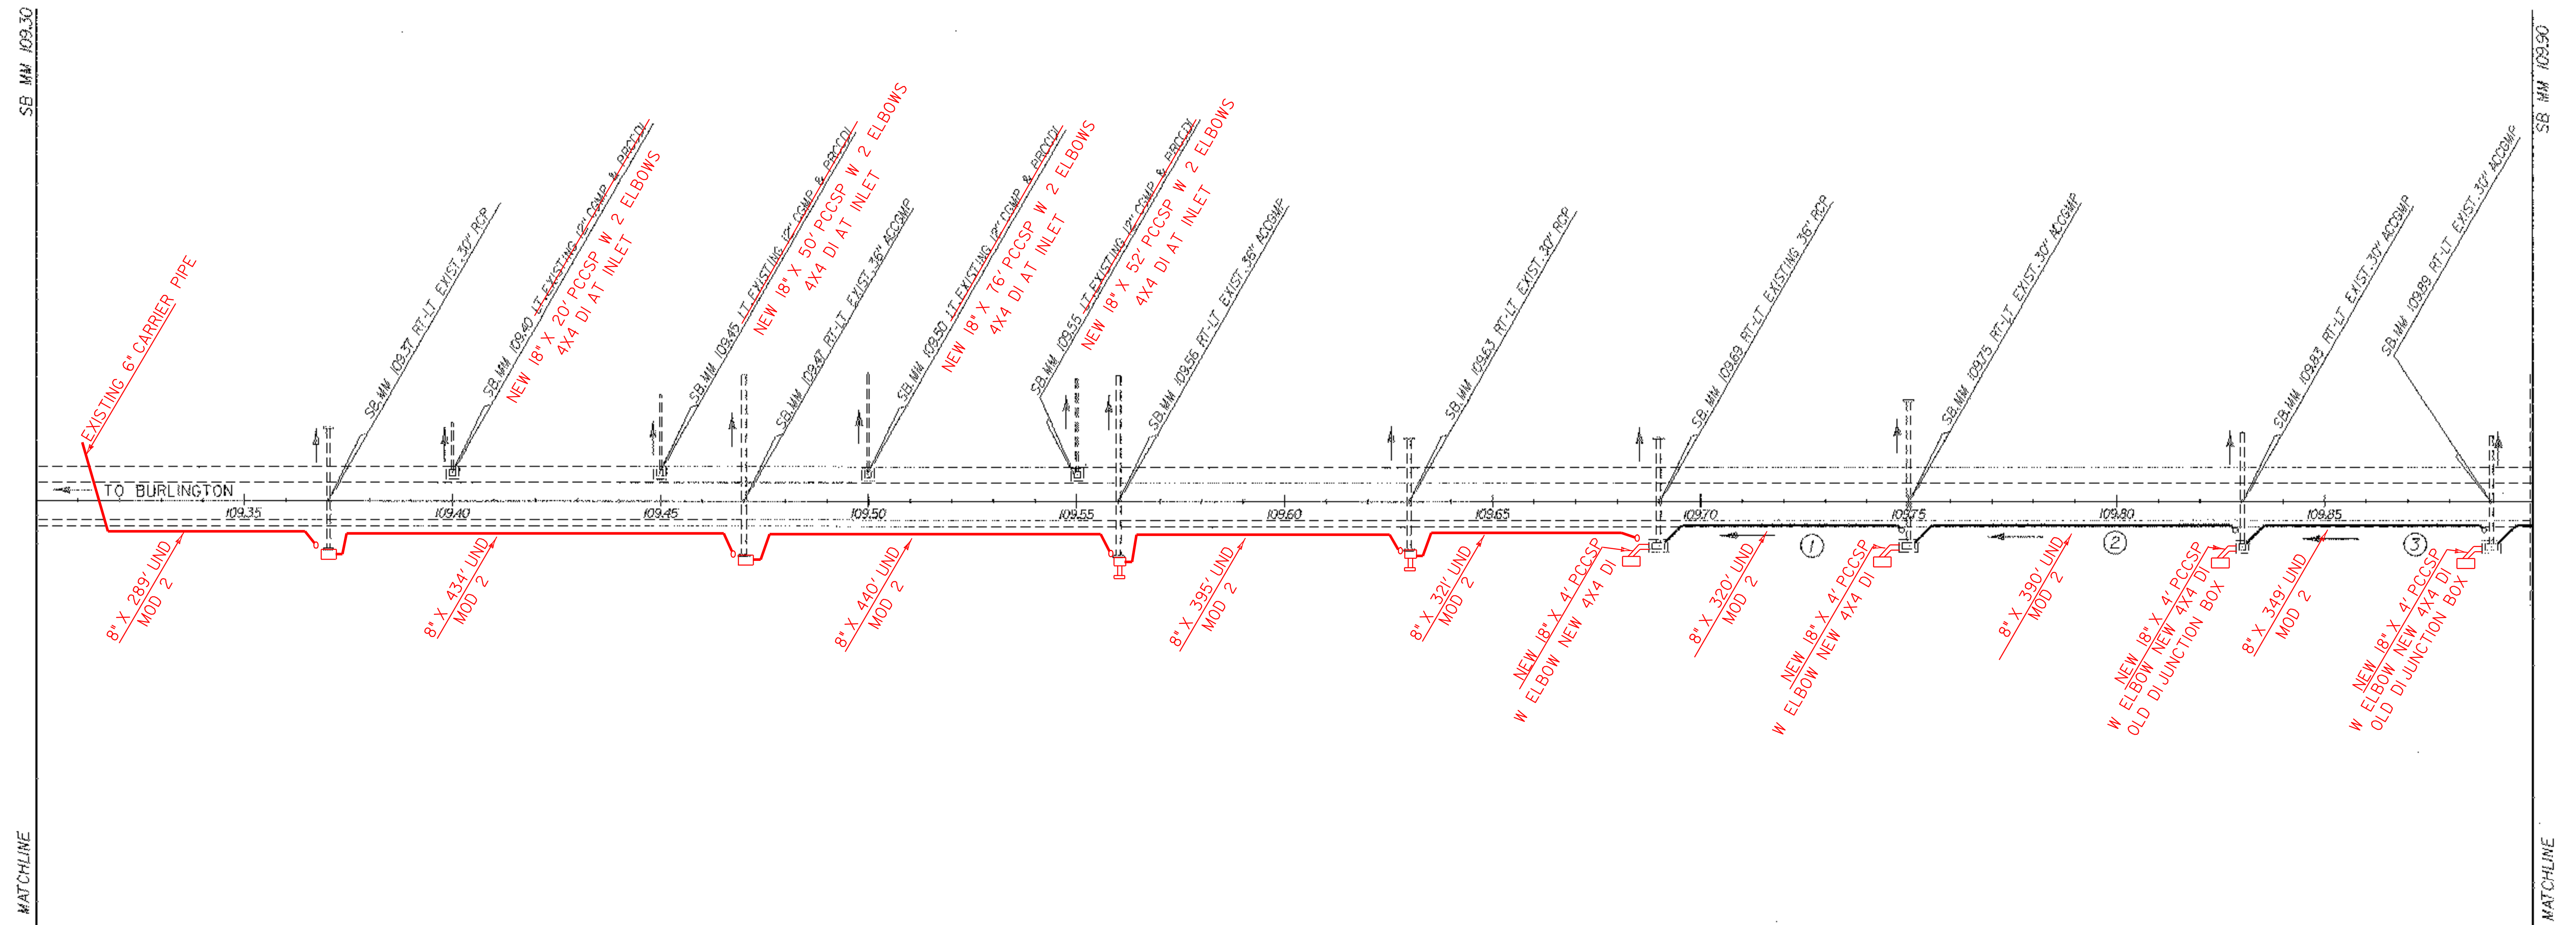


REMOVAL AND DISPOSAL
OF GUARD RAIL
SB MM 109.30 LT. ~ MM 109.90 LT.

- ~~① SB MM 109.69 RT. ~ MM 109.75 RT. W/FB @ 109.75 RT.~~
- ~~② SB MM 109.75 RT. ~ MM 109.83 RT. W/FB @ 109.83 RT.~~
- ~~③ SB MM 109.83 RT. ~ MM 109.89 RT. W/FB @ 109.89 RT.~~

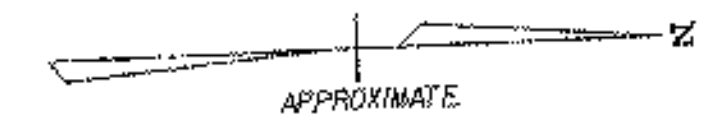

SURVEYED BY _____ DATE _____
DRAWN BY SQUAD B DATE _____
SQUAD LEADER DELLA SANTA
DESIGN FILE NO. /S00B/87A007A/DAG007A.DGN
IPARM FILE DAD007L12 DATE 26-MAR-1997
PLOTED
PROJ. NAME FAIRFAX - 089
PROJ. NO. IM-089-3(26)
SHEET 74 OF 121 SHEETS

NOT TO SCALE

DATUM	
VERTICAL	N/A
HORIZONTAL	N/A