




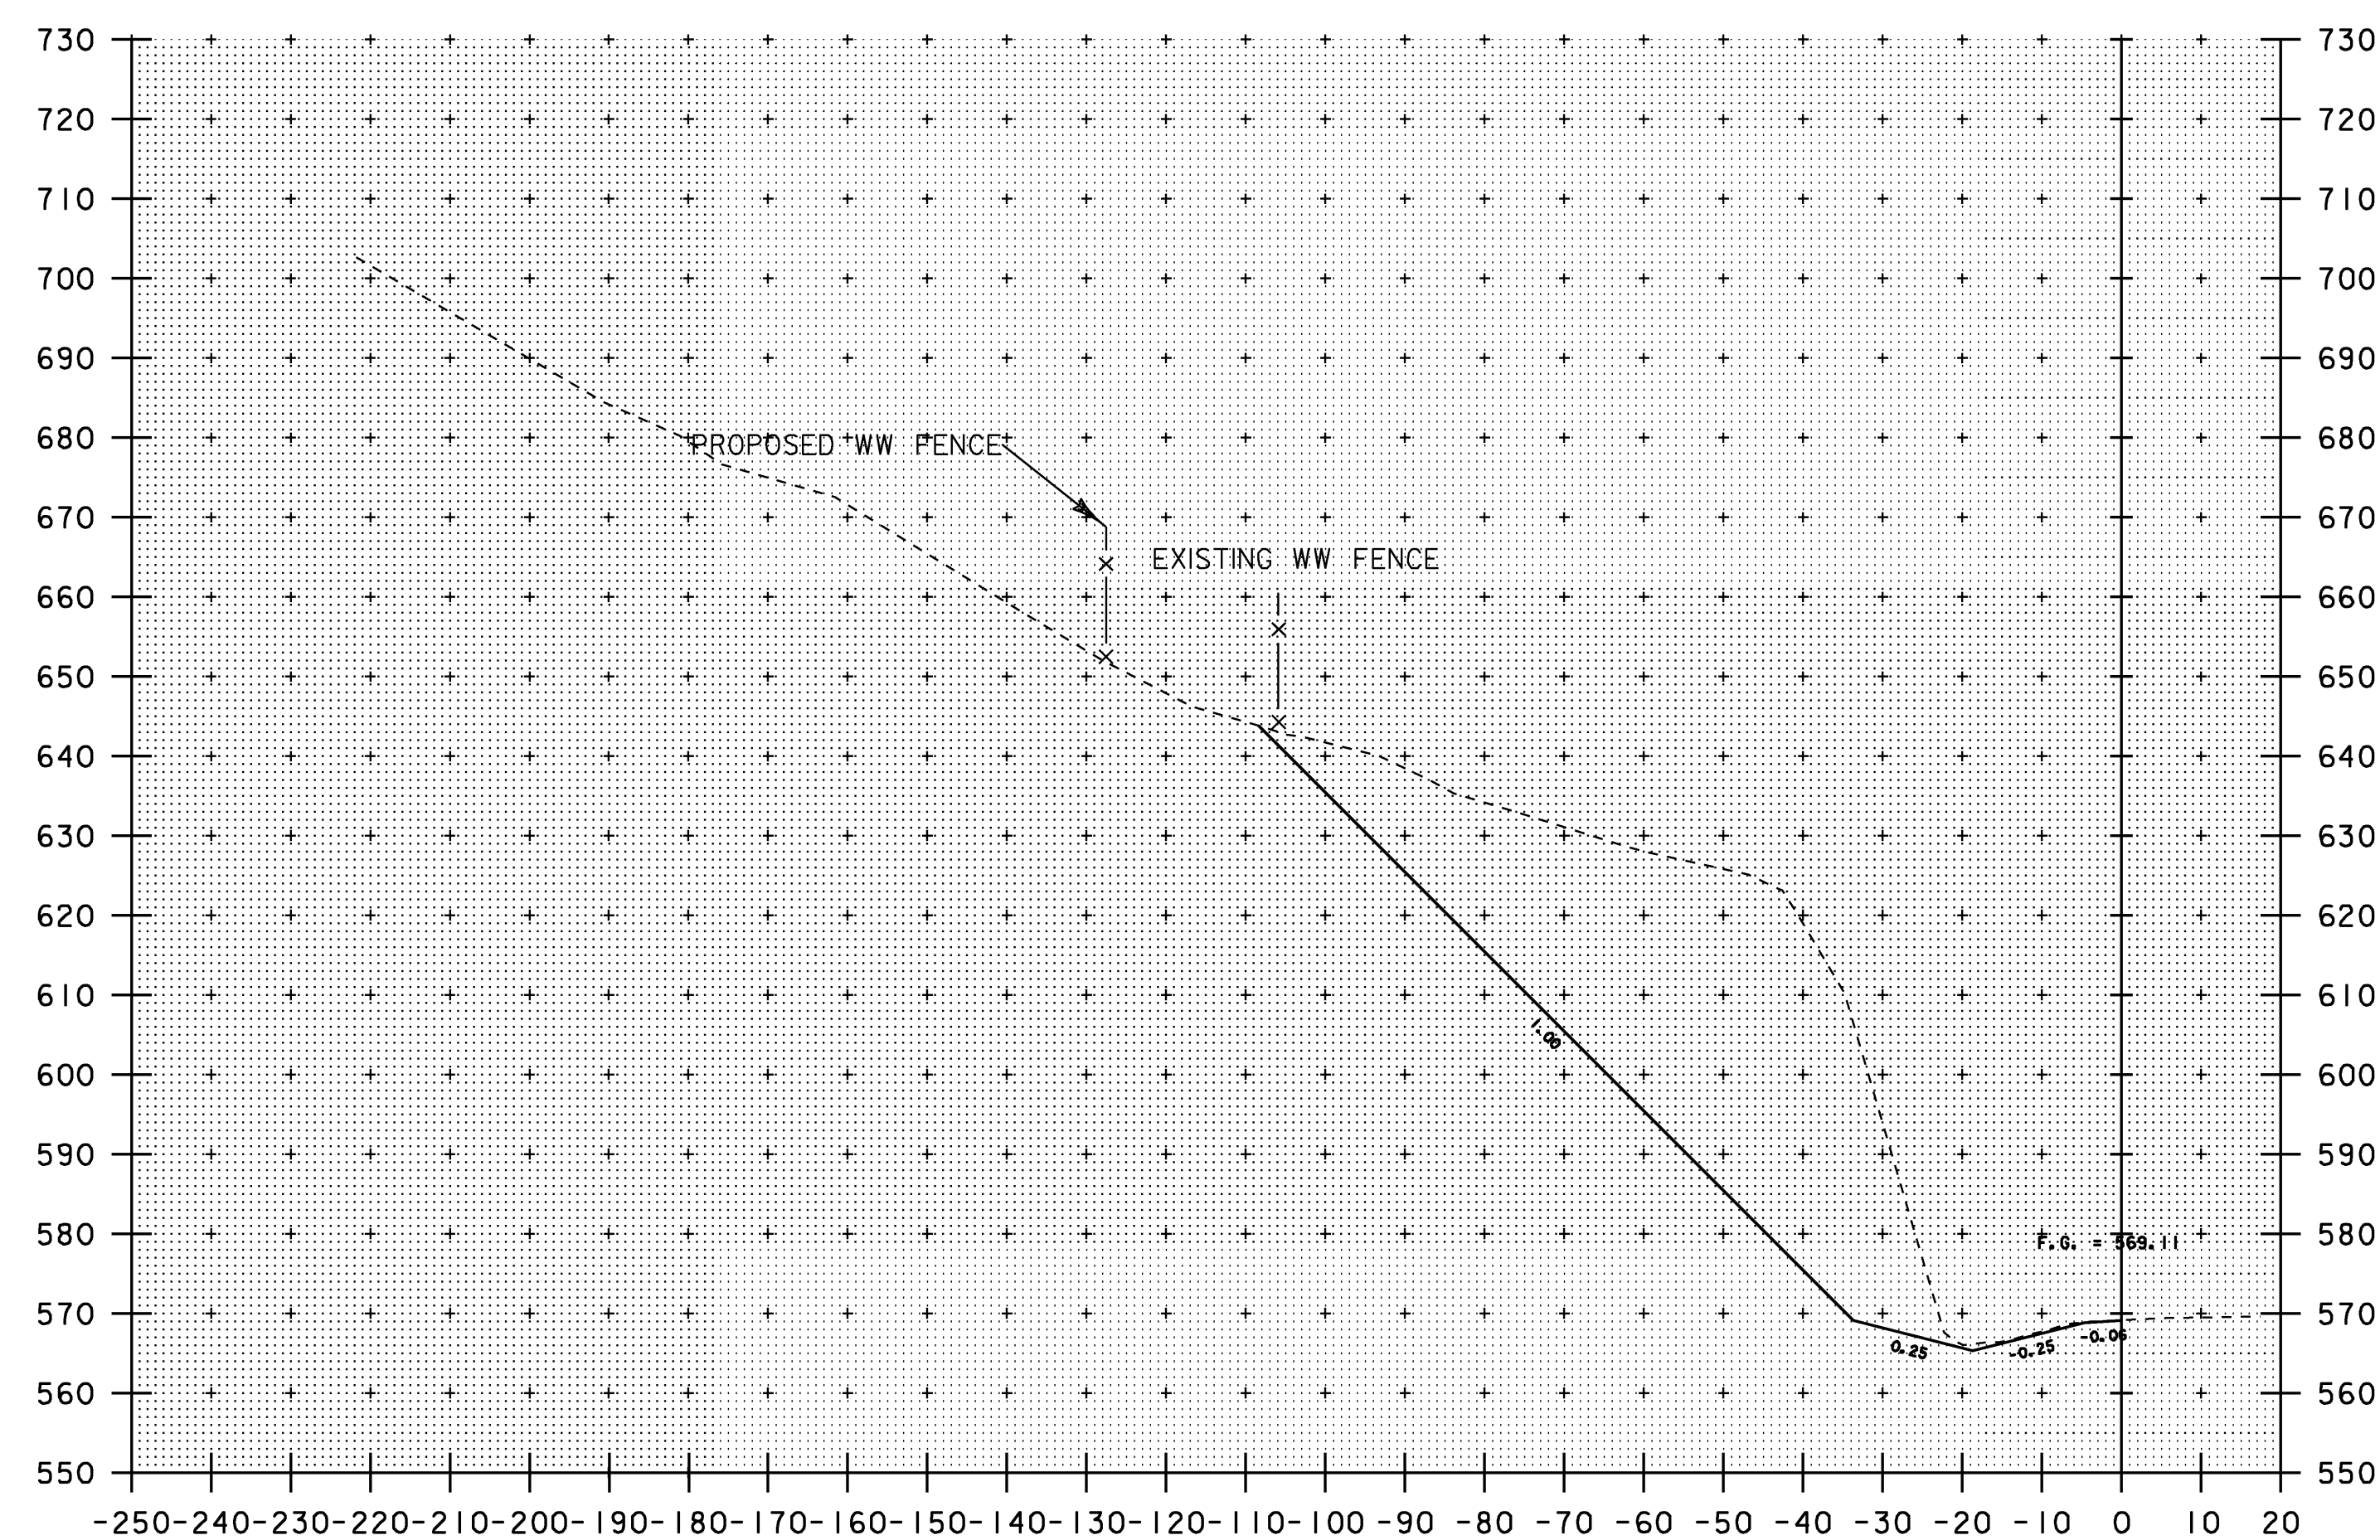

4599+50

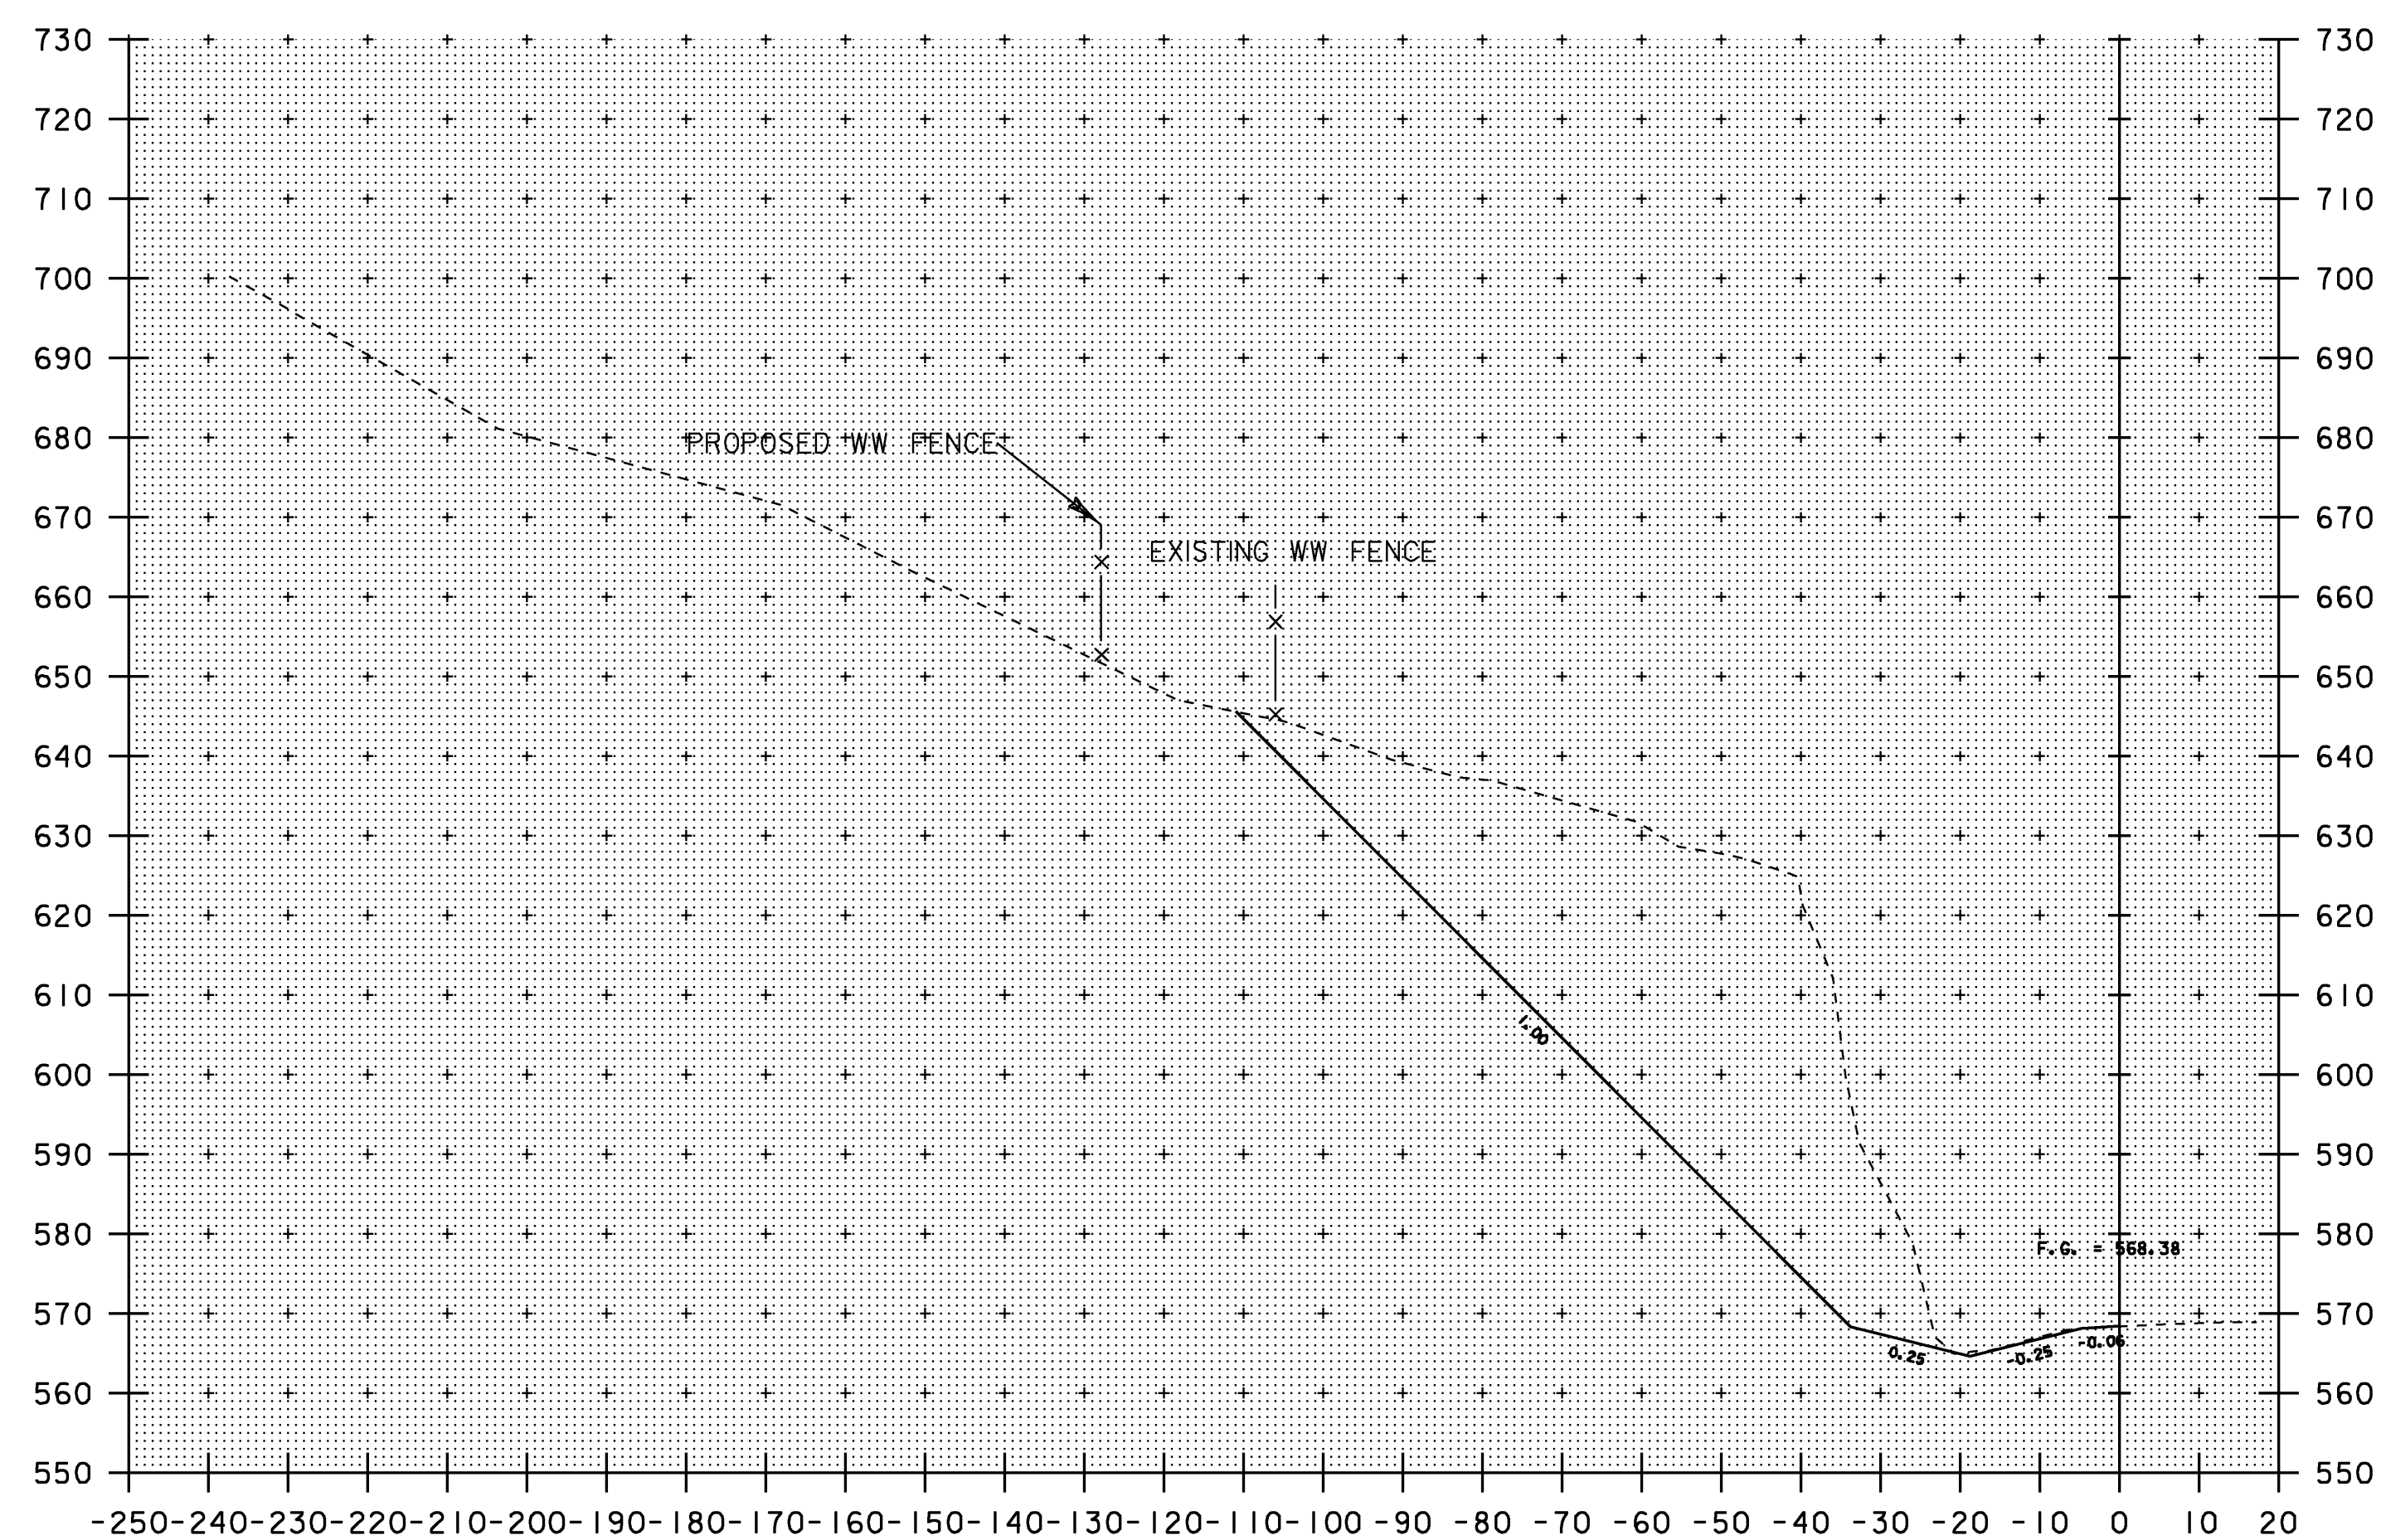

4600+00

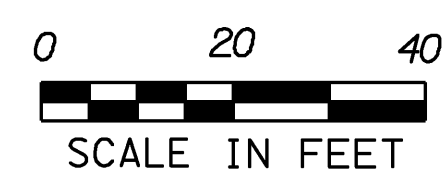

NOTE: ALIGNMENT IS THE CENTER OF THE SHOULDER LINE AND EDGE OF PAVEMENT.

MM 86.63 - MM 86.75

SOUTHBOUND CROSS SECTIONS #6

PROJECT NAME: HARTFORD - NEWBURY	
PROJECT NUMBER: IM 091-2(72)	
FILE NAME: d99a052_bdr_xs.dgn	PLOT DATE: 21-JUL-2009
PROJECT LEADER: K. UPMAL	DRAWN BY: N. PAPPAS
DESIGNED BY: N. PAPPAS	CHECKED BY: A. BOMBARDIER
IPARM FILE NAME: d99a052_bdr_xs_sb_06	SHEET 35 OF 45