

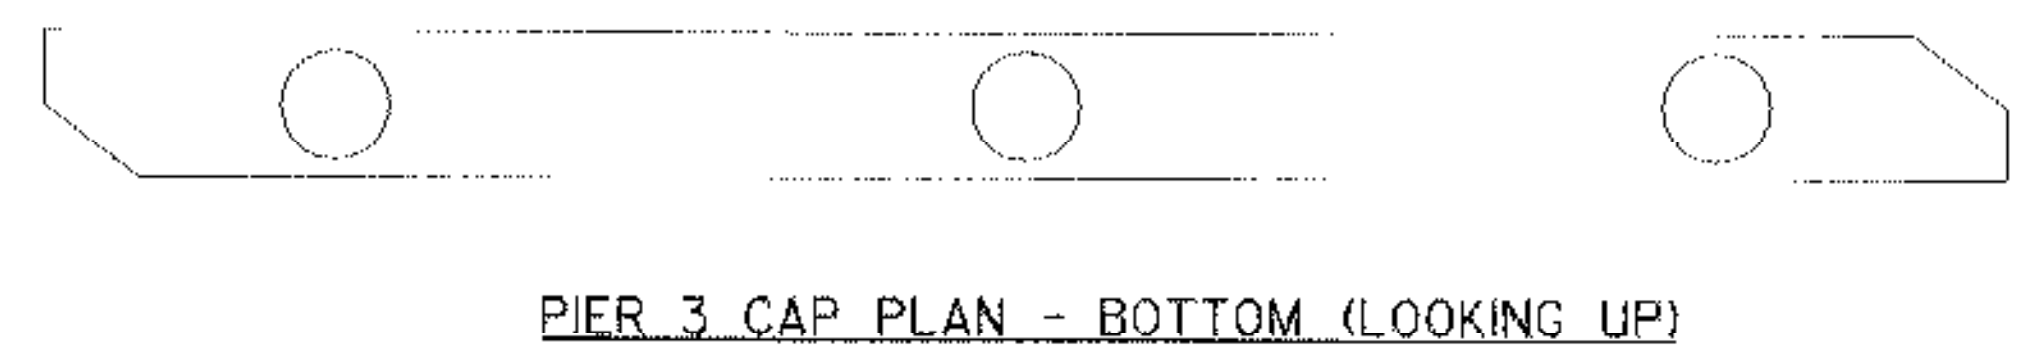



ALL PEDESTALS HAVE RECESSES

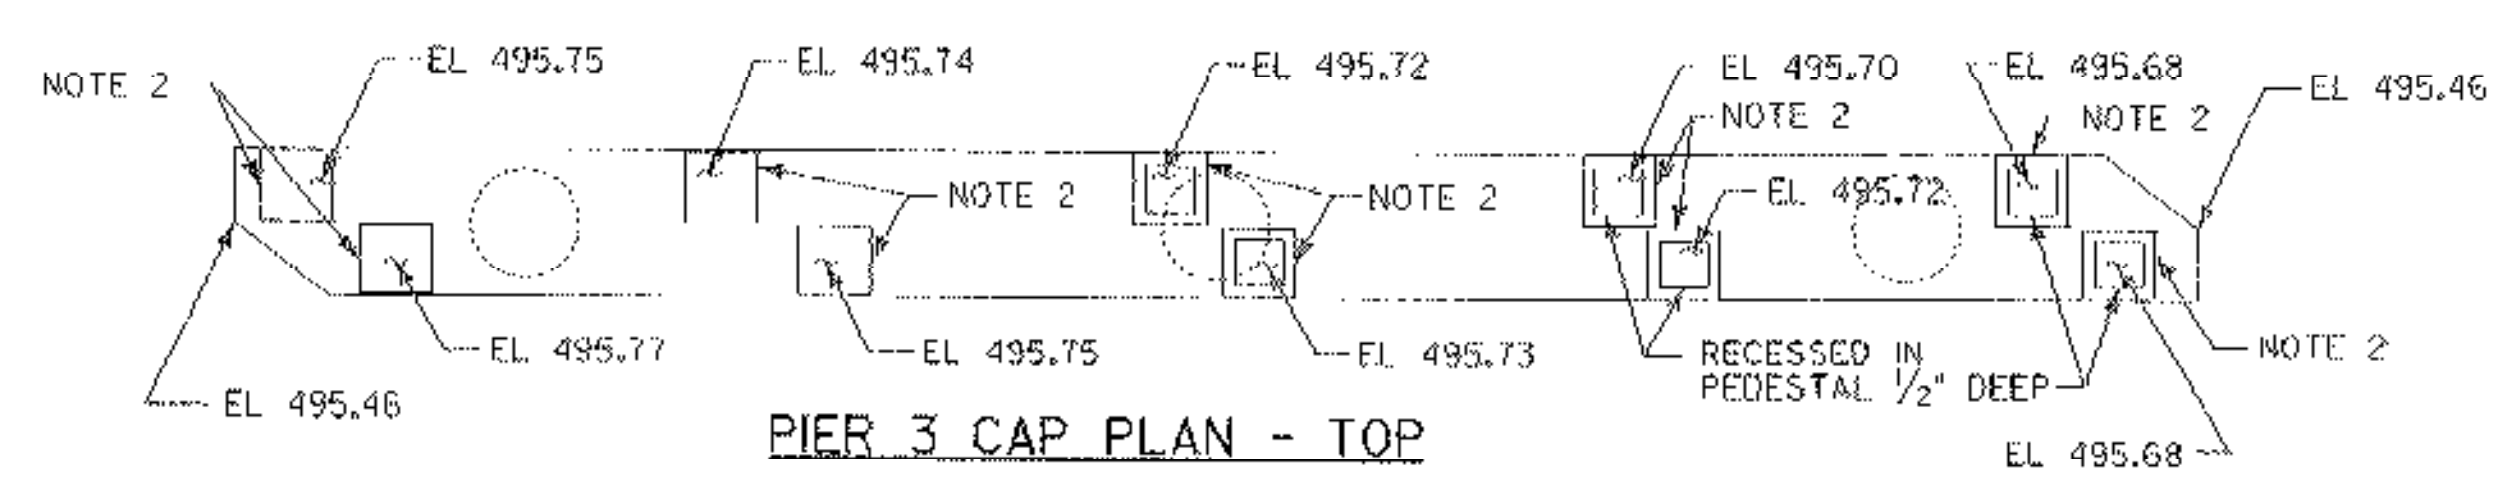


- NOTES:**
- 1. ELEVATIONS ARE REFERENCE ELEVATIONS BASED ON SURVEY DATA.
  - 2. REMOVE AND REBUILD NOTED PEDESTALS PER DETAILS GIVEN ON SHEET 36.
  - 3. REFER TO SHEET 36 FOR THE PIER BEAM SEAT ELEVATIONS.
  - 4. PROVIDE A SHM IN ACCORDANCE WITH THE DETAILS GIVEN ON SHEET 21 WHEN THE PIER BEAM SEAT ELEVATION IS HIGHER THAN THE EXISTING PIER BEAM SEAT ELEVATION AND THE PEDESTAL IS NOT BEING REBUILT PER NOTE 2.

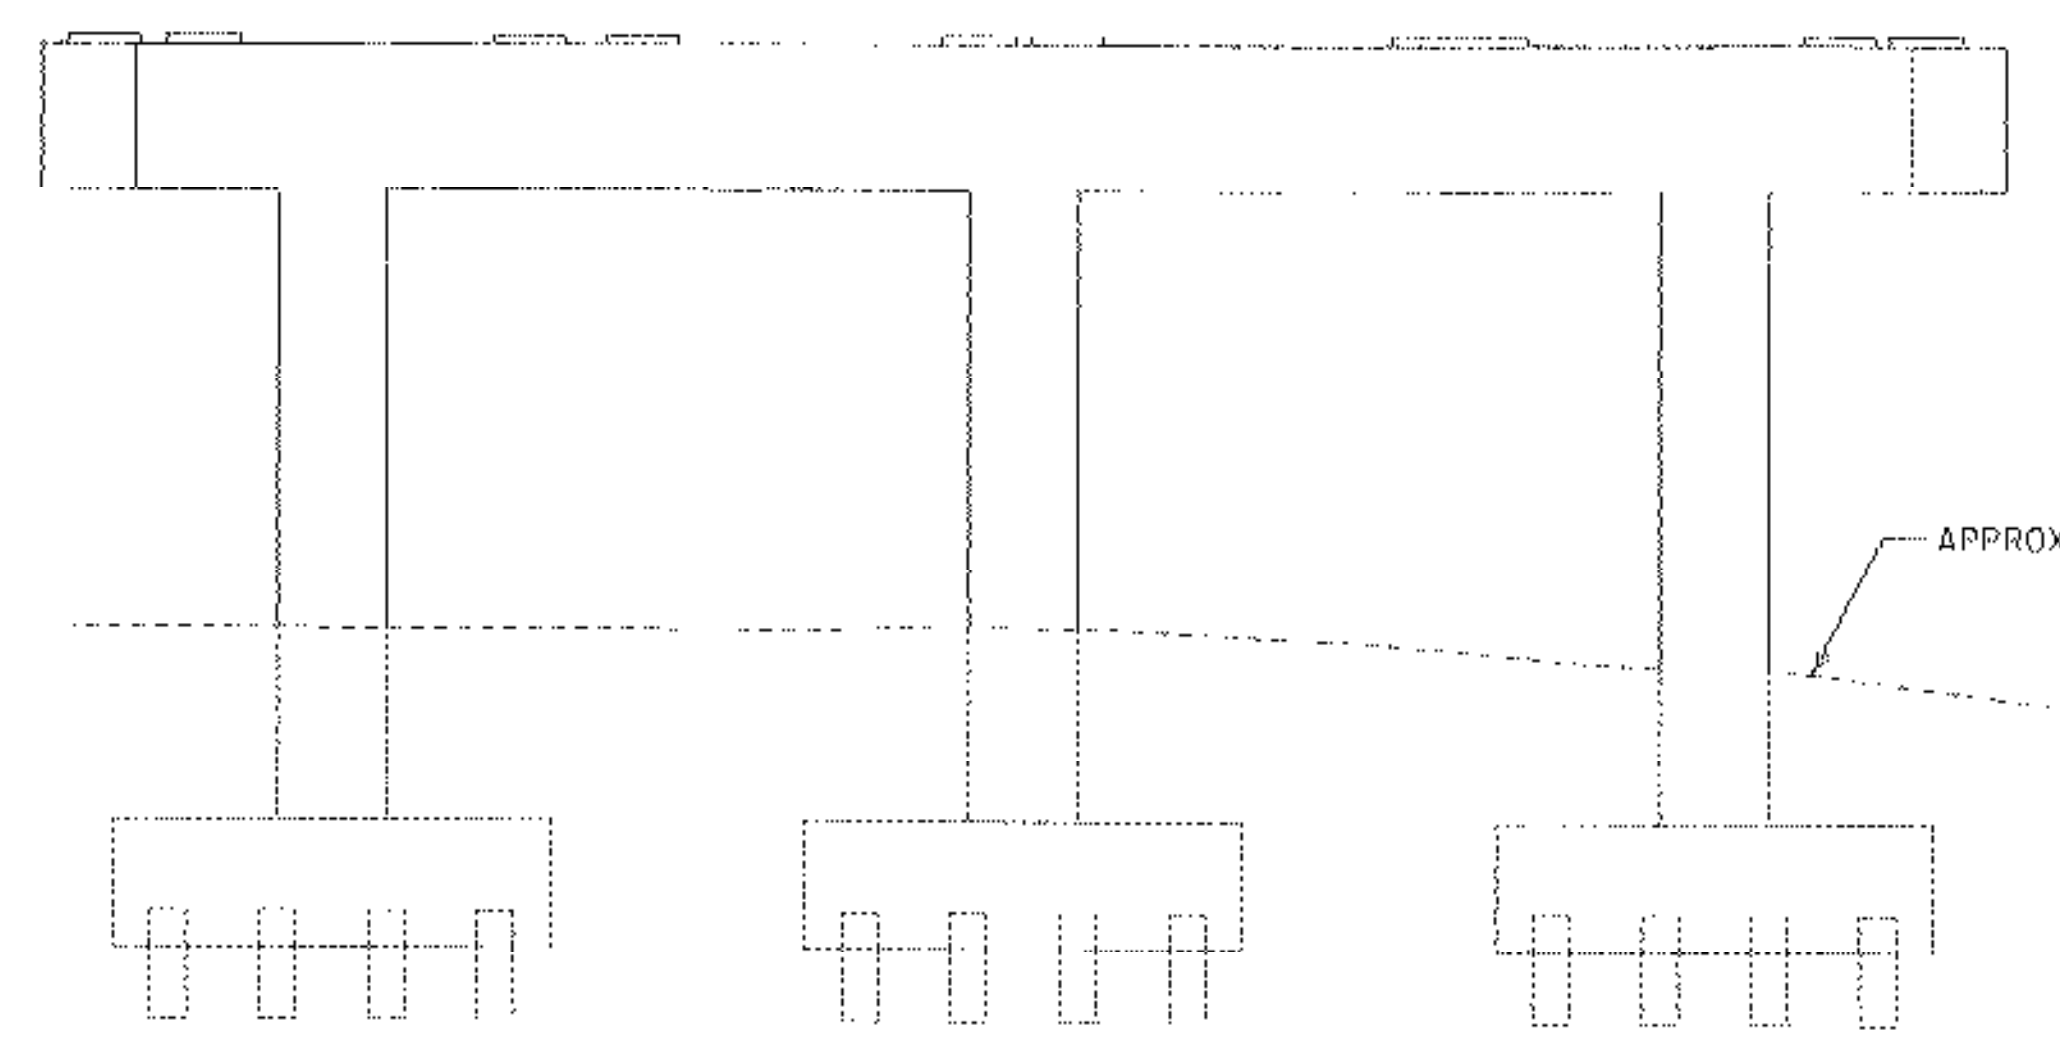


EAST ELEVATION

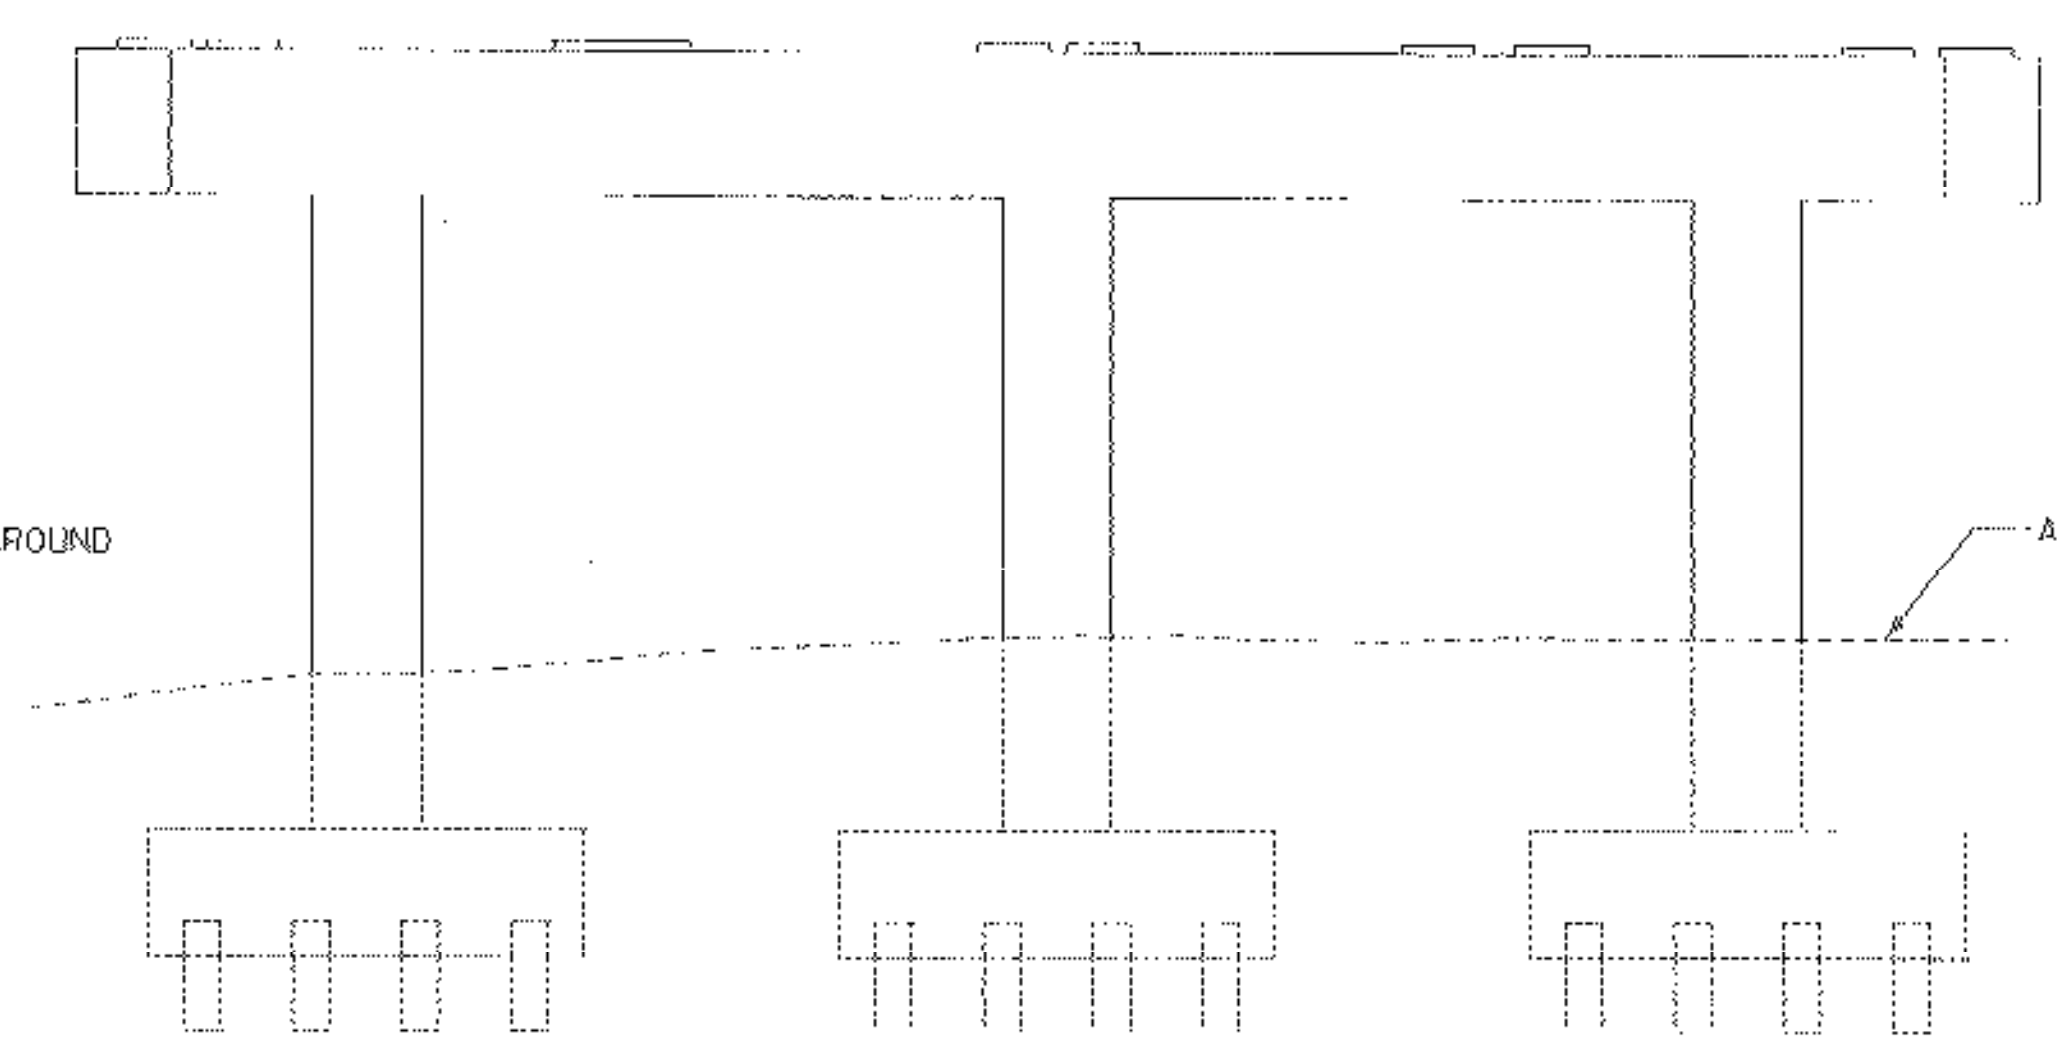


WEST ELEVATION

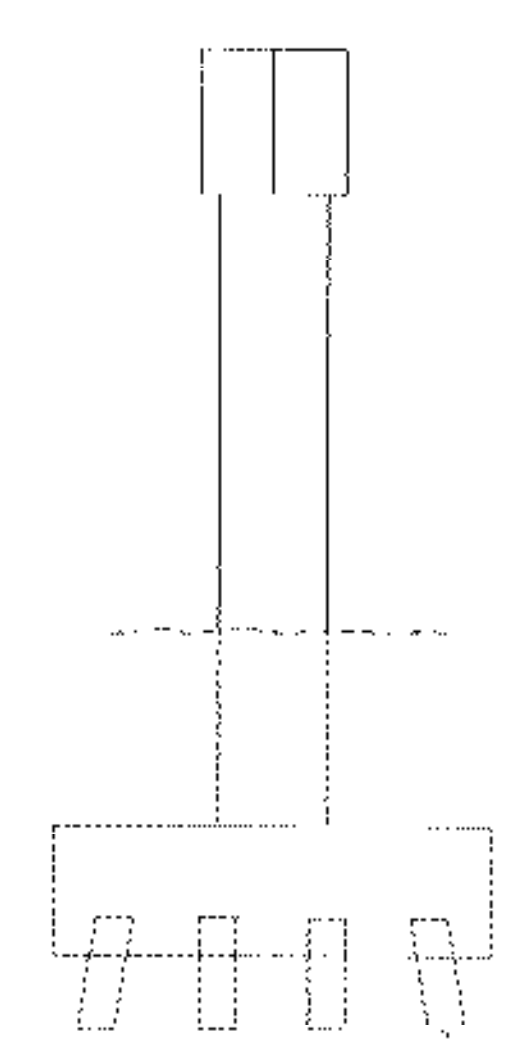


SOUTH FACE  
SOUTH COLUMN

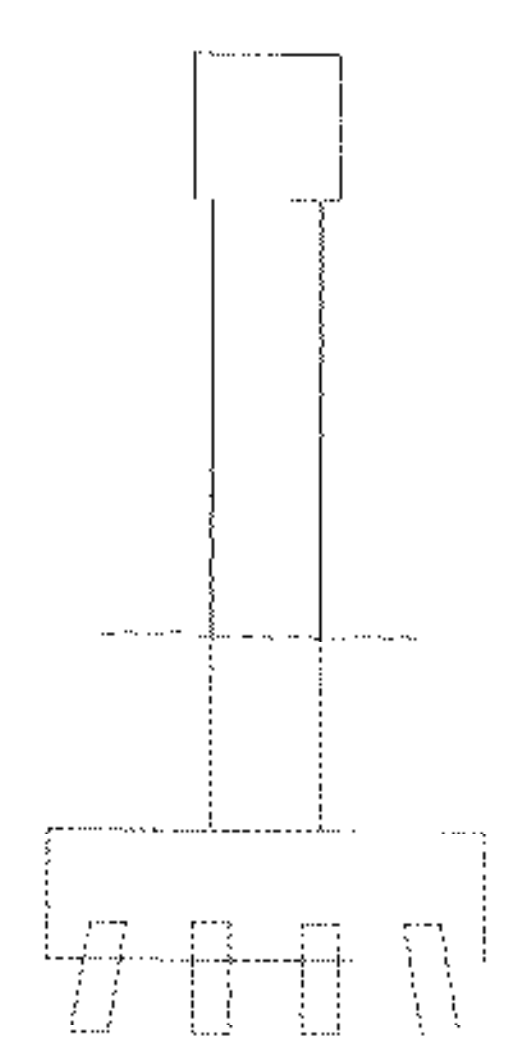


SOUTH FACE  
MIDDLE COLUMN

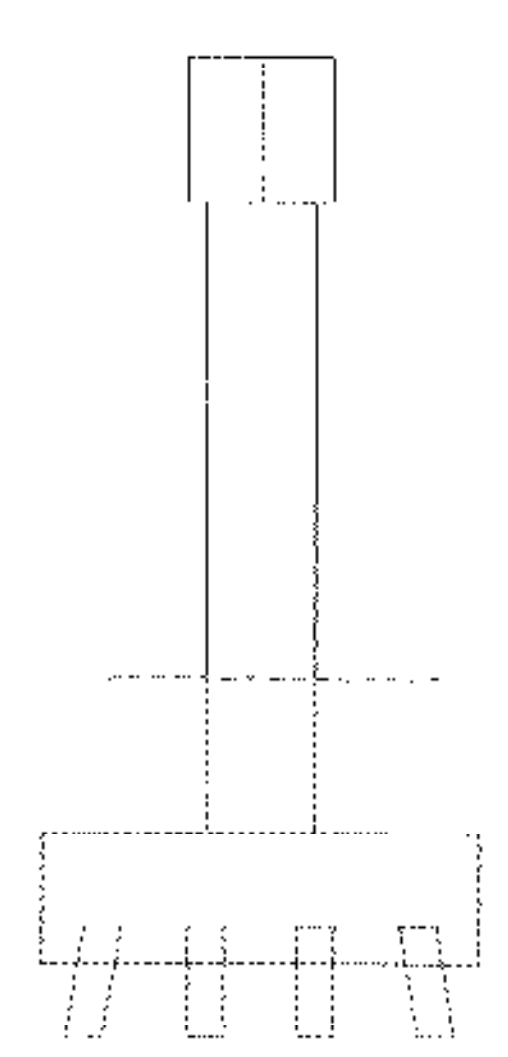


SOUTH FACE  
NORTH COLUMN

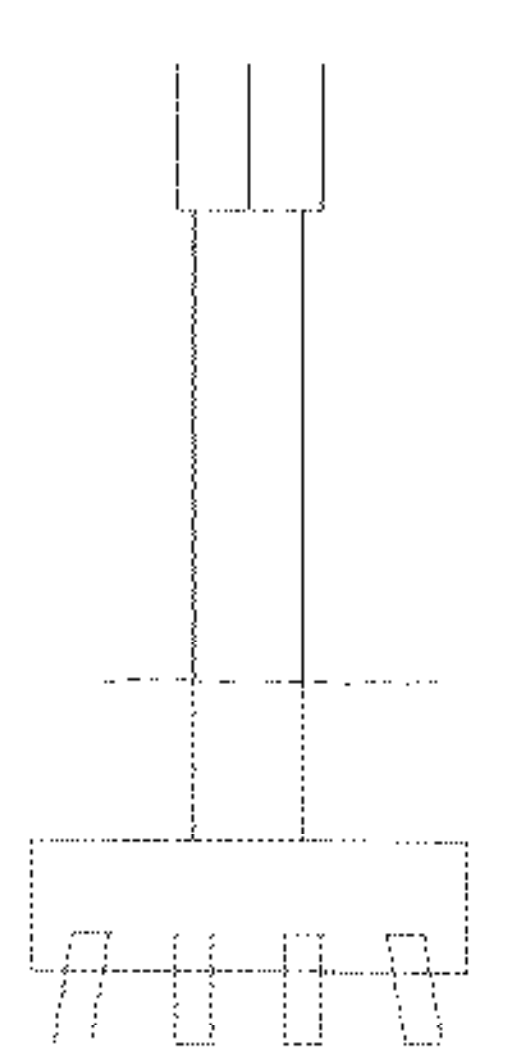

NORTH FACE  
NORTH COLUMN

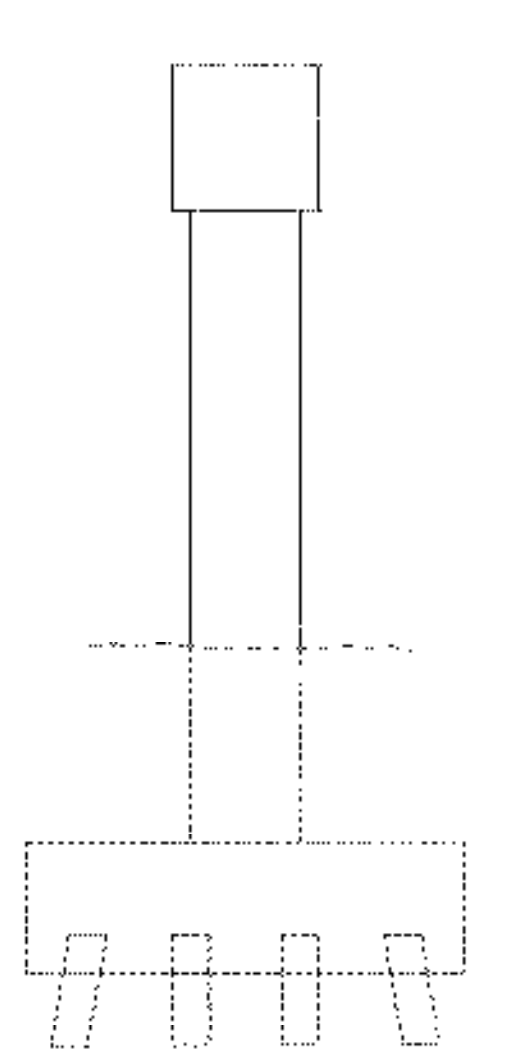

NORTH FACE  
MIDDLE COLUMN

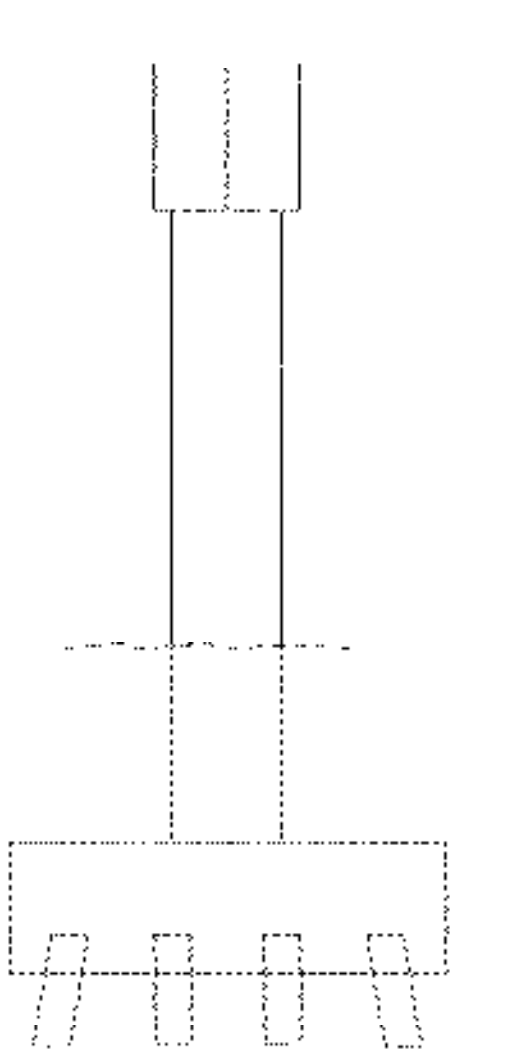

NORTH FACE  
SOUTH COLUMN

**LEGEND:**

- SPALL
- DELANIMATION
- SURFACE CRACK

SCALE 3/16" = 1'-0"

| STATE OF VERMONT<br>AGENCY OF TRANSPORTATION |                |                                                     |  |
|----------------------------------------------|----------------|-----------------------------------------------------|--|
| Town Of HARTLAND                             |                | Bridge No. 38                                       |  |
| Highway No. 1-91                             |                | Log Sta.                                            |  |
|                                              |                | Surv. Sta.                                          |  |
| PIER NO. 3                                   |                |                                                     |  |
| REPAIR AREAS                                 |                |                                                     |  |
| Designed By S. YONGHO                        |                | Drawn By N. HERRERA                                 |  |
| Checked By S. YONGHO                         | Date DEC. 2000 | Bridge Design Supervisor E. JOHNSTON Date FEB. 2000 |  |
| PROJECT HARTLAND                             |                | PROJECT NO. 1M 091-1(36)                            |  |
| Drawing Name 2a272pr3.dgn                    |                |                                                     |  |
| Bridge Sheet No.                             |                | Sheet 34 of 85                                      |  |

STONE & WEBSTER, INC.