



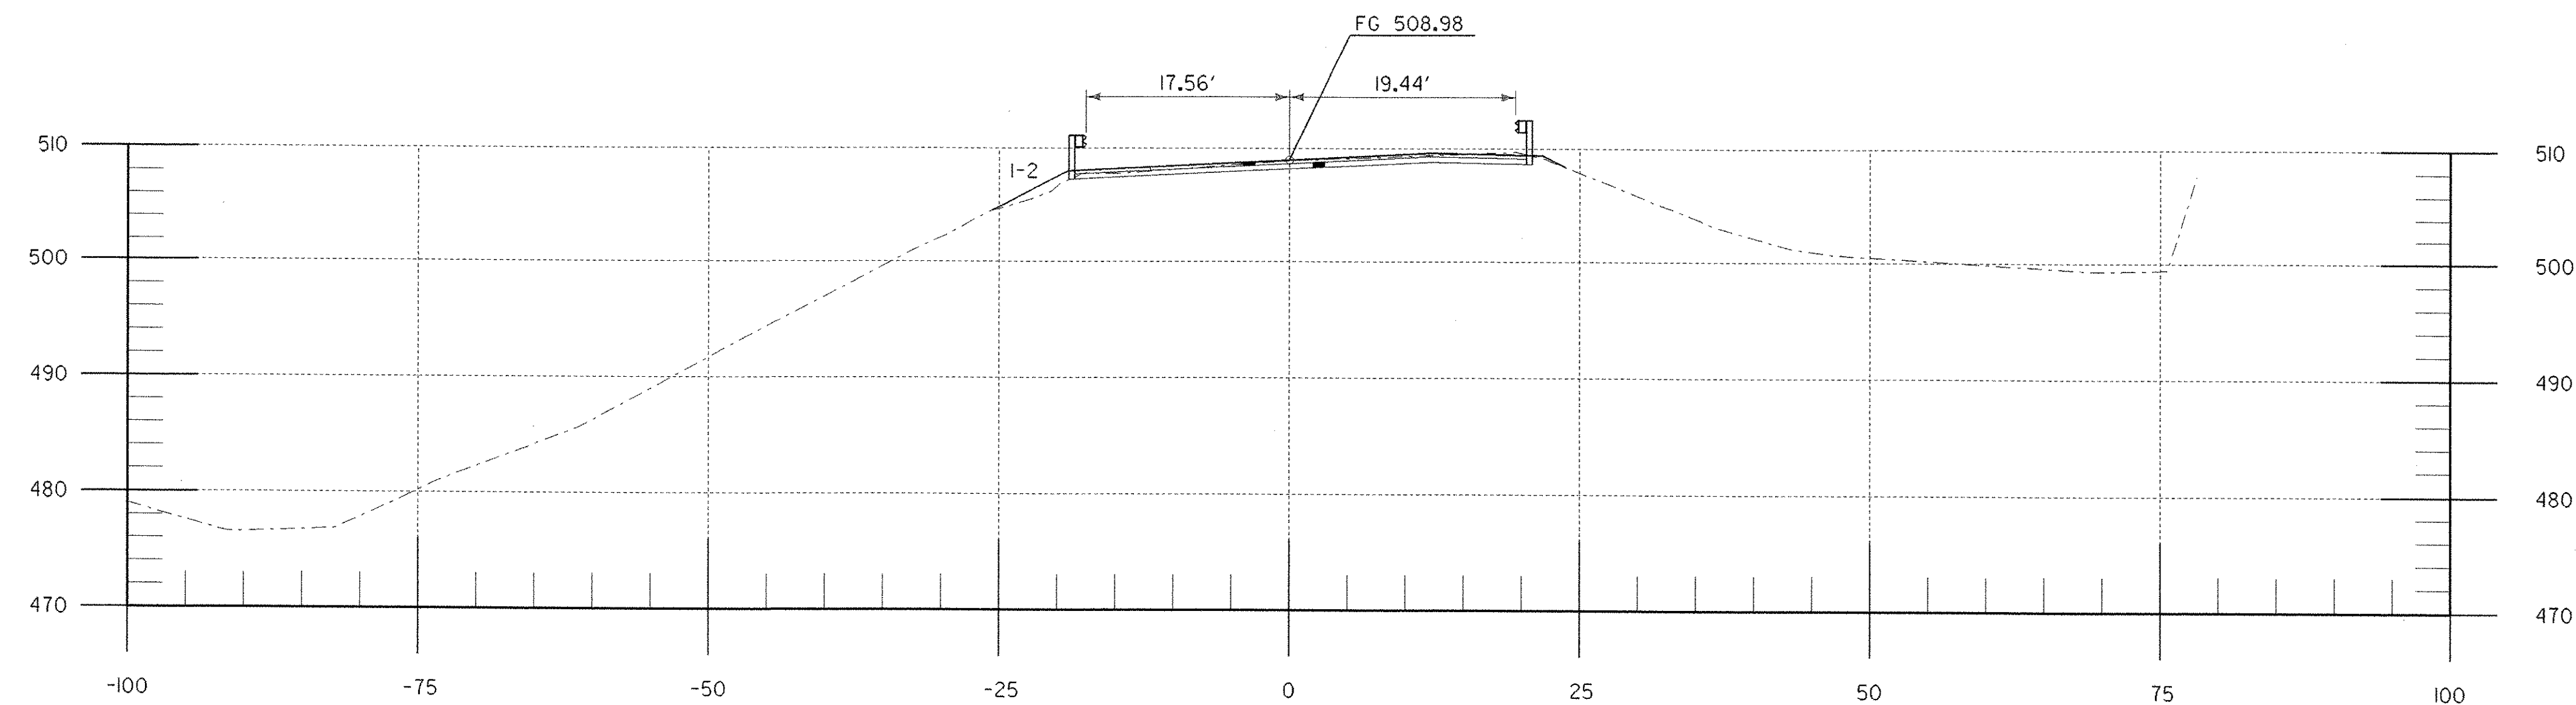

427+60

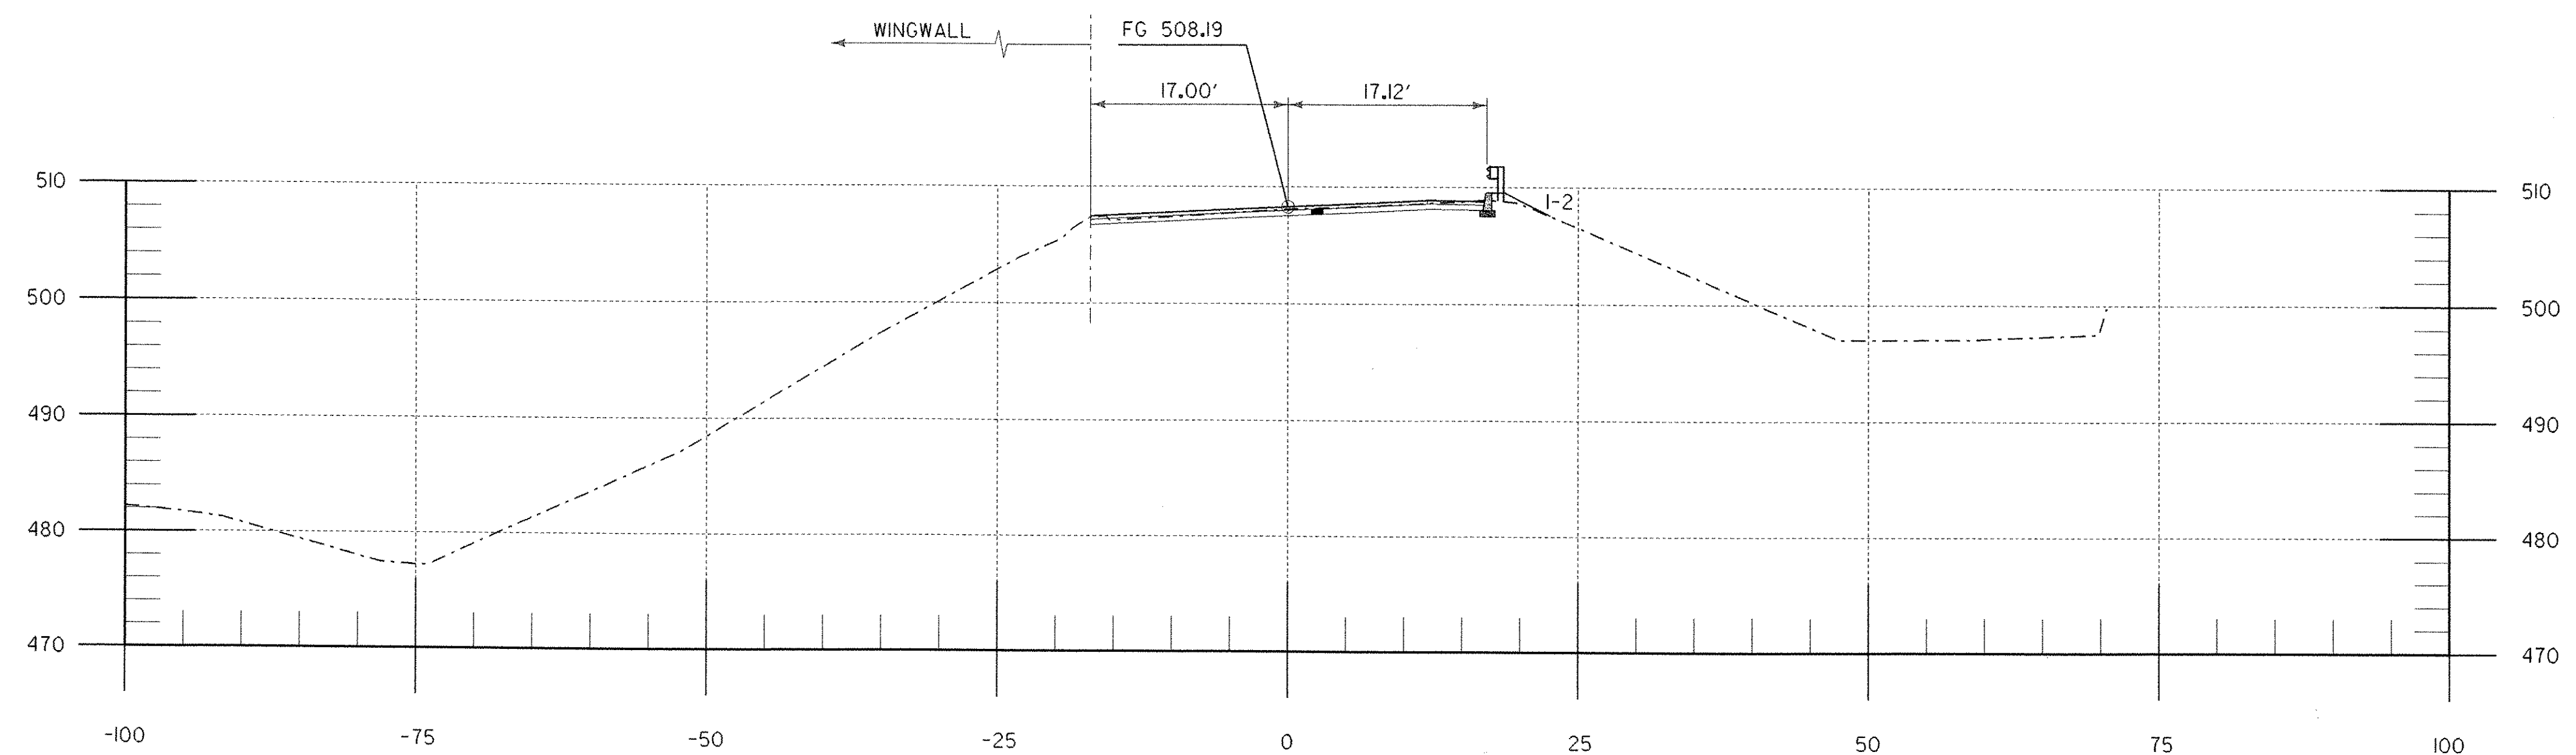

427+20

SCALE 1" = 10'-0"

STATE OF VERMONT AGENCY OF TRANSPORTATION

Town Of	HARTLAND	Bridge No.	38
Highway No.	1-91	Log Sta.	
		Surv. Sta.	
US 5 CROSS SECTIONS			
STA 427+20 TO 427+60			
Designed By	J. BARRACK	Drawn By	N. HERRERA
Checked By	J. BARRACK	Bridge Design Supervisor	E. JOHNSTON
Date	DEC 2000	Date	FEB. 2001
PROJECT	HARTLAND	PROJECT NO.	IM 091-1(36)
Drawing Name	za272xs3.dgn	Bridge Sheet No.	Sheet 44 of 85

STONE & WEBSTER, INC.

10-DEC-2002

v:\Civil\working\za272xs3.dgn