



8b
8a

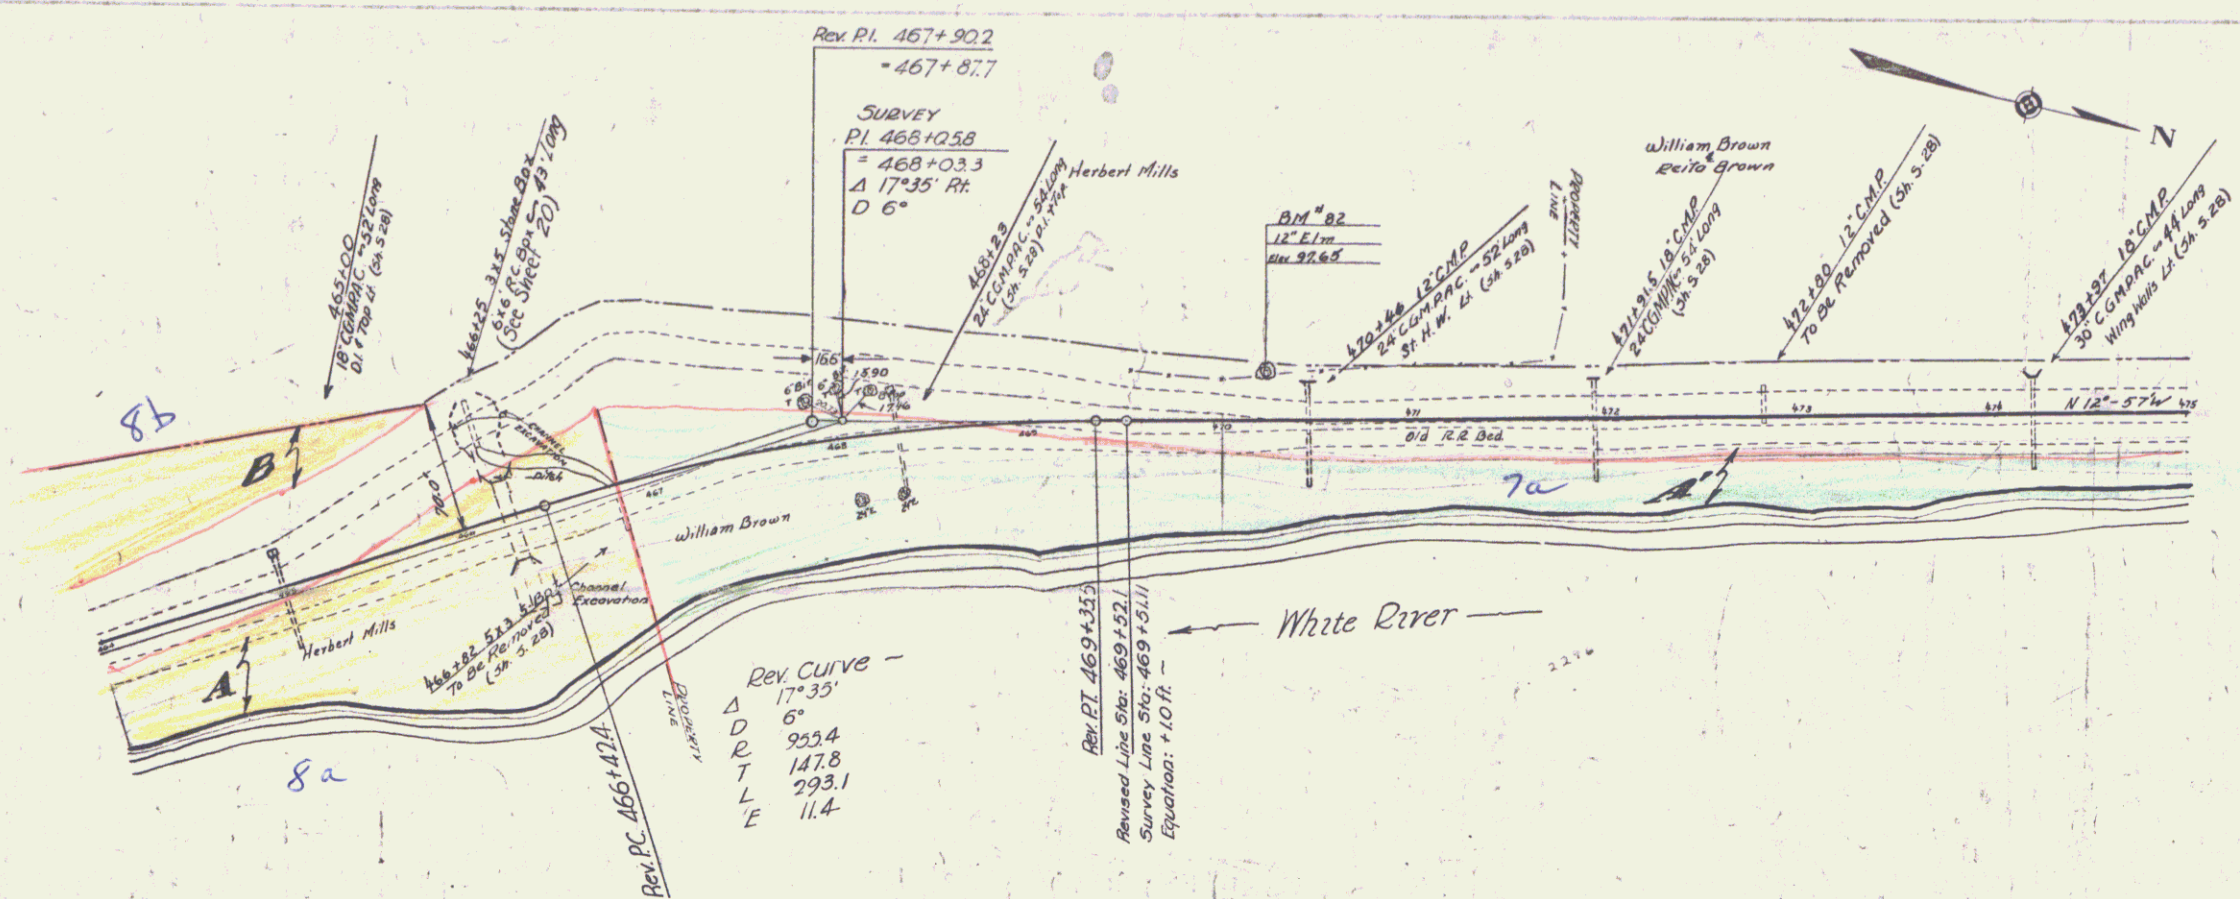

PARCEL	INSTRUMENT	DATE	GRANTOR	GRANTEE	RECORDED STOCK	REMARKS
1800	O.C.D.	5-6-37	HERBERT MILLS	STOCK	20	347.8 7-12-37 CUL. STA.
A.B.	O.C.D.	5-25-37	W.B. BROWN	"	29	343.4 6-21-37 18100 101100 191100

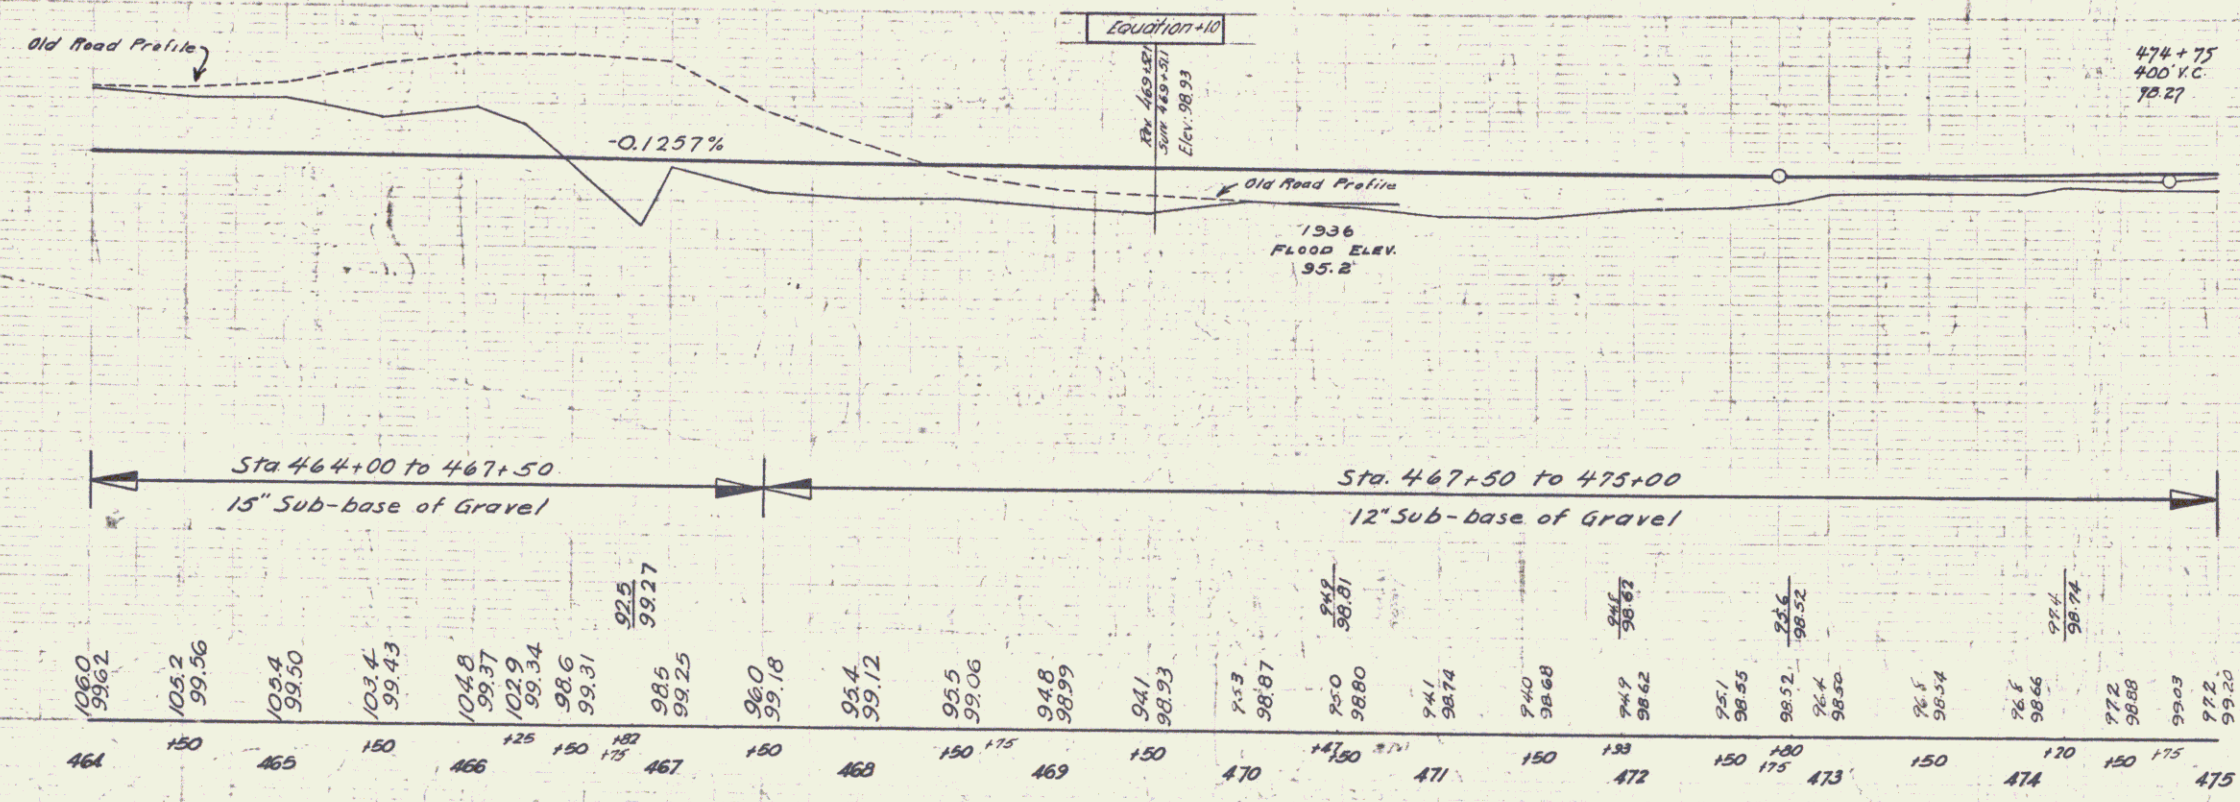

B.M. #82 3pt. in 12' Elm 20 ft. Sta 470+12 Elev. 97.65