


TYPICAL SECTIONS

7" ONE COURSE CEMENT CONC. PAVT. ITEM 35-A.

FRANK
10-0-0 1939 3 43

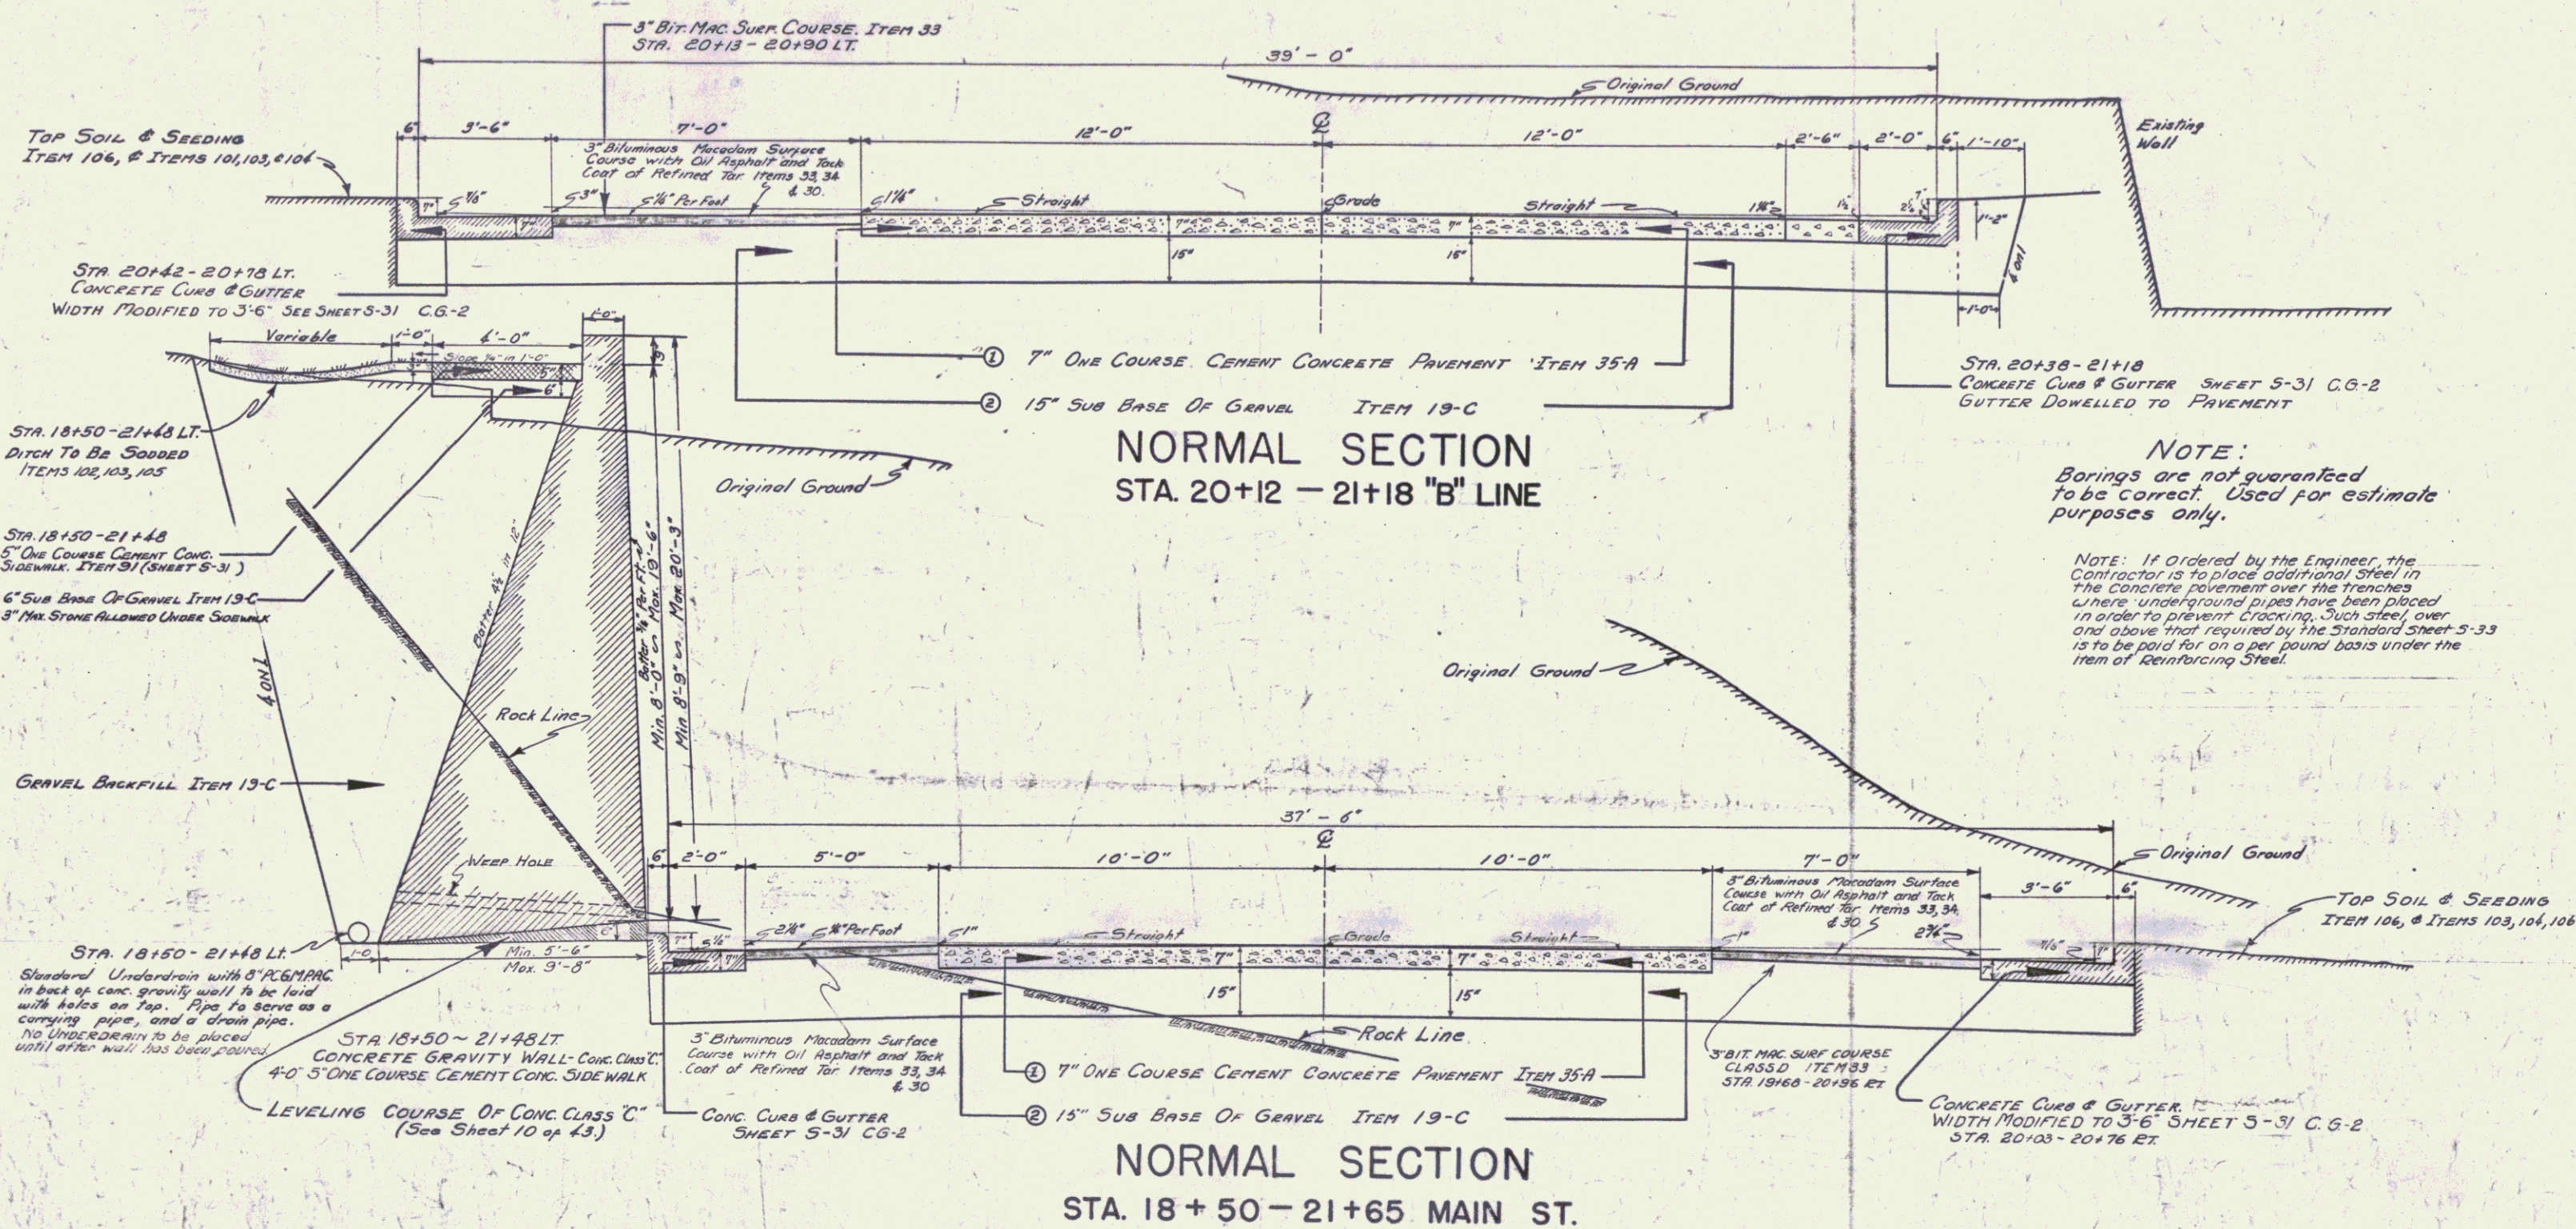

NOTE:
Borings are not guaranteed
to be correct. Used for estimate
purposes only.

NOTE: If ordered by the Engineer, the
Contractor is to place additional steel in
the concrete pavement over the trenches
where underground pipes have been placed
in order to prevent cracking. Such steel, over
and above that required by the Standard Sheet 5-33
is to be paid for on a per pound basis under the
item of Reinforcing Steel.

ESTIMATED QUANTITIES

Surveyed by A.D. WOOD
Designed by R. J. RUTHERFORD
Drawn by E. J. B.
Traced by E. J. B.
Checked by J. H. C.
Series FRANK No. 101-0 (1) Filed
Sheet 3 of 3 Sheets