

19	DETAILS OF 15'-0" GUMP AT STA. 95+13.9	
20	CHANNEL SECTIONS AT STA. 95+25	
25	DETAILS OF 7'-0" GUMP AT STA. 114+66	
27-30	CHANNEL SECTIONS AT STA. 114+66	
31	SANITWORK SHEET (MULTIPLUATE CULVERTS)	
32	DETAILS OF ABUTMENT #1 AT STA. 107+92	
33	" " #2 AT STA. 168+71	
34	EARTHWORK SHEET (BRIDGE)	
35	REINFORCING STEEL SCHEDULE	
36-39	CHANNEL SECTIONS AT STA. 107+92	
40-41	BRIDGE STANDARD SHEET	SB-30-56
42	" " " " " "	SB-5A-55
43	" " " " " "	SB-20-56 (DETAILS, C.O.B.E)
44	ROADWAY STANDARD SHEET	RS 99-31 (DRAINAGE TABLES)
45	" " " " " "	RS 99-33 (MURERS)
46	" " " " " "	RS 96-4 (DRAINAGE)
47	" " " " " "	RS 36-6 (SLOPE, GRADING)

48 ROADWAY STANDARD SHEET RS 56-11
(THREE CABLE GUARD RAIL WITH STEEL POSTS)
49 ROADWAY STANDARD SHEET RS 56-12
(BARRICADES, SIGNS & LIGHTS)
50-96 CROSS SECTION SHEETS

[illegible][illegible]

PROPOSED IMPROVEMENT

FEDERAL AID
SECONDARY PROJECT


COUNTY OF LAMOILLE

VERMONT ROUTE # 108

STOWE - JEFFERSONVILLE ROAD

BEGINNING AT A POINT APPROXIMATELY 2.0 MILES NORTHERLY OF THE
STOWE-CAMBRIDGE TOWN LINE AND EXTENDING NORTHERLY 2.019 MILES

LENGTH OF ROADWAY - 10582.9 FEET - 2.004 MILES
LENGTH OF BRIDGE - 79.0 FEET - 0.015 MILES
LENGTH OF PROJECT - 10661.9 FEET - 2.019 MILES

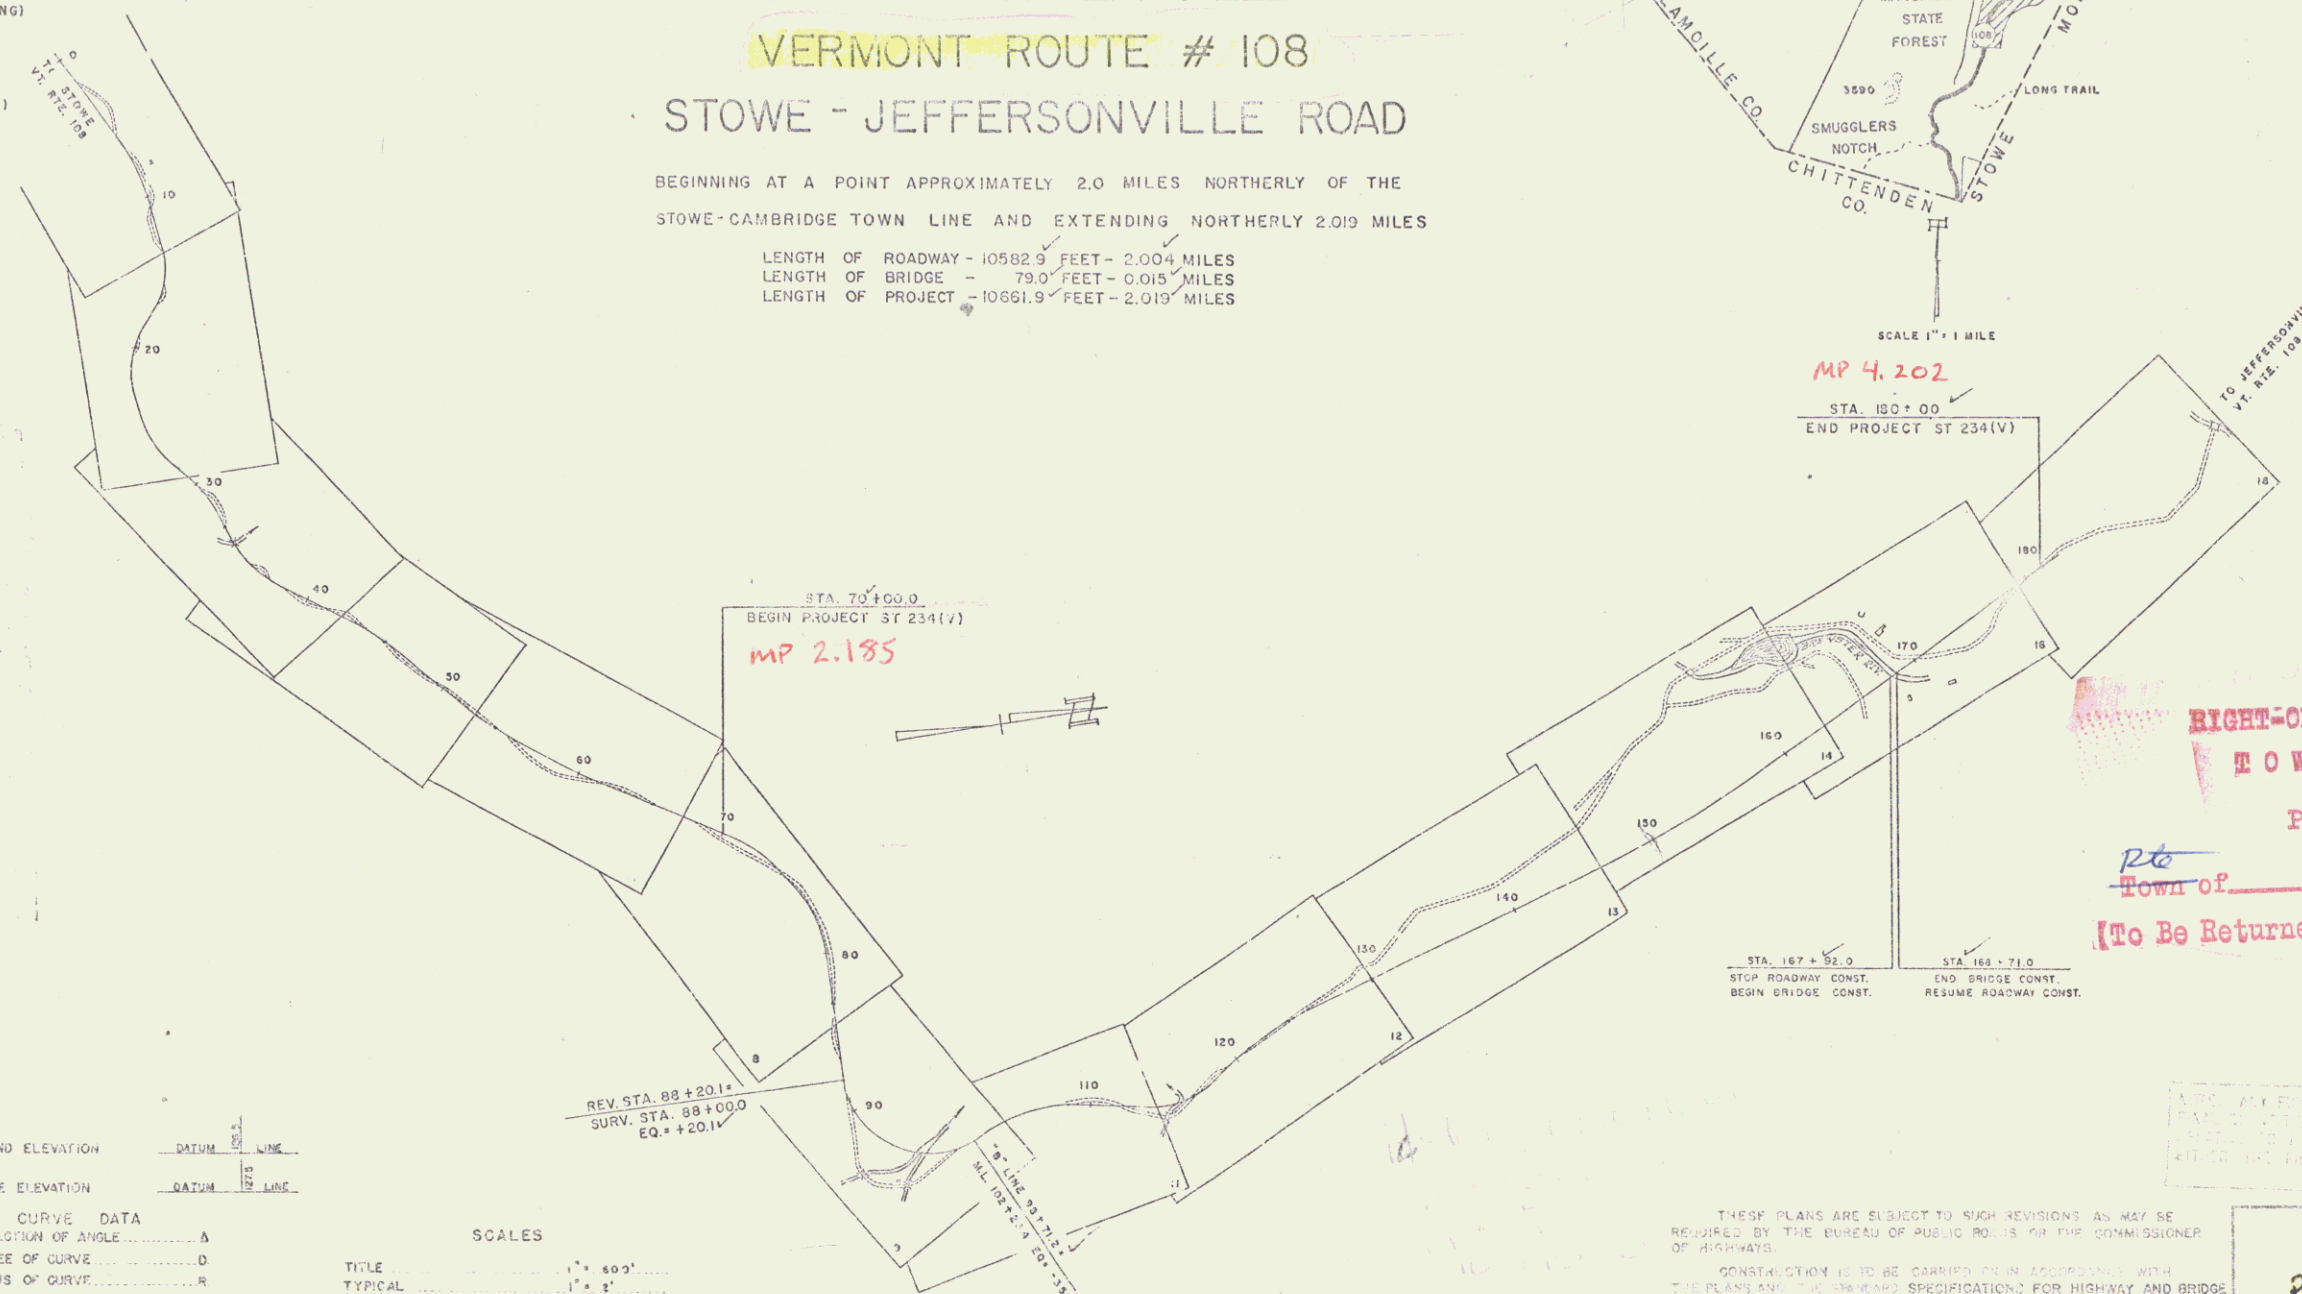

THESE PLANS ARE SUBJECT TO SUCH REVISIONS AS MAY BE REQUIRED BY THE BUREAU OF PUBLIC ROADS OR THE COMMISSIONER OF HIGHWAYS.

CONSTRUCTION IS TO BE CARRIED ON IN ACCORDANCE WITH THE PLANS AND THE STANDARD SPECIFICATIONS FOR HIGHWAY AND BRIDGE CONSTRUCTION OF JANUARY 1956 SUBMITTED TO THE BUREAU OF PUBLIC ROADS FOR APPROVAL APRIL 8, 1956, INCLUDING ALL SUBSEQUENT APPROVED REVISIONS AND SUCH REVISED SPECIFICATIONS AND SPECIAL PROVISIONS AS ARE SUBMITTED WITH THE PLANS.


DEPARTMENT OF COMMERCE
BUREAU OF PUBLIC ROADS

Pin # 00R037


Rt
Town of NH 108
(To Be Returned To R.O.W. Division)


STEARNS R. JENKINS


VH 108

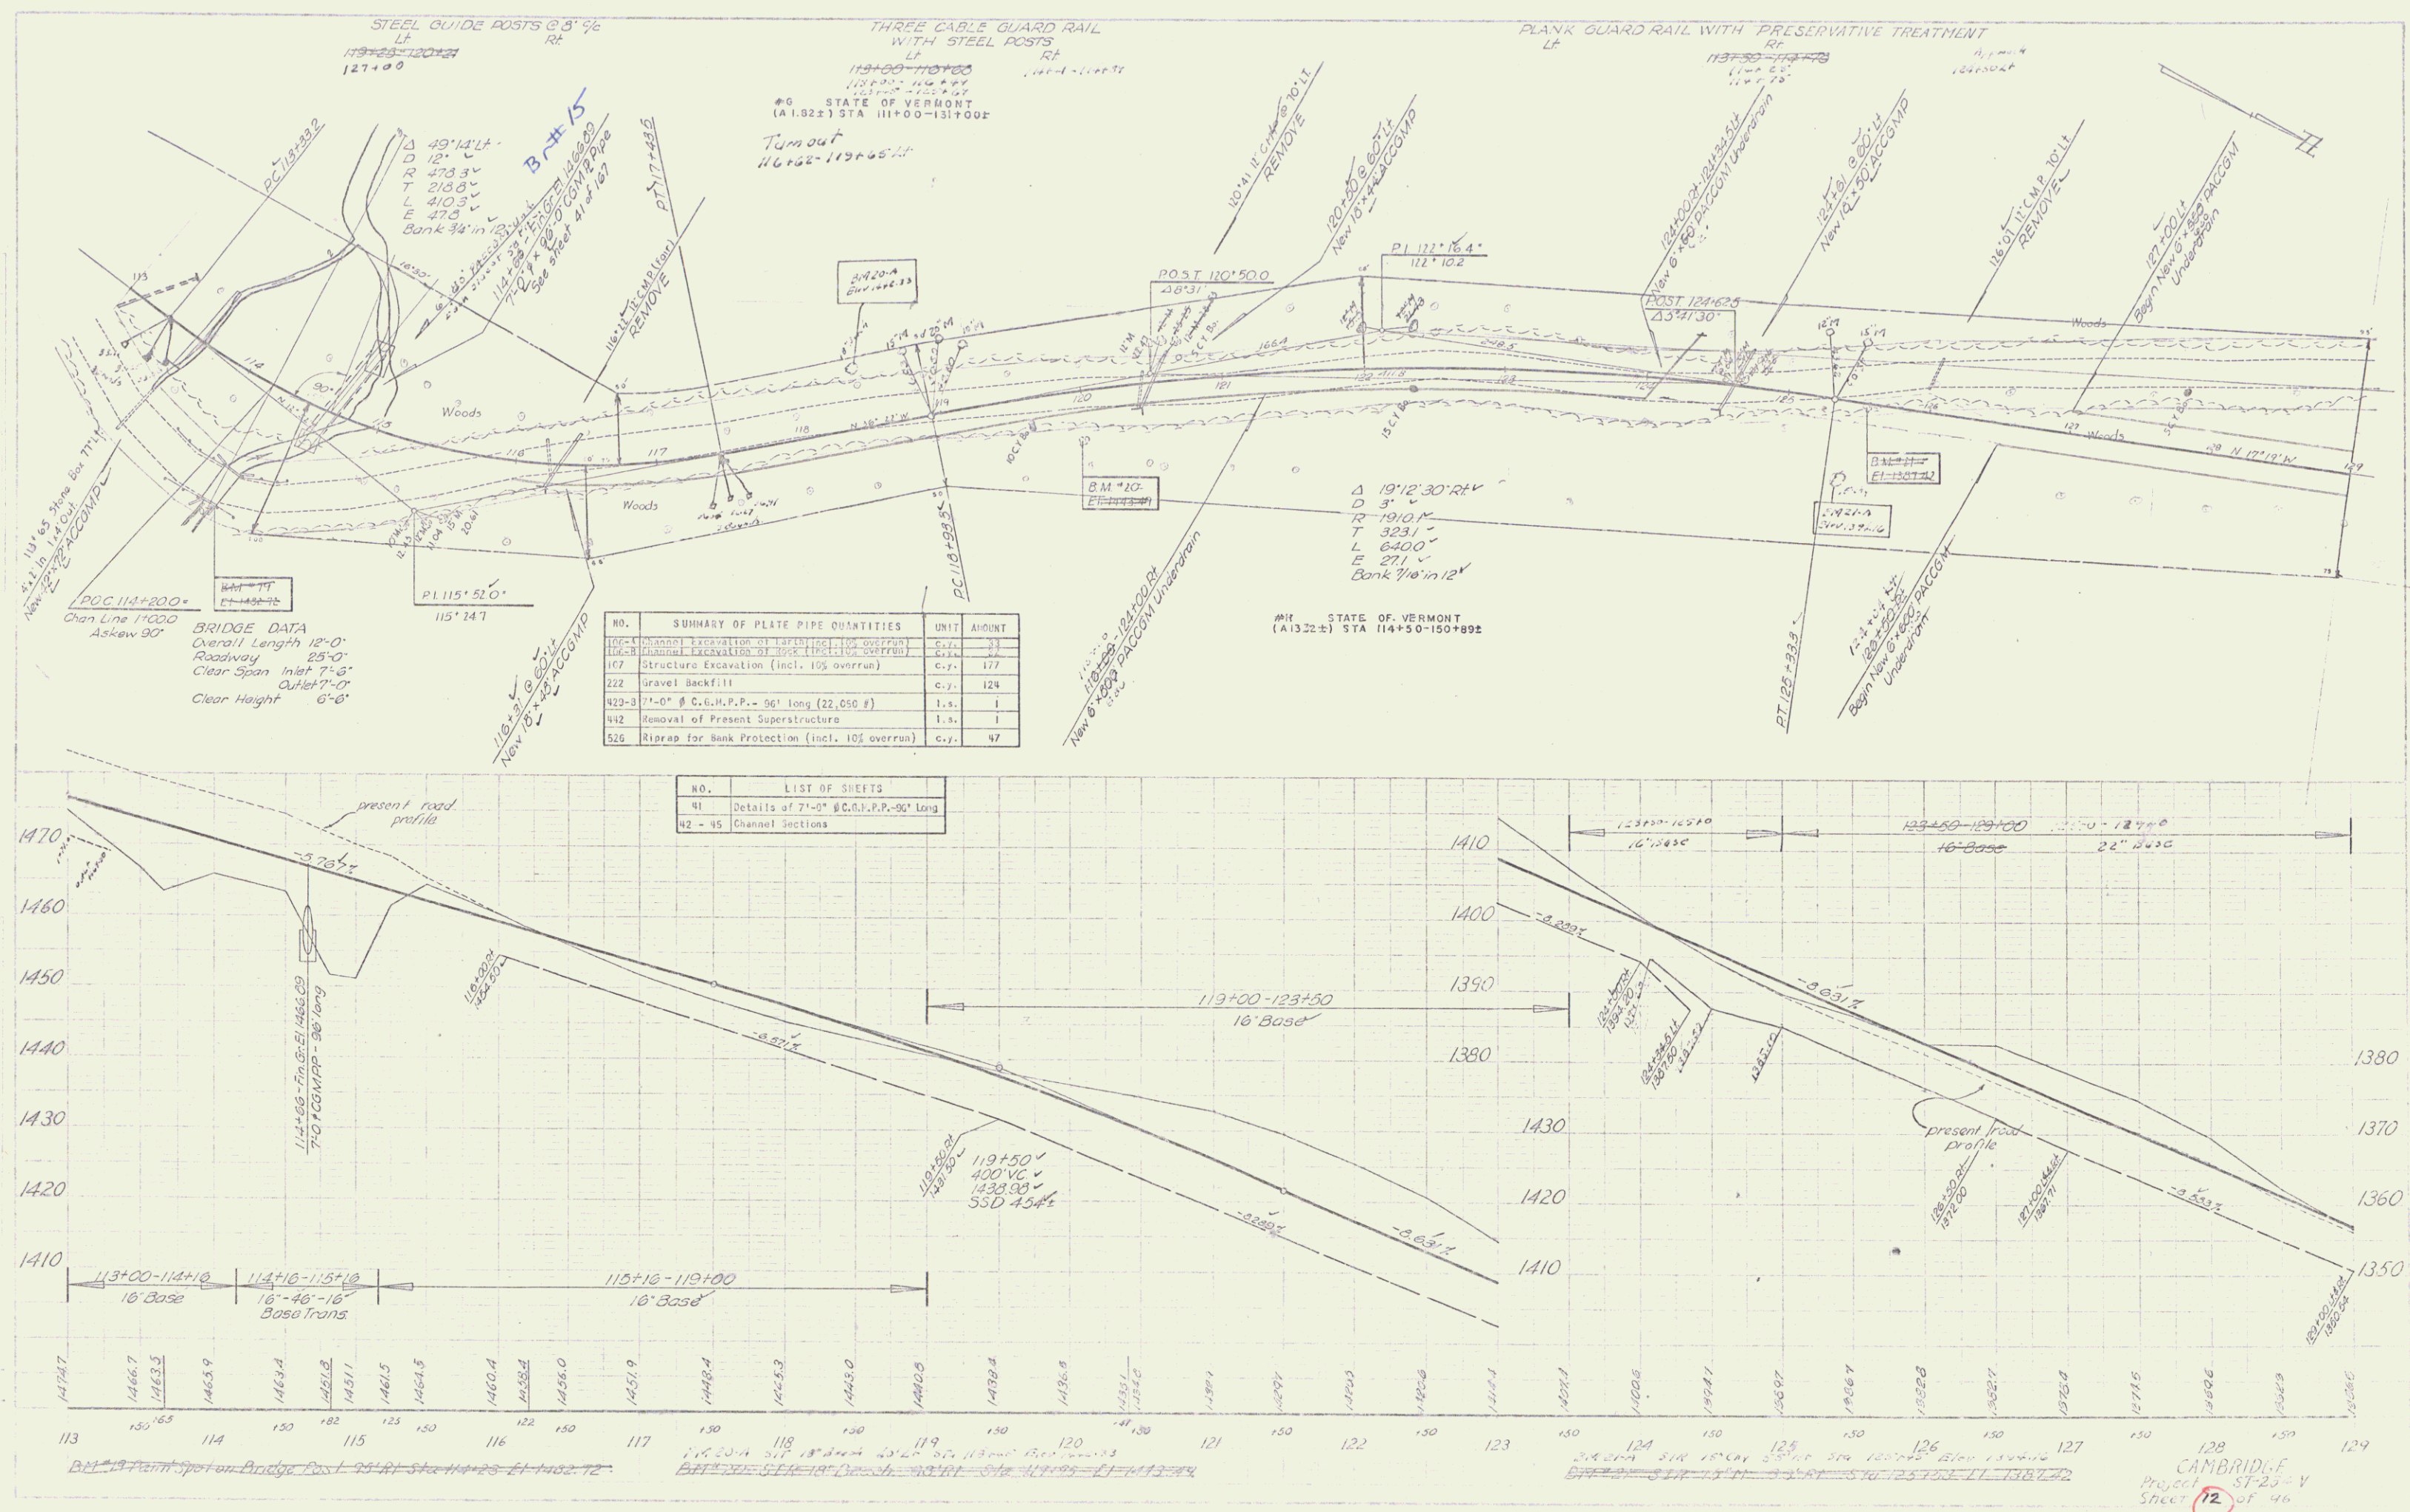

CAMBRIDGE
Project ST-25-V
Sheet 12 of 46

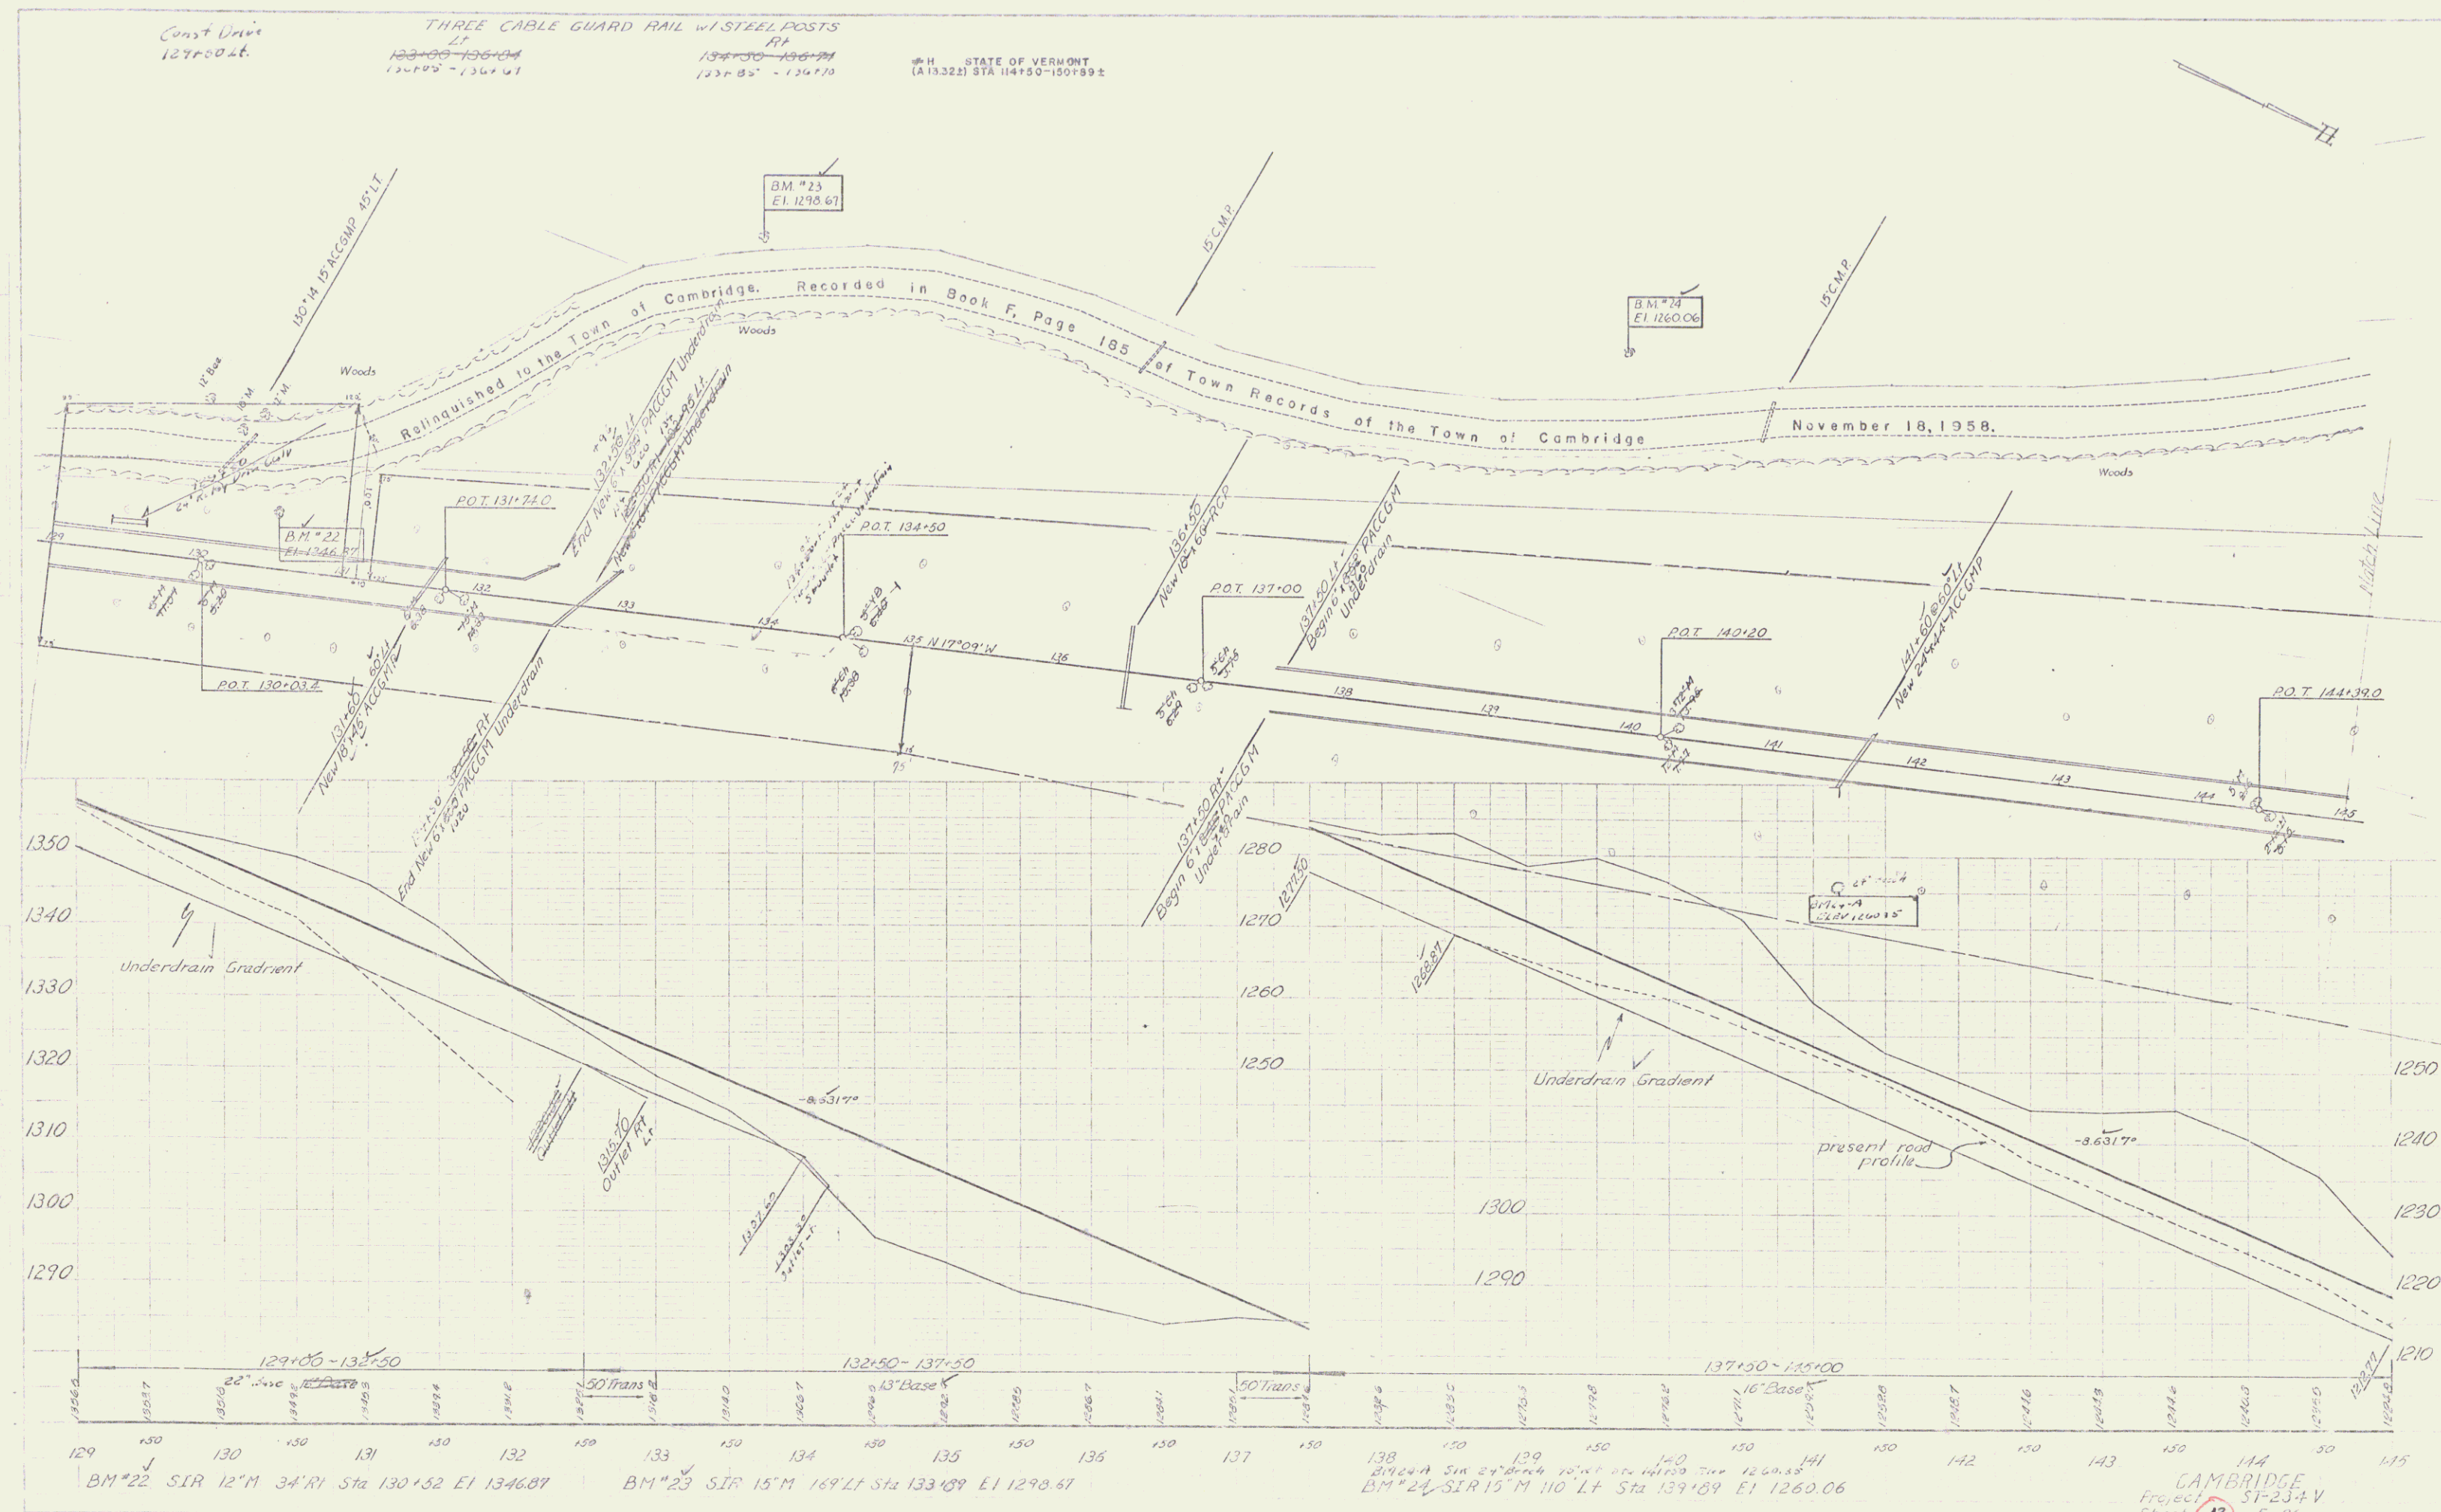

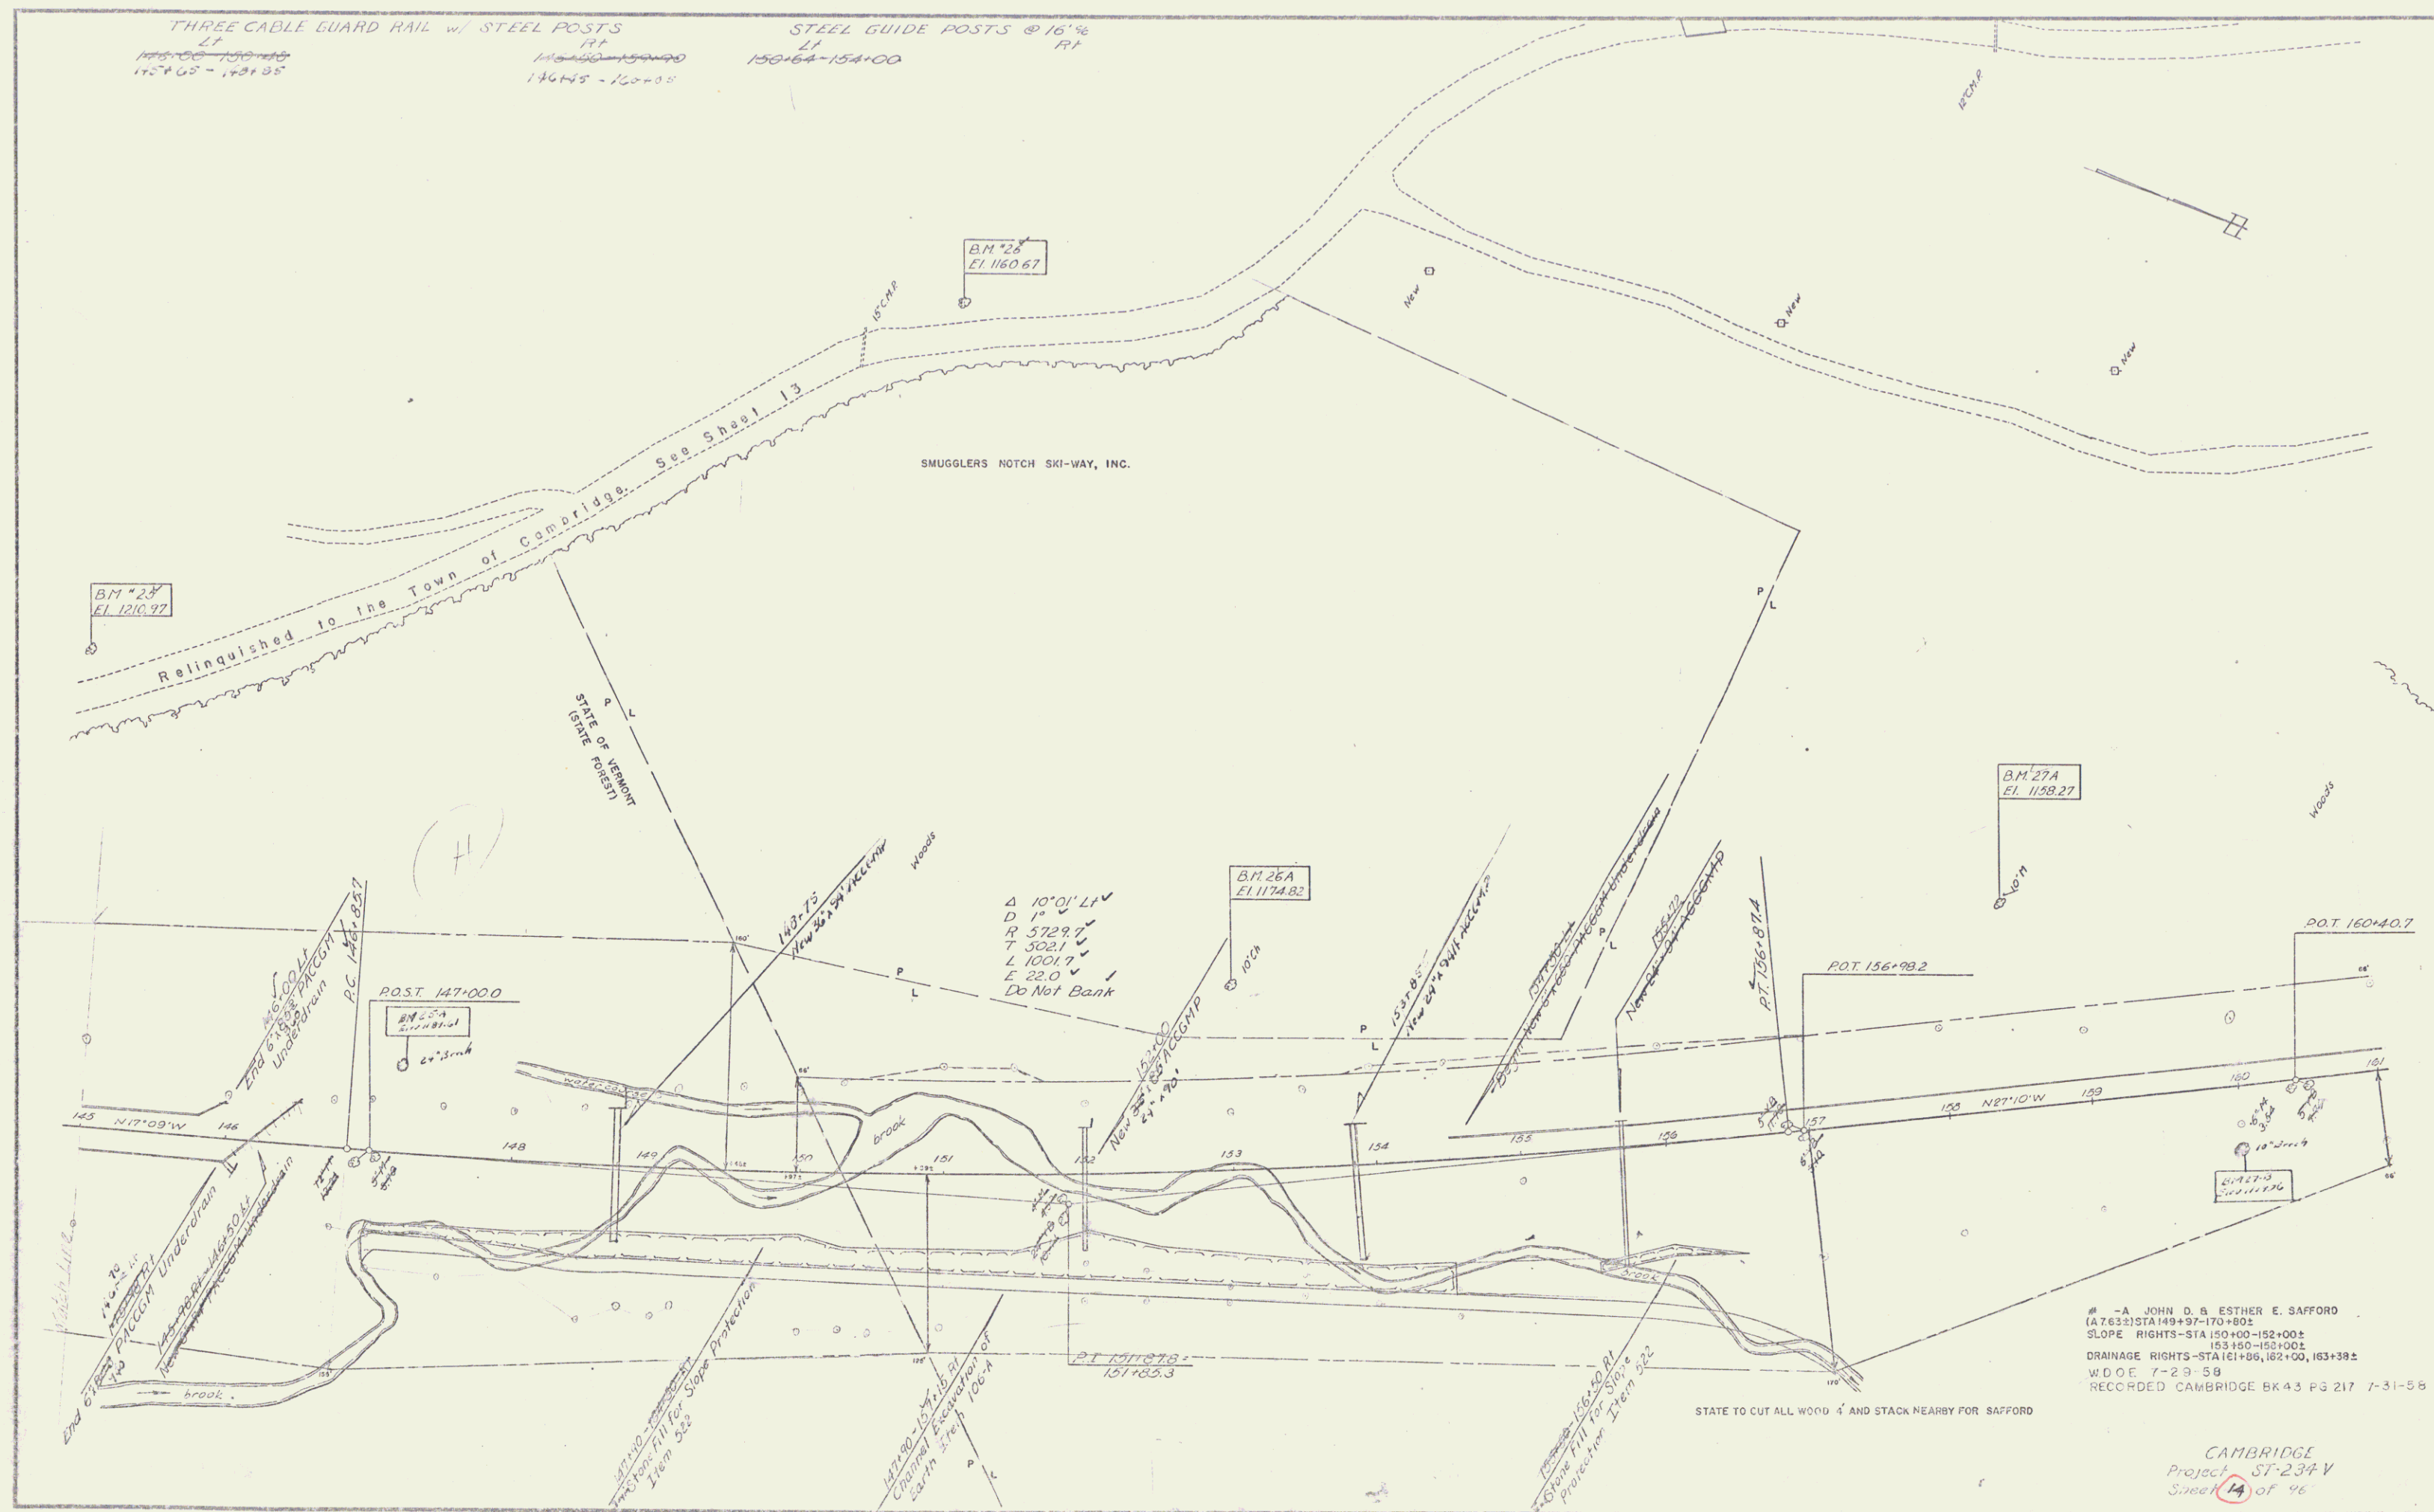


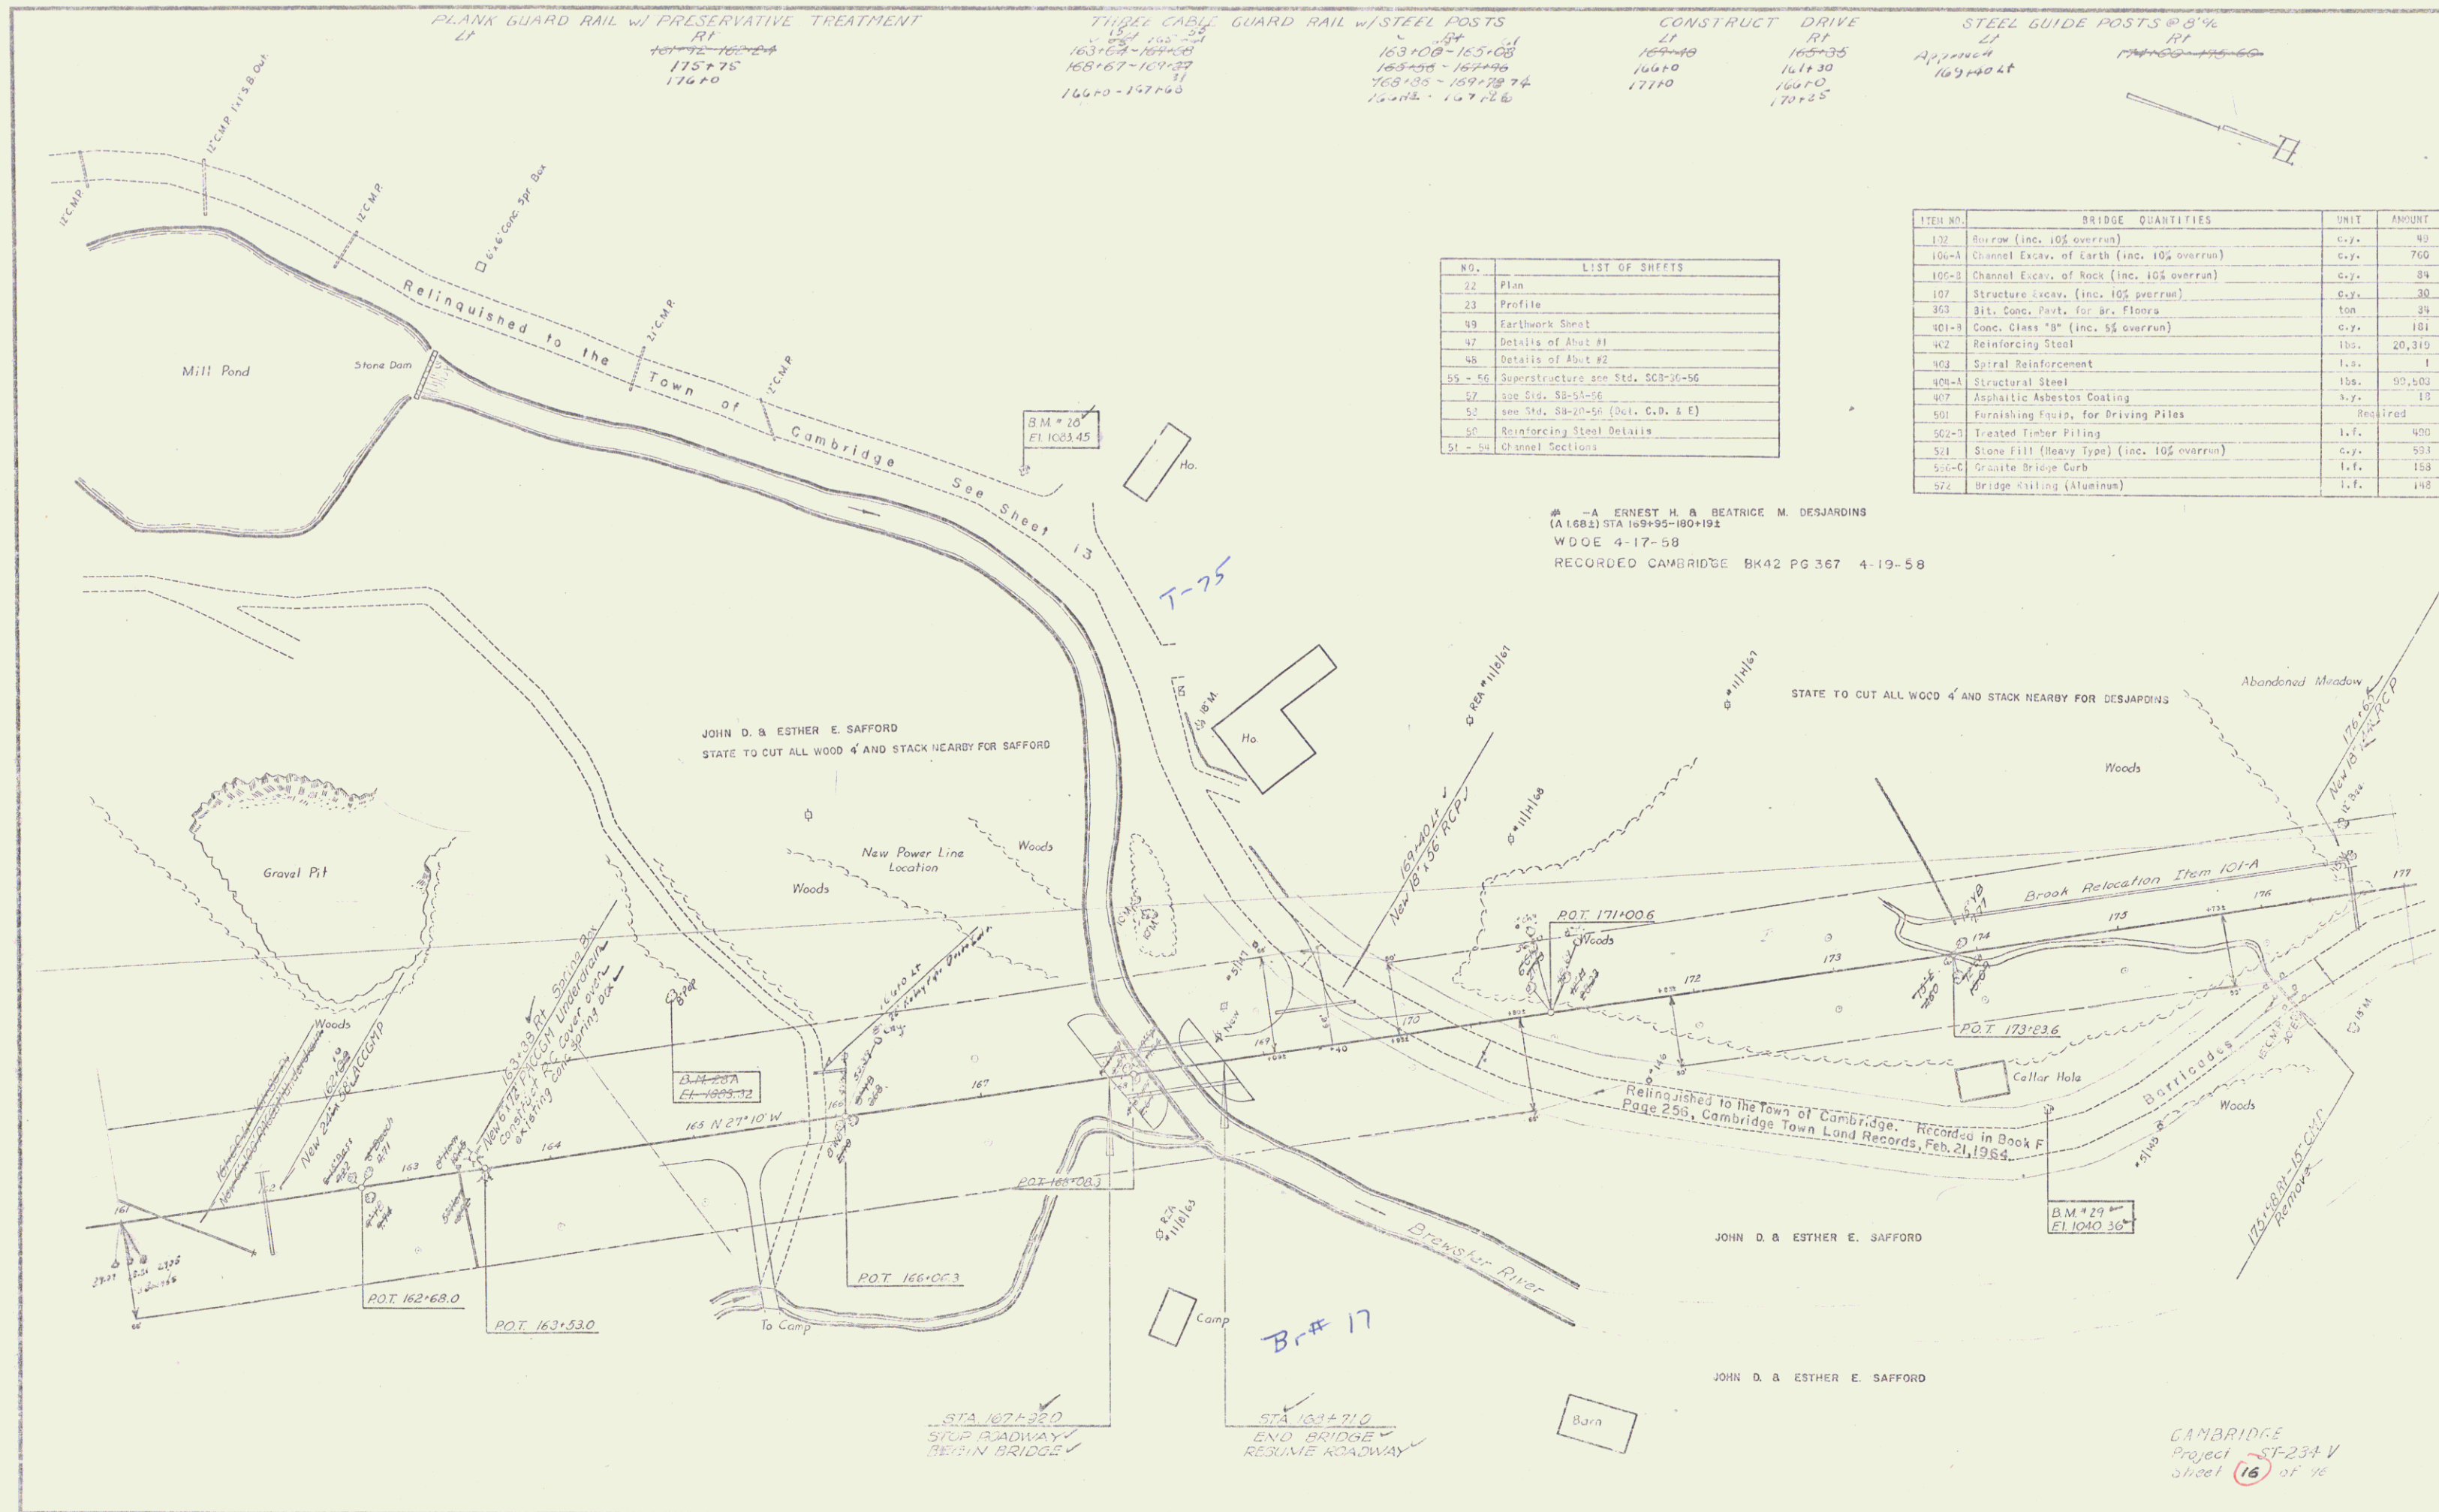


ERNEST H. & BEATRICE M. DESJARDINS

JOHN D. & ESTHER E. SAFFORD

John P. & Thomas J. McGovern

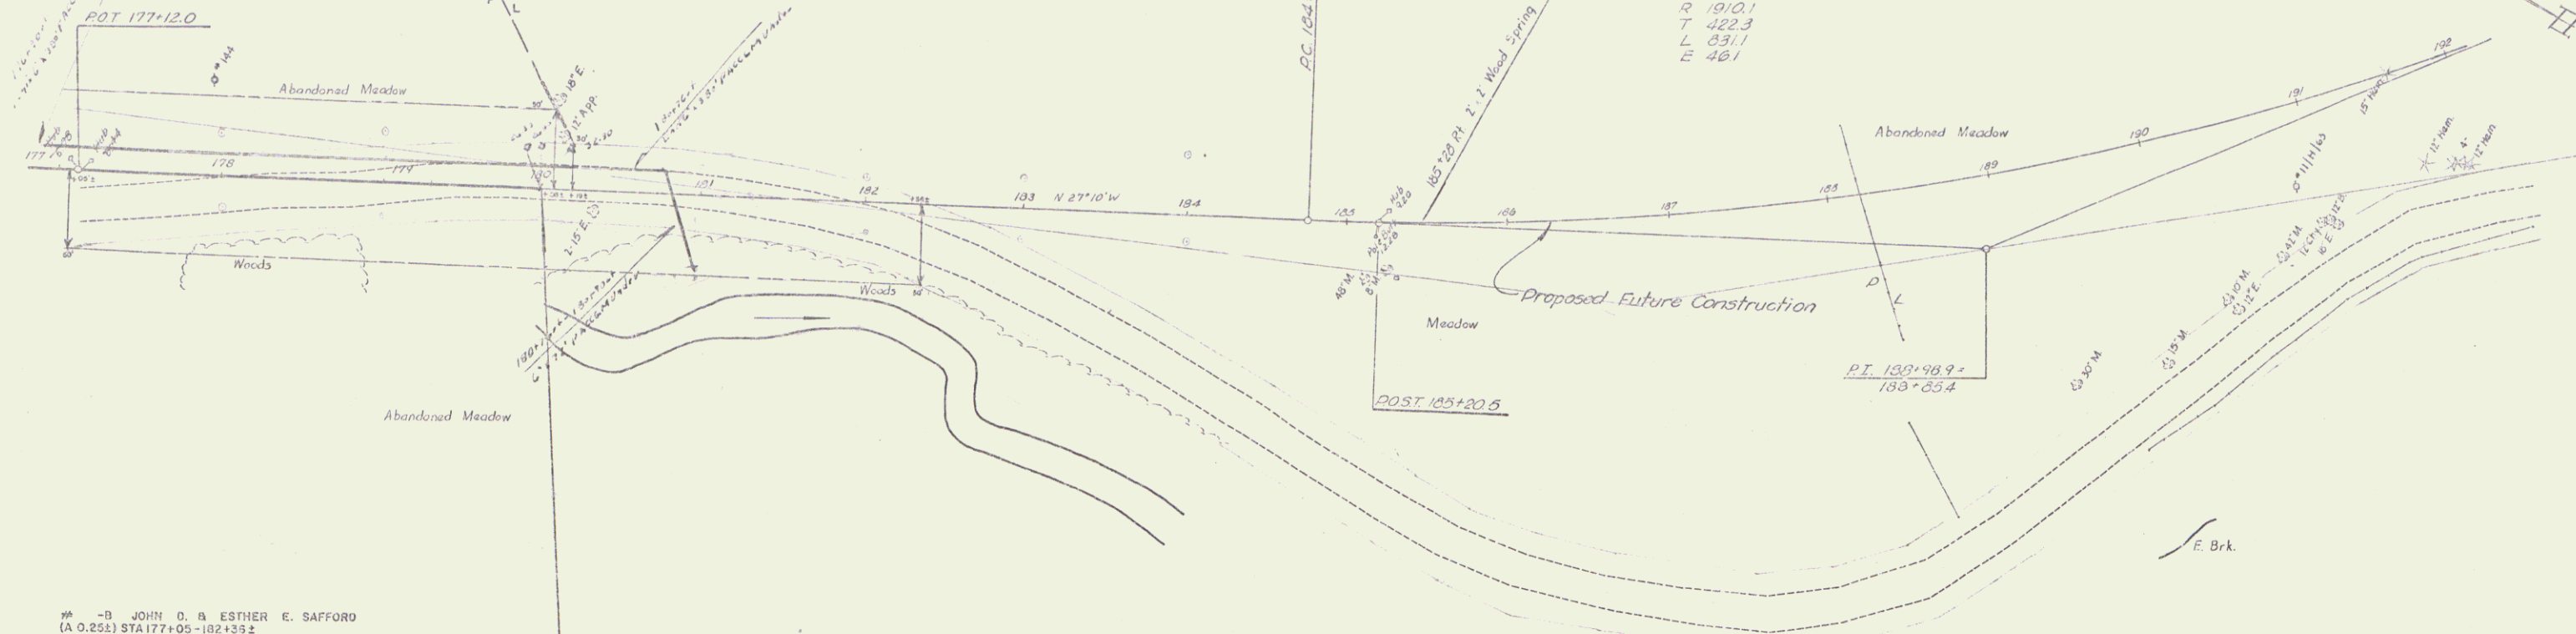

BY JOHN D. & ESTHER E. SAFFORD
(A 0.252) STA 177+00 - 182+39.2

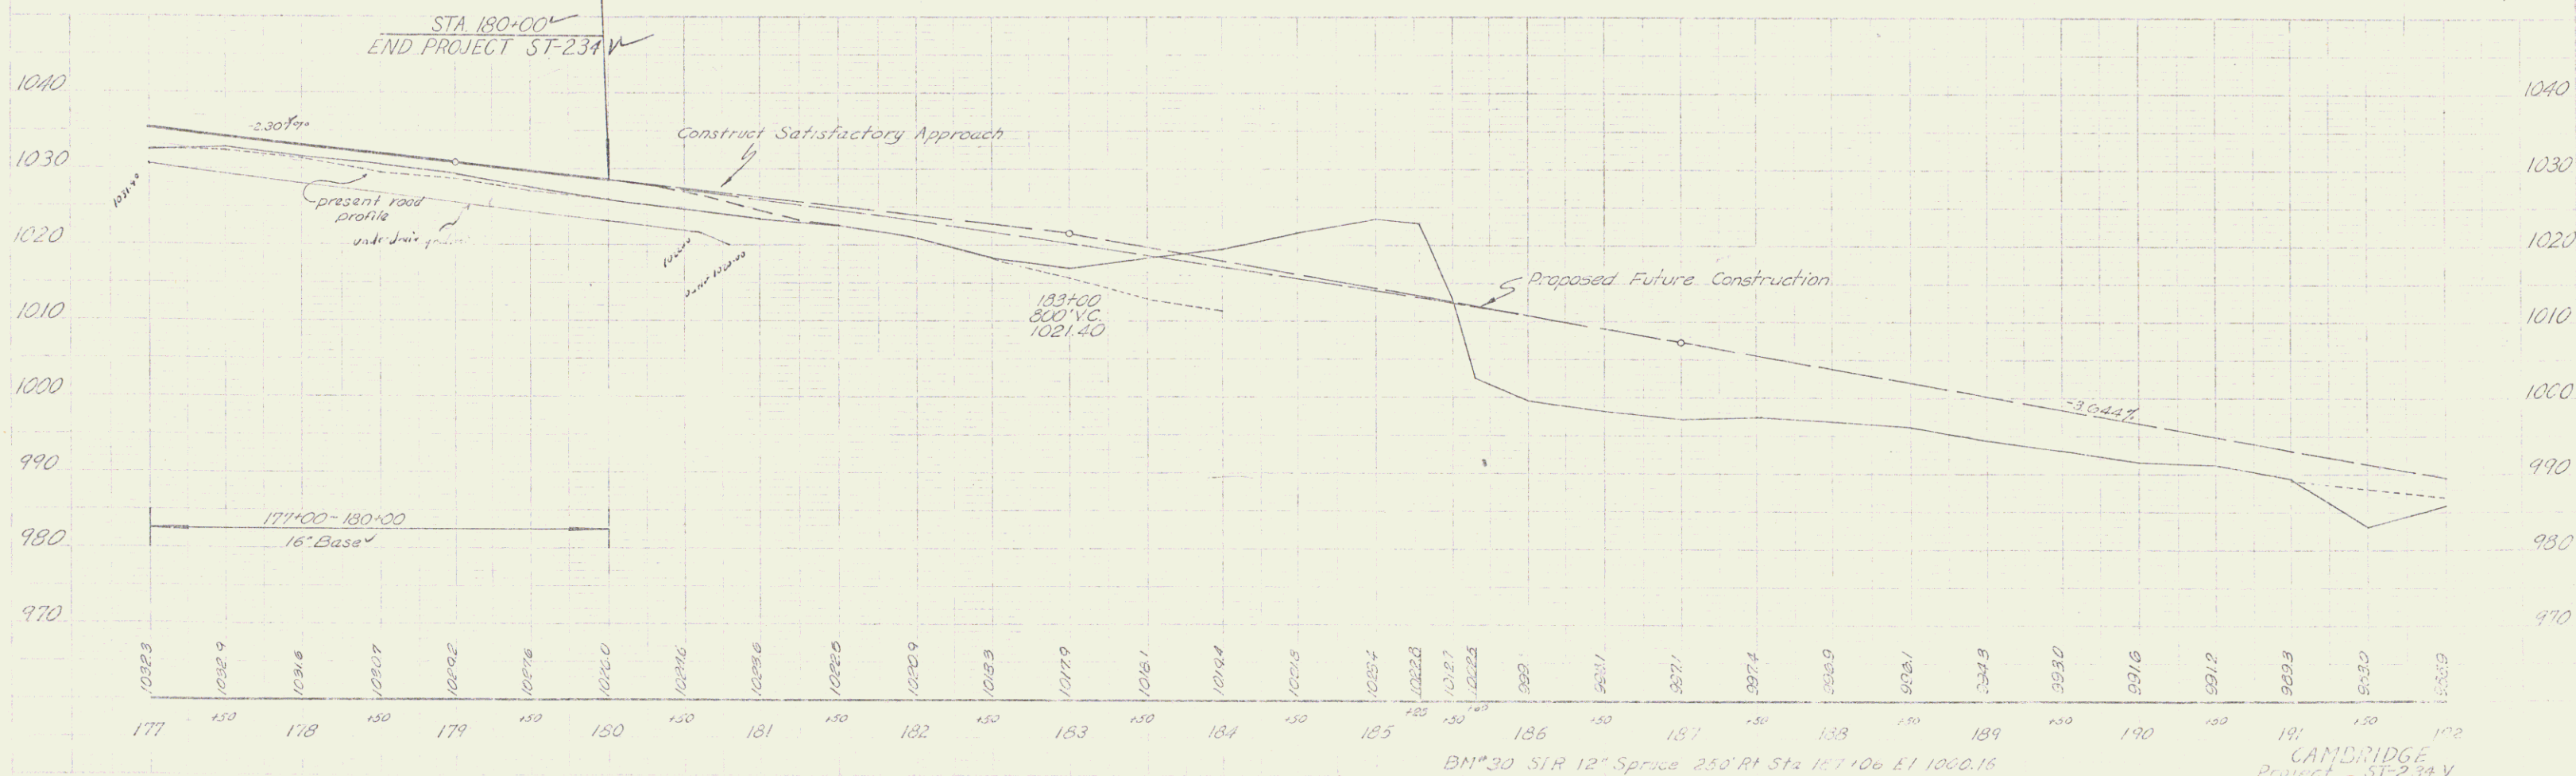

BM #30 S.R. 12" Spruce 250' Rt Sta 187+00 El 1000.16

CAMBRIDGE
Project ST-234 V
Sheet 18 of 18