

INDEX OF SHEETS

SHEET 1	GENERAL SHEETS
2	TITLE PAGE
3	TYPICAL ROADWAY SECTIONS BITUMINOUS CONCRETE PAVEMENT
4	QUANTITY SHEET, ITEMS
5	QUANTITY SHEET, ITEMS
6,7,8,9	EARTH-WORK SHEETS
10-12,13,14	PLAN & PROFILE SHEETS
15-17	SUPERELEVATION TRANSITION, TALC MILL UNDERPASS
18-20	BRIDGE AT STA. 114+50
21-23	PRELIMINARY INFORMATION SHEET
24	GENERAL PLAN & ELEVATION
25-27	BRIDGE DETAILS
28	BLANK
29	BLANK
30-32	BRIDGE AT STA. 165+40
33	PRELIMINARY INFORMATION SHEET
34	GENERAL PLAN & ELEVATION
35-37	BRIDGE DETAILS

DEPARTMENT STANDARDS

45	ROADWAY STANDARDS B-1, B-5, B-6, D-1, D-2, D-3, D-4, D-8, D-10, D-11, D-13, E-1, E-9, G-2, G-3, G-4, H-1a, H-1b, J-1
67-71	BRIDGE STANDARDS SCB-30-58, SHT 1; SCB-30-58, SHT 2; SCB-30-58, SHT 3; SCB-30-58, SHT 4
72-107	CROSS SECTIONS
108-193	HIGHWAY RELOCATION
194-200	CHANNEL RELOCATION
201-208	CHANNEL IMPROVEMENT SECTIONS

STATE OF VERMONT
DEPARTMENT OF HIGHWAYS
PROPOSED IMPROVEMENT

TOWN OF CHESTER
COUNTY OF WINDSOR
VERMONT ROUTE 103
CHESTER-LUDLOW ROAD

BEGINNING AT A POINT APPROXIMATELY 0.55 MILES SOUTH
OF THE INTERSECTION OF VERMONT ROUTES 10 & 103
AND EXTENDING NORTHWESTERLY TO THE CAVENDISH
CHESTER TOWN LINE.

LENGTH OF ROADWAY 13,428.50 FT = 2.543 MILES
LENGTH OF BRIDGE 522.47 FT = .099 MILES
LENGTH OF PROJECT 13,951.06 FT = 2.642 MILES


PROJECT NAME & NUMBER TYPE PAVEMENT AREA
CHESTER F 025-1(8) BIT. CONCRETE 20,756 S.Y.

RECORD PLANS

MATERIALS

CUBBASE OF GRAVEL	SCHALLOW PIT - PROCTORSVILLE, VT.
CRUSHED STONE BASE COURSE	VERMONT MARBLE CO. - FLORENCE, VT.
ASPHALT & TAR	ALL STATES ASPHALT CO. INC. - SUNDERLAND, MASS.
BITUMINOUS CONCRETE PAVE	L.M. PIKE & SON - PLANTMANCHESTER, VT.
CONCRETE CLASS 5	CHARLESTOWN READY MIX INC. - CHARLESTOWN, N.H.
REINFORCING & STRUCTURAL STEEL	CITY IRON WORKS - BRIDGEPORT, CONN.
REINFORCED CONCRETE PIPE	AMERICAN MARIETTA CO. - WINDSOR, VT.
ASPH. COATED CORR. GALV. METAL PIPE & METAL BIN RETAINING WALL	NEW ENGLAND METAL CULVERT CO. - WESTMINSTER, VT.
GUARD RAIL (CABLE & WOOD)	MAINLINE FENCE CO. - WESTBROOK, MAINE.
BRIDGE RAILING	VERMONT STRUCTURAL STEEL CO. - BURLINGTON, VT.
GRANITE SLOPE EDGING	ROCK OF AGES CORP. - BARRE, VERMONT.
CONTRACTORS	CALEDONIA SAND & GRAVEL CO. INC.
& MILLER CONST. CO.	WINDSOR, VT.
RESIDENT ENGINEER	HUGH F. ELDER.
INSPECTORS	S. LANGILL & J. DAVIS.
RECORD PLANS	A.G. SPIDLE.

DATED - JAN. 19, 1961.
STARTED - JAN. 19, 1961.
COMPLETED - JUNE 29, 1962.
ACCEPTED - JUNE 29, 1962.

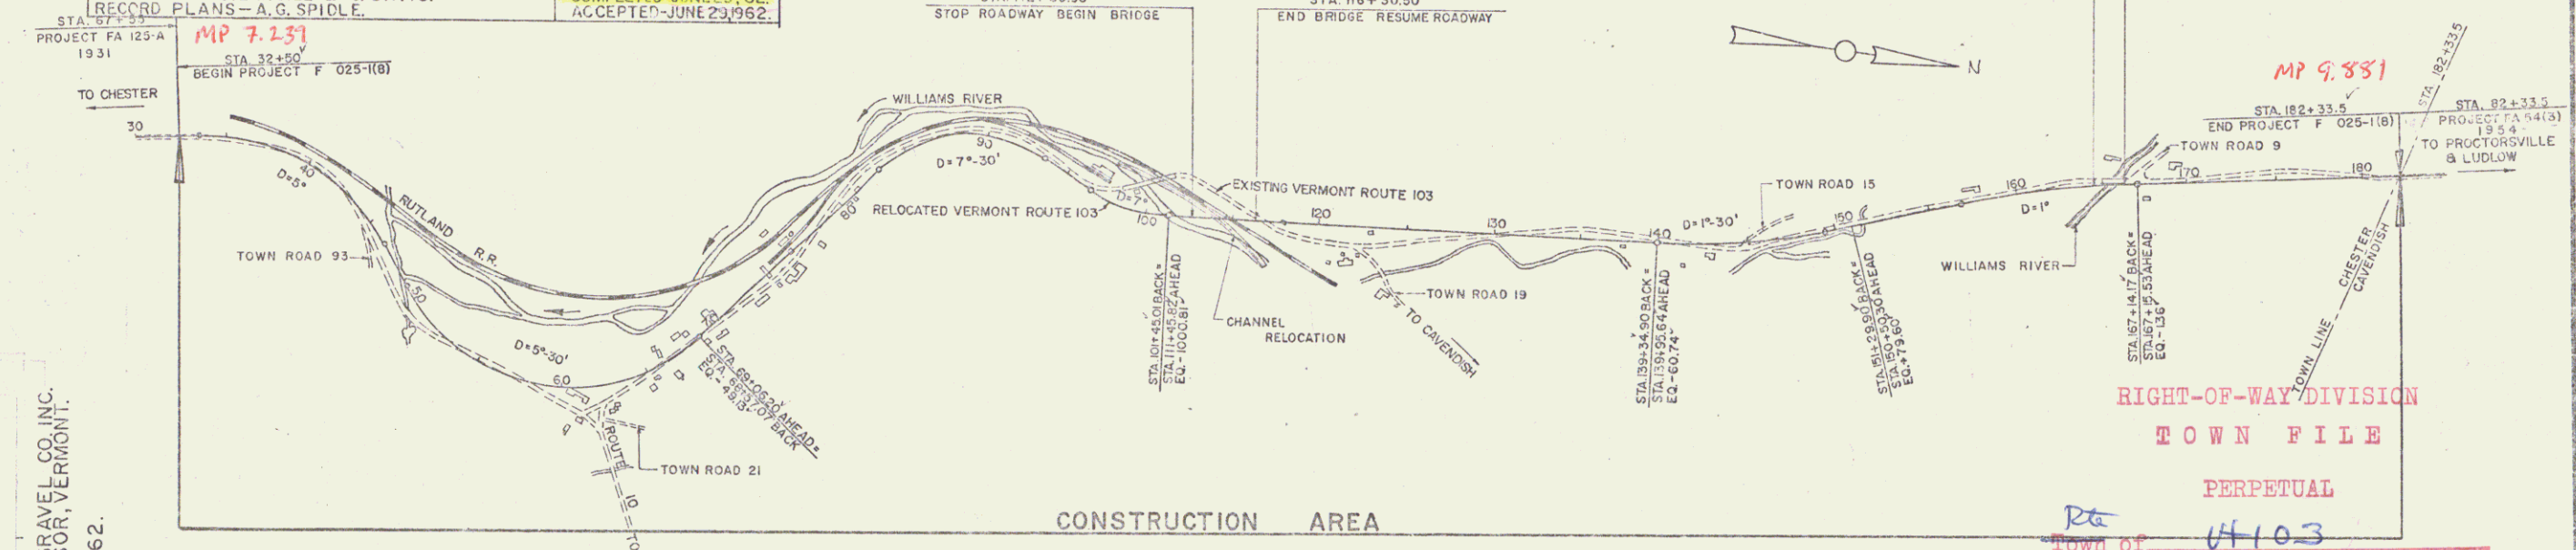

ROW L
COUNTY L
TOWN L
FENCE L
STONE W
UNFENCE
GUARD R
TRAVEL
RAILROAD
RETAIN
CENTER
SURVEY
CULVERT
DRAIN
TROLLEY
POWER L
TELEPHONE

PROJECT
CHESTER
F 025-1(8)
LUDLOW 2.642 MI.
STATE
BITUMINOUS CONCRETE PAVEMENT

CONTRACTOR
CALEDONIA SAND & GRAVEL CO. INC.
& MILLER CONST. CO. WINDSOR, VT. 057-164-62

LOCATION
Beginning of project approximately 0.55 miles south of the
intersection of Vermont Routes 10 & 103 and extending northwest-
erly to the Cavendish-Chester Town Line.

CHESTER
RECORD PLANS
MILLER CONST. CO. - WINDSOR, VERMONT.
CONST. COMPLETED - JUNE 29, 1962.

GROUND ELEVATION DATUM 1985 LINE

GRADE ELEVATION DATUM 1985 LINE

CURVE DATA

DEFLECTION OF ANGLE	A
DEGREE OF CURVE	D
RADIUS OF CURVE	R
TANGENT DISTANCE	T
LENGTH OF CURVE	L
EXTERNAL DISTANCE	E
POINT OF INTERSECTION	PI
POINT OF CURVE	PC
POINT OF TANGENT	PT
POINT ON TANGENT	POT
POINT ON SUB-TANGENT	POST

SCALES

TITLE	1" = 500'
TYPICAL	3/8" = 1' & 1/8" = 1'
PLAN	1" = 50'
PROFILE HORIZONTAL	1" = 10'
VERTICAL	1" = 10'
GROSS-SECTIONS	1" = 5' & 1" = 10'

THESE PLANS ARE SUBJECT TO SUCH REVISIONS AS MAY BE
REQUIRED BY THE BUREAU OF PUBLIC ROADS OR THE COMMISSIONER
OF HIGHWAYS.

CONSTRUCTION IS TO BE CARRIED ON IN ACCORDANCE WITH
THE PLANS AND THE STANDARD SPECIFICATIONS FOR HIGHWAY AND BRIDGE
CONSTRUCTION OF JANUARY 1956 SUBMITTED TO THE BUREAU OF
PUBLIC ROADS AS APPROVED JULY 5, 1956, INCLUDING ALL SUBSEQUENT
APPROVED REVISIONS AND SUCH REVISED SPECIFICATIONS AND SPECIAL
PROVISIONS AS ARE SUBMITTED WITH THE PLANS.

APPROVED	STANDARD ENGINEER	DATE	5/3/60
APPROVED	DATE	5/3/60	
APPROVED	DATE	7/26/60	
APPROVED	DATE	7/24/60	
APPROVED	DATE	7/24/60	

Pin # 00R132

DEPARTMENT OF COMMERCE
BUREAU OF PUBLIC ROADS



APPROVED

PROJECT F 025-1(8)

SHEET 1 OF 233 SHEETS

BEING A PART OF THE SAME LAND AND PREMISES
ACQUIRED BY THE STATE OF VERMONT FROM HENRY
J. & JENNIE W. CHAMPMAN BY CONDEMNATION ORDER
DATED OCTOBER 11, 1969 AND RECORDED IN BOOK
39, PAGE 460, OF THE TOWN OF CHESTER LAND
RECORDS.

MP 0749

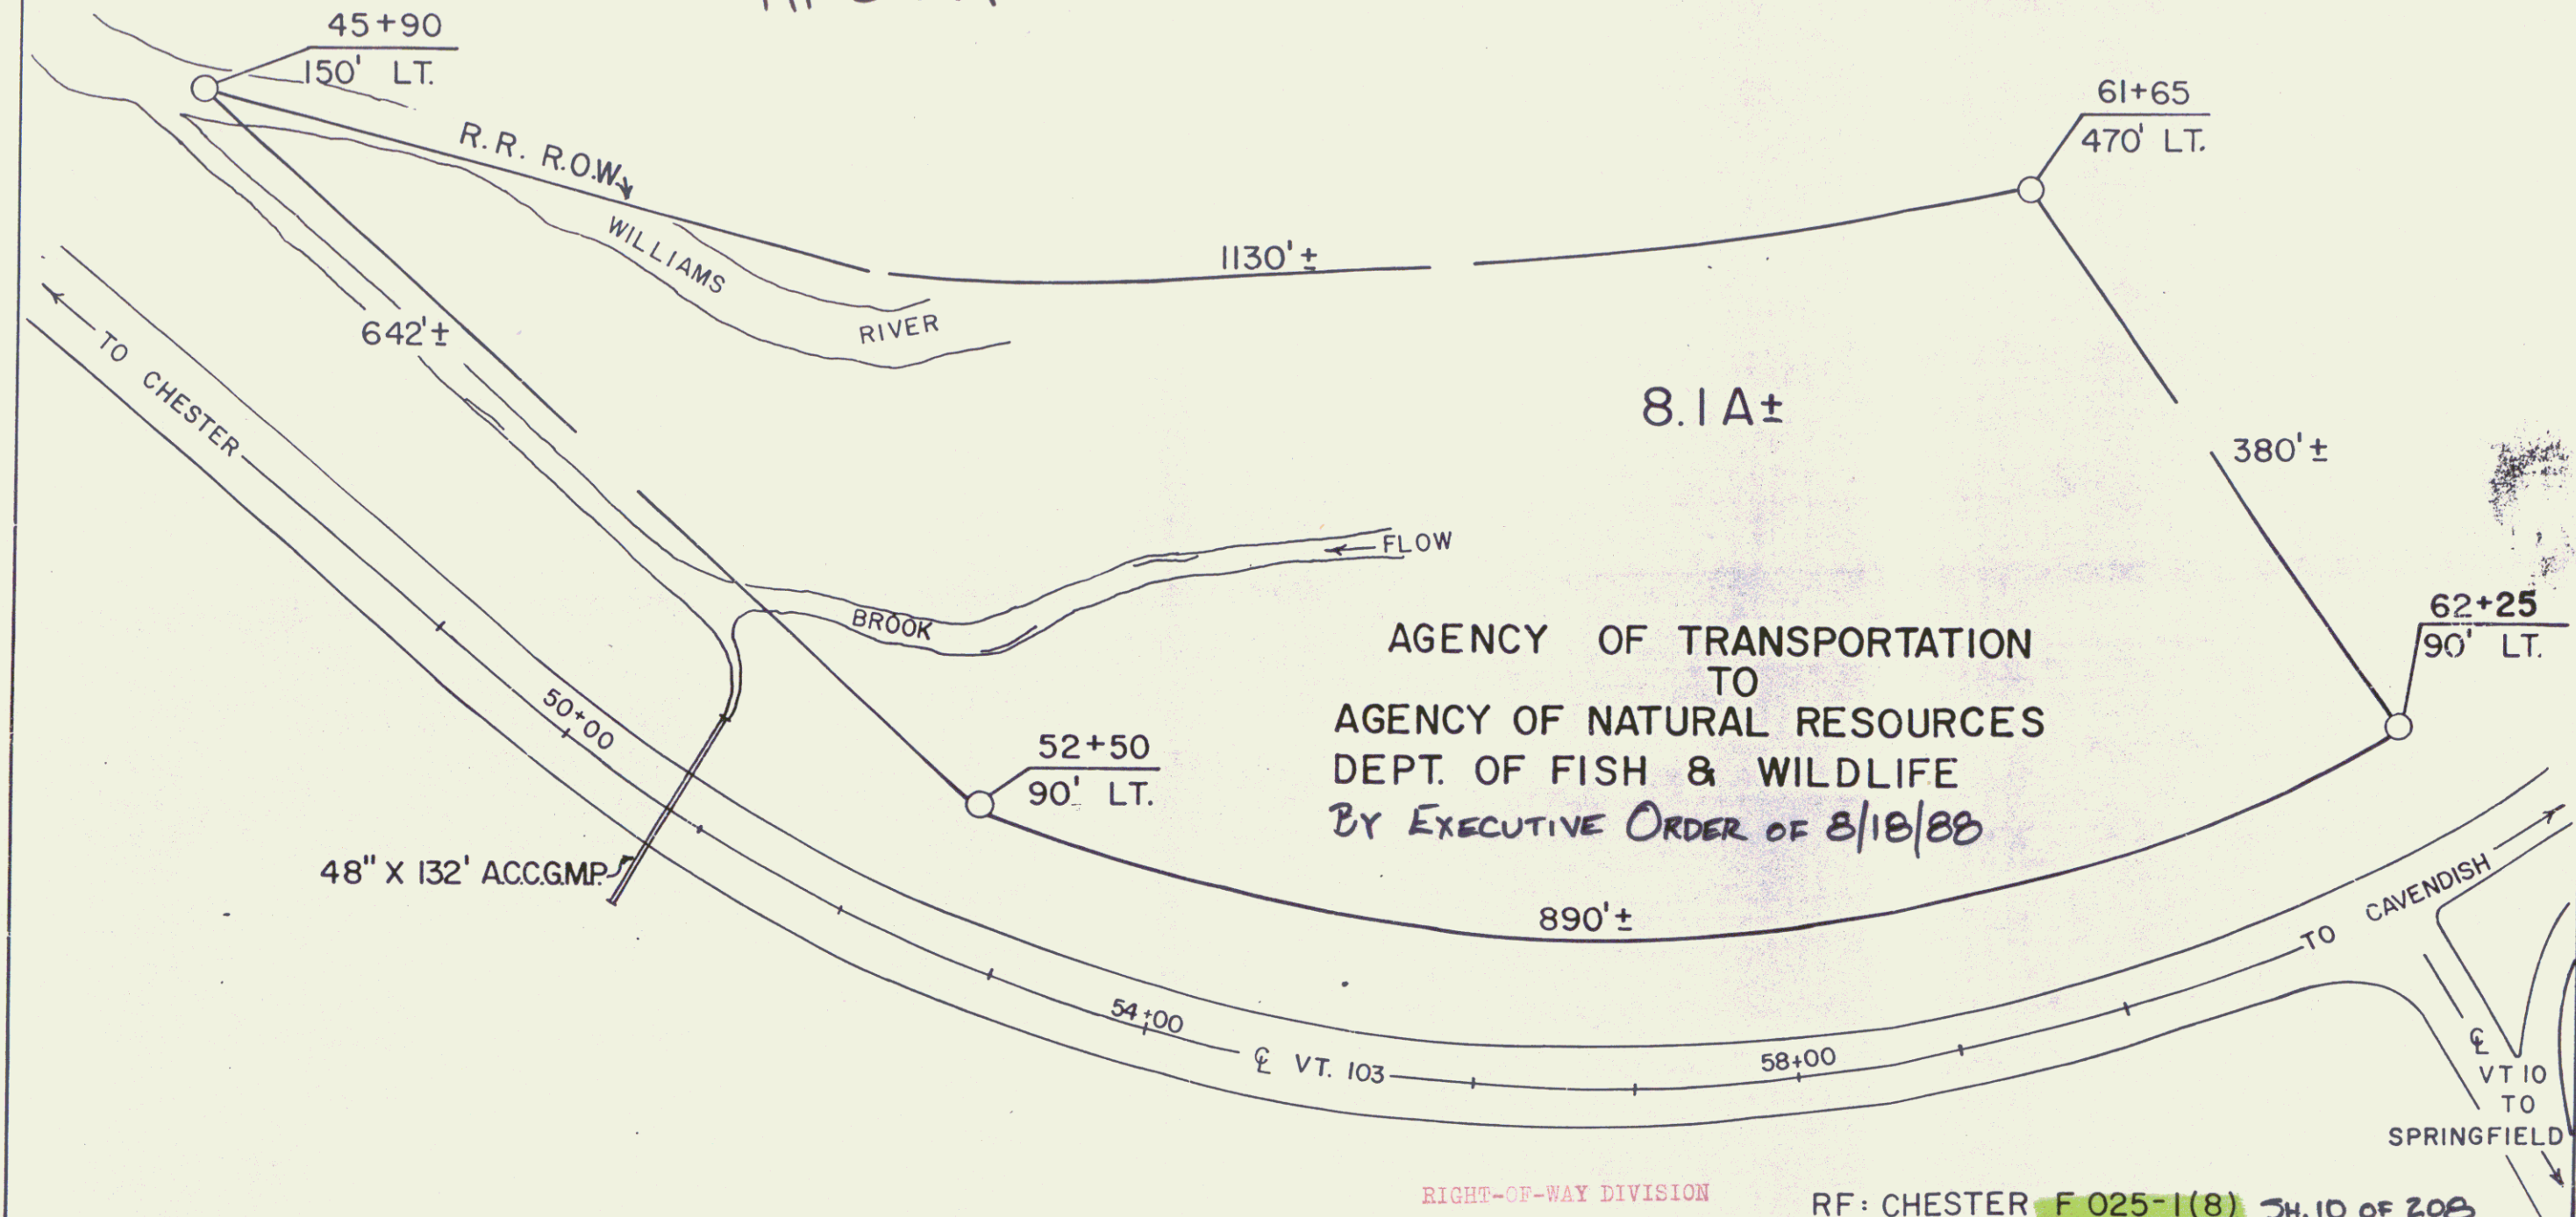
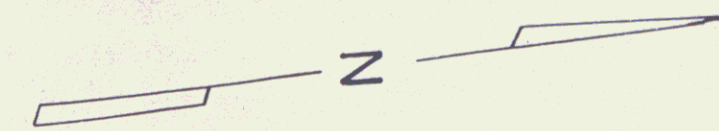


RIGHT-OF-WAY DIVISION
TOWN FILE
PERPETUAL
Town of CHESTER
(To Be Returned To R.O.W. Division)



RF: CHESTER F 025-1(8) 3H.10 of 208		
STATE OF VERMONT AGENCY OF TRANSPORTATION		
TOWN OF CHESTER		SHEET 10A
4		
APPROX. SCALE 1"=100'	DATE: 1-25-88	DRAWN BY: M.R.

Seed ing, fertilizer & Topsoil
 Item 543
 67+35 - 69+88 Lt
 69+10 - 69+65 Rt
 69+77 - 70+62 Rt
 70+76 - 71+50 Rt
 67+25 - 63+27 Rt (Dm. 15/land)
 Rte #10
 0+00 - 0+87 Lt
 0+99 - 1+87 Lt
 0+70 - 0+94 Rt
 1+06 - 2+00 Rt

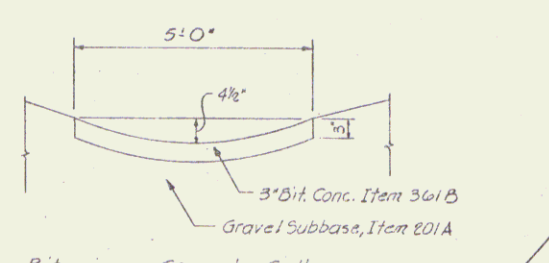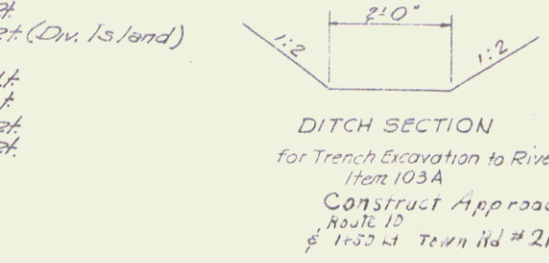

Bituminous Concrete Gutter
 Sta 65+00 to Sta 66+00 Lt
 65+00 - 66+00 Lt

For details of Intersection
 See Sheet No 12-A

Curve Data
 Route #10
 Δ = 8° 32' 00" Lt
 D = 70' 7"
 R = 813.51'
 T = 31.07'
 L = 121.00'
 Bank 1/2" per foot

PARCEL: 7
 GRANTOR: HOLLIS E. & DAISY A. CARLETON
 STATIONS: 4+52 - 6+85
 TAKING: 0.2 AC ±
 REMAINDER: 0.8 AC ±
 RIGHTS: NONE
 TITLE TAKEN: MD DE 10/10/60
 RECORDED: CHESTER BK 39-PG 458
 10/18/60

PARCEL: 8
 GRANTOR: 1+60 - 4+69 SIDE LINE
 STATIONS: 1+60 - 4+69
 TAKING: 0.2 AC ±
 REMAINDER: 0.8 AC ±
 RIGHTS: NONE
 TITLE TAKEN: MD DE 10/10/60
 RECORDED: CHESTER BK 39-PG 458
 10/18/60

TRAFFIC MOVEMENT DURING
 BOTH PEAK HOUR TRAFFIC
 KEY:
 DNK 750-1980 Estimated 30th Peak
 Hour Volume
 Peak Hour Truck Traffic is 11% of the
 Total Peak Hour Traffic

3 Cable Guard Rail with Steel Posts, Item 543
 4+48 to 4+50 to 4+98 Route 10
 Sta 4+36 to 4+84 Route 10 Rt 48'

Granite Slope Edging
 59+39 - 61+70.15 Lt & Rt
 62+20.15 Rt - 64+15.7 Lt
 65+35 - 67+15.7 Lt
 67+35 - 69+88 Lt
 69+10 - 69+65 Rt
 69+77 - 70+62 Rt
 70+76 - 71+50 Rt

Construct Drives
 Route 10
 Sta 6+96 Lt to 100 Rt 4+60 Rt
 Route 10
 Sta 6+96 Lt to 100 Rt 4+60 Rt
 65+35 - 67+15.7 Lt
 67+35 - 69+88 Lt
 69+10 - 69+65 Rt
 69+77 - 70+62 Rt
 70+76 - 71+50 Rt

PARCEL: 12 A
 GRANTOR: HENRY J. & JENNIE W. CHAPMAN
 STATIONS: 65+35 - 67+15.7
 TAKING: 0.2 AC ±
 REMAINDER: 0.8 AC ±
 RIGHTS: NONE
 TITLE TAKEN: MD DE 10/10/60
 RECORDED: CHESTER BK 39-PG 458
 10/18/60

PARCEL: 12 B
 GRANTOR: HENRY J. & JENNIE W. CHAPMAN
 STATIONS: 67+15.7 - 69+88
 TAKING: 0.2 AC ±
 REMAINDER: 0.8 AC ±
 RIGHTS: NONE
 TITLE TAKEN: MD DE 10/10/60
 RECORDED: CHESTER BK 39-PG 458
 10/18/60

PARCEL: 12 C
 GRANTOR: HENRY J. & JENNIE W. CHAPMAN
 STATIONS: 69+88 - 71+50
 TAKING: 0.2 AC ±
 REMAINDER: 0.8 AC ±
 RIGHTS: NONE
 TITLE TAKEN: MD DE 10/10/60
 RECORDED: CHESTER BK 39-PG 458
 10/18/60

PARCEL: 12 D
 GRANTOR: HENRY J. & JENNIE W. CHAPMAN
 STATIONS: 71+50 - 73+15
 TAKING: 0.2 AC ±
 REMAINDER: 0.8 AC ±
 RIGHTS: NONE
 TITLE TAKEN: MD DE 10/10/60
 RECORDED: CHESTER BK 39-PG 458
 10/18/60

PARCEL: 12 E
 GRANTOR: HENRY J. & JENNIE W. CHAPMAN
 STATIONS: 73+15 - 75+00
 TAKING: 0.2 AC ±
 REMAINDER: 0.8 AC ±
 RIGHTS: NONE
 TITLE TAKEN: MD DE 10/10/60
 RECORDED: CHESTER BK 39-PG 458
 10/18/60

PARCEL: 12 F
 GRANTOR: HENRY J. & JENNIE W. CHAPMAN
 STATIONS: 75+00 - 77+15
 TAKING: 0.2 AC ±
 REMAINDER: 0.8 AC ±
 RIGHTS: NONE
 TITLE TAKEN: MD DE 10/10/60
 RECORDED: CHESTER BK 39-PG 458
 10/18/60

PARCEL: 12 G
 GRANTOR: HENRY J. & JENNIE W. CHAPMAN
 STATIONS: 77+15 - 79+30
 TAKING: 0.2 AC ±
 REMAINDER: 0.8 AC ±
 RIGHTS: NONE
 TITLE TAKEN: MD DE 10/10/60
 RECORDED: CHESTER BK 39-PG 458
 10/18/60

PARCEL: 12 H
 GRANTOR: HENRY J. & JENNIE W. CHAPMAN
 STATIONS: 79+30 - 81+45
 TAKING: 0.2 AC ±
 REMAINDER: 0.8 AC ±
 RIGHTS: NONE
 TITLE TAKEN: MD DE 10/10/60
 RECORDED: CHESTER BK 39-PG 458
 10/18/60

PARCEL: 12 I
 GRANTOR: HENRY J. & JENNIE W. CHAPMAN
 STATIONS: 81+45 - 83+60
 TAKING: 0.2 AC ±
 REMAINDER: 0.8 AC ±
 RIGHTS: NONE
 TITLE TAKEN: MD DE 10/10/60
 RECORDED: CHESTER BK 39-PG 458
 10/18/60

PARCEL: 12 J
 GRANTOR: HENRY J. & JENNIE W. CHAPMAN
 STATIONS: 83+60 - 85+75
 TAKING: 0.2 AC ±
 REMAINDER: 0.8 AC ±
 RIGHTS: NONE
 TITLE TAKEN: MD DE 10/10/60
 RECORDED: CHESTER BK 39-PG 458
 10/18/60

PARCEL: 12 K
 GRANTOR: HENRY J. & JENNIE W. CHAPMAN
 STATIONS: 85+75 - 87+90
 TAKING: 0.2 AC ±
 REMAINDER: 0.8 AC ±
 RIGHTS: NONE
 TITLE TAKEN: MD DE 10/10/60
 RECORDED: CHESTER BK 39-PG 458
 10/18/60

PARCEL: 12 L
 GRANTOR: HENRY J. & JENNIE W. CHAPMAN
 STATIONS: 87+90 - 90+05
 TAKING: 0.2 AC ±
 REMAINDER: 0.8 AC ±
 RIGHTS: NONE
 TITLE TAKEN: MD DE 10/10/60
 RECORDED: CHESTER BK 39-PG 458
 10/18/60

PARCEL: 12 M
 GRANTOR: HENRY J. & JENNIE W. CHAPMAN
 STATIONS: 90+05 - 92+20
 TAKING: 0.2 AC ±
 REMAINDER: 0.8 AC ±
 RIGHTS: NONE
 TITLE TAKEN: MD DE 10/10/60
 RECORDED: CHESTER BK 39-PG 458
 10/18/60

PARCEL: 12 N
 GRANTOR: HENRY J. & JENNIE W. CHAPMAN
 STATIONS: 92+20 - 94+35
 TAKING: 0.2 AC ±
 REMAINDER: 0.8 AC ±
 RIGHTS: NONE
 TITLE TAKEN: MD DE 10/10/60
 RECORDED: CHESTER BK 39-PG 458
 10/18/60

PARCEL: 12 O
 GRANTOR: HENRY J. & JENNIE W. CHAPMAN
 STATIONS: 94+35 - 96+50
 TAKING: 0.2 AC ±
 REMAINDER: 0.8 AC ±
 RIGHTS: NONE
 TITLE TAKEN: MD DE 10/10/60
 RECORDED: CHESTER BK 39-PG 458
 10/18/60

PARCEL: 12 P
 GRANTOR: HENRY J. & JENNIE W. CHAPMAN
 STATIONS: 96+50 - 98+65
 TAKING: 0.2 AC ±
 REMAINDER: 0.8 AC ±
 RIGHTS: NONE
 TITLE TAKEN: MD DE 10/10/60
 RECORDED: CHESTER BK 39-PG 458
 10/18/60

PARCEL: 12 Q
 GRANTOR: HENRY J. & JENNIE W. CHAPMAN
 STATIONS: 98+65 - 100+80
 TAKING: 0.2 AC ±
 REMAINDER: 0.8 AC ±
 RIGHTS: NONE
 TITLE TAKEN: MD DE 10/10/60
 RECORDED: CHESTER BK 39-PG 458
 10/18/60

PARCEL: 12 R
 GRANTOR: HENRY J. & JENNIE W. CHAPMAN
 STATIONS: 100+80 - 102+95
 TAKING: 0.2 AC ±
 REMAINDER: 0.8 AC ±
 RIGHTS: NONE
 TITLE TAKEN: MD DE 10/10/60
 RECORDED: CHESTER BK 39-PG 458
 10/18/60

PARCEL: 12 S
 GRANTOR: HENRY J. & JENNIE W. CHAPMAN
 STATIONS: 102+95 - 105+10
 TAKING: 0.2 AC ±
 REMAINDER: 0.8 AC ±
 RIGHTS: NONE
 TITLE TAKEN: MD DE 10/10/60
 RECORDED: CHESTER BK 39-PG 458
 10/18/60

PARCEL: 12 T
 GRANTOR: HENRY J. & JENNIE W. CHAPMAN
 STATIONS: 105+10 - 107+25
 TAKING: 0.2 AC ±
 REMAINDER: 0.8 AC ±
 RIGHTS: NONE
 TITLE TAKEN: MD DE 10/10/60
 RECORDED: CHESTER BK 39-PG 458
 10/18/60

PARCEL: 12 U
 GRANTOR: HENRY J. & JENNIE W. CHAPMAN
 STATIONS: 107+25 - 109+40
 TAKING: 0.2 AC ±
 REMAINDER: 0.8 AC ±
 RIGHTS: NONE
 TITLE TAKEN: MD DE 10/10/60
 RECORDED: CHESTER BK 39-PG 458
 10/18/60

PARCEL: 12 V
 GRANTOR: HENRY J. & JENNIE W. CHAPMAN
 STATIONS: 109+40 - 111+55
 TAKING: 0.2 AC ±
 REMAINDER: 0.8 AC ±
 RIGHTS: NONE
 TITLE TAKEN: MD DE 10/10/60
 RECORDED: CHESTER BK 39-PG 458
 10/18/60

PARCEL: 12 W
 GRANTOR: HENRY J. & JENNIE W. CHAPMAN
 STATIONS: 111+55 - 113+70
 TAKING: 0.2 AC ±
 REMAINDER: 0.8 AC ±
 RIGHTS: NONE
 TITLE TAKEN: MD DE 10/10/60
 RECORDED: CHESTER BK 39-PG 458
 10/18/60

PARCEL: 12 X
 GRANTOR: HENRY J. & JENNIE W. CHAPMAN
 STATIONS: 113+70 - 115+85
 TAKING: 0.2 AC ±
 REMAINDER: 0.8 AC ±
 RIGHTS: NONE
 TITLE TAKEN: MD DE 10/10/60
 RECORDED: CHESTER BK 39-PG 458
 10/18/60

PARCEL: 12 Y
 GRANTOR: HENRY J. & JENNIE W. CHAPMAN
 STATIONS: 115+85 - 118+00
 TAKING: 0.2 AC ±
 REMAINDER: 0.8 AC ±
 RIGHTS: NONE
 TITLE TAKEN: MD DE 10/10/60
 RECORDED: CHESTER BK 39-PG 458
 10/18/60

PARCEL: 12 Z
 GRANTOR: HENRY J. & JENNIE W. CHAPMAN
 STATIONS: 118+00 - 120+15
 TAKING: 0.2 AC ±
 REMAINDER: 0.8 AC ±
 RIGHTS: NONE
 TITLE TAKEN: MD DE 10/10/60
 RECORDED: CHESTER BK 39-PG 458
 10/18/60

PARCEL: 12 AA
 GRANTOR: HENRY J. & JENNIE W. CHAPMAN
 STATIONS: 120+15 - 122+30
 TAKING: 0.2 AC ±
 REMAINDER: 0.8 AC ±
 RIGHTS: NONE
 TITLE TAKEN: MD DE 10/10/60
 RECORDED: CHESTER BK 39-PG 458
 10/18/60

PARCEL: 12 AB
 GRANTOR: HENRY J. & JENNIE W. CHAPMAN
 STATIONS: 122+30 - 124+45
 TAKING: 0.2 AC ±
 REMAINDER: 0.8 AC ±
 RIGHTS: NONE
 TITLE TAKEN: MD DE 10/10/60
 RECORDED: CHESTER BK 39-PG 458
 10/18/60

PARCEL: 12 AC
 GRANTOR: HENRY J. & JENNIE W. CHAPMAN
 STATIONS: 124+45 - 126+60
 TAKING: 0.2 AC ±
 REMAINDER: 0.8 AC ±
 RIGHTS: NONE
 TITLE TAKEN: MD DE 10/10/60
 RECORDED: CHESTER BK 39-PG 458
 10/18/60

PARCEL: 12 AD
 GRANTOR: HENRY J. & JENNIE W. CHAPMAN
 STATIONS: 126+60 - 128+75
 TAKING: 0.2 AC ±
 REMAINDER: 0.8 AC ±
 RIGHTS: NONE
 TITLE TAKEN: MD DE 10/10/60
 RECORDED: CHESTER BK 39-PG 458
 10/18/60

PARCEL: 12 AE
 GRANTOR: HENRY J. & JENNIE W. CHAPMAN
 STATIONS: 128+75 - 130+90
 TAKING: 0.2 AC ±
 REMAINDER: 0.8 AC ±
 RIGHTS: NONE
 TITLE TAKEN: MD DE 10/10/60
 RECORDED: CHESTER BK 39-PG 458
 10/18/60

PARCEL: 12 AF
 GRANTOR: HENRY J. & JENNIE W. CHAPMAN
 STATIONS: 130+90 - 133+05
 TAKING: 0.2 AC ±
 REMAINDER: 0.8 AC ±
 RIGHTS: NONE
 TITLE TAKEN: MD DE 10/10/60
 RECORDED: CHESTER BK 39-PG 458
 10/18/60

PARCEL: 12 AG
 GRANTOR: HENRY J. & JENNIE W. CHAPMAN
 STATIONS: 133+05 - 135+20
 TAKING: 0.2 AC ±
 REMAINDER: 0.8 AC ±
 RIGHTS: NONE
 TITLE TAKEN: MD DE 10/10/60
 RECORDED: CHESTER BK 39-PG 458
 10/18/60

PARCEL: 12 AH
 GRANTOR: HENRY J. & JENNIE W. CHAPMAN
 STATIONS: 135+20 - 137+35
 TAKING: 0.2 AC ±
 REMAINDER: 0.8 AC ±
 RIGHTS: NONE
 TITLE TAKEN: MD DE 10/10/60
 RECORDED: CHESTER BK 39-PG 458
 10/18/60

PARCEL: 12 AI
 GRANTOR: HENRY J. & JENNIE W. CHAPMAN
 STATIONS: 137+35 - 139+50
 TAKING: 0.2 AC ±
 REMAINDER: 0.8 AC ±
 RIGHTS: NONE
 TITLE TAKEN: MD DE 10/10/60
 RECORDED: CHESTER BK 39-PG 458
 10/18/60

PARCEL: 12 AJ
 GRANTOR: HENRY J. & JENNIE W. CHAPMAN
 STATIONS: 139+50 - 141+65
 TAKING: 0.2 AC ±
 REMAINDER: 0.8 AC ±
 RIGHTS: NONE
 TITLE TAKEN: MD DE 10/10/60
 RECORDED: CHESTER BK 39-PG 458
 10/18/60

PARCEL: 12 AK
 GRANTOR: HENRY J. & JENNIE W. CHAPMAN
 STATIONS: 141+65 - 143+80
 TAKING: 0.2 AC ±
 REMAINDER: 0.8 AC ±
 RIGHTS: NONE
 TITLE TAKEN: MD DE 10/10/60
 RECORDED: CHESTER BK 39-PG 458
 10/18/60

PARCEL: 12 AL
 GRANTOR: HENRY J. & JENNIE W. CHAPMAN
 STATIONS: 143+80 - 145+95
 TAKING: 0.2 AC ±
 REMAINDER: 0.8 AC ±
 RIGHTS: NONE
 TITLE TAKEN: MD DE 10/10/60
 RECORDED: CHESTER BK 39-PG 458
 10/18/60

PARCEL: 12 AM
 GRANTOR: HENRY J. & JENNIE W. CHAPMAN
 STATIONS: 145+95 - 148+10
 TAKING: 0.2 AC ±
 REMAINDER: 0.8 AC ±
 RIGHTS: NONE
 TITLE TAKEN: MD DE 10/10/60
 RECORDED: CHESTER BK 39-PG 458
 10/18/60

PARCEL: 12 AN
 GRANTOR: HENRY J. & JENNIE W. CHAPMAN
 STATIONS: 148+10 - 150+25
 TAKING: 0.2 AC ±
 REMAINDER: 0.8 AC ±
 RIGHTS: NONE
 TITLE TAKEN: MD DE 10/10/60
 RECORDED: CHESTER BK 39-PG 458
 10/18/60

PARCEL: 12 AO
 GRANTOR: HENRY J. & JENNIE W. CHAPMAN
 STATIONS: 150+25 - 152+40
 TAKING: 0.2 AC ±
 REMAINDER: 0.8 AC ±
 RIGHTS: NONE
 TITLE TAKEN: MD DE 10/10/60
 RECORDED: CHESTER BK 39-PG 458
 10/18/60

PARCEL: 12 AP
 GRANTOR: HENRY J. & JENNIE W. CHAPMAN
 STATIONS: 152+40 - 154+55
 TAKING: 0.2 AC ±
 REMAINDER: 0.8 AC ±
 RIGHTS: NONE
 TITLE TAKEN: MD DE 10/10/60
 RECORDED: CHESTER BK 39-PG 458
 10/18/60

PARCEL: 12 AQ
 GRANTOR: HENRY J. & JENNIE W. CHAPMAN
 STATIONS: 154+55 - 156+70
 TAKING: 0.2 AC ±
 REMAINDER: 0.8 AC ±
 RIGHTS: NONE
 TITLE TAKEN: MD DE 10/10/60
 RECORDED: CHESTER BK 39-PG 458
 10/18/60

PARCEL: 12 AR
 GRANTOR: HENRY J. & JENNIE W. CHAPMAN
 STATIONS: 156+70 - 158+85
 TAKING: 0.2 AC ±
 REMAINDER: 0.8 AC ±
 RIGHTS: NONE
 TITLE TAKEN: MD DE 10/10/60
 RECORDED: CHESTER BK 39-PG 458
 10/18/60


PARCEL: 12 AS
 GRANTOR: HENRY J. & JENNIE W. CHAPMAN
 STATIONS: 158+85 - 161+00
 TAKING: 0.2 AC ±
 REMAINDER: 0.8 AC ±
 RIGHTS: NONE
 TITLE TAKEN: MD DE 10/10/60
 RECORDED: CHESTER BK 39-PG 458
 10/18/60

PARCEL: 12 AT
 GRANTOR: HENRY J. & JENNIE W. CHAPMAN
 STATIONS: 161+00 - 163+15
 TAKING: 0.2 AC ±
 REMAINDER: 0.8 AC ±
 RIGHTS: NONE
 TITLE TAKEN: MD DE 10/10/60
 RECORDED: CHESTER BK 39-PG 458
 10/18/60

FOR PROFILE SEE SHEET NO. 12


CHESTER
 Project No. F-025-1(8)
 Sheet 11 of 208


5

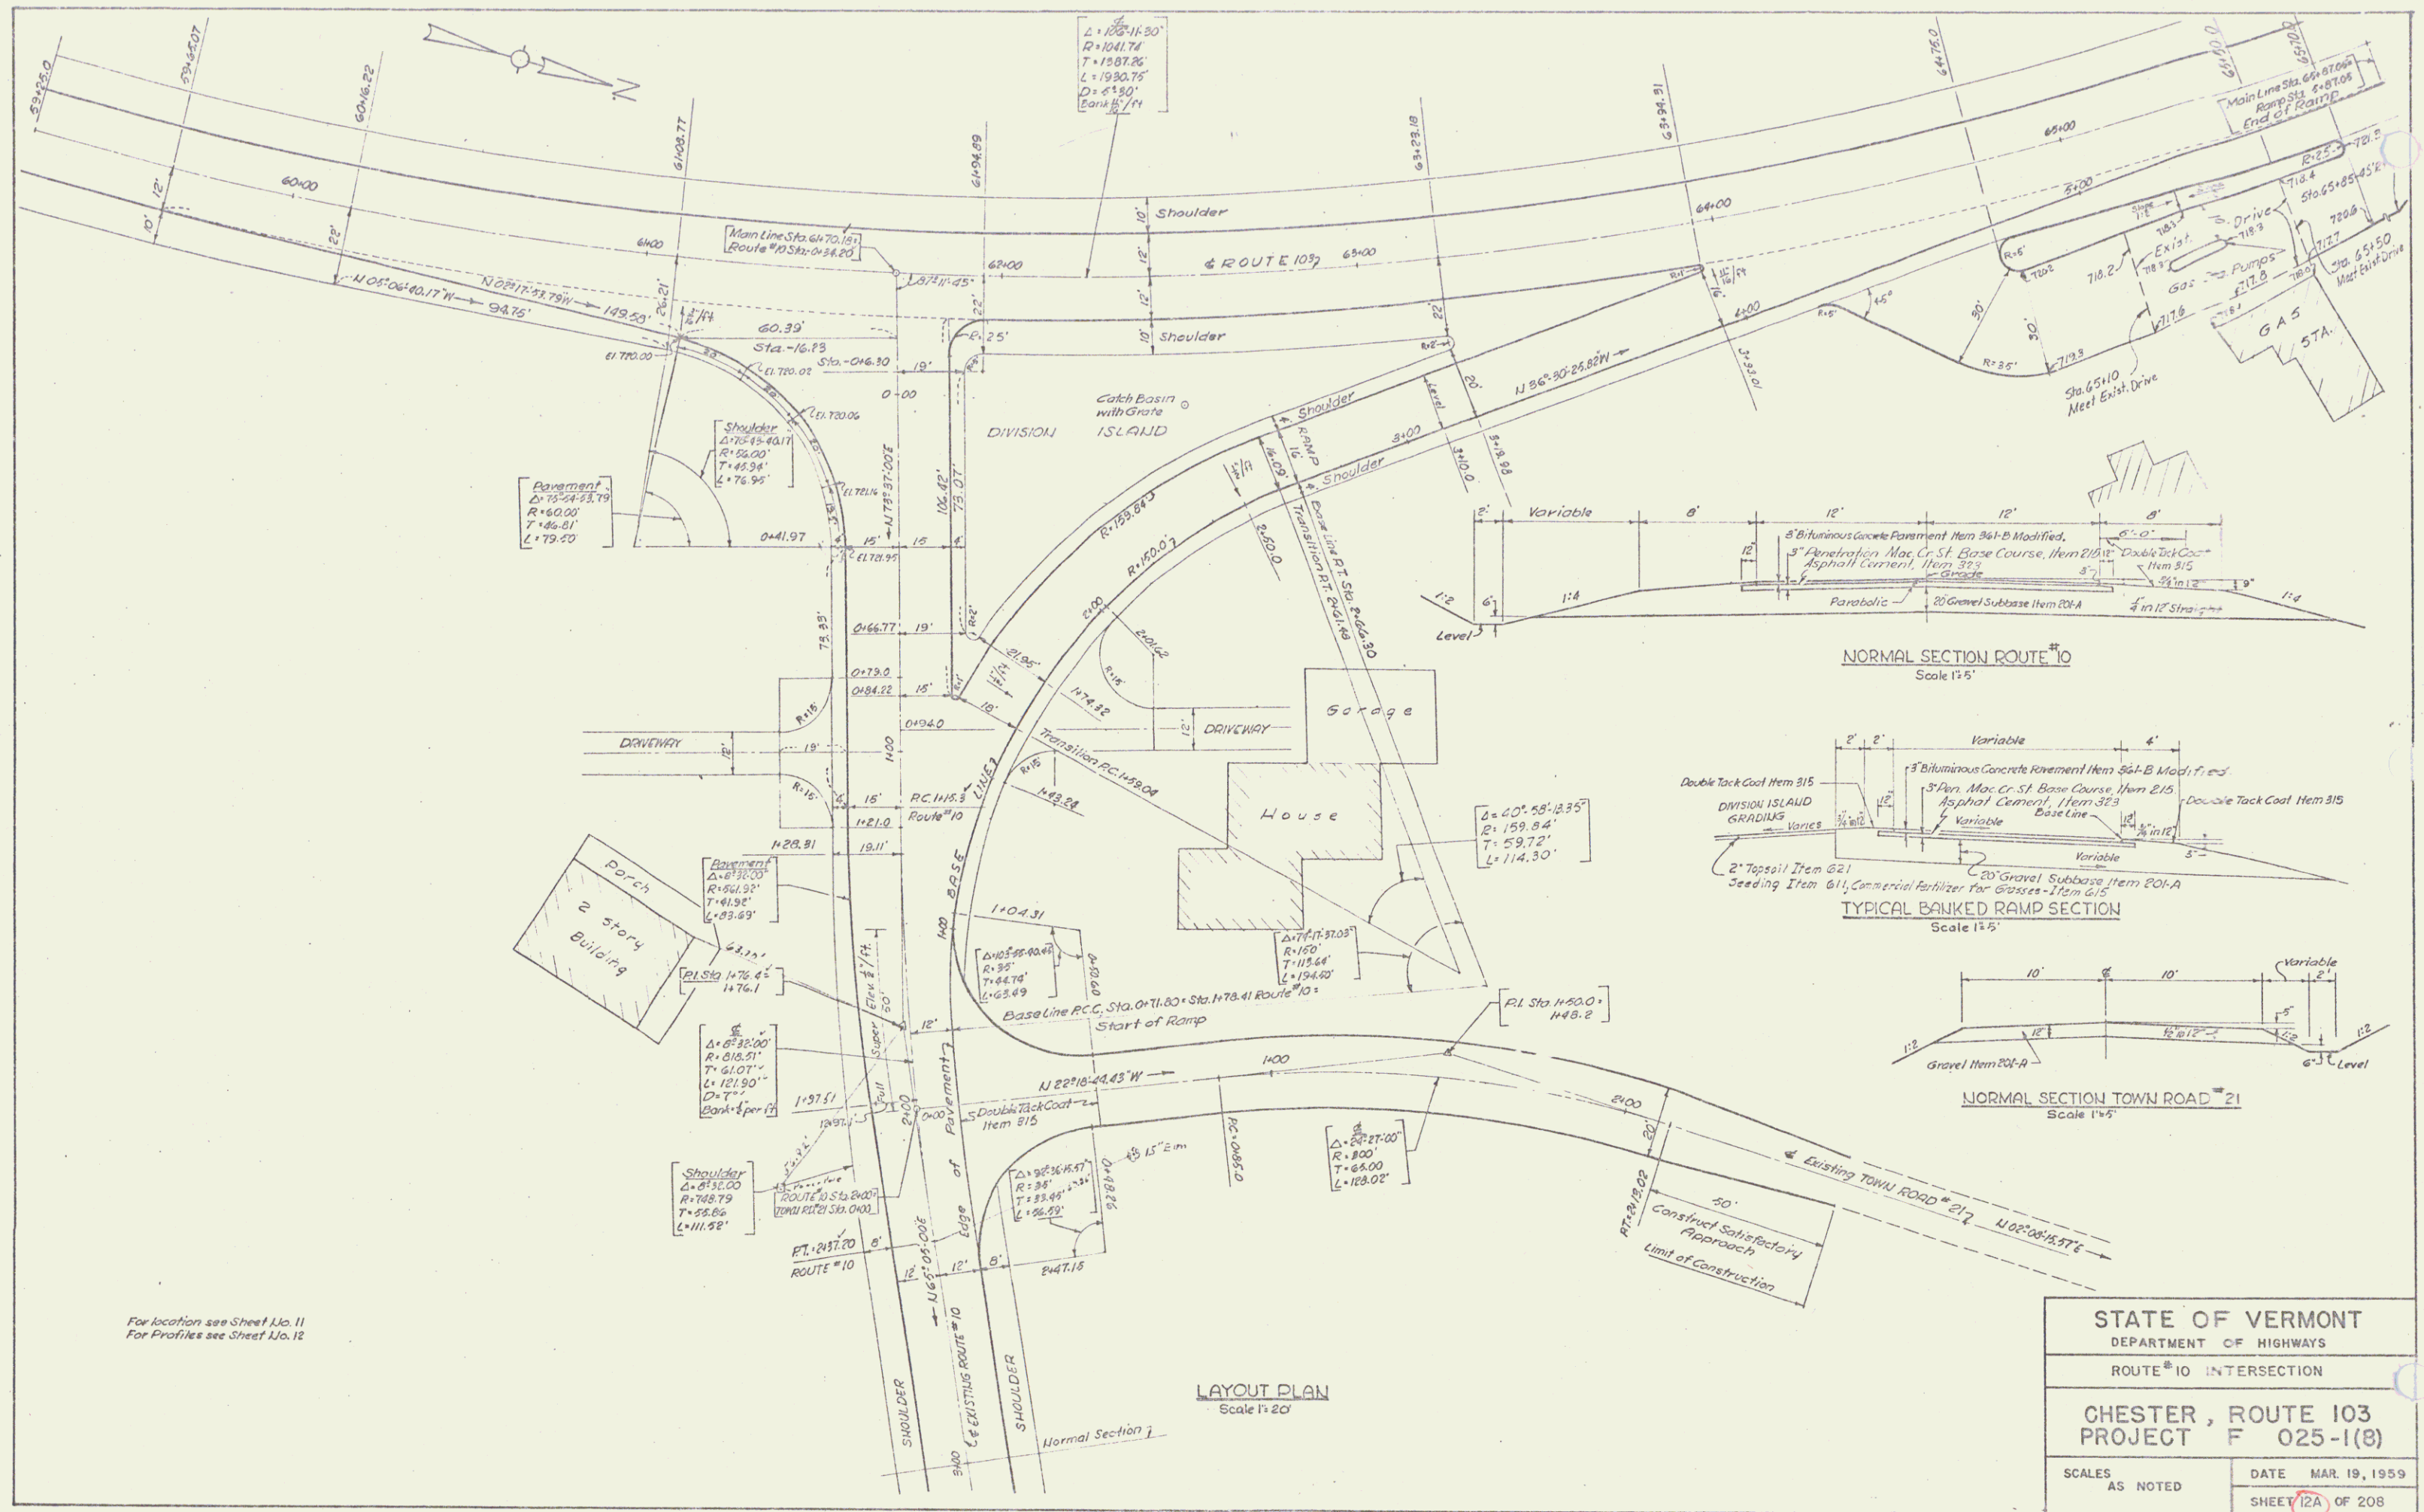


PLAN	DATE
BY	
CHECKED	
NOTE BOOK	
NO.	

PROFILE	DATE
BY	
CHECKED	
NOTE BOOK	
NO.	

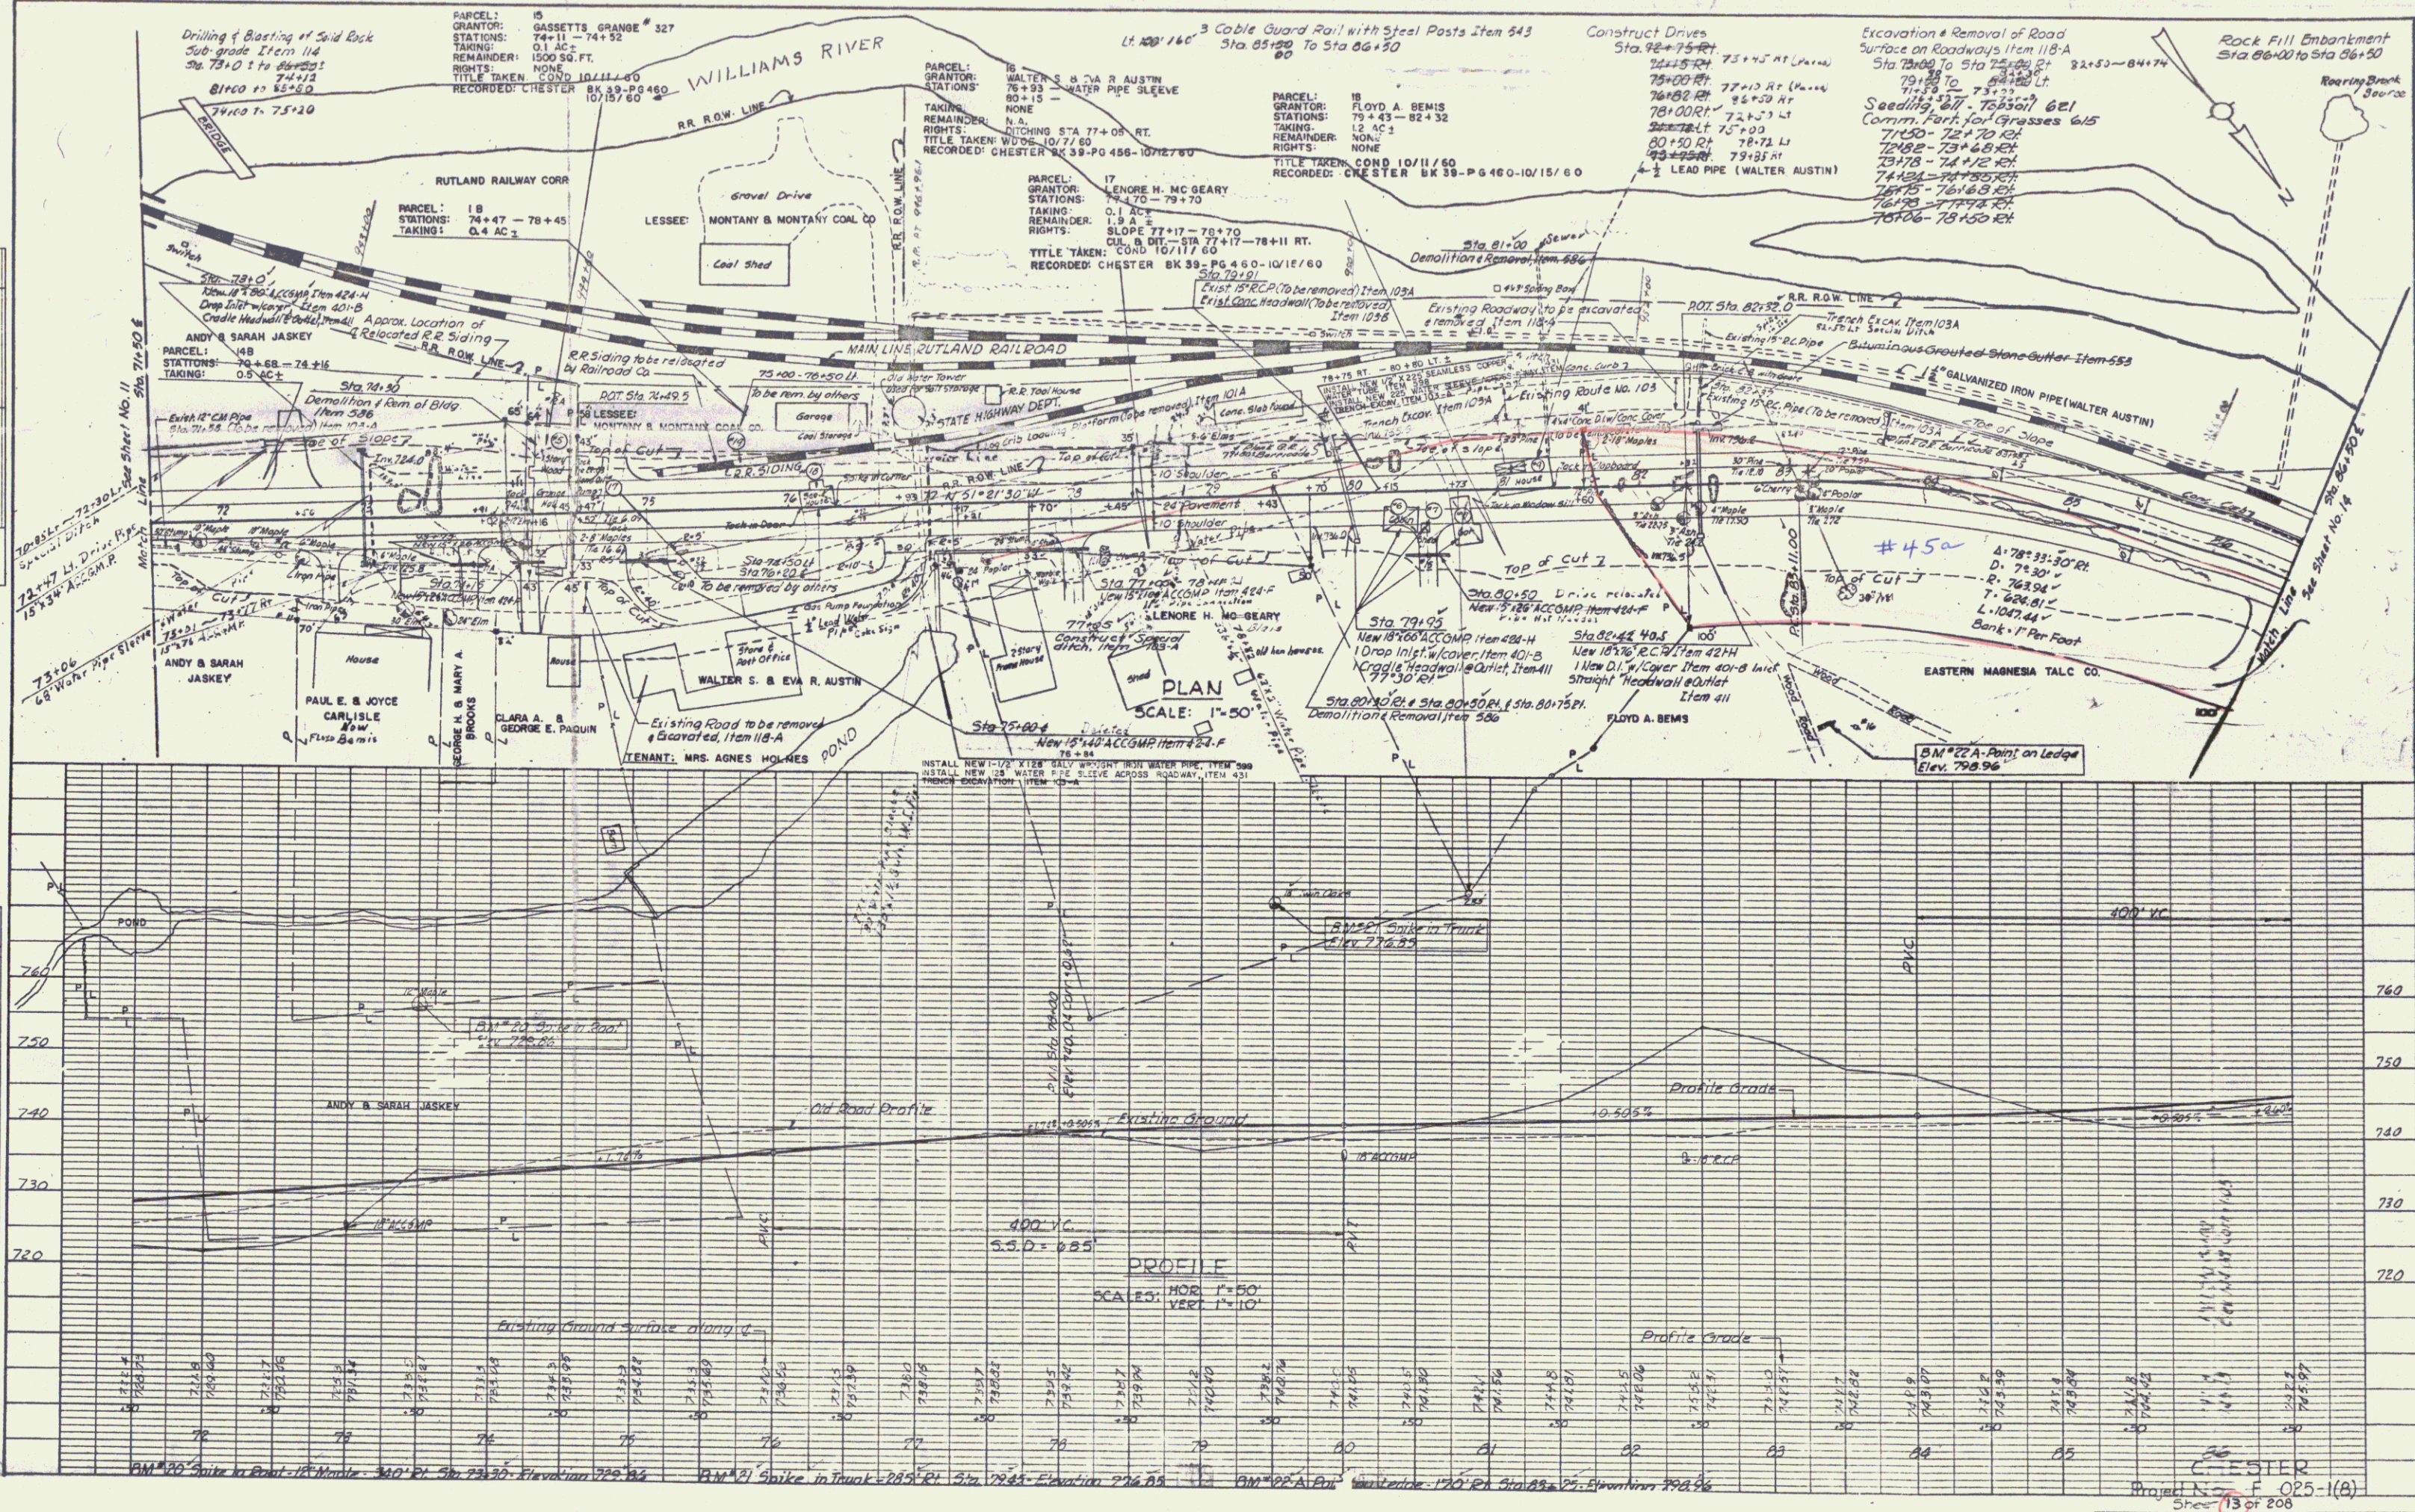

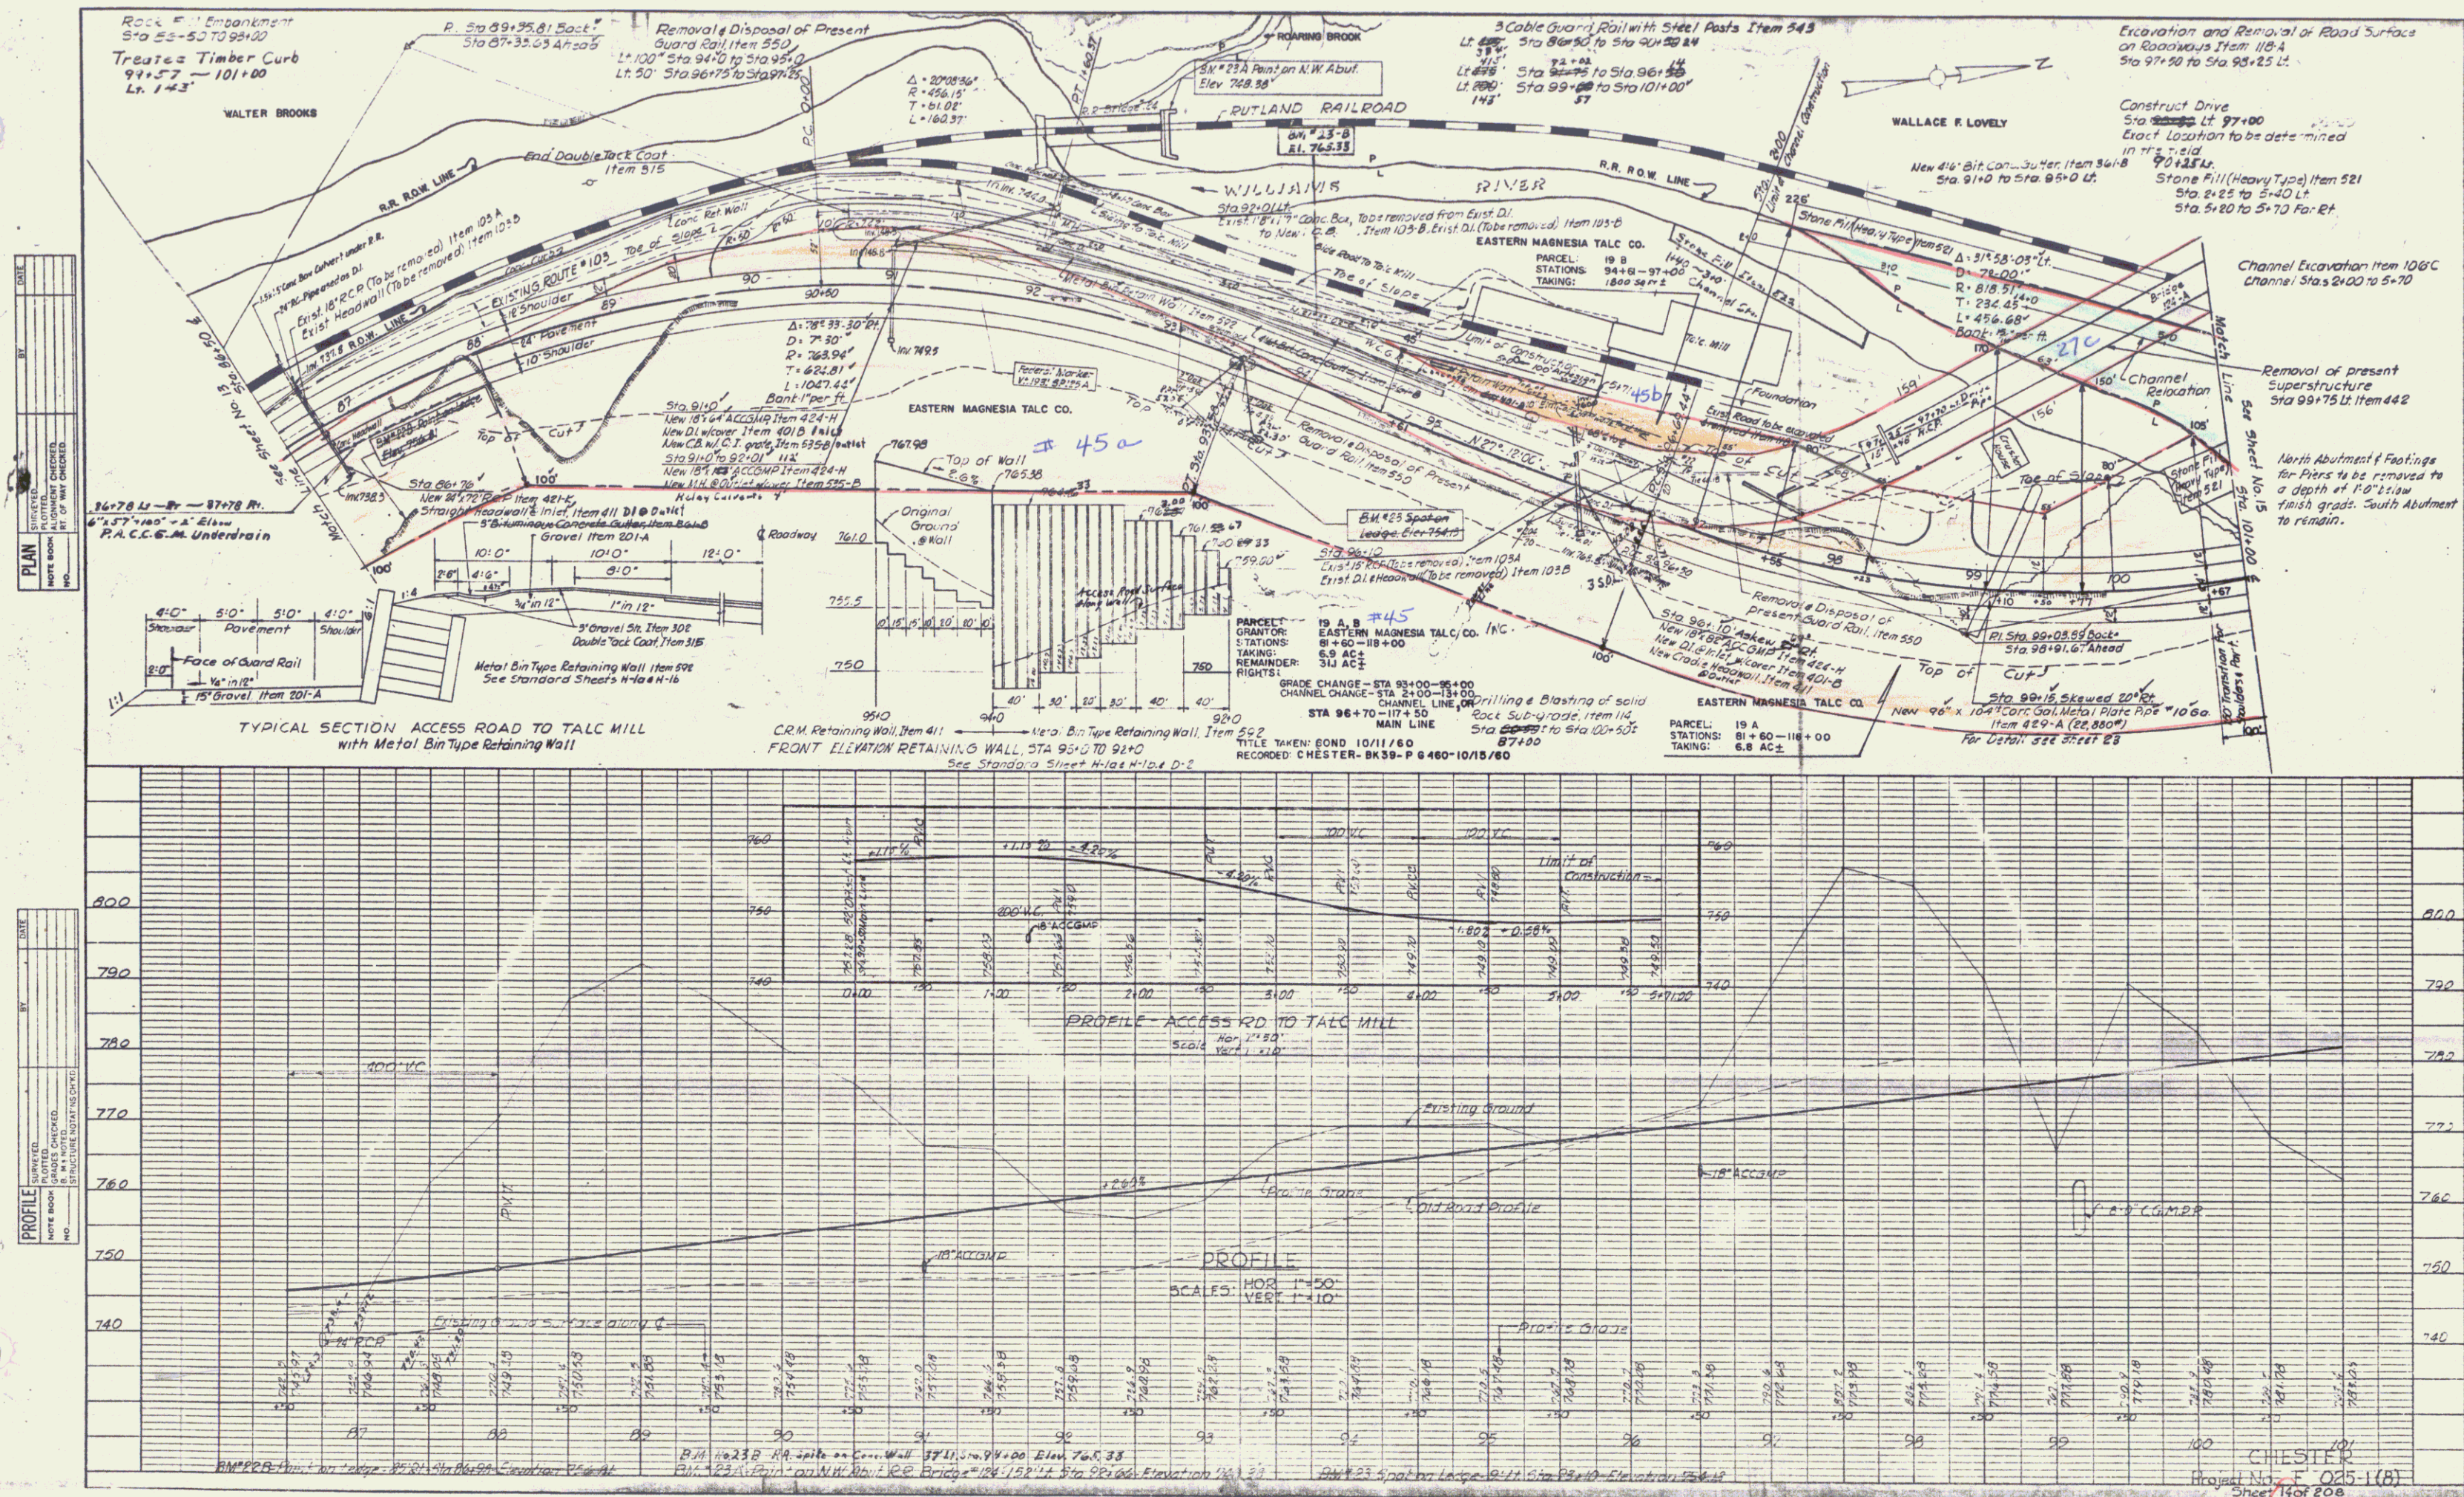


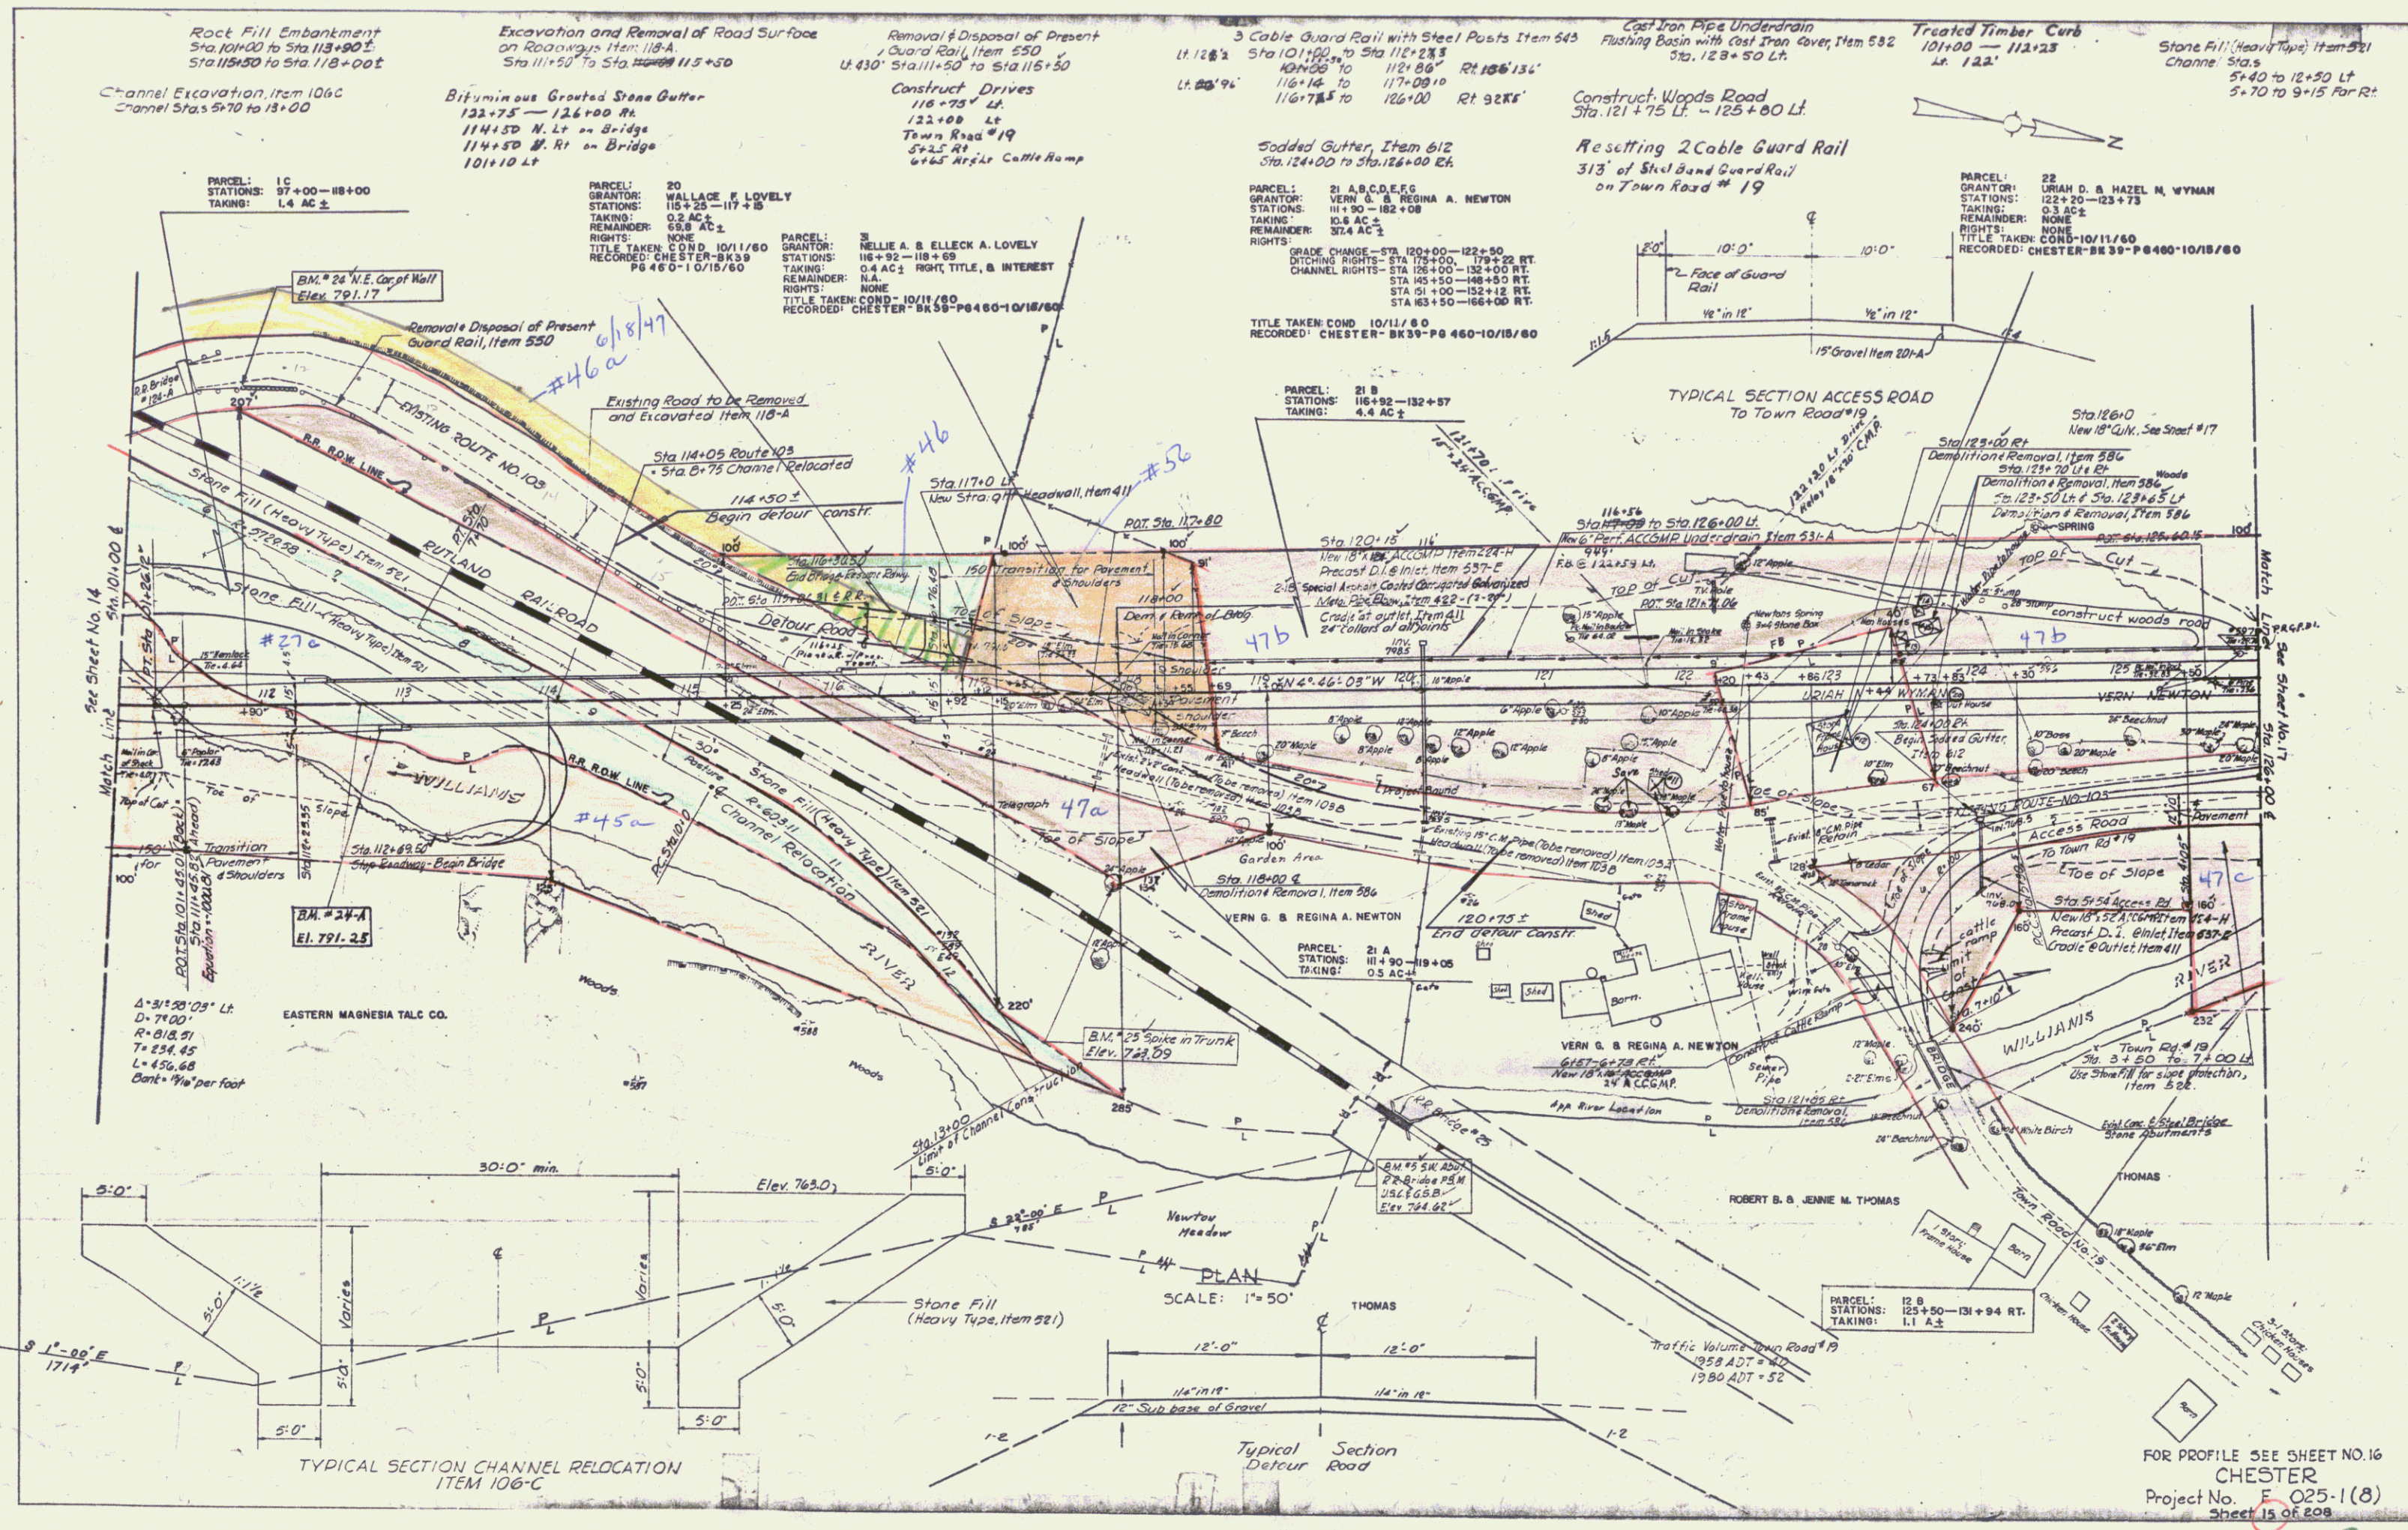


FOR PROFILE SEE SHEET NO. 16
CHESTER
Project No. E-025-1(8)
Sheet 15 of 208

THIS IS PART OF THE SAME LAND ACQUIRED BY THE STATE OF VERMONT AS PART OF THE ORIGINAL VT. RTE. 103 TAKEN INTO THE STATE HIGHWAY SYSTEM ON APRIL 4, 1931 BY ORDER OF THE STATE HIGHWAY BOARD PURSUANT TO LEGISLATIVE ACT 61 OF 1931 AND PART OF THE SAME LAND ACQUIRED FROM ELLECK LOVELY BY WARRANTY DEED OF EASEMENT DATED JUNE 16, 1947 AND RECORDED IN BOOK 35, PAGE 110 OF THE TOWN OF CHESTER LAND RECORDS.


MP 0924

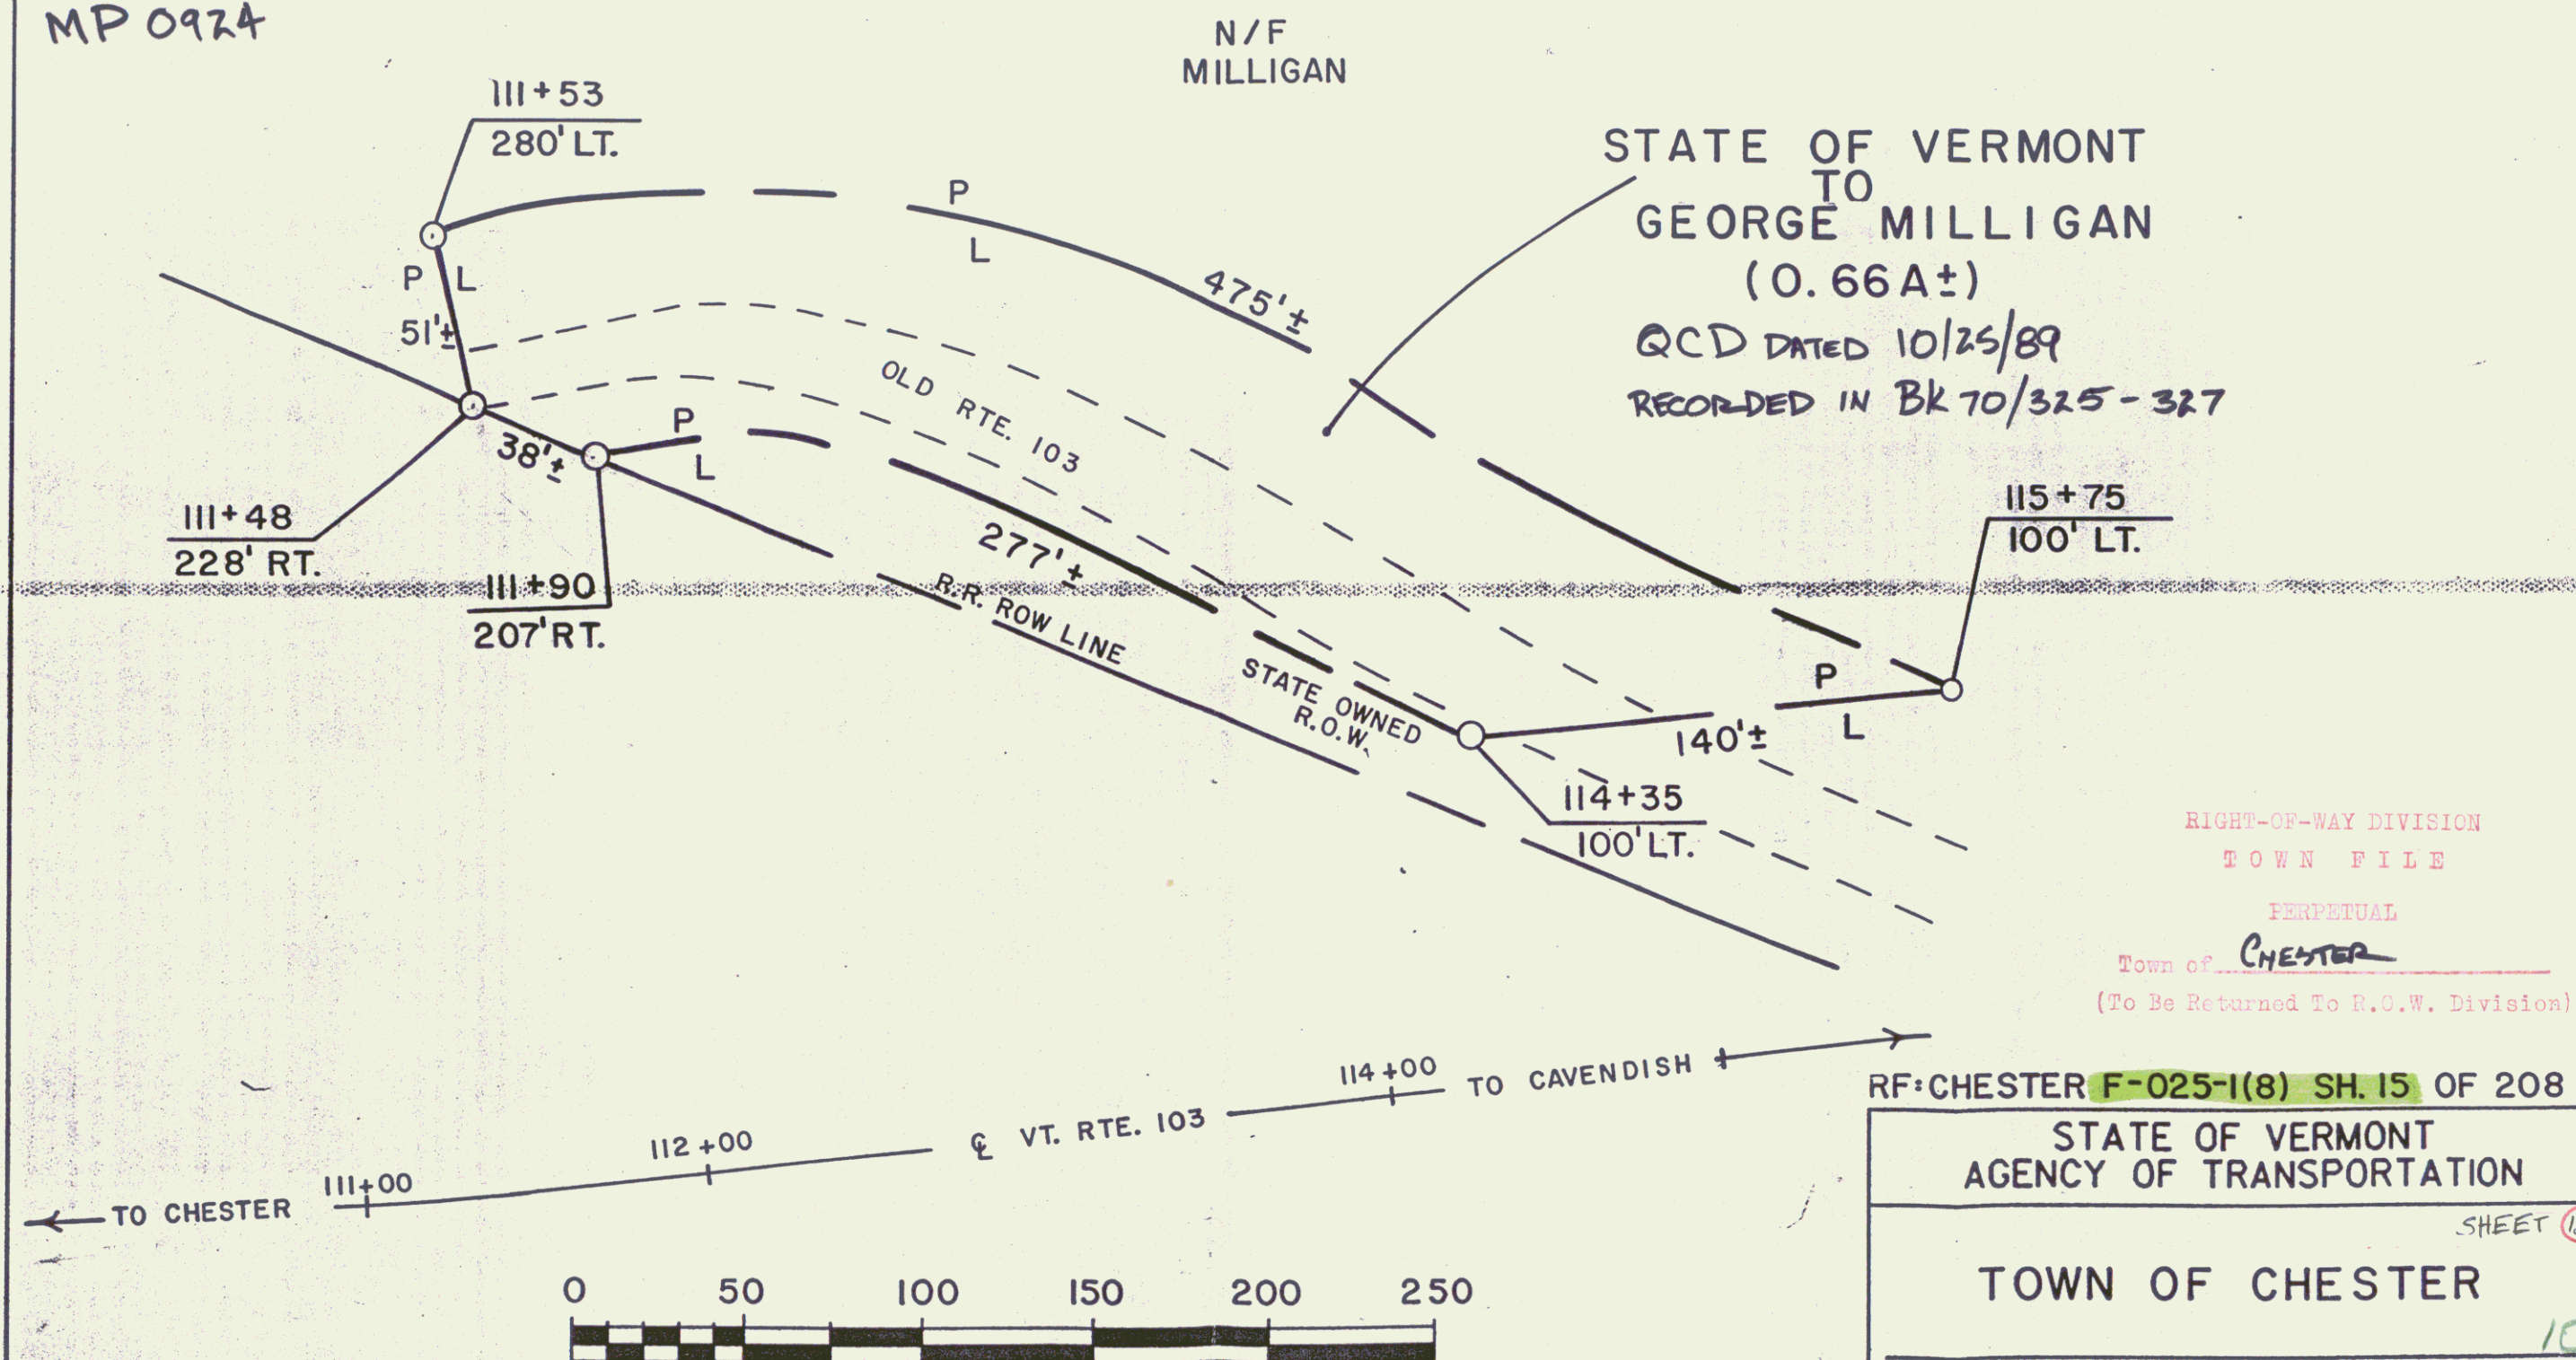

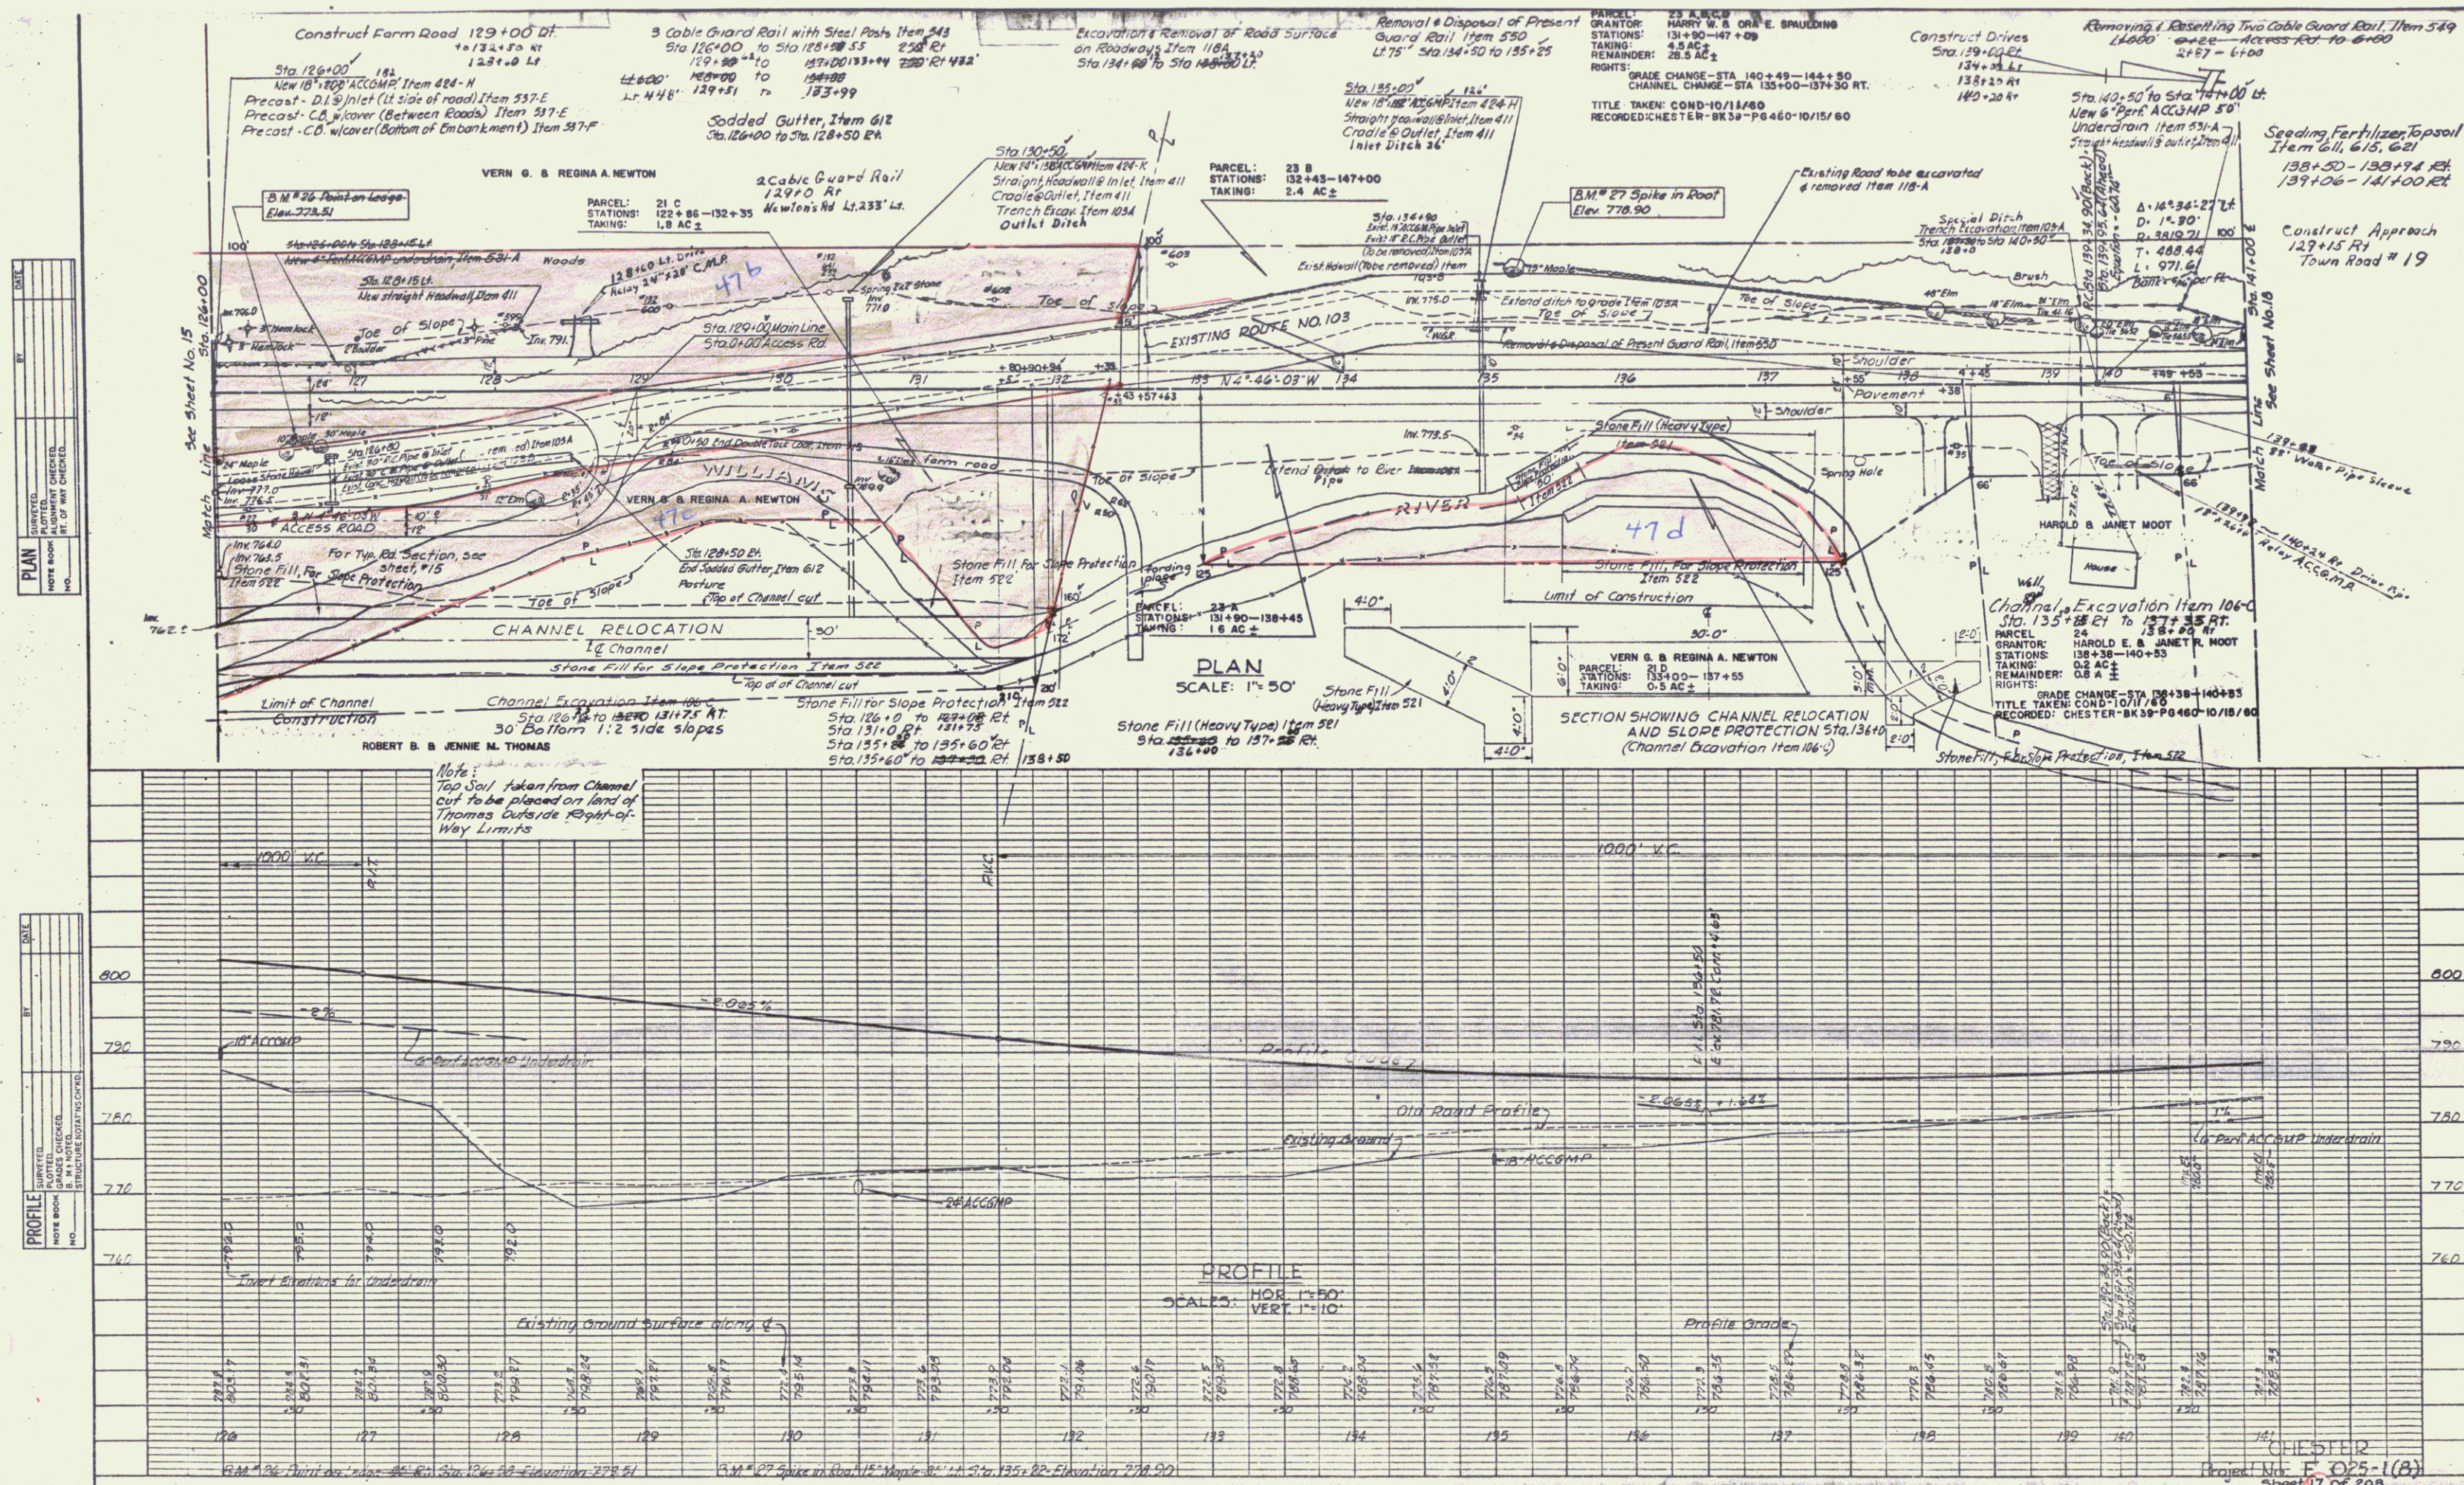

PLAN	DATE
NOTES	
1. ALL GRADES CHECKED	
2. ALL STATIONS CHECKED	
3. ALL DIMENSIONS CHECKED	
4. ALL NOTES CHECKED	
5. ALL NOTES CHECKED	
6. ALL NOTES CHECKED	
7. ALL NOTES CHECKED	
8. ALL NOTES CHECKED	
9. ALL NOTES CHECKED	
10. ALL NOTES CHECKED	

PROFILE	DATE
NOTES	
1. ALL GRADES CHECKED	
2. ALL STATIONS CHECKED	
3. ALL DIMENSIONS CHECKED	
4. ALL NOTES CHECKED	
5. ALL NOTES CHECKED	
6. ALL NOTES CHECKED	
7. ALL NOTES CHECKED	
8. ALL NOTES CHECKED	
9. ALL NOTES CHECKED	
10. ALL NOTES CHECKED	

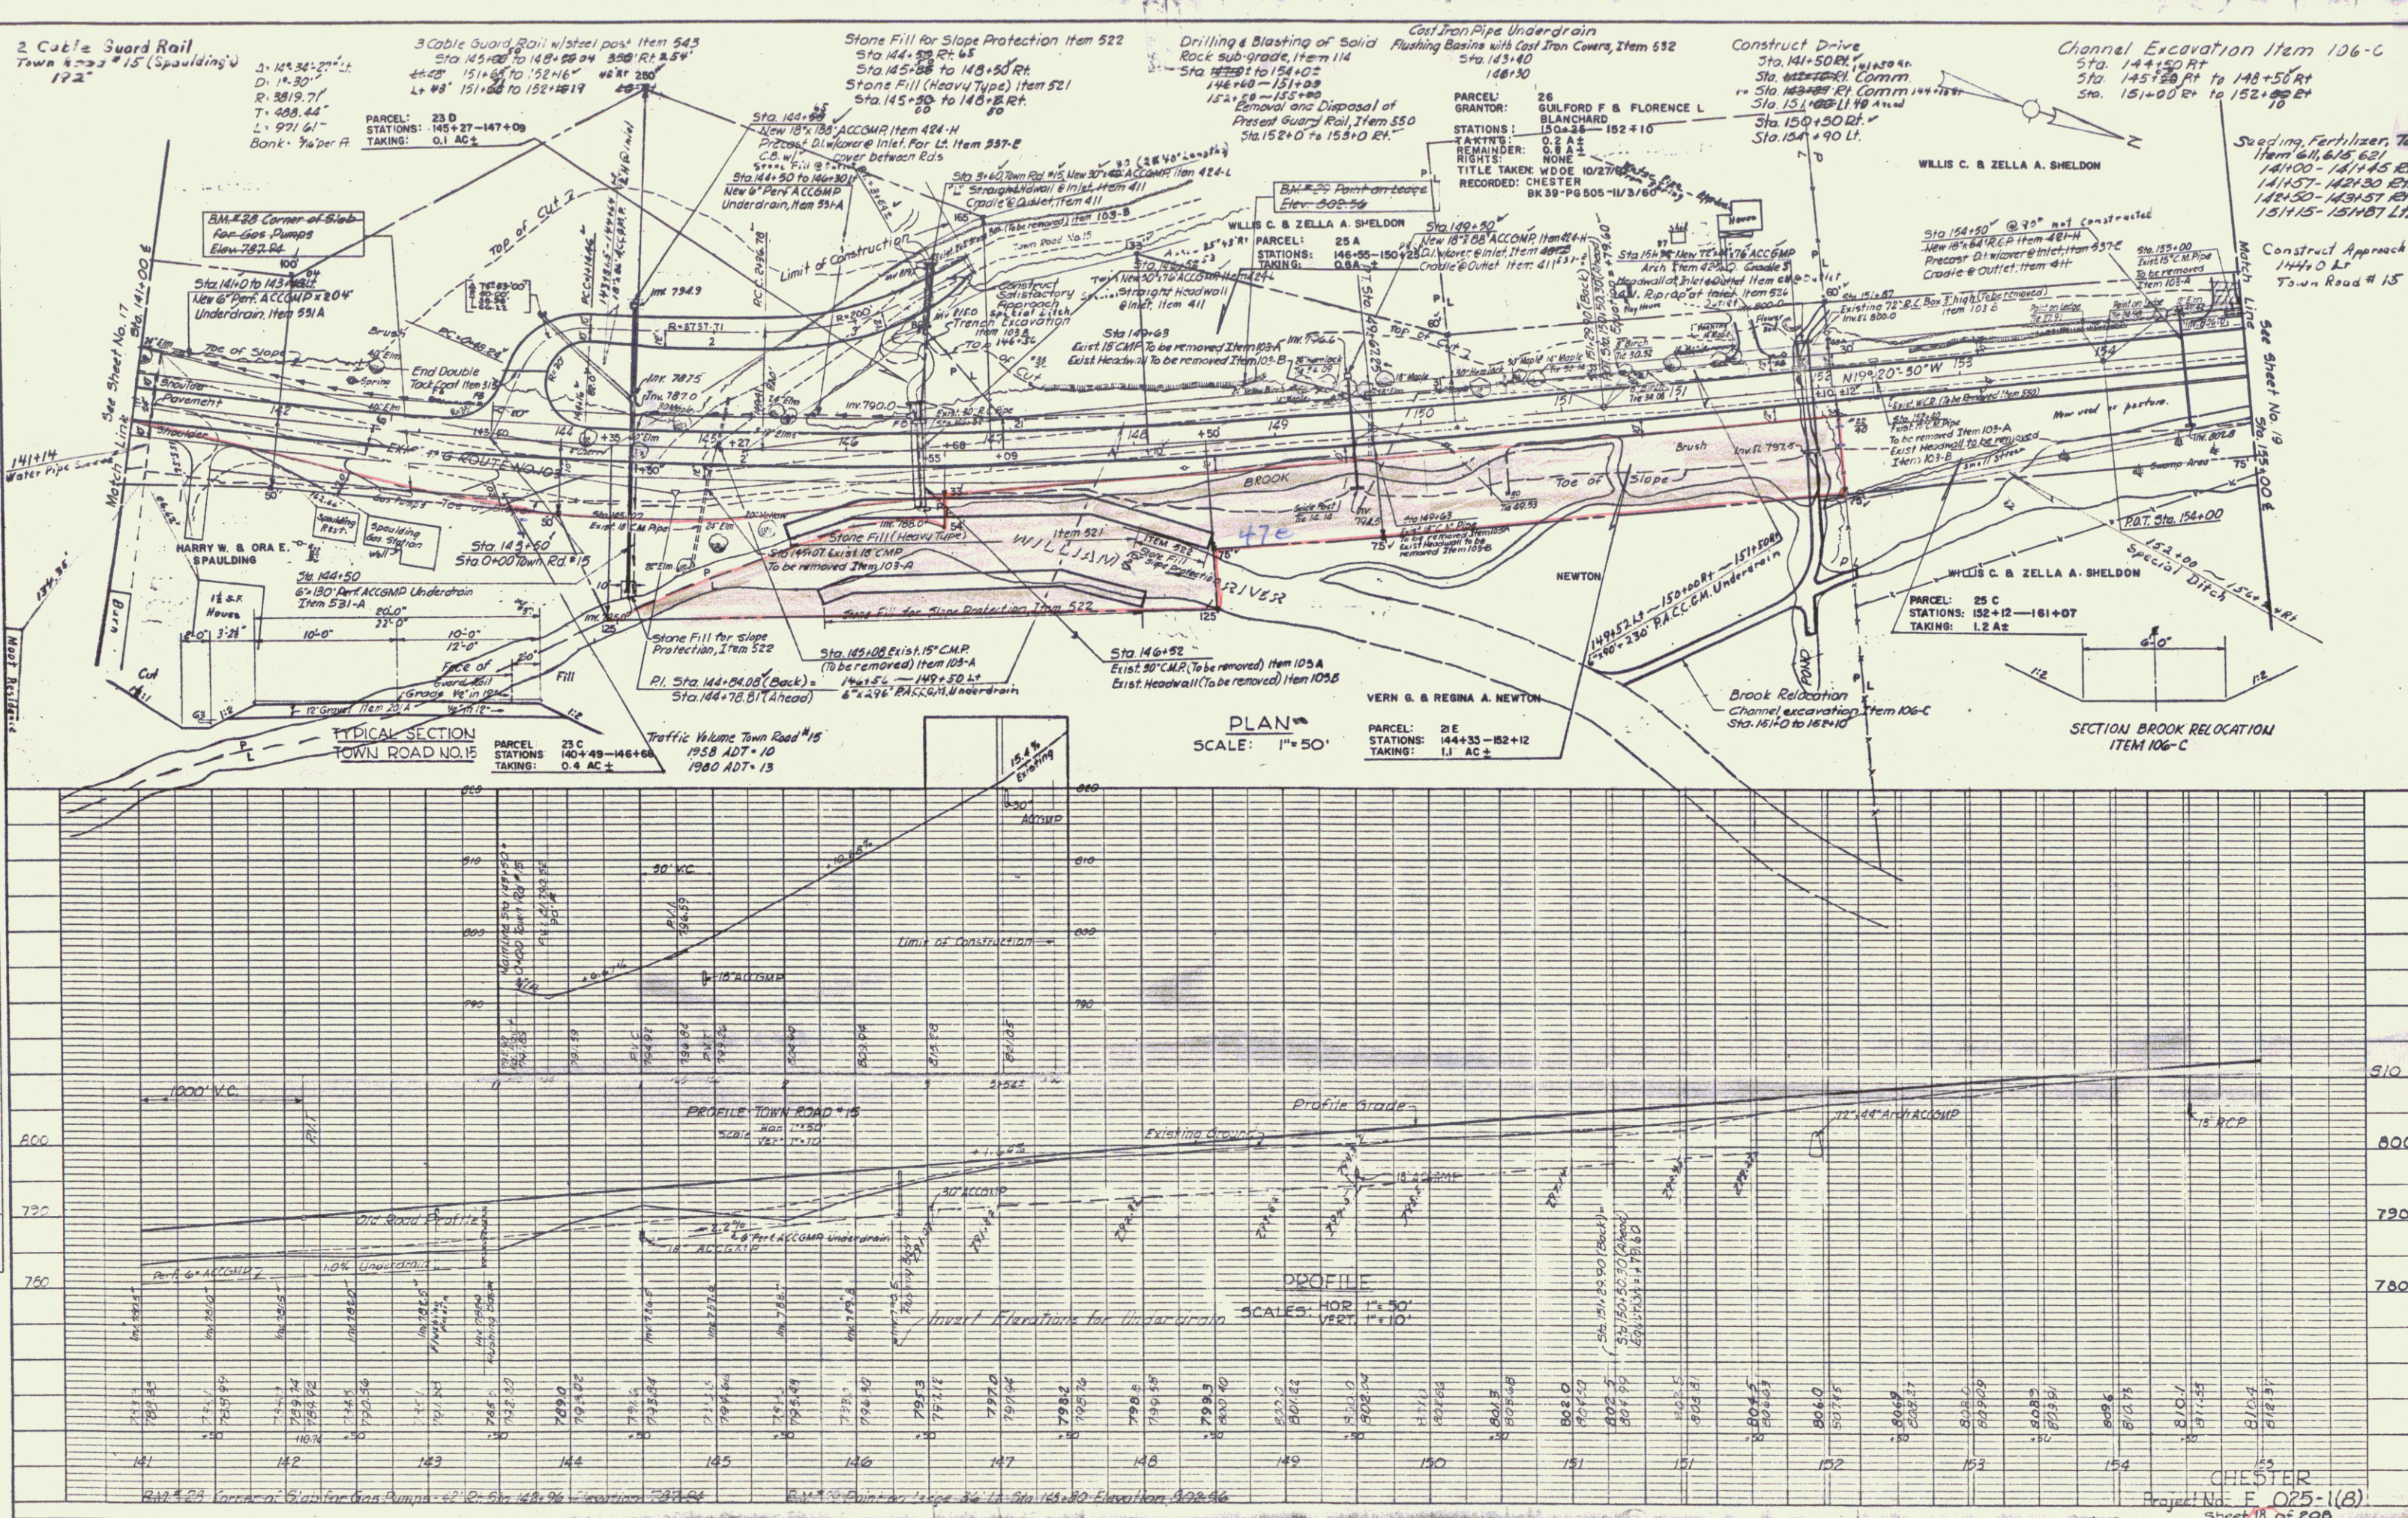

PLAN	DATE
SUBMITTED	
APPROVED	
NOTED	
REVISIONS	
BY	
DATE	

PROFILE	DATE
SUBMITTED	
APPROVED	
NOTED	
REVISIONS	
BY	
DATE	

