


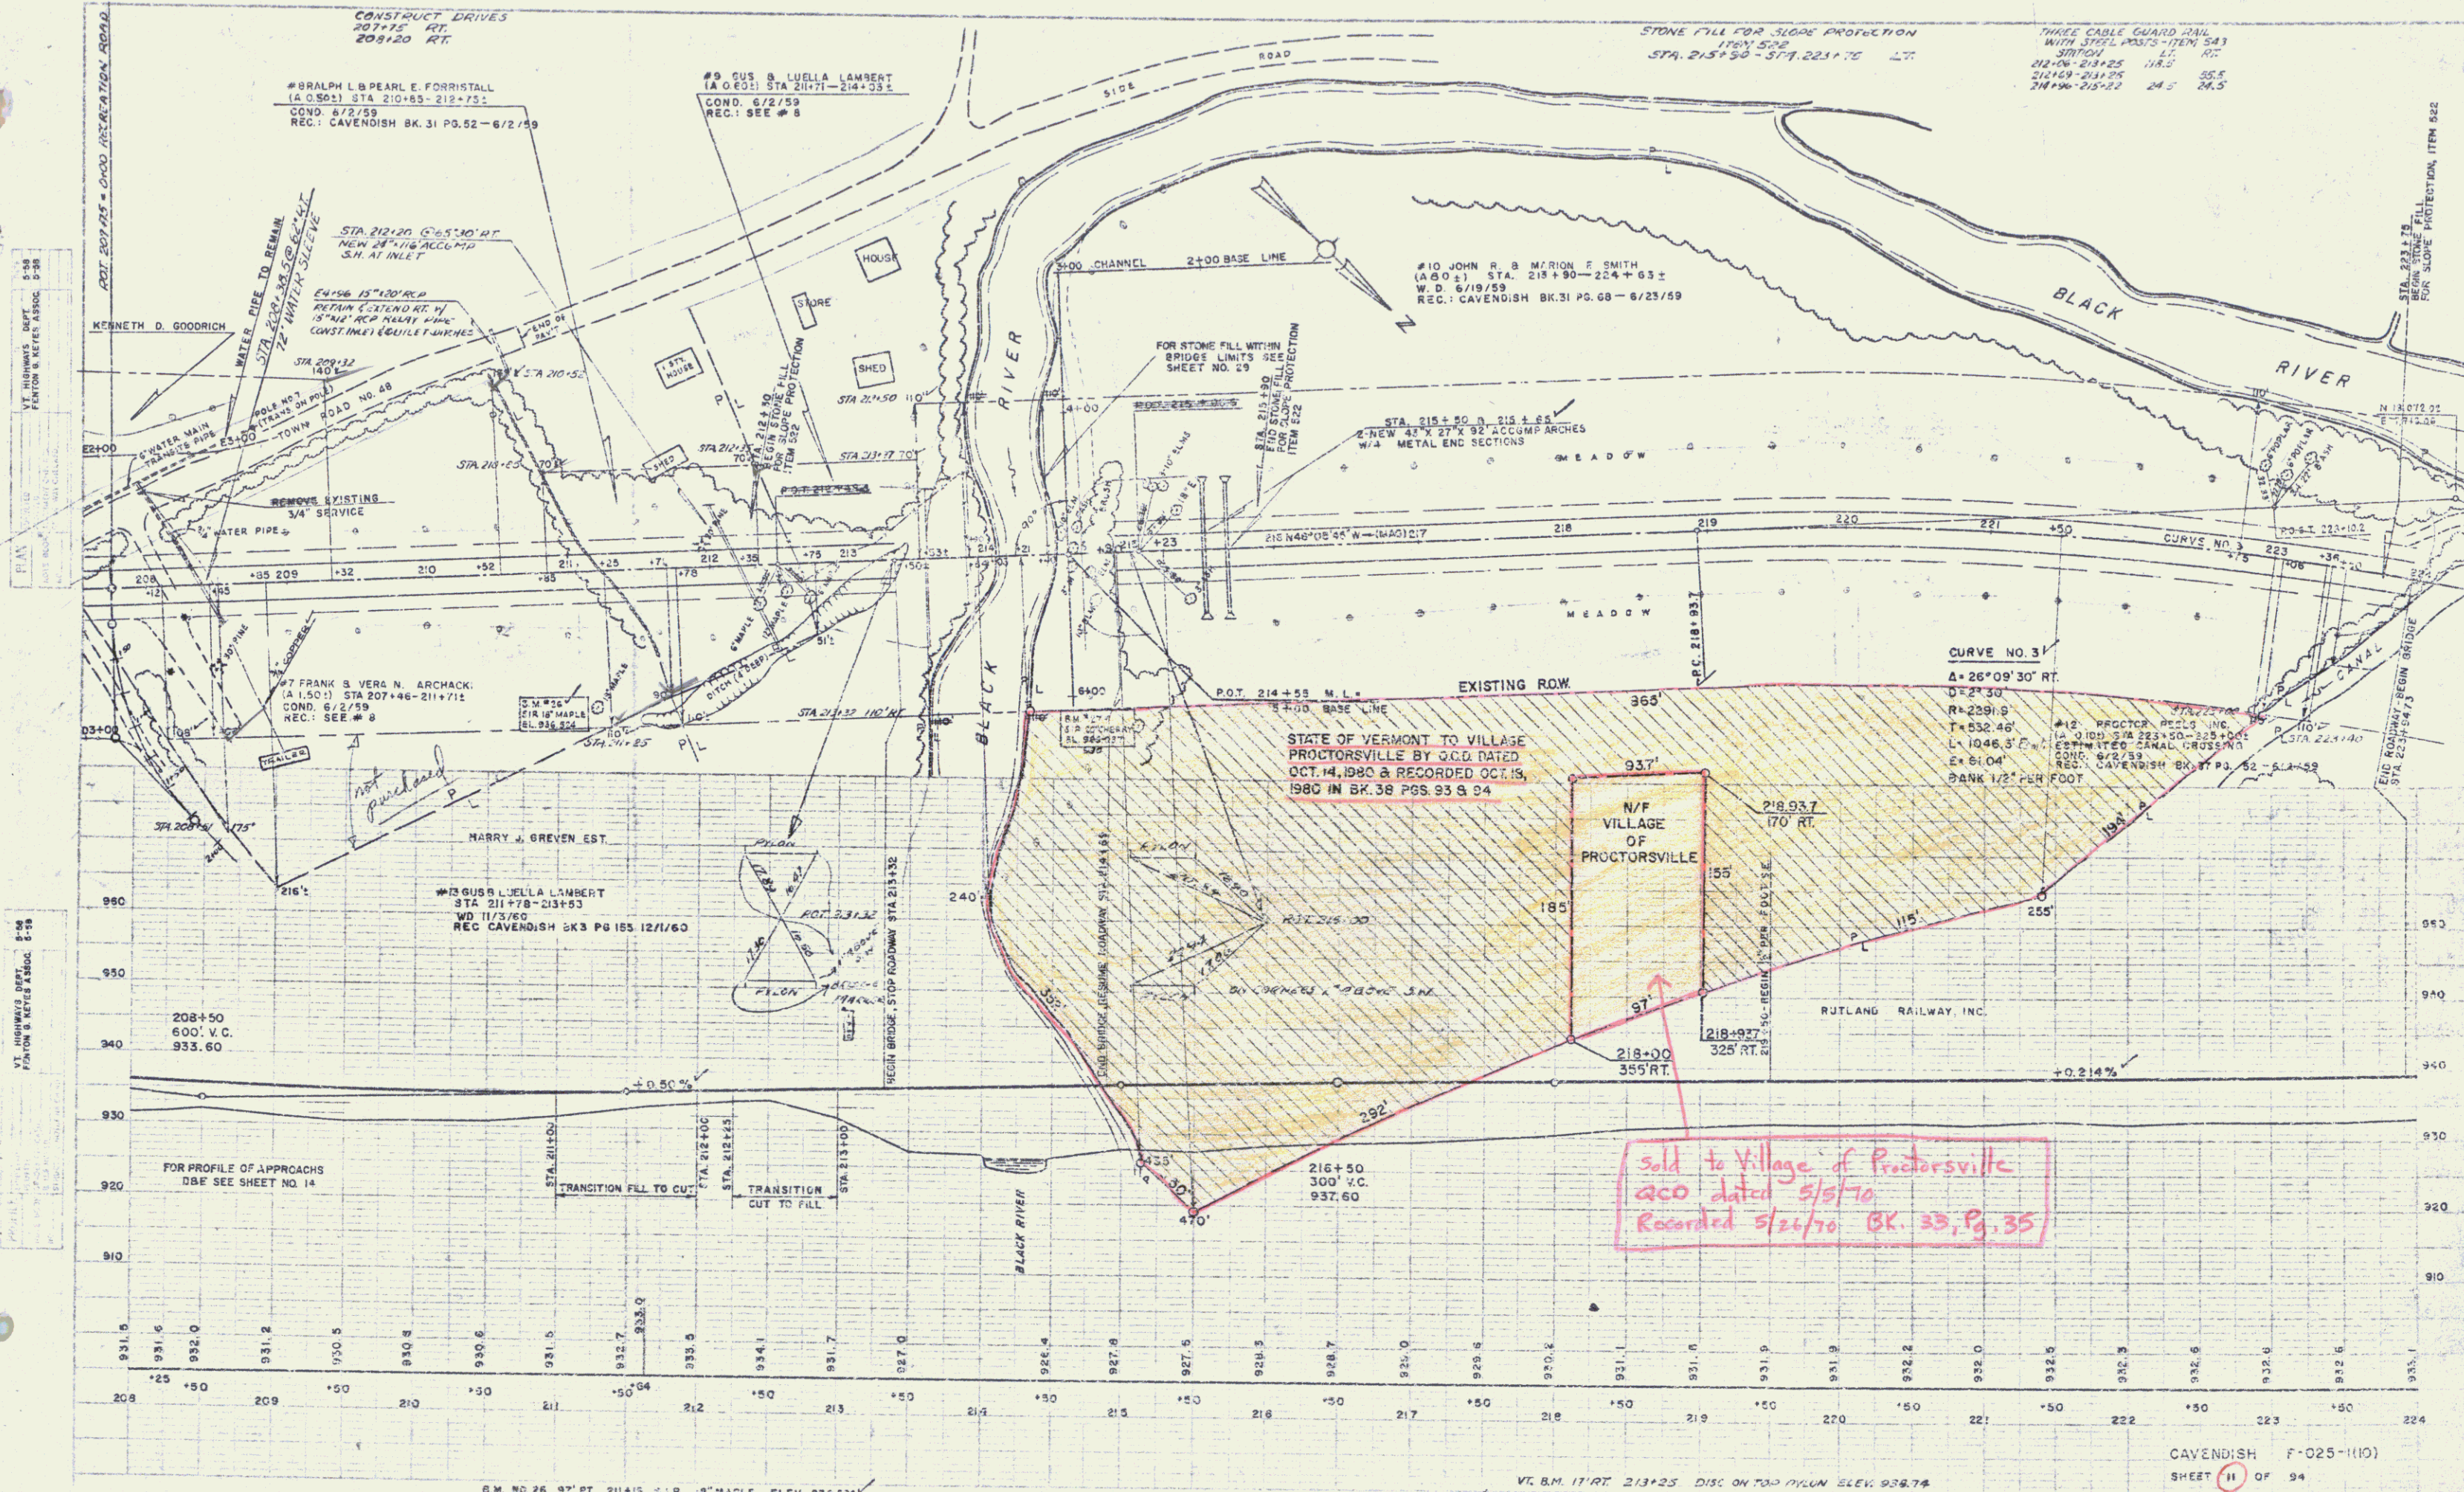

PLAN
SCALE 1" = 40'
DATE 10/30/79
BY J. H. HARRIS
CHECKED BY J. H. HARRIS

PLAN
SCALE 1" = 40'
DATE 10/30/79
BY J. H. HARRIS
CHECKED BY J. H. HARRIS

CAVENDISH F-025-110
SHEET 11 OF 94

OCT 30 1980