

- INDEX OF SHEETS
- 1 TITLE PAGE
 - 2 TYPICAL CROSS SECTION OF IMPROVEMENT, 3" BITUMINOUS CONCRETE PAVEMENT, ITEM 361-B, MODIFIED
 - 3 QUANTITY SHEET (ITEMS)
 - 4 QUANTITY SHEET (DRAINAGE)
 - 5-6 EARTHWORK SHEETS
 - 7-10 PLAN AND PROFILE SHEETS
 - 11 A-1 (DRILLING AND BLASTING OF SOLID ROCK SUBGRADE)
 - 12 B-1 (BANKING TABLES)
 - 13 B-5 (TYPICAL SLOPE GRADING)
 - 14 D-2 (DRAINAGE)
 - 14A D-3 (GUTTERS)
 - 15 D-4 (FLUSHING BASINS)
 - 16 D-8 (REINFORCED CONCRETE DROP INLET)
 - 17 E-1 (BARRICADES, SIGNS AND LIGHTS)
 - 17A E-9 (CONSTRUCTION IDENTIFICATION SIGNS)
 - 18 G-3 (THREE CABLE GUARD RAIL WITH STEEL POSTS)
 - 19 G-4 (STEEL MARKER POSTS AND PLANK GUARD RAIL)
 - 20 J-1 (PROJECT AND BOUNDARY MARKERS)
 - 21 DETAILS OF 60" CMPP
 - 22 CHANNEL SECTIONS
 - 23-33 CROSS SECTIONS

PROJECT NAME & NUMBER TYPE PAVEMENT AREA
ROCKINGHAM F 025-1(1) BIT. CONC. FAVT. II, 406 S.Y.

RECORD PLANS
MATERIALS

SUBBASE OF GRAVEL -- BARBER PARK PIT -- SAXTONS RIVER, VT.
-- TRASK PIT (formerly FONTAINE) -- BROCKWAY MILLS, VT.
SUBBASE OF SAND -- SPENCER PIT -- ROCKINGHAM, VT.
PENETRATION MACADAM CRUSHED STONE BASE COURSE & GRAVEL SHOULDERS
-- FERINI QUARRY (Pardo, Goldsmith, Jones property) -- WESTMINSTER, VT.
GRAVEL BACKFILL -- STODDARD PIT NO. 2 -- ROCKINGHAM, VT.
REFINED TAR -- WHITCO CHEMICAL CO. -- WORCESTER, MASS.
ASPHALT CEMENT -- ESSO -- EVERETT, MASS.
BITUMINOUS CONCRETE -- L.M. PIKE & SON INC. -- LACONIA, N. H.
CONCRETE CLASS "B" -- CHARLESTOWN READYMIX -- CHARLESTOWN, N. H.
REINFORCING STEEL -- BETHLEHEM STEEL CORP. -- BETHLEHEM, PA.
REINFORCED CONCRETE PIPE -- MARTIN MARIETTA CO. -- WINDSOR, VT.
ASPH. CTD. CORR. GALV. METAL PIPE & C.I. COVERS FOR FLUSHING BASINS --
-- NORTHEASTERN METAL CULVERT CO. -- WESTMINSTER, VT.
COPPER WATER TUBE -- ANACONDA WIRE CO. -- NEW YORK, N.Y.
SLEEVES FOR WATER PIPES -- CRANE PLUMBING SUPPLIES -- PITTSBURG, PA.
THREE CABLE GUARD RAIL, STEEL GUIDE & MARKER POSTS, BOUNDARY MARKERS --
-- S. T. GRISWOLD & CO. INC. -- WILLISTON, VT.
SHRUBS & VINES -- PUTNEY NURSERY INC. -- PUTNEY, VT.
CONTRACTOR -- PERINI CORP. -- FRAMINGHAM, MASS.
CONSULTING ENGINEER -- D. G. CADIZ.
DESIGNER -- R. TOWNS.
RECORD PLANS -- J. G. PHILBRICK.

STARTED -- AUGUST 28, 1962.
COMPLETED -- AUGUST 30, 1962.
ACCEPTED -- AUGUST 21, 1963.

STATE OF VERMONT
DEPARTMENT OF HIGHWAYS

PROPOSED IMPROVEMENT


FEDERAL AID PROJECT

TOWN OF ROCKINGHAM
COUNTY OF WINDHAM
VERMONT ROUTE 103
BELLOWS FALLS-CHESTER ROAD

BEGINNING AT A POINT 0.58 MILES NORTHWEST OF
THE INTERSECTION OF U.S. ROUTE 5 AND VERMONT
ROUTE 103 AND EXTENDING NORTHWESTERLY 0.810 MILES

4.2773
LENGTH OF PROJECT 4,276.3 FEET = 0.810 MILES

DESIGN	DESIGNATION
ADT (1960)	2750
ADT (1980)	3580
DIV	420
V	57%
V	10%
V	50 MPH

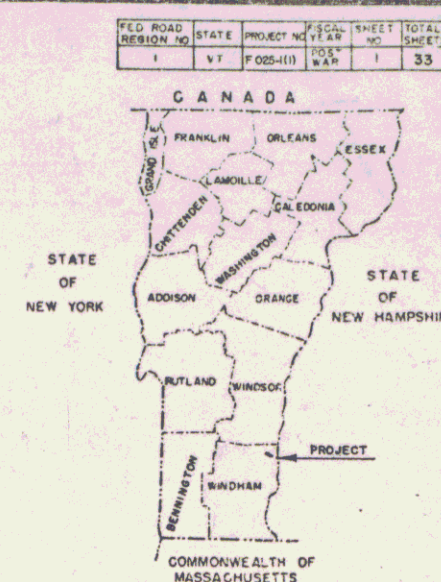

RIGHT-OF-WAY DIVISION
TOWN FILE

PERPETUAL
Town of Ut 103
(To Be Returned To R.O.W. Division)

NOTE: ANY FURTHER INFORMATION CONCERNING
FINAL QUANTITIES, MATERIALS, OR OTHER DETAILS
RELATIVE TO THIS PROJECT, SHOULD BE FURNISHED IN
EITHER THE FIELD BOOKS OR THE CONTRACT
FILE.

THESE PLANS ARE SUBJECT TO SUCH REVISIONS AS MAY BE
REQUIRED BY THE BUREAU OF PUBLIC ROADS OR THE COMMISSIONER
OF HIGHWAYS.

CONSTRUCTION IS TO BE CARRIED ON IN ACCORDANCE WITH
THE PLANS AND THE STANDARD SPECIFICATIONS FOR HIGHWAY AND BRIDGE
CONSTRUCTION OF JANUARY, 1956, SUBMITTED TO THE BUREAU OF
PUBLIC ROADS AS APPROVED JULY 5, 1956, INCLUDING ALL SUBSEQUENT
APPROVED REVISIONS AND SUCH REVISED SPECIFICATIONS AND SPECIAL
PROVISIONS AS ARE SUBMITTED WITH THE PLANS.

DEPARTMENT OF COMMERCE
BUREAU OF PUBLIC ROADS
Pin # 00R143


APPROVED
DIVISION ENGINEER DATE

PROJECT F NO. 025-1(1)

SHEET 1 OF 33 SHEETS


APPROVED SECONDARY ENGINEER DATE 10-24-60
APPROVED BRIDGE ENGINEER DATE 10/24/60
APPROVED DISTRICT ENGINEER DATE 10/24/60
APPROVED HIGHWAY ENGINEER DATE 10/24/60
APPROVED CHIEF ENGINEER DATE 10-21-60
SUBMITTED BY ORDER OF THE STATE HIGHWAY BOARD

12-59
1-60
2-60
3-60
4-60
5-60
6-60
7-60
8-60
9-60
10-60
11-60
12-60
1-61
2-61
3-61
4-61
5-61
6-61
7-61
8-61
9-61
10-61
11-61
12-61
1-62
2-62
3-62
4-62
5-62
6-62
7-62
8-62
9-62
10-62
11-62
12-62
1-63
2-63
3-63
4-63
5-63
6-63
7-63
8-63
9-63
10-63
11-63
12-63
1-64
2-64
3-64
4-64
5-64
6-64
7-64
8-64
9-64
10-64
11-64
12-64
1-65
2-65
3-65
4-65
5-65
6-65
7-65
8-65
9-65
10-65
11-65
12-65
1-66
2-66
3-66
4-66
5-66
6-66
7-66
8-66
9-66
10-66
11-66
12-66
1-67
2-67
3-67
4-67
5-67
6-67
7-67
8-67
9-67
10-67
11-67
12-67
1-68
2-68
3-68
4-68
5-68
6-68
7-68
8-68
9-68
10-68
11-68
12-68
1-69
2-69
3-69
4-69
5-69
6-69
7-69
8-69
9-69
10-69
11-69
12-69
1-70
2-70
3-70
4-70
5-70
6-70
7-70
8-70
9-70
10-70
11-70
12-70
1-71
2-71
3-71
4-71
5-71
6-71
7-71
8-71
9-71
10-71
11-71
12-71
1-72
2-72
3-72
4-72
5-72
6-72
7-72
8-72
9-72
10-72
11-72
12-72
1-73
2-73
3-73
4-73
5-73
6-73
7-73
8-73
9-73
10-73
11-73
12-73
1-74
2-74
3-74
4-74
5-74
6-74
7-74
8-74
9-74
10-74
11-74
12-74
1-75
2-75
3-75
4-75
5-75
6-75
7-75
8-75
9-75
10-75
11-75
12-75
1-76
2-76
3-76
4-76
5-76
6-76
7-76
8-76
9-76
10-76
11-76
12-76
1-77
2-77
3-77
4-77
5-77
6-77
7-77
8-77
9-77
10-77
11-77
12-77
1-78
2-78
3-78
4-78
5-78
6-78
7-78
8-78
9-78
10-78
11-78
12-78
1-79
2-79
3-79
4-79
5-79
6-79
7-79
8-79
9-79
10-79
11-79
12-79
1-80
2-80
3-80
4-80
5-80
6-80
7-80
8-80
9-80
10-80
11-80
12-80
1-81
2-81
3-81
4-81
5-81
6-81
7-81
8-81
9-81
10-81
11-81
12-81
1-82
2-82
3-82
4-82
5-82
6-82
7-82
8-82
9-82
10-82
11-82
12-82
1-83
2-83
3-83
4-83
5-83
6-83
7-83
8-83
9-83
10-83
11-83
12-83
1-84
2-84
3-84
4-84
5-84
6-84
7-84
8-84
9-84
10-84
11-84
12-84
1-85
2-85
3-85
4-85
5-85
6-85
7-85
8-85
9-85
10-85
11-85
12-85
1-86
2-86
3-86
4-86
5-86
6-86
7-86
8-86
9-86
10-86
11-86
12-86
1-87
2-87
3-87
4-87
5-87
6-87
7-87
8-87
9-87
10-87
11-87
12-87
1-88
2-88
3-88
4-88
5-88
6-88
7-88
8-88
9-88
10-88
11-88
12-88
1-89
2-89
3-89
4-89
5-89
6-89
7-89
8-89
9-89
10-89
11-89
12-89
1-90
2-90
3-90
4-90
5-90
6-90
7-90
8-90
9-90
10-90
11-90
12-90
1-91
2-91
3-91
4-91
5-91
6-91
7-91
8-91
9-91
10-91
11-91
12-91
1-92
2-92
3-92
4-92
5-92
6-92
7-92
8-92
9-92
10-92
11-92
12-92
1-93
2-93
3-93
4-93
5-93
6-93
7-93
8-93
9-93
10-93
11-93
12-93
1-94
2-94
3-94
4-94
5-94
6-94
7-94
8-94
9-94
10-94
11-94
12-94
1-95
2-95
3-95
4-95
5-95
6-95
7-95
8-95
9-95
10-95
11-95
12-95
1-96
2-96
3-96
4-96
5-96
6-96
7-96
8-96
9-96
10-96
11-96
12-96
1-97
2-97
3-97
4-97
5-97
6-97
7-97
8-97
9-97
10-97
11-97
12-97
1-98
2-98
3-98
4-98
5-98
6-98
7-98
8-98
9-98
10-98
11-98
12-98
1-99
2-99
3-99
4-99
5-99
6-99
7-99
8-99
9-99
10-99
11-99
12-99
1-100
2-100
3-100
4-100
5-100
6-100
7-100
8-100
9-100
10-100
11-100
12-100
1-101
2-101
3-101
4-101
5-101
6-101
7-101
8-101
9-101
10-101
11-101
12-101
1-102
2-102
3-102
4-102
5-102
6-102
7-102
8-102
9-102
10-102
11-102
12-102
1-103
2-103
3-103
4-103
5-103
6-103
7-103
8-103
9-103
10-103
11-103
12-103
1-104
2-104
3-104
4-104
5-104
6-104
7-104
8-104
9-104
10-104
11-104
12-104
1-105
2-105
3-105
4-105
5-105
6-105
7-105
8-105
9-105
10-105
11-105
12-105
1-106
2-106
3-106
4-106
5-106
6-106
7-106
8-106
9-106
10-106
11-106
12-106
1-107
2-107
3-107
4-107
5-107
6-107
7-107
8-107
9-107
10-107
11-107
12-107
1-108
2-108
3-108
4-108
5-108
6-108
7-108
8-108
9-108
10-108
11-108
12-108
1-109
2-109
3-109
4-109
5-109
6-109
7-109
8-109
9-109
10-109
11-109
12-109
1-110
2-110
3-110
4-110
5-110
6-110
7-110
8-110
9-110
10-110
11-110
12-110
1-111
2-111
3-111
4-111
5-111
6-111
7-111
8-111
9-111
10-111
11-111
12-111
1-112
2-112
3-112
4-112
5-112
6-112
7-112
8-112
9-112
10-112
11-112
12-112
1-113
2-113
3-113
4-113
5-113
6-113
7-113
8-113
9-113
10-113
11-113
12-113
1-114
2-114
3-114
4-114
5-114
6-114
7-114
8-114
9-114
10-114
11-114
12-114
1-115
2-115
3-115
4-115
5-115
6-115
7-115
8-115
9-115
10-115
11-115
12-115
1-116
2-116
3-116
4-116
5-116
6-116
7-116
8-116
9-116
10-116
11-116
12-116
1-117
2-117
3-117
4-117
5-117
6-117
7-117
8-117
9-117
10-117
11-117
12-117
1-118
2-118
3-118
4-118
5-118
6-118
7-118
8-118
9-118
10-118
11-118
12-118
1-119
2-119
3-119
4-119
5-119
6-119
7-119
8-119
9-119
10-119
11-119
12-119
1-120
2-120
3-120
4-120
5-120
6-120
7-120
8-120
9-120
10-120
11-120
12-120
1-121
2-121
3-121
4-121
5-121
6-121
7-121
8-121
9-121
10-121
11-121
12-121
1-122
2-122
3-122
4-122
5-122
6-122
7-122
8-122
9-122
10-122
11-122
12-122
1-123
2-123
3-123
4-123
5-123
6-123
7-123
8-123
9-123
10-123
11-123
12-123
1-124
2-124
3-124
4-124
5-124
6-124
7-124
8-124
9-124
10-124
11-124
12-124
1-125
2-125
3-125
4-125
5-125
6-125
7-125
8-125
9-125
10-125
11-125
12-125
1-126
2-126
3-126
4-126
5-126
6-126
7-126
8-126
9-126
10-126
11-126
12-126
1-127
2-127
3-127
4-127
5-127
6-127
7-127
8-127
9-127
10-127
11-127
12-127
1-128
2-128
3-128
4-128
5-128
6-128
7-128
8-128
9-128
10-128
11-128
12-128
1-129
2-129
3-129
4-129
5-129
6-129
7-129
8-129
9-129
10-129
11-129
12-129
1-130
2-130
3-130
4-130
5-130
6-130
7-130
8-130
9-130
10-130
11-130
12-130
1-131
2-131
3-131
4-131
5-131
6-131
7-131
8-131
9-131
10-131
11-131
12-131
1-132
2-132
3-132
4-132
5-132
6-132
7-132
8-132
9-132
10-132
11-132
12-132
1-133
2-133
3-133
4-133
5-133
6-133
7-133
8-133
9-133
10-133
11-133
12-133
1-134
2-134
3-134
4-134
5-134
6-134
7-134
8-134
9-134
10-134
11-134
12-134
1-135
2-135
3-135
4-135
5-135
6-135
7-135
8-135
9-135
10-135
11-135
12-135
1-136
2-136
3-136
4-136
5-136
6-136
7-136
8-136
9-136
10-136
11-136
12-136
1-137
2-137
3-137
4-137
5-137
6-137
7-137
8-137
9-137
10-137
11-137
12-137
1-138
2-138
3-138
4-138
5-138
6-138
7-138
8-138
9-138
10-138
11-138
12-138
1-139
2-139
3-139
4-139
5-139
6-139
7-139
8-139
9-139
10-139
11-139
12-139
1-140
2-140
3-140
4-140
5-140
6-140
7-140
8-140
9-140
10-140
11-140
12-140
1-141
2-141
3-141
4-141
5-141
6-141
7-141
8-141
9-141
10-141
11-141
12-141
1-142
2-142
3-142
4-142
5-142
6-142
7-142
8-142
9-142
10-142
11-142
12-142
1-143
2-143
3-143
4-143
5-143
6-143
7-143
8-143
9-143
10-143
11-143
12-143
1-144
2-144
3-144
4-144
5-144
6-144
7-144
8-144
9-144
10-144
11-144
12-144
1-145
2-145
3-145
4-145
5-145
6-145
7-145
8-145
9-145
10-145
11-145
12-145
1-146
2-146
3-146
4-146
5-146
6-146
7-146
8-146
9-146
10-146
11-146
12-146
1-147
2-147
3-147
4-147
5-147
6-147
7-147
8-147
9-147
10-147
11-147
12-147
1-148
2-148
3-148
4-148
5-148
6-148
7-148
8-148
9-148
10-148
11-148
12-148
1-149
2-149
3-149
4-149
5-149
6-149
7-149
8-149
9-149
10-149
11-149
12-149
1-150
2-150
3-150
4-150
5-150
6-150
7-150
8-150
9-150
10-150
11-150
12-150
1-151
2-151
3-151
4-151
5-151
6-151
7-151
8-151
9-151
10-151
11-151
12-151
1-152
2-152
3-152
4-152
5-152
6-152
7-152
8-152
9-152
10-152
11-152
12-152
1-153
2-153
3-153
4-153
5-153
6-153
7-153
8-153
9-153
10-153
11-153
12-153
1-154
2-154
3-154
4-154
5-154
6-154
7-154
8-154
9-154
10-154
11-154
12-154
1-155
2-155
3-155
4-155
5-155
6-155
7-155
8-155
9-155
10-155
11-155
12-155
1-156
2-156
3-156
4-156
5-156
6-156
7-156
8-156
9-156
10-156
11-156
12-156
1-157
2-157
3-157
4-157
5-157
6-157
7-157
8-157
9-157
10-157
11-157
12-157
1-158
2-158
3-158
4-158
5-158
6-158
7-158
8-158
9-158
10-158
11-158
12-158
1-159
2-159
3-159
4-159
5-159
6-159
7-159
8-159
9-159
10-159
11-159
12-159
1-160
2-160
3-160
4-160
5-160
6-160
7-160
8-160
9-160
10-160
11-160
12-160
1-161
2-161
3-161
4-161
5-161
6-161
7-161
8-161
9-161
10-161
11-161
12-161
1-162
2-162
3-162
4-162
5-162
6-162
7-162
8-162
9-162
10-162
11-162
12-162
1-163
2-163
3-163
4-163
5-163
6-163
7-163
8-163
9-163
10-163
11-163
12-163
1-164
2-164
3-164
4-164
5-164
6-164
7-164
8-164
9-164
10-164
11-164
12-164
1-165
2-165
3-165
4-165
5-165
6-165
7-165
8-165
9-165
10-165
11-165
12-165
1-166
2-166
3-166
4-166
5-166
6-166
7-166
8-166
9-166
10-166
11-166
12-166
1-167
2-167
3-167
4-167
5-167
6-167
7-167
8-167
9-167
10-167
11-167
12-167
1-168
2-168
3-168
4-168
5-168
6-168
7-168
8-168
9-168
10-168
11-168
12-168
1-169
2-169
3-169
4-169
5-169
6-169
7-169
8-169
9-169
10-169
11-169
12-169
1-170
2-170
3-170
4-170
5-170
6-170
7-170
8-170
9-170
10-170
11-170
12-170
1-171
2-171
3-171
4-171
5-171
6-171
7-171
8-171
9-171
10-171
11-171
12-171
1-172
2-172
3-172
4-172
5-172
6-172
7-172
8-172
9-172
10-172
11-172
12-172
1-173
2-173
3-173
4-173
5-173
6-173
7-173
8-173
9-173
10-173
11-173
12-173
1-174
2-174
3-174
4-174
5-174
6-174
7-174
8-174
9-174
10-174
11-174
12-174
1-175
2-175
3-175
4-175
5-175
6-175
7-175
8-175
9-175
10-175
11-175
12-175
1-176
2-176
3-176
4-176
5-176
6-176
7-176
8-176
9-176
10-176
11-176
12-176
1-177
2-177
3-177
4-177
5-177
6-177
7-177
8-177
9-177
10-177
11-177
12-177
1-178
2-178
3-178
4-178
5-178
6-178
7-178
8-178
9-178
10-178
11-178
12-178
1-179
2-179
3-179
4-179
5-179
6-179
7-179
8-179
9-179
10-179
11-179
12-179
1-180
2-180
3-180
4-180
5-180
6-180
7-180
8-180
9-180
10-180
11-180
12-180
1-181
2-181
3-181
4-181
5-181
6-181
7-181
8-181
9-181
10-181
11-181
12-181
1-182
2-182
3-182
4-182
5-182
6-182
7-182
8-182
9-182
10-182
11-182
12-182
1-183
2-183
3-183
4-183
5-183
6-183
7-183
8-183
9-183
10-183
11-183
12-183
1-184
2-184
3-184
4-184
5-184
6-184
7-184
8-184
9-184
10-184
11-184
12-184
1-185
2-185
3-185
4-185
5-185
6-185
7-185
8-185
9-185
10-185
11-185
12-185
1-186
2-186
3-186
4-186
5-186
6-186
7-186
8-186
9-186
10-186
11-186
12-186
1-187
2-187
3-187
4-187
5-187
6-187
7-187
8-187
9-187
10-187
11-187
12-187
1-188
2-188
3-188
4-188
5-188
6-188
7-188
8-188
9-188
10-188
11-188
12-188
1-189
2-189
3-189
4-189
5-189
6-189
7-189
8-189
9-189
10-189
11-189
12-189
1-190
2-190
3-190
4-190
5-190
6-190
7-190
8-190
9-190
10-190
11-190
12-190
1-191
2-191
3-191
4-191
5-191
6-191
7-191
8-191
9-191
10-191
11-191
12-191
1-192
2-192
3-192
4-192
5-192
6-192
7-192
8-192
9-192
10-192
11-192
12-192
1-193
2-193
3-193
4-193
5-193
6-193
7-193
8-193
9-193
10-193
11-193
12-193
1-194
2-194
3-194
4-194
5-194
6-194
7-194
8-194
9-194
10-194
11-194
12-194
1-195
2-195
3-195
4-195
5-195
6-195
7-195
8-195
9-195
10-195
11-195
12-195
1-196
2-196
3-196
4-196
5-196
6-196
7-196
8-196
9-196
10-196
11-196
12-196
1-197
2-197
3-197
4-197
5-197
6-197
7-197
8-197
9-197
10-197
11-197
12-197
1-198
2-198
3-198
4-198
5-198
6-198
7-198
8-198
9-198
10-198
11-198
12-198
1-199
2-199
3-199
4-199
5-199
6-199
7-199
8-199
9-199
10-199
11-199
12-199
1-200
2-200
3-200
4-200
5-200
6-200
7-200
8-200
9-200
10-200
11-200
12-200
1-201
2-201
3-201
4-201
5-201
6-201
7-201
8-201
9-201
10-201
11-201
12-201
1-202
2-202
3-202
4-202
5-202
6-202
7-202
8-202
9-202
10-202
11-202
12-202
1-203
2-203
3-203
4-203
5-203
6-203
7-203
8-203
9-203
10-203
11-203
12-203
1-204
2-204
3-204
4-204
5-204
6-204
7-204
8-204
9-204
10-204
11-204
12-204
1-205
2-205
3-205
4-205
5-205
6-205
7-205
8-205
9-205
10-205
11-205
12-205
1-206
2-206
3-206
4-206
5-206
6-206
7-206
8-206
9-206
10-206
11-206
12-206
1-207
2-207
3-207
4-207
5-207
6-20

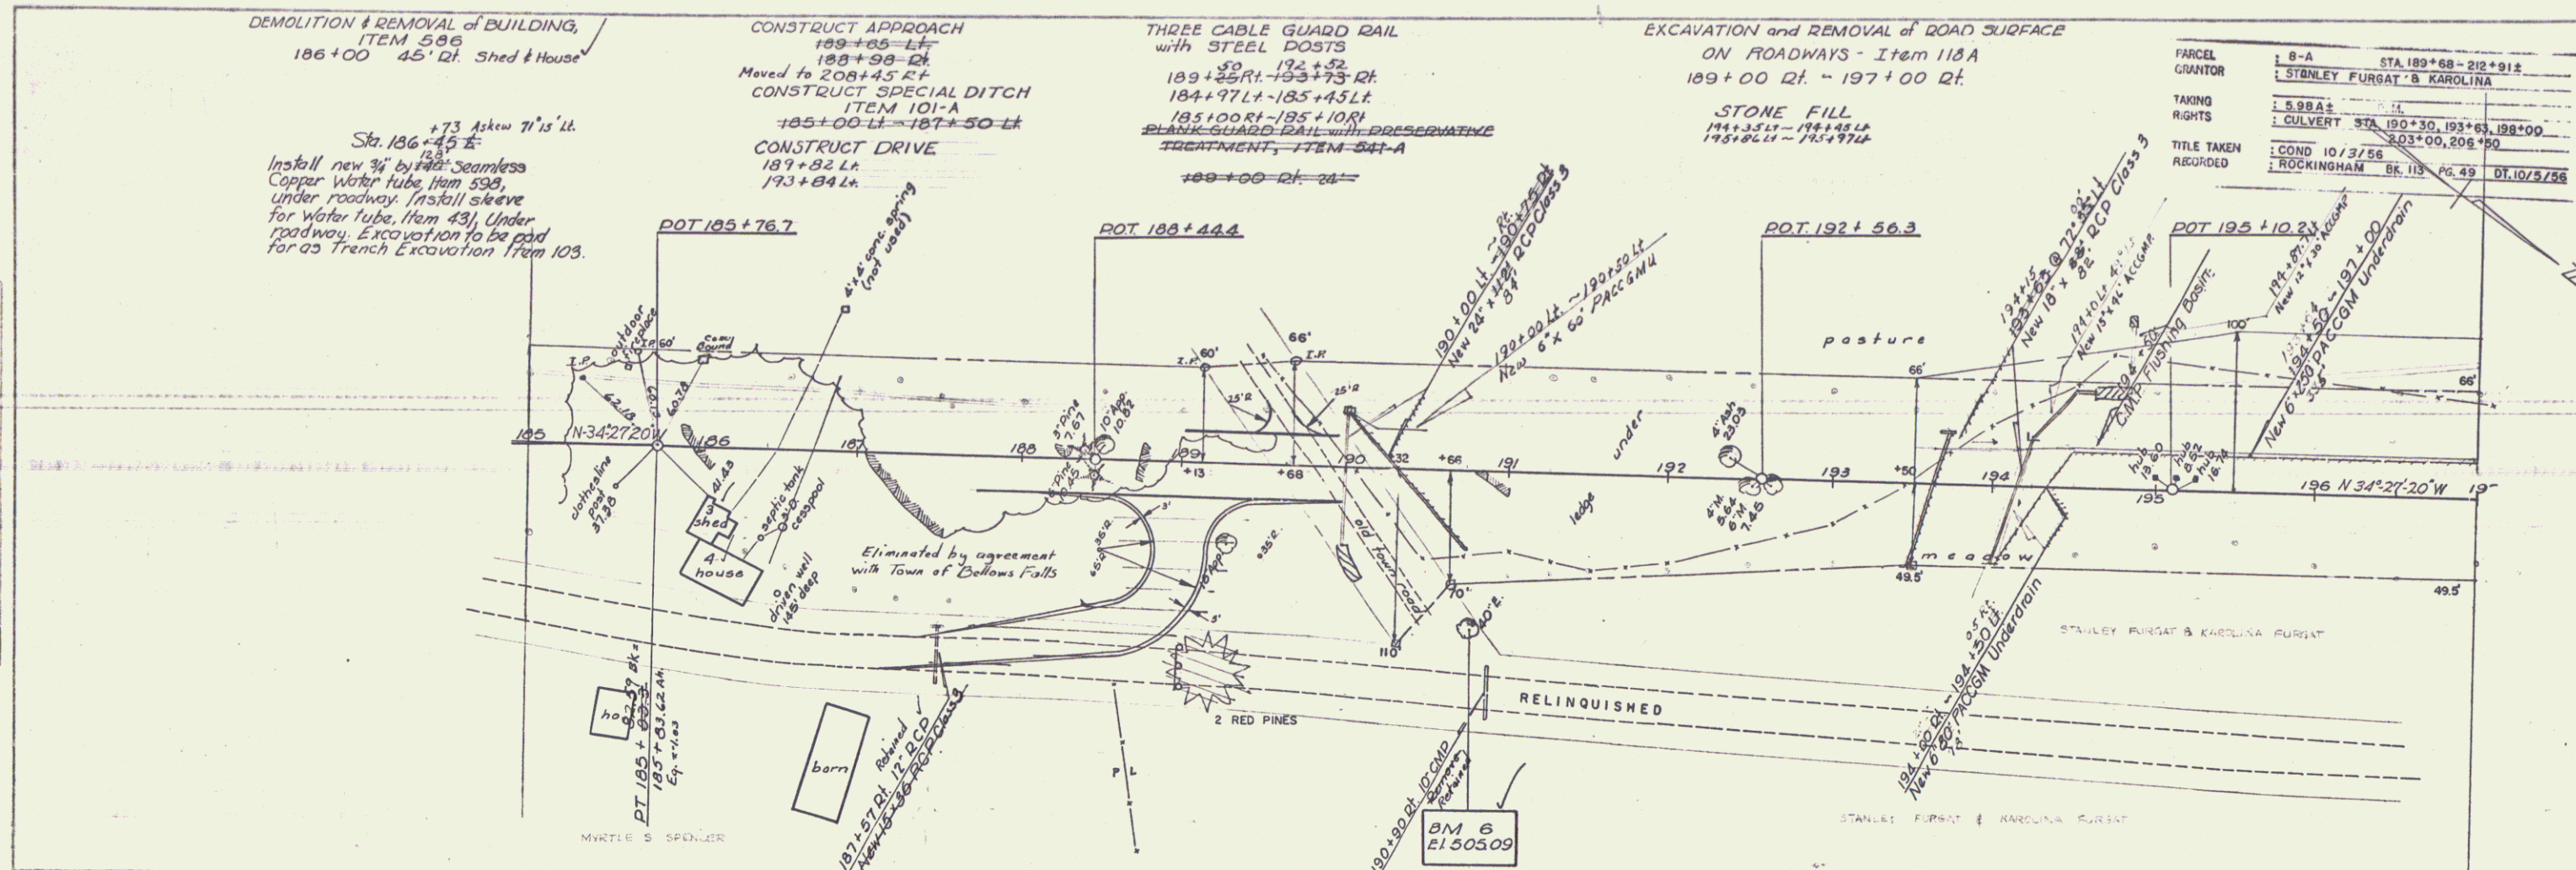


PARCEL	7	STA. 184+65-190+32
GRANTOR	MYRTLE S. SPENCER	
TAKING RIGHTS	1.65 A ±	REM.
TITLE TAKEN RECORDED	WD 5/20/58	ROCKINGHAM BK. 113 PG. 418 DT. 5/28/58

THE SECTION OF HIGHWAY, BEGINNING AT A POINT IN THE CENTER OF FORMER VERMONT ROUTE 103, ± 975 FEET SOUTHEASTERLY FROM ITS INTERSECTION WITH TOWN ROAD NO. 31, AND 58 FEET RIGHT OR NORTHEASTERLY OF STA. 174+00 OF HIGHWAY PROJECT-ROCKINGHAM F 025-1(1); THENCE CONTINUING ± 0.872 MILE NORTHEASTERLY TO A POINT IN THE CENTER OF SAID FORMER HIGHWAY, 50 FEET RIGHT OR NORTHEASTERLY FROM STA. 209+50 OF SAID HIGHWAY PROJECT, IS HEREBY RELINQUISHED AND RETURNED TO THE TOWN OF ROCKINGHAM AND RECORDED IN BOOK 113, PAGE 208 OF LAND RECORDS OF THE TOWN OF ROCKINGHAM, DECEMBER 13, 1963.

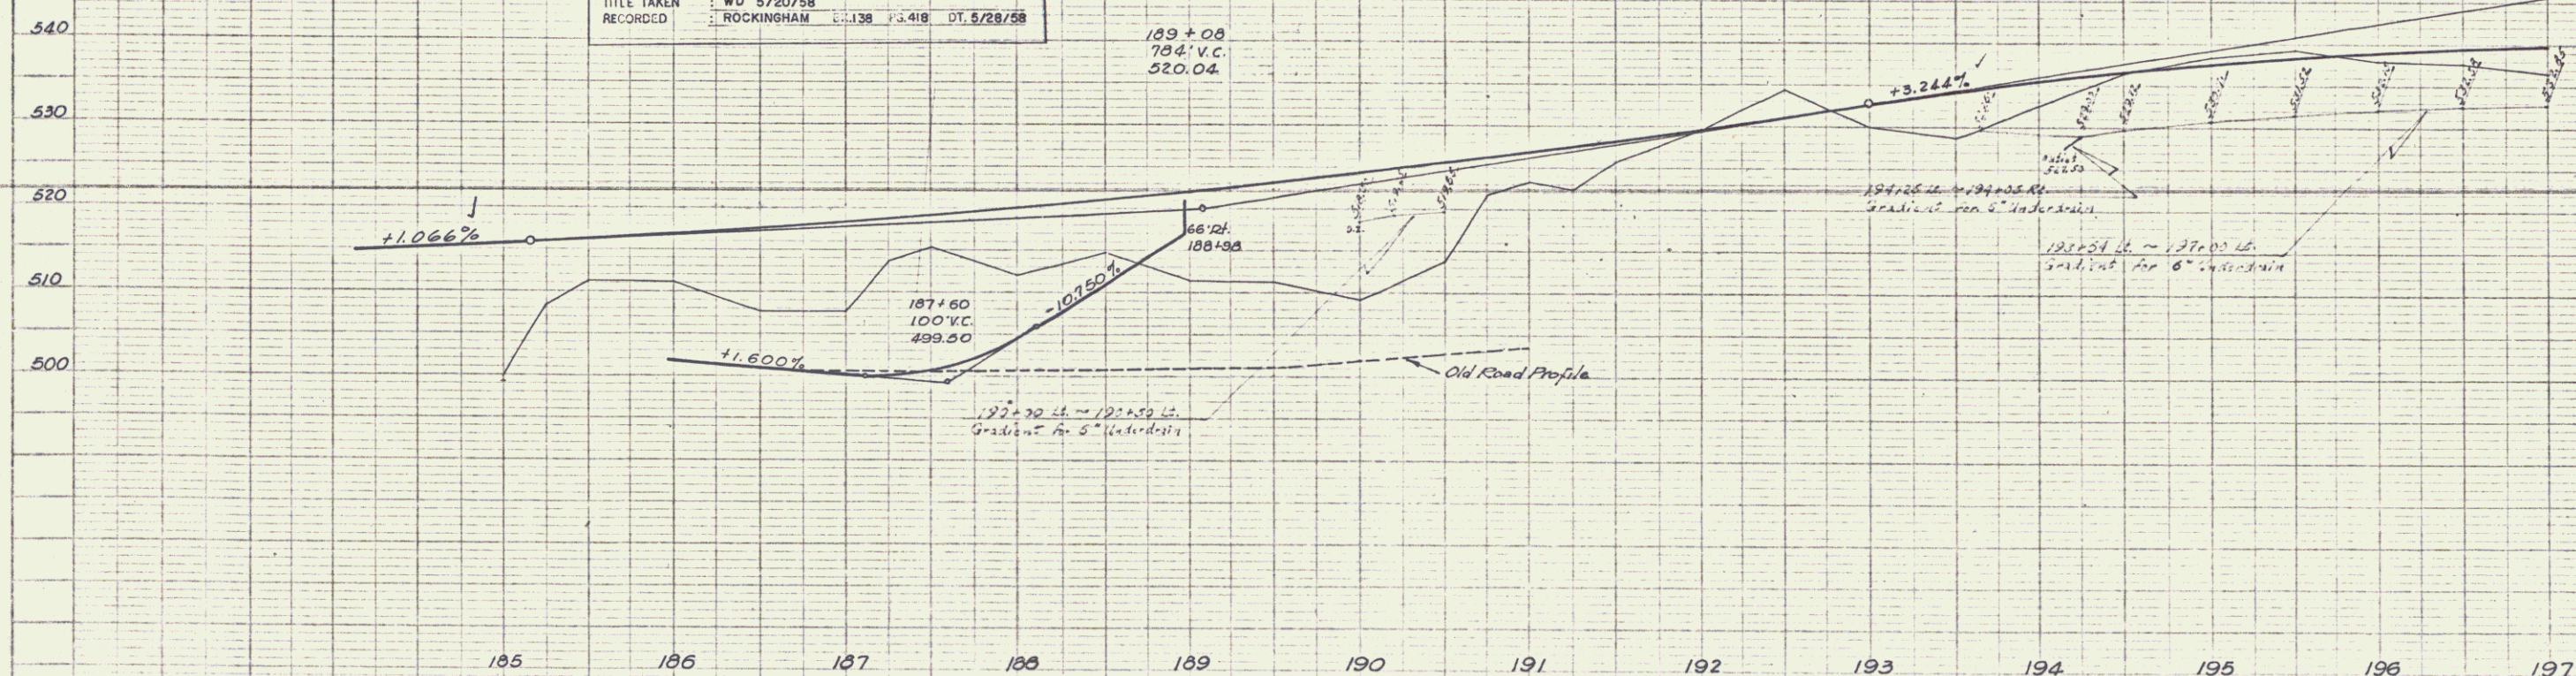

ROCKINGHAM
F 025-1(1)
Sheet 8 of 33

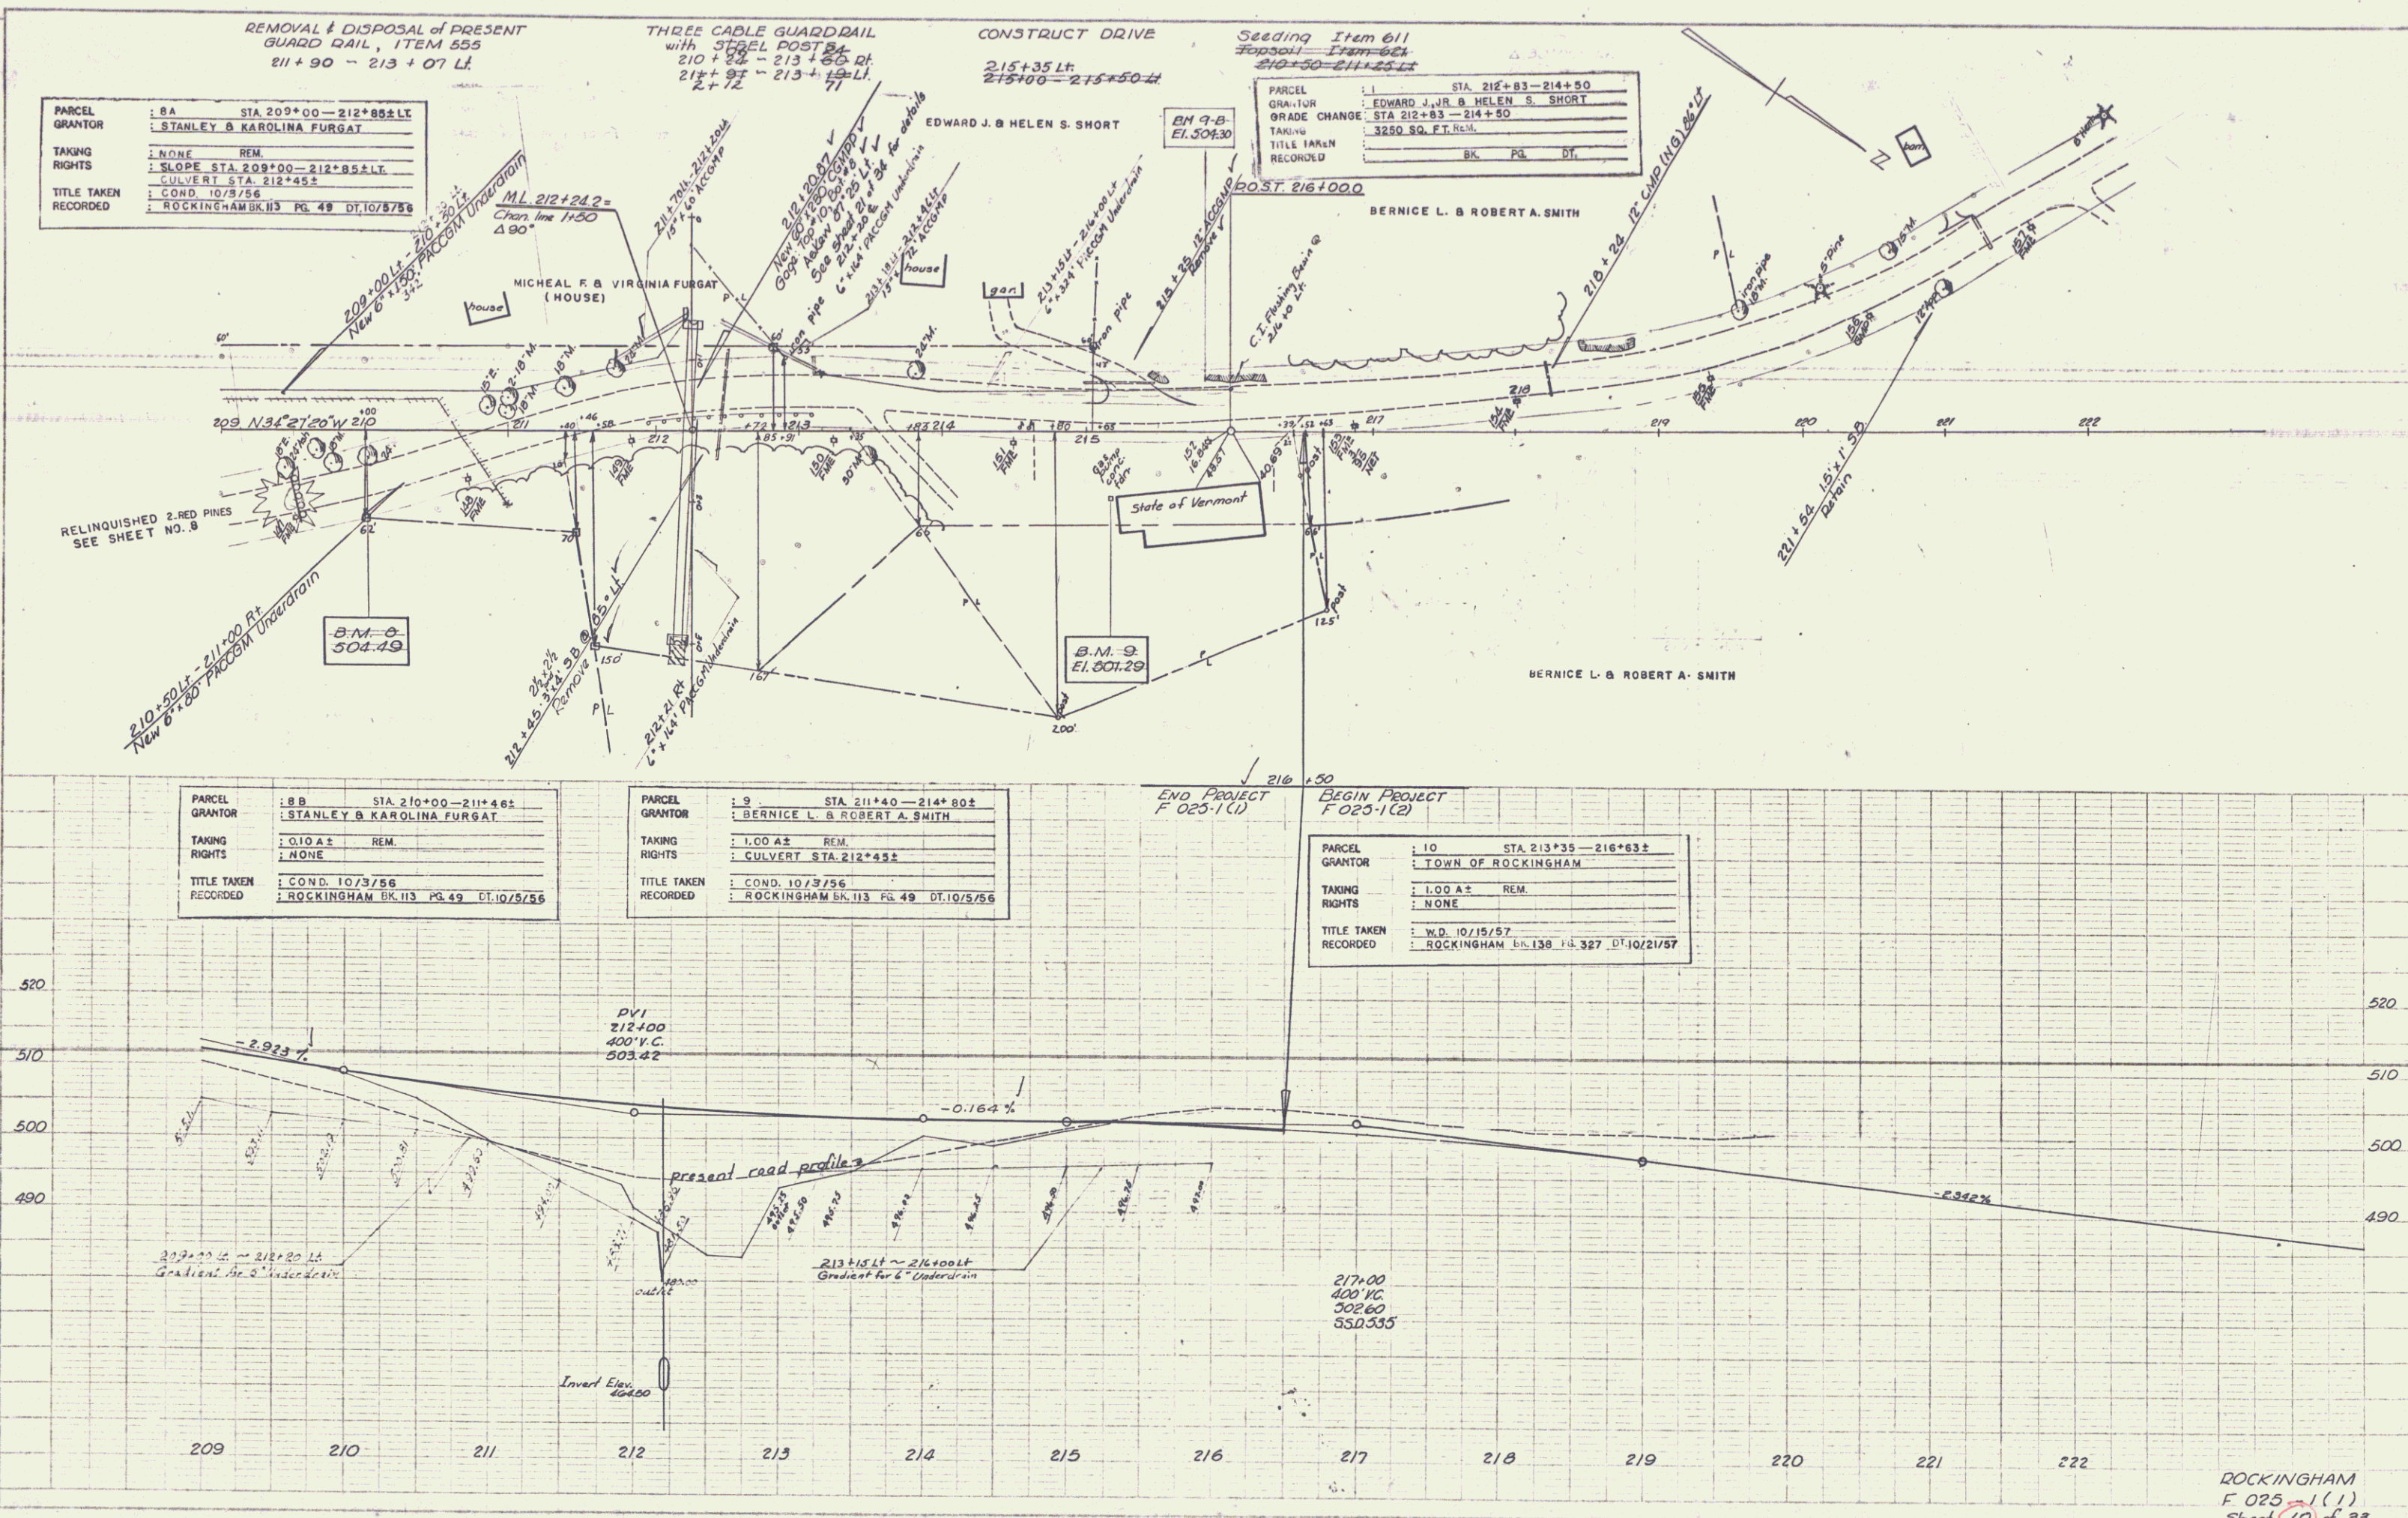

PARCEL	1: 8A	STA 209+00 - 212+85± LT
GRANTOR	1: STANLEY & KAROLINA FURGAT	
TAKING	1: NONE	REM.
RIGHTS	1: SLOPE STA 209+00 - 212+85± LT	
	1: CULVERT STA 212+45±	
TITLE TAKEN	1: COND. 10/3/56	
RECORDED	1: ROCKINGHAM BK. 113 PG. 49 DT. 10/5/56	

THREE CABLE GUARDRAIL
with 3" STEEL POST 84
210+84 - 213+88 Lt
212+12

CONSTRUCT DRIVE
215+35 Lt
215+00 - 215+50 Lt

Seeding Item 611
#0501 - Item 624
210+50 - 211+25 Lt

PARCEL	1: 1	STA 212+83 - 214+50
GRANTOR	1: EDWARD J. & HELEN S. SHORT	
TAKING	1: GRADE CHANGE STA 212+83 - 214+50	
RIGHTS	1: 3250 SQ. FT. N.E.M.	
TITLE TAKEN	1: NONE	
RECORDED	1: BK. PG. DT.	

PARCEL	1: 8B	STA 210+00 - 211+46±
GRANTOR	1: STANLEY & KAROLINA FURGAT	
TAKING	1: 0.10 A±	REM.
RIGHTS	1: NONE	
TITLE TAKEN	1: COND. 10/3/56	
RECORDED	1: ROCKINGHAM BK. 113 PG. 49 DT. 10/5/56	

PARCEL	1: 9	STA 211+40 - 214+80±
GRANTOR	1: BERNICE L. & ROBERT A. SMITH	
TAKING	1: 1.00 A±	REM.
RIGHTS	1: CULVERT STA 212+45±	
TITLE TAKEN	1: COND. 10/3/56	
RECORDED	1: ROCKINGHAM BK. 113 PG. 49 DT. 10/5/56	

PARCEL	1: 10	STA 213+35 - 216+63±
GRANTOR	1: TOWN OF ROCKINGHAM	
TAKING	1: 1.00 A±	REM.
RIGHTS	1: NONE	
TITLE TAKEN	1: W.D. 10/15/57	
RECORDED	1: ROCKINGHAM BK. 138 PG. 327 DT. 10/21/57	

ROCKINGHAM
F 025-1(1)
Sheet 10 of 33