


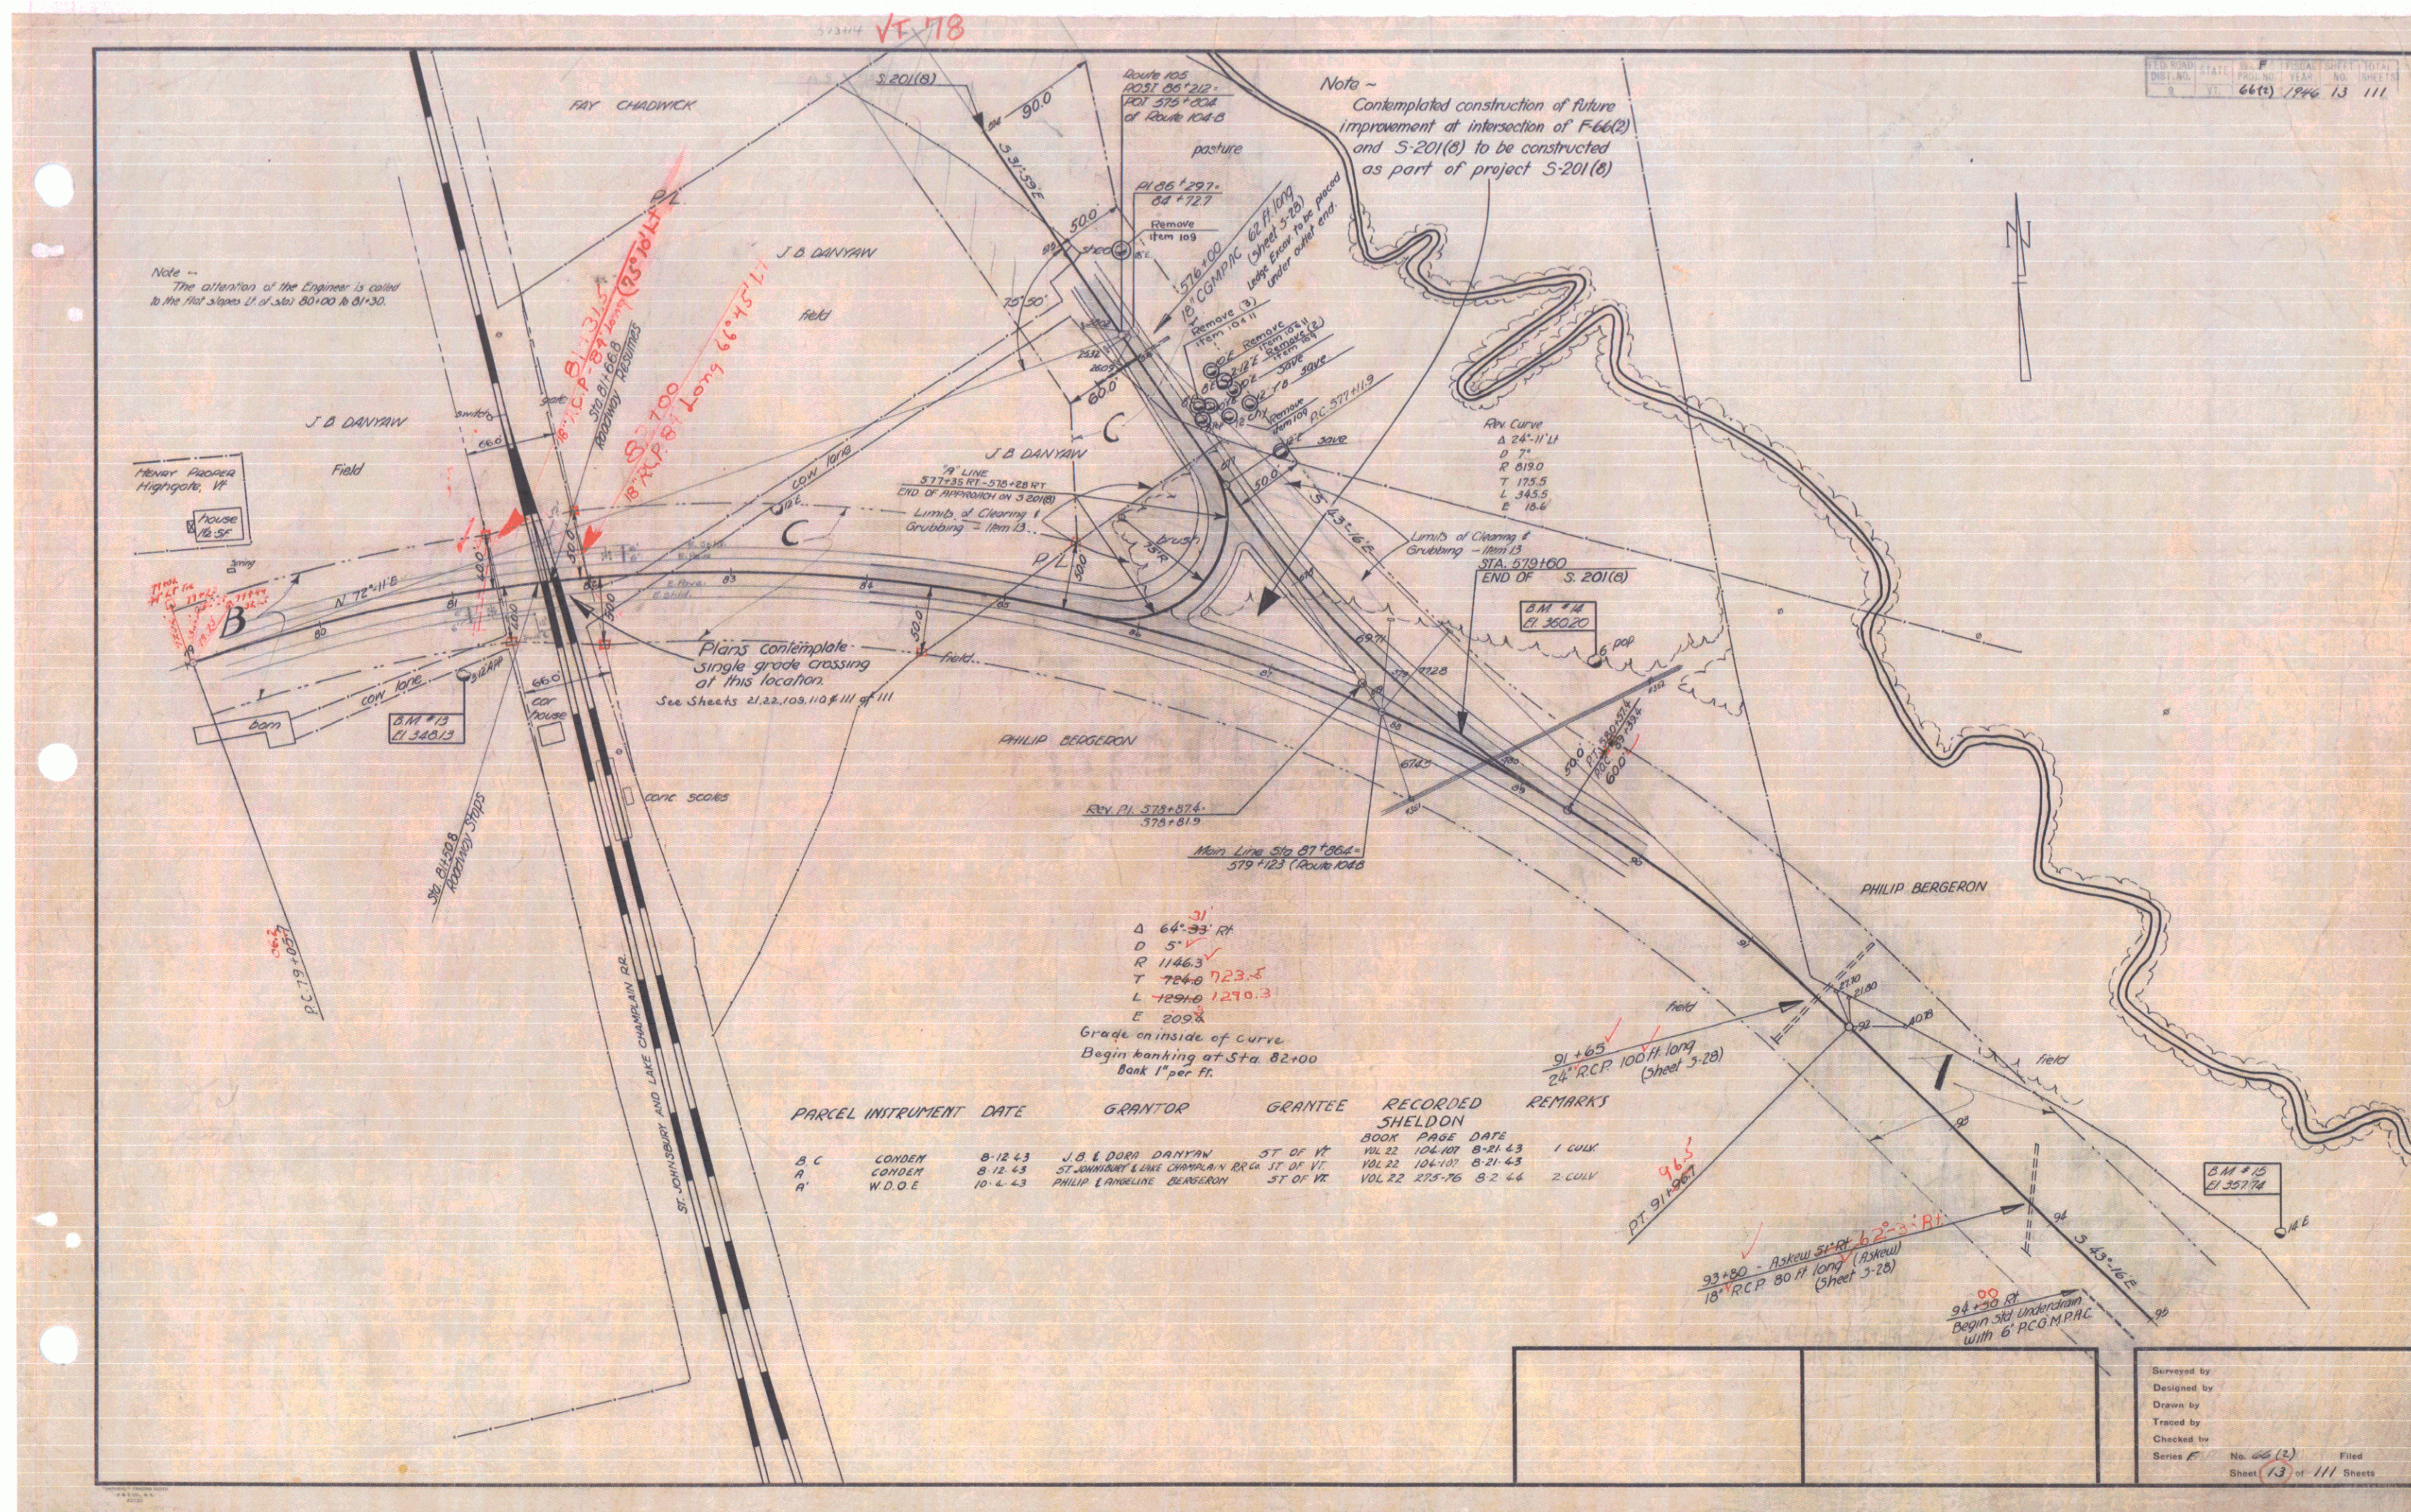

Note -
The attention of the Engineer is called
to the flat slopes of Sta 50+00 to 51+00.

Note -
Contemplated construction of future
improvement at intersection of F-66(2)
and S-201(6) to be constructed
as part of project S-201(6)

Plans contemplate
single grade crossing
at this location.
See Sheets 21.22.109.110 & 111 of 111

Δ 64'-33" RT
D 5' ✓
R 1146.3 ✓
T 724-0 723.5
L 1294-0 1290.3
E 209.4
Grade on inside of curve.
Begin banking at Sta. 82+00
Bank 1" per ft.

PARCEL INSTRUMENT	DATE	GRANTOR	GRANTEE	RECORDED	REMARKS
B, C	CONDEN	8-12-43	J. B. & DORA DANYAN	ST OF VT	
A	CONDEN	8-12-43	ST. JOHNSBURY & LAKE CHARLEMAN DR	ST OF VT	
A'	W.D.O.E	10-4-43	PHILIP & ANGELINE BERGERON	ST OF VT	

BOOK	PAGE	DATE
VOL 22	104-107	8-21-43
VOL 22	104-107	8-21-43
VOL 22	275-76	8-2-44

Surveyed by
Designed by
Drawn by
Traced by
Checked by
Series No. 465 (2) Filed
Sheet 73 of 111 Sheets