

INDEX OF SHEETS	
SHEET NO	TITLE PAGE
1	TITLE PAGE
2	TYPICAL CROSS SECTION OF IMPROVEMENT
3	STANDARD STRUCTURE SHEET (STABILIZED GRAVEL BASE COURSE OF HIGHWAY)
4	QUANTITY SHEET (11045)
5-4	QUANTITY SHEET (11045)
7-27	PLAN AND PROFILE SHEETS
28	DETAILS OF ADJUTMENT NO. 1 APPROACH 5486
29	DETAILS OF ADJUTMENT NO. 2 APPROACH 5487
30	DETAILS OF 12" CORR. 47942
31	DETAILS OF 8" CORR. 47943
32	DETAILS OF 8" CORR. 47943
33	DETAILS OF 8" CORR. 51340
34	DETAILS OF ADJUTMENT NO. 1 APPROACH 5486
35	DETAILS OF ADJUTMENT NO. 2 APPROACH 5487
36	REINFORCING STEEL SCHEDULE 5486-5487
37	STANDARD STRUCTURE SHEET (DRAINAGE AND MARKERS)
38	STANDARD STRUCTURE SHEET (DRAINAGE AND MARKERS)
39	STANDARD STRUCTURE SHEET (DRAINAGE AND MARKERS)
40	STANDARD STRUCTURE SHEET (DRAINAGE AND MARKERS)
41	STANDARD STRUCTURE SHEET (DRAINAGE AND MARKERS)
42	STANDARD STRUCTURE SHEET (DRAINAGE AND MARKERS)
43	STANDARD STRUCTURE SHEET (DRAINAGE AND MARKERS)
44	STANDARD STRUCTURE SHEET (DRAINAGE AND MARKERS)
45	STANDARD STRUCTURE SHEET (DRAINAGE AND MARKERS)
46	STANDARD STRUCTURE SHEET (DRAINAGE AND MARKERS)
47	STANDARD STRUCTURE SHEET (DRAINAGE AND MARKERS)
48-154	CROSS SECTIONS
155-163	12" CORR. PIPE STRUCTURE SECTIONS
164-165	CORR. PIPE SECTIONS
166-170	EMBANKMENT SECTIONS


STANDARD STRUCTURE SHEET APPROVED BY THE CHIEF ENGINEER, VERMONT STATE DEPARTMENT OF HIGHWAYS
5-40 JUNE 10, 1950

(To Be Returned To R.O.W. Division)

RECEIVED
TOWN OF JAY
RIGHT-OF-WAY DIVISION

PROJECT JAY
ROUTE F 137(4)
TYPE STABILIZED GRAVEL COURSE
CONTRACTOR CHARTER ONE CONST. CO., INC.
LOCATION INTERSECT. ROAD
BEGINNING AT A POINT ON THE STATE ROAD
BEYOND NORTH TROY AND EAST RICHFORD VIA JAY
JAY TOWN LINE AND EXTENDING WESTERLY 19,859.4 FT.

PROJECT NAME & NUMBER	TYPE	PAVEMENT AREA
JAY F137(4)	STABILIZED GRAVEL	51,740 S.Y.
RECORD PLANS		
MATERIALS		
SUB-BASE OF GRAVEL-DIPLOMAT, E. RICHFORD, VT.	REINFORCING STEEL-Vermont Structural Steel Co., Burlington, VT.	
SUB-BASE OF CRUSHED GRAVEL-Stormville, VT.	STRUCTURAL STEEL-Vermont Structural Steel Co., Burlington, VT.	
GUTBACK ASPHALT-Princeton, Vermont, Mass.	ACCOMP-NE Metal Pipe Co., Palmer, Mass.	
PEA-STONE FOR SEAL-Idem Mine, Eden, VT.	ACCOMP-NE Metal Pipe Co., Palmer, Mass.	
SAND FOR SEAL-Cooking, VT.	ACCOMP-NE Metal Pipe Co., Palmer, Mass.	
CEMENT-Idem, VT.	ACCOMP-NE Metal Pipe Co., Palmer, Mass.	
COURSE AGGR. FOR CONCRETE-Idem, VT.	CABLE FOR GUARD RAIL-American Wire Co.	
CONTRACTOR-CHARTER ONE CONSTRUCTION CO., INC.	GUARD RAIL PAINT-Brown Chemicals, Ltd., New York, N.Y.	
RESIDENT ENGINEER-H. E. August	CONTRACT DATED-JUL 8, 1953	
INSPECTORS-NE Metal Pipe Co., Palmer, Mass.	CONTRACT STARTED-OCT 12, 1953	
RECORD PLANS-Idem, VT.	CONTRACT COMPLETED-OCT 16, 1956	
	CONTRACT ACCEPTED-OCT 17, 1956	

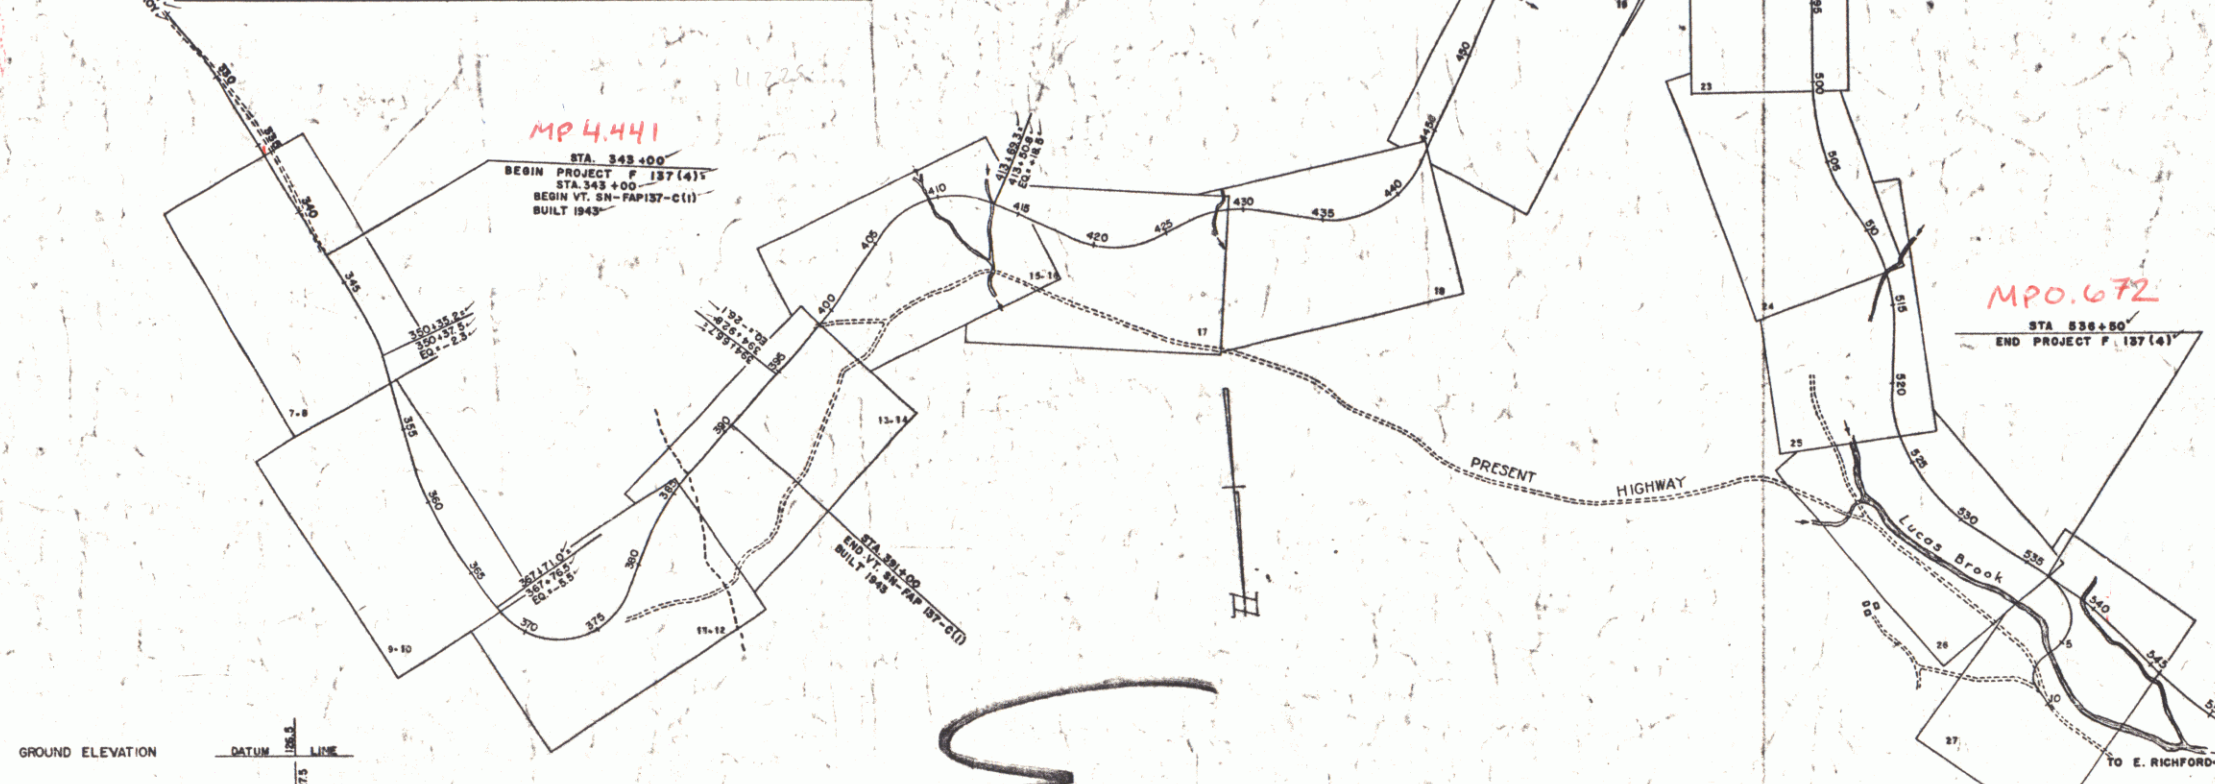

GROUND ELEVATION	DATUM	LINE
GRADE ELEVATION	DATUM	LINE
CURVE DATA		
DEFLECTION OF ANGLE	A	
DEGREE OF CURVE	D	
RADIUS OF CURVE	R	
TANGENT DISTANCE	T	
LENGTH OF CURVE	L	
EXTERNAL DISTANCE	E	
POINT OF INTERSECTION	P.I.	
POINT OF CURVE	P.C.	
POINT OF TANGENT	P.T.	
POINT ON TANGENT	P.O.T.	
POINT ON SUB-TANGENT	P.O.S.T.	


SCALES
TITLE 1" = 600'
TYPICAL 1" = 2'
PLAN 1" = 50'
PROFILE HORIZONTAL 1" = 50'
PROFILE VERTICAL 1" = 10'
CROSS-SECTIONS 1" = 5' & 10'

STATE OF VERMONT DEPARTMENT OF HIGHWAYS Proposed Improvement TOWN OF JAY COUNTY OF ORLEANS

NORTH TROY-JAY MOUNTAIN-EAST RICHFORD ROAD

BEGINNING AT A POINT ON THE STATE ROAD BETWEEN NORTH TROY AND EAST RICHFORD VIA JAY MOUNTAIN; SAID POINT BEING 4.34 MILES WEST OF THE TROY-JAY TOWN LINE AND EXTENDING WESTERLY 19,859.4 FEET.

LENGTH OF PROJECT 19,859.4 FT=3.761 MILES

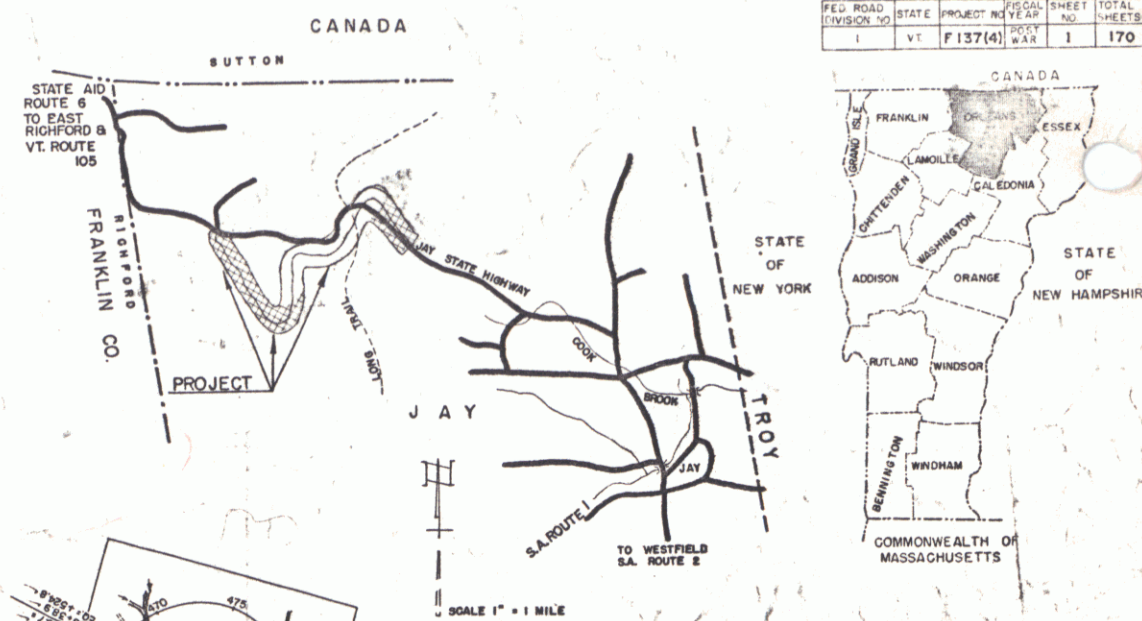

NOTE: ANY FURTHER INFORMATION CONCERNING FINAL QUANTITIES, AMOUNTS OR OTHER DETAILS RELATIVE TO THIS PROJECT MAY BE FOUND IN EITHER THE FIELD BOOKS OR THE ESTIMATE FILE.

Route VT 105

Pin # 00R165


DEPARTMENT OF COMMERCE
BUREAU OF PUBLIC ROADS

APPROVED: [Signature]
DISTRICT ENGINEER DATE

APPROVED [Signature] CONSTRUCTION ENGINEER DATE Aug 12 1953	APPROVED [Signature] BRIDGE ENGINEER DATE AUG 19 1953	APPROVED [Signature] DISTRICT ENGINEER DATE Aug 24 1953	APPROVED [Signature] SUPERVISOR DATE AUG 19 1953	APPROVED [Signature] CHIEF ENGINEER DATE AUG 20 1953 SUBMITTED BY ORDER OF THE STATE HIGHWAY BOARD	PROJECT F NO. 137(4) SHEET 1 OF SHEETS 170
---	---	---	--	---	---

PLAN	DATE	BY	CHKD
10/13/53	10/13/53	JAY	JAY
NOTE BOOK	DATE	BY	CHKD
10/13/53	10/13/53	JAY	JAY

PROFILE	DATE	BY	CHKD
10/13/53	10/13/53	JAY	JAY
NOTE BOOK	DATE	BY	CHKD
10/13/53	10/13/53	JAY	JAY

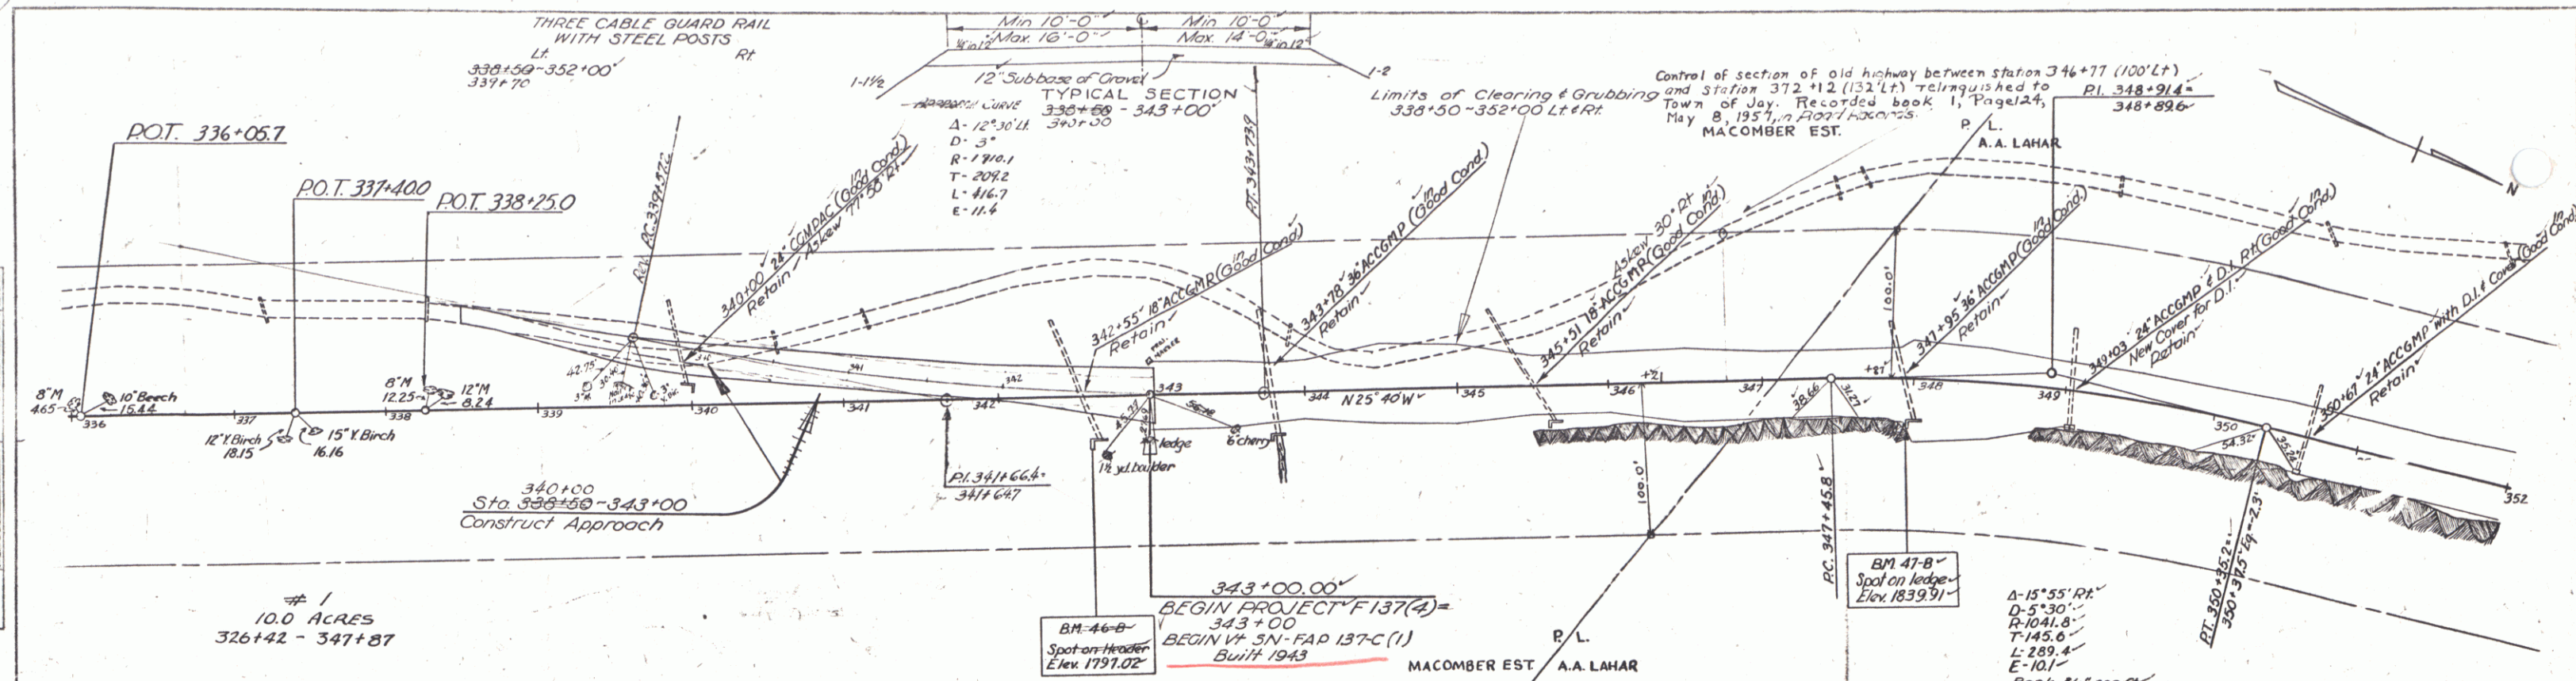


PARCEL	INSTRUMENT	DATE	GRANTOR	GRANTEE	RECORDED	BOOK	PAGE	DATE	REMARKS
#1	ADRIAN W.D.O.E.	9-3-41	A.A. MACOMBER	St of VT	JAY	13	2623	10-24-41	See SN-FAP 137C (1) 1942
			(ROBERT WELLS, ADRIAN)						
			HIGHWAY PROJECT F-137 (4) 1953						
See Remarks	Corps QCDDE	10-13-53	UNIVERSITY OF VT.	St of VT	JAY	13	320-322	11-7	RELEASE OF RIGHTS ON PARCELS 1, 2A, 2B, #3 & 4E # PART OF 4DRAF
			4 ST. AGRICULTURAL COLLEGE						LEASED LAND
									SEE ALSO SHEETS 9, 11, 13, 21, 26A


JAY
Proj F-137 (4)
Sheet 2 of 170

THREE CABLE GUARD RAIL
WITH STEEL POSTS Rt.
Lt. 352+00 - 360+00

FED. ROAD DIST. NO.	STATE	PROJ. NO.	FISCAL YEAR	SHEET NO.	TOTAL SHEETS
9	VT.				

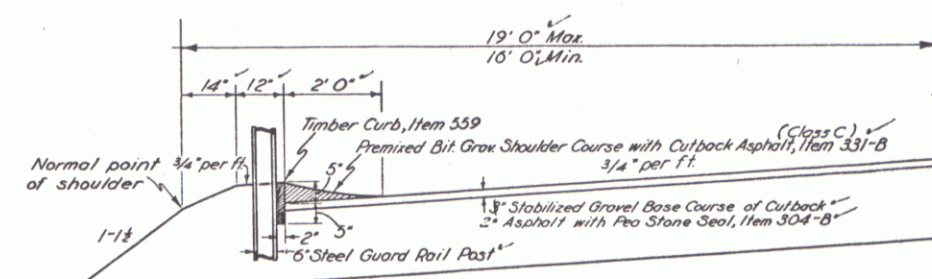


DETAIL OF
TIMBER CURB
& PREMIXED SHOULDER
355+95' - 379+10' Lt.
408+18' - 409+45' Rt.
409+01' - 414+50' Rt.
426+30' - 432+18' Rt.
452+54' - 457+28' Rt.
470+33' - 471+10' Rt.
512+41' - 513+18' Rt.

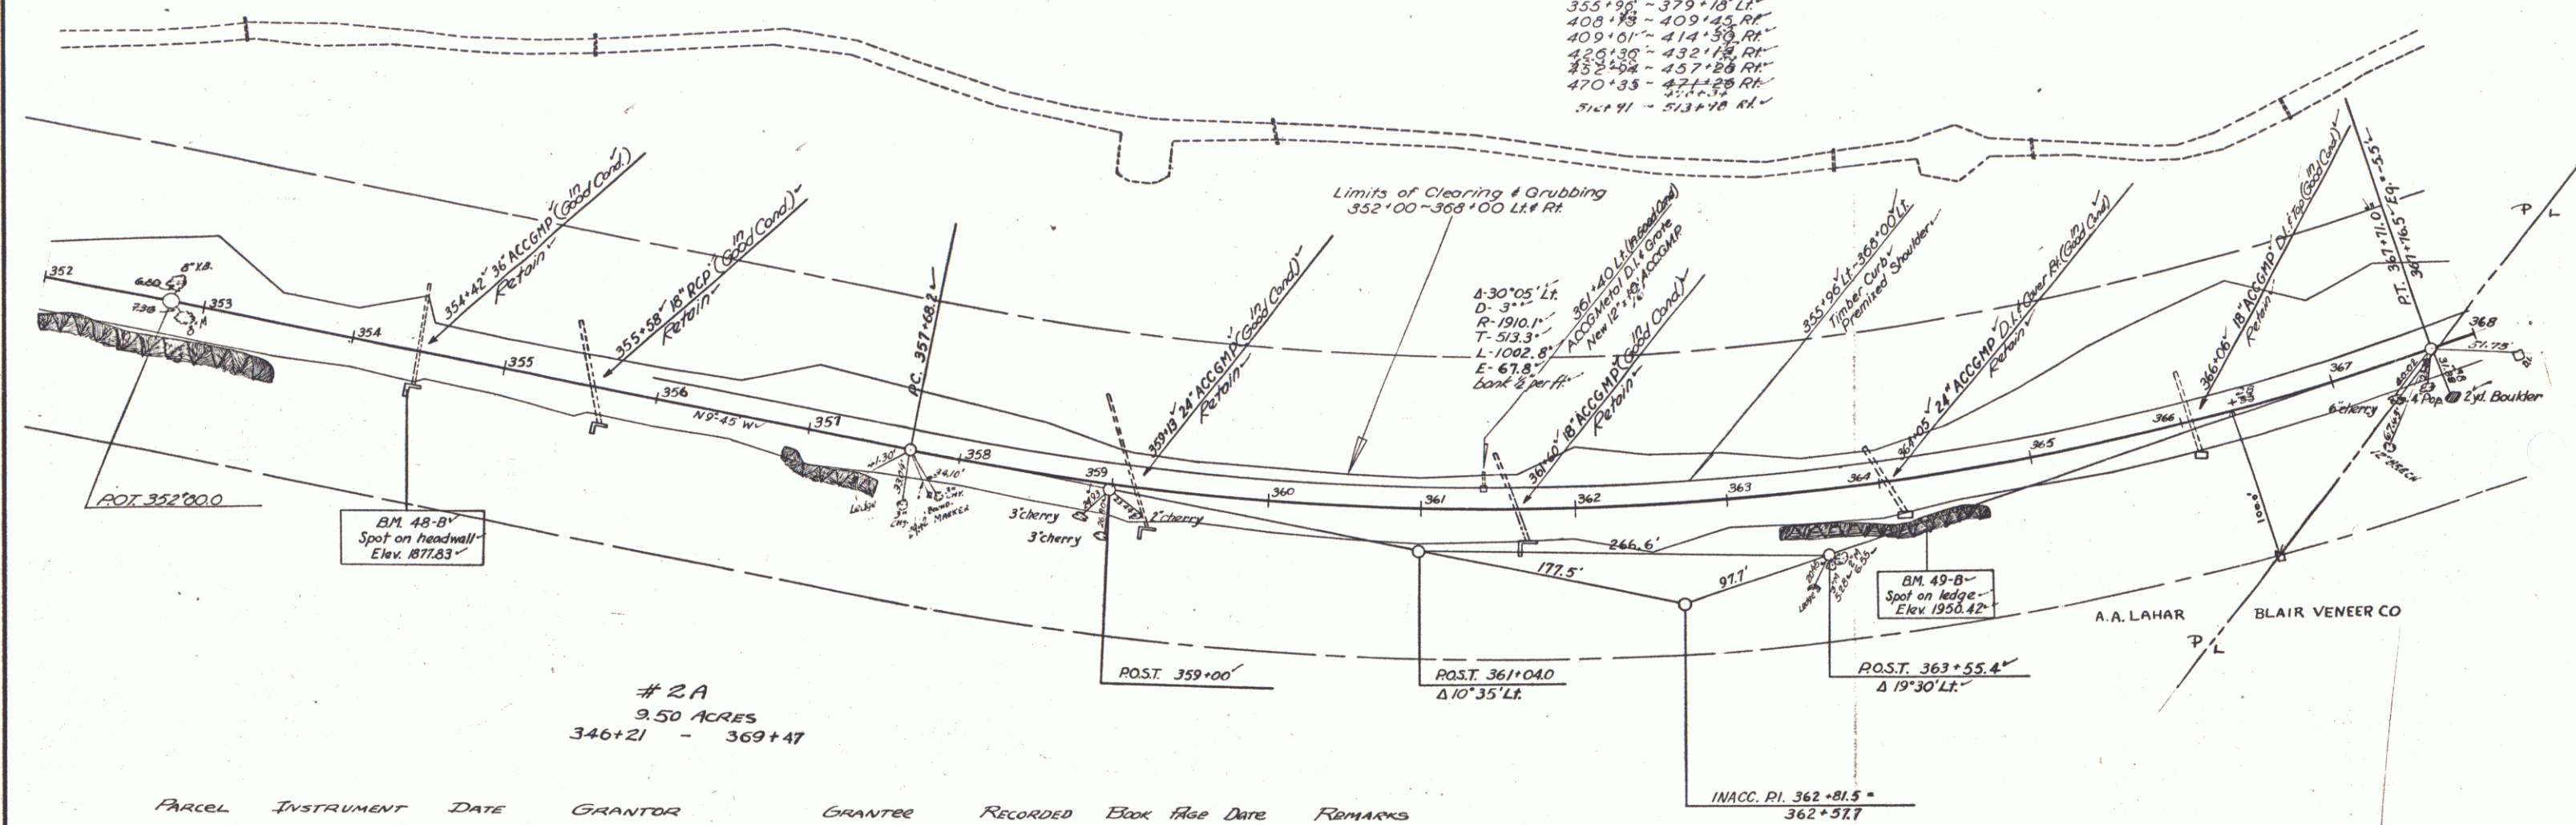


2A
9.50 ACRES
346+21 - 369+47

PARCEL	INSTRUMENT	DATE	GRANTOR	GRANTEE	RECORDED	BOOK	PAGE	DATE	REMARKS
2A	W.D.O.E.	8-25-41	ARTHUR A. LAHAR	SC. OF VT.	JAY	13	2389	10-24-41	See NS-FAP 137C(1) 1942


JAY
Surveyed by G. Lane
Designed by
Drawn by
Traced by R. Fraser
Checked by
Series F No. 137(4) Filed
Sheet 9 of 170 Sheets

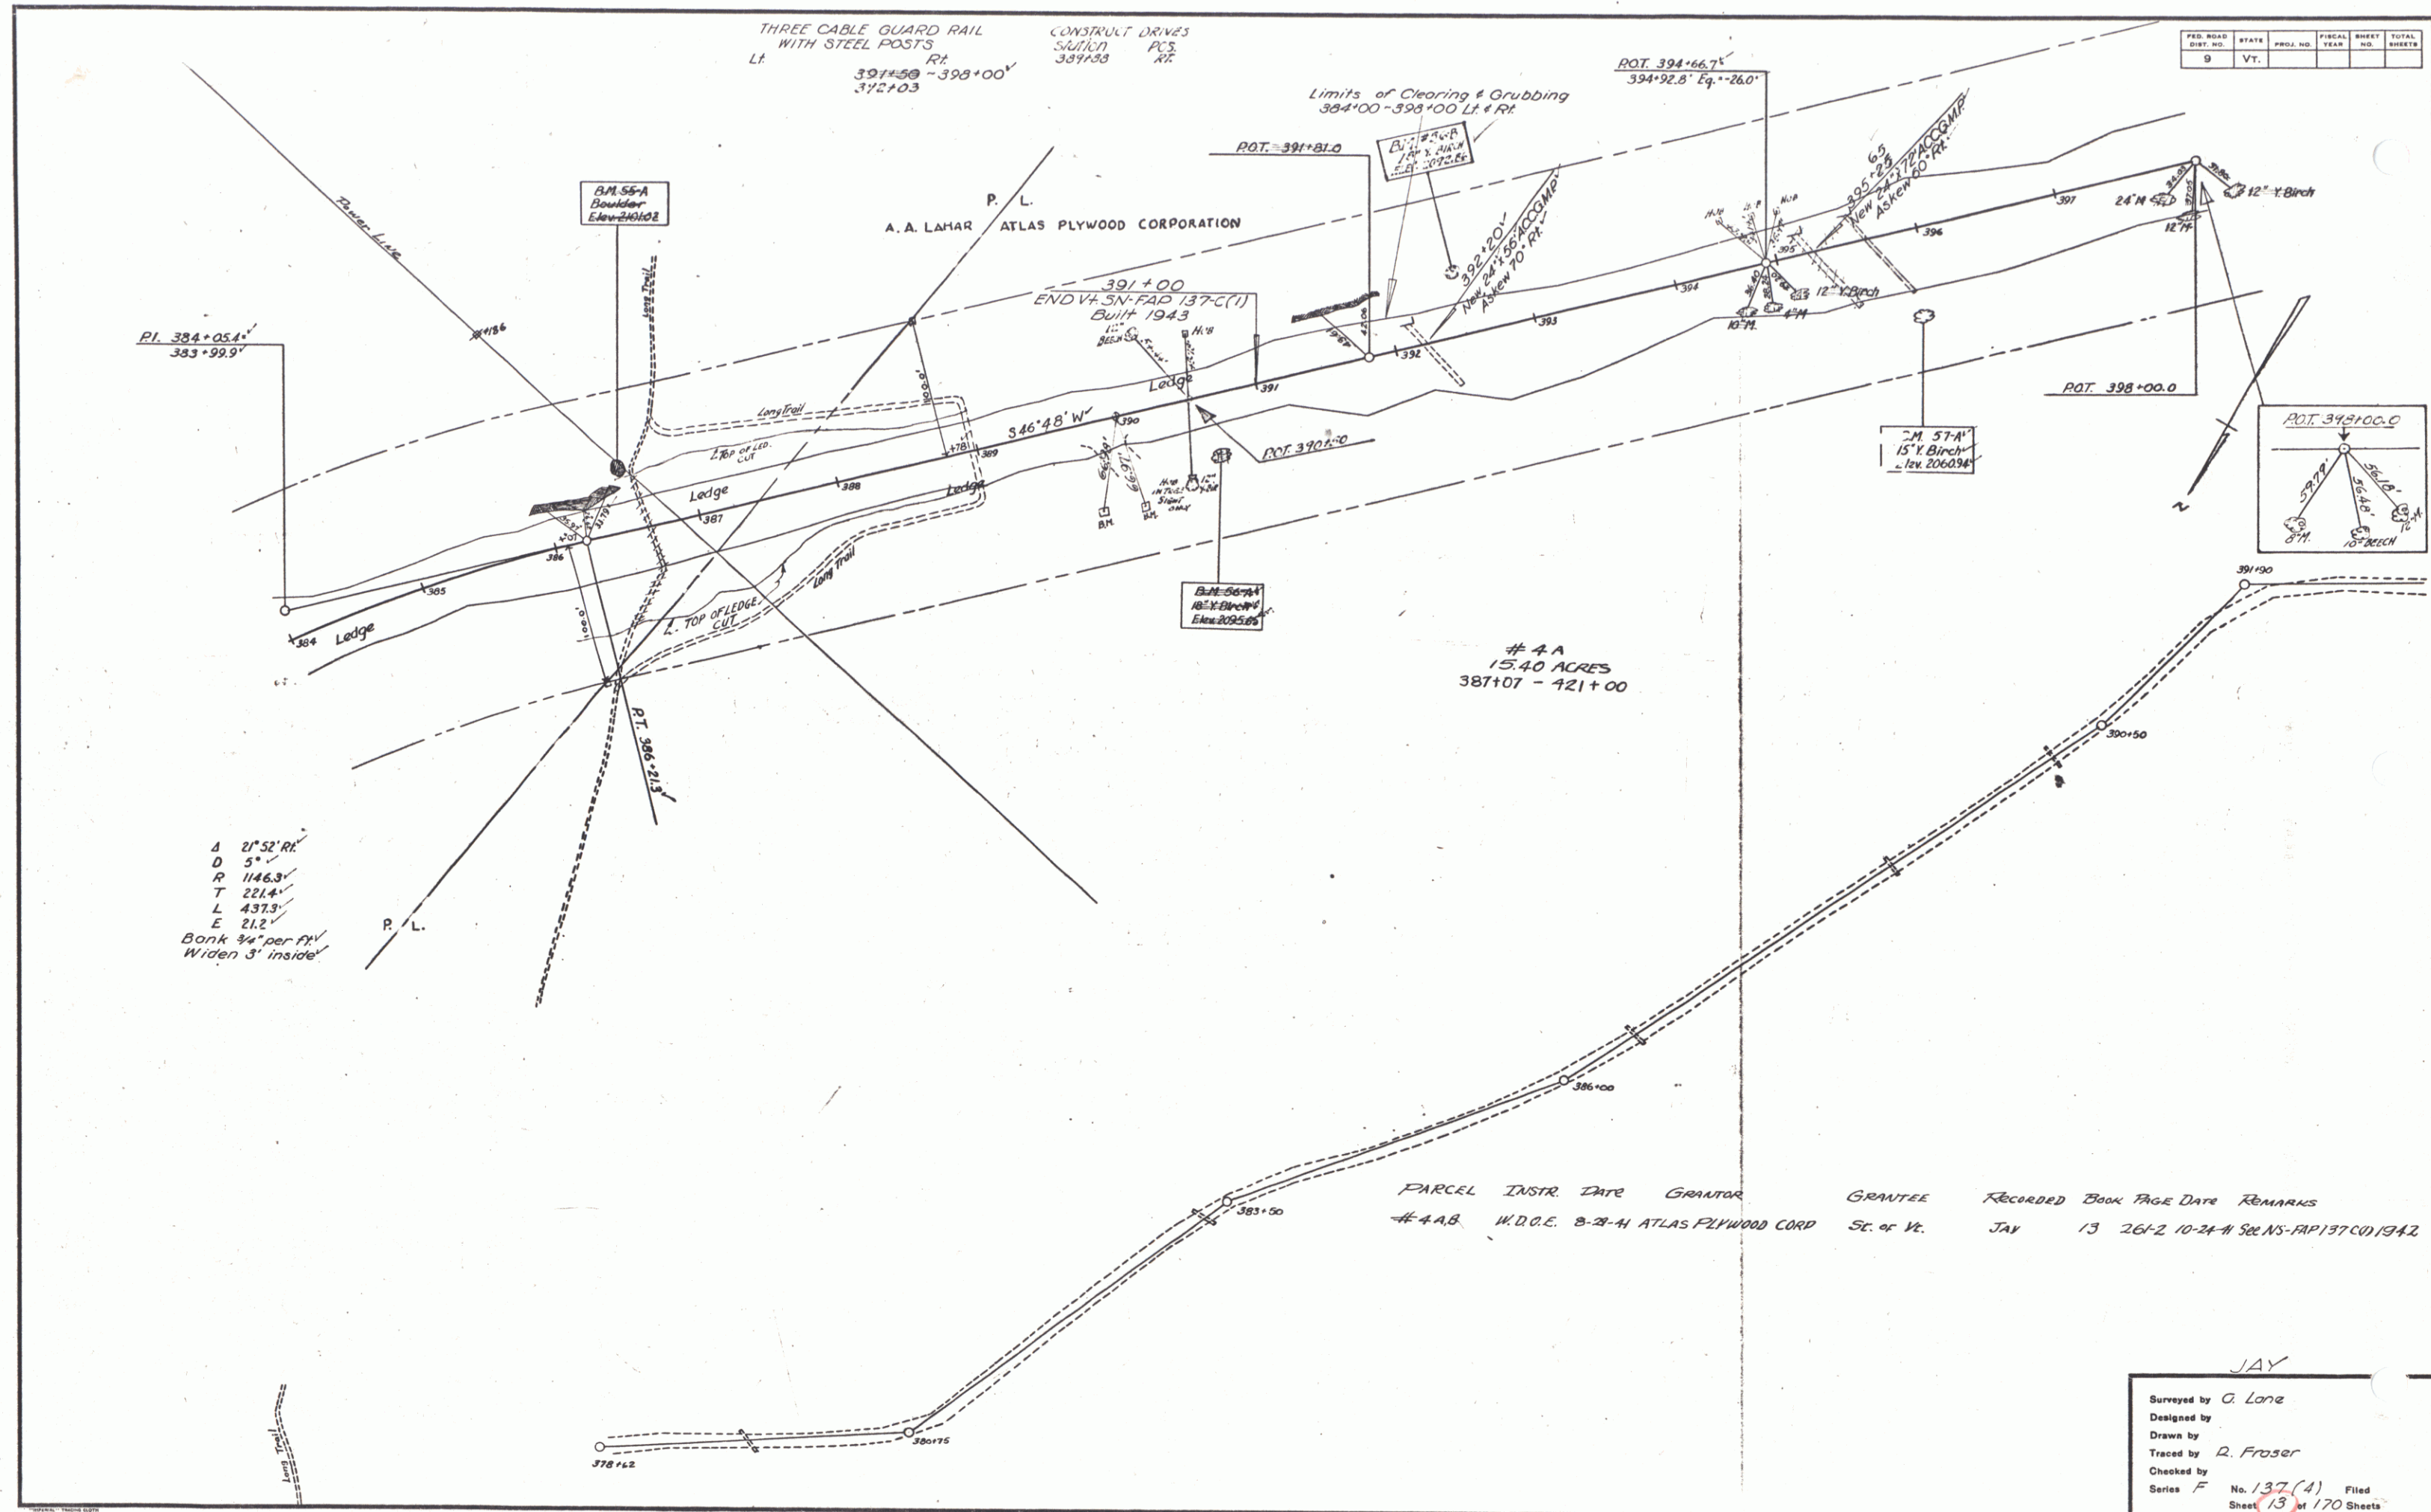

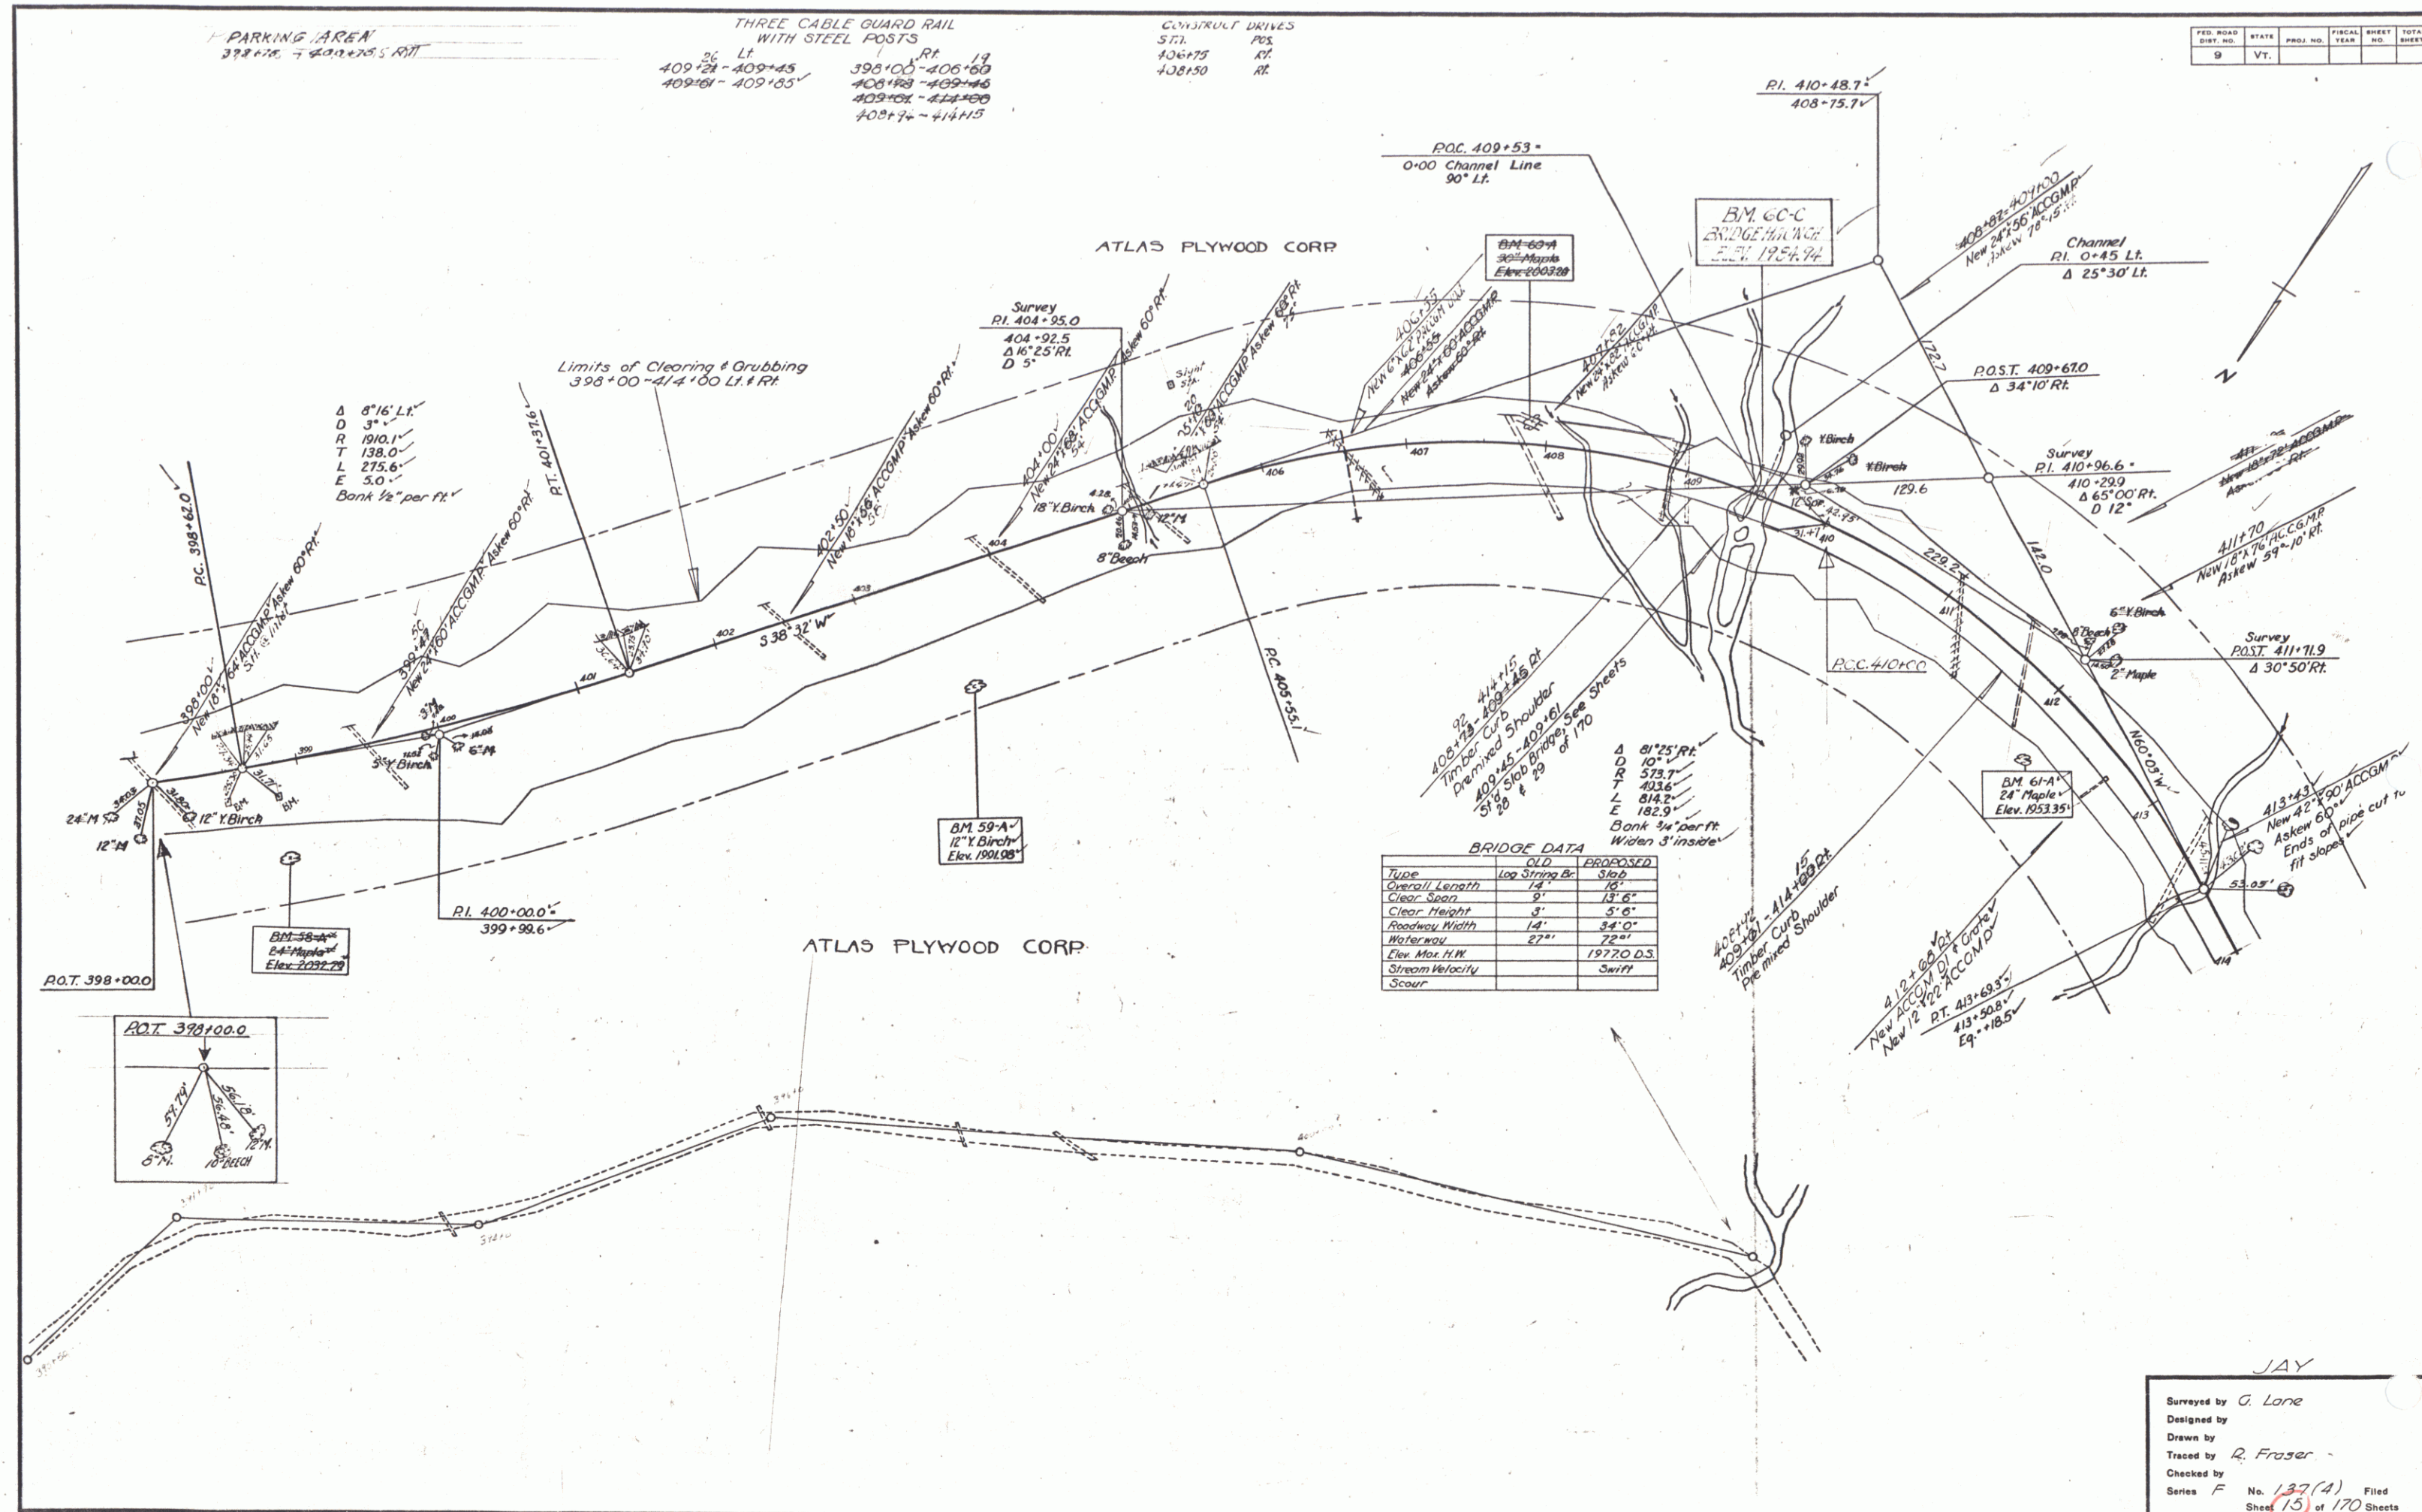

PLAN	DATE	BY	CHECKED
DATE	DATE	DATE	DATE
DATE	DATE	DATE	DATE
DATE	DATE	DATE	DATE


PROFILE	DATE	BY	CHECKED
DATE	DATE	DATE	DATE
DATE	DATE	DATE	DATE
DATE	DATE	DATE	DATE

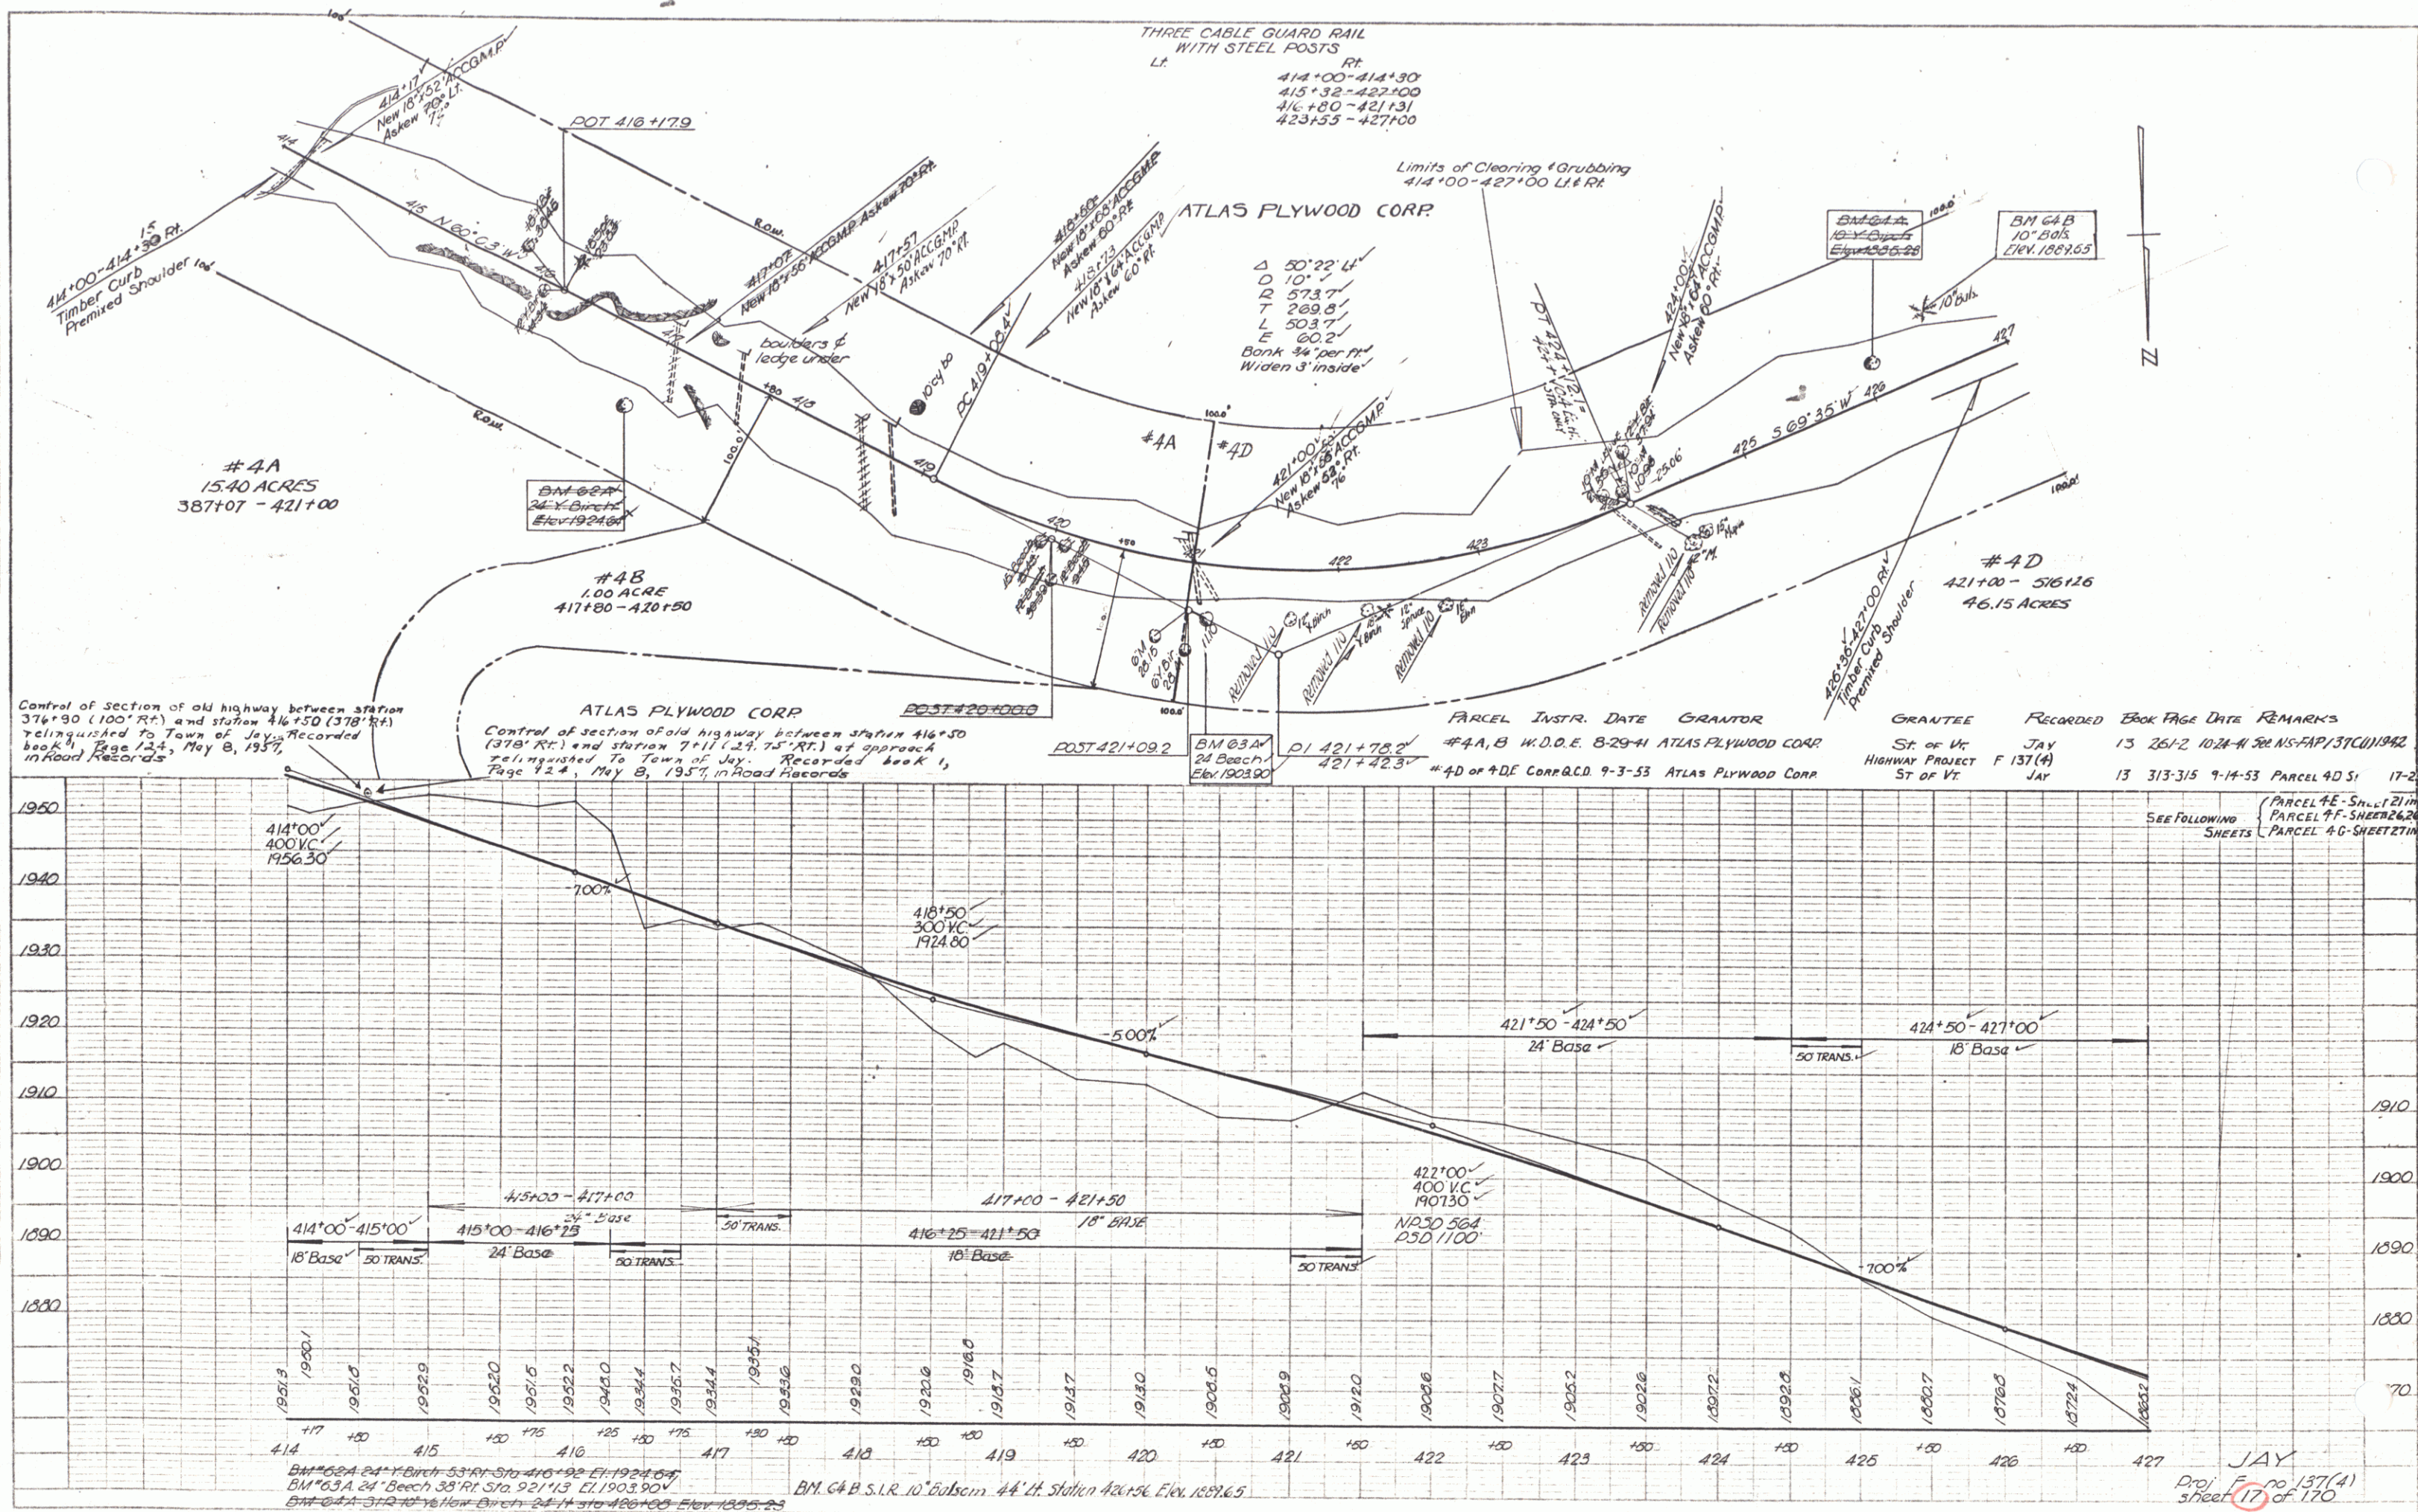

JAY
 Proj. no. 137(4)
 sheet 17 of 170

PLAN	DATE	BY	CHECKED	DATE
1/14	1/14	1/14	1/14	1/14
1/14	1/14	1/14	1/14	1/14
1/14	1/14	1/14	1/14	1/14
1/14	1/14	1/14	1/14	1/14

PROFILE	DATE	BY	CHECKED	DATE
1/14	1/14	1/14	1/14	1/14
1/14	1/14	1/14	1/14	1/14
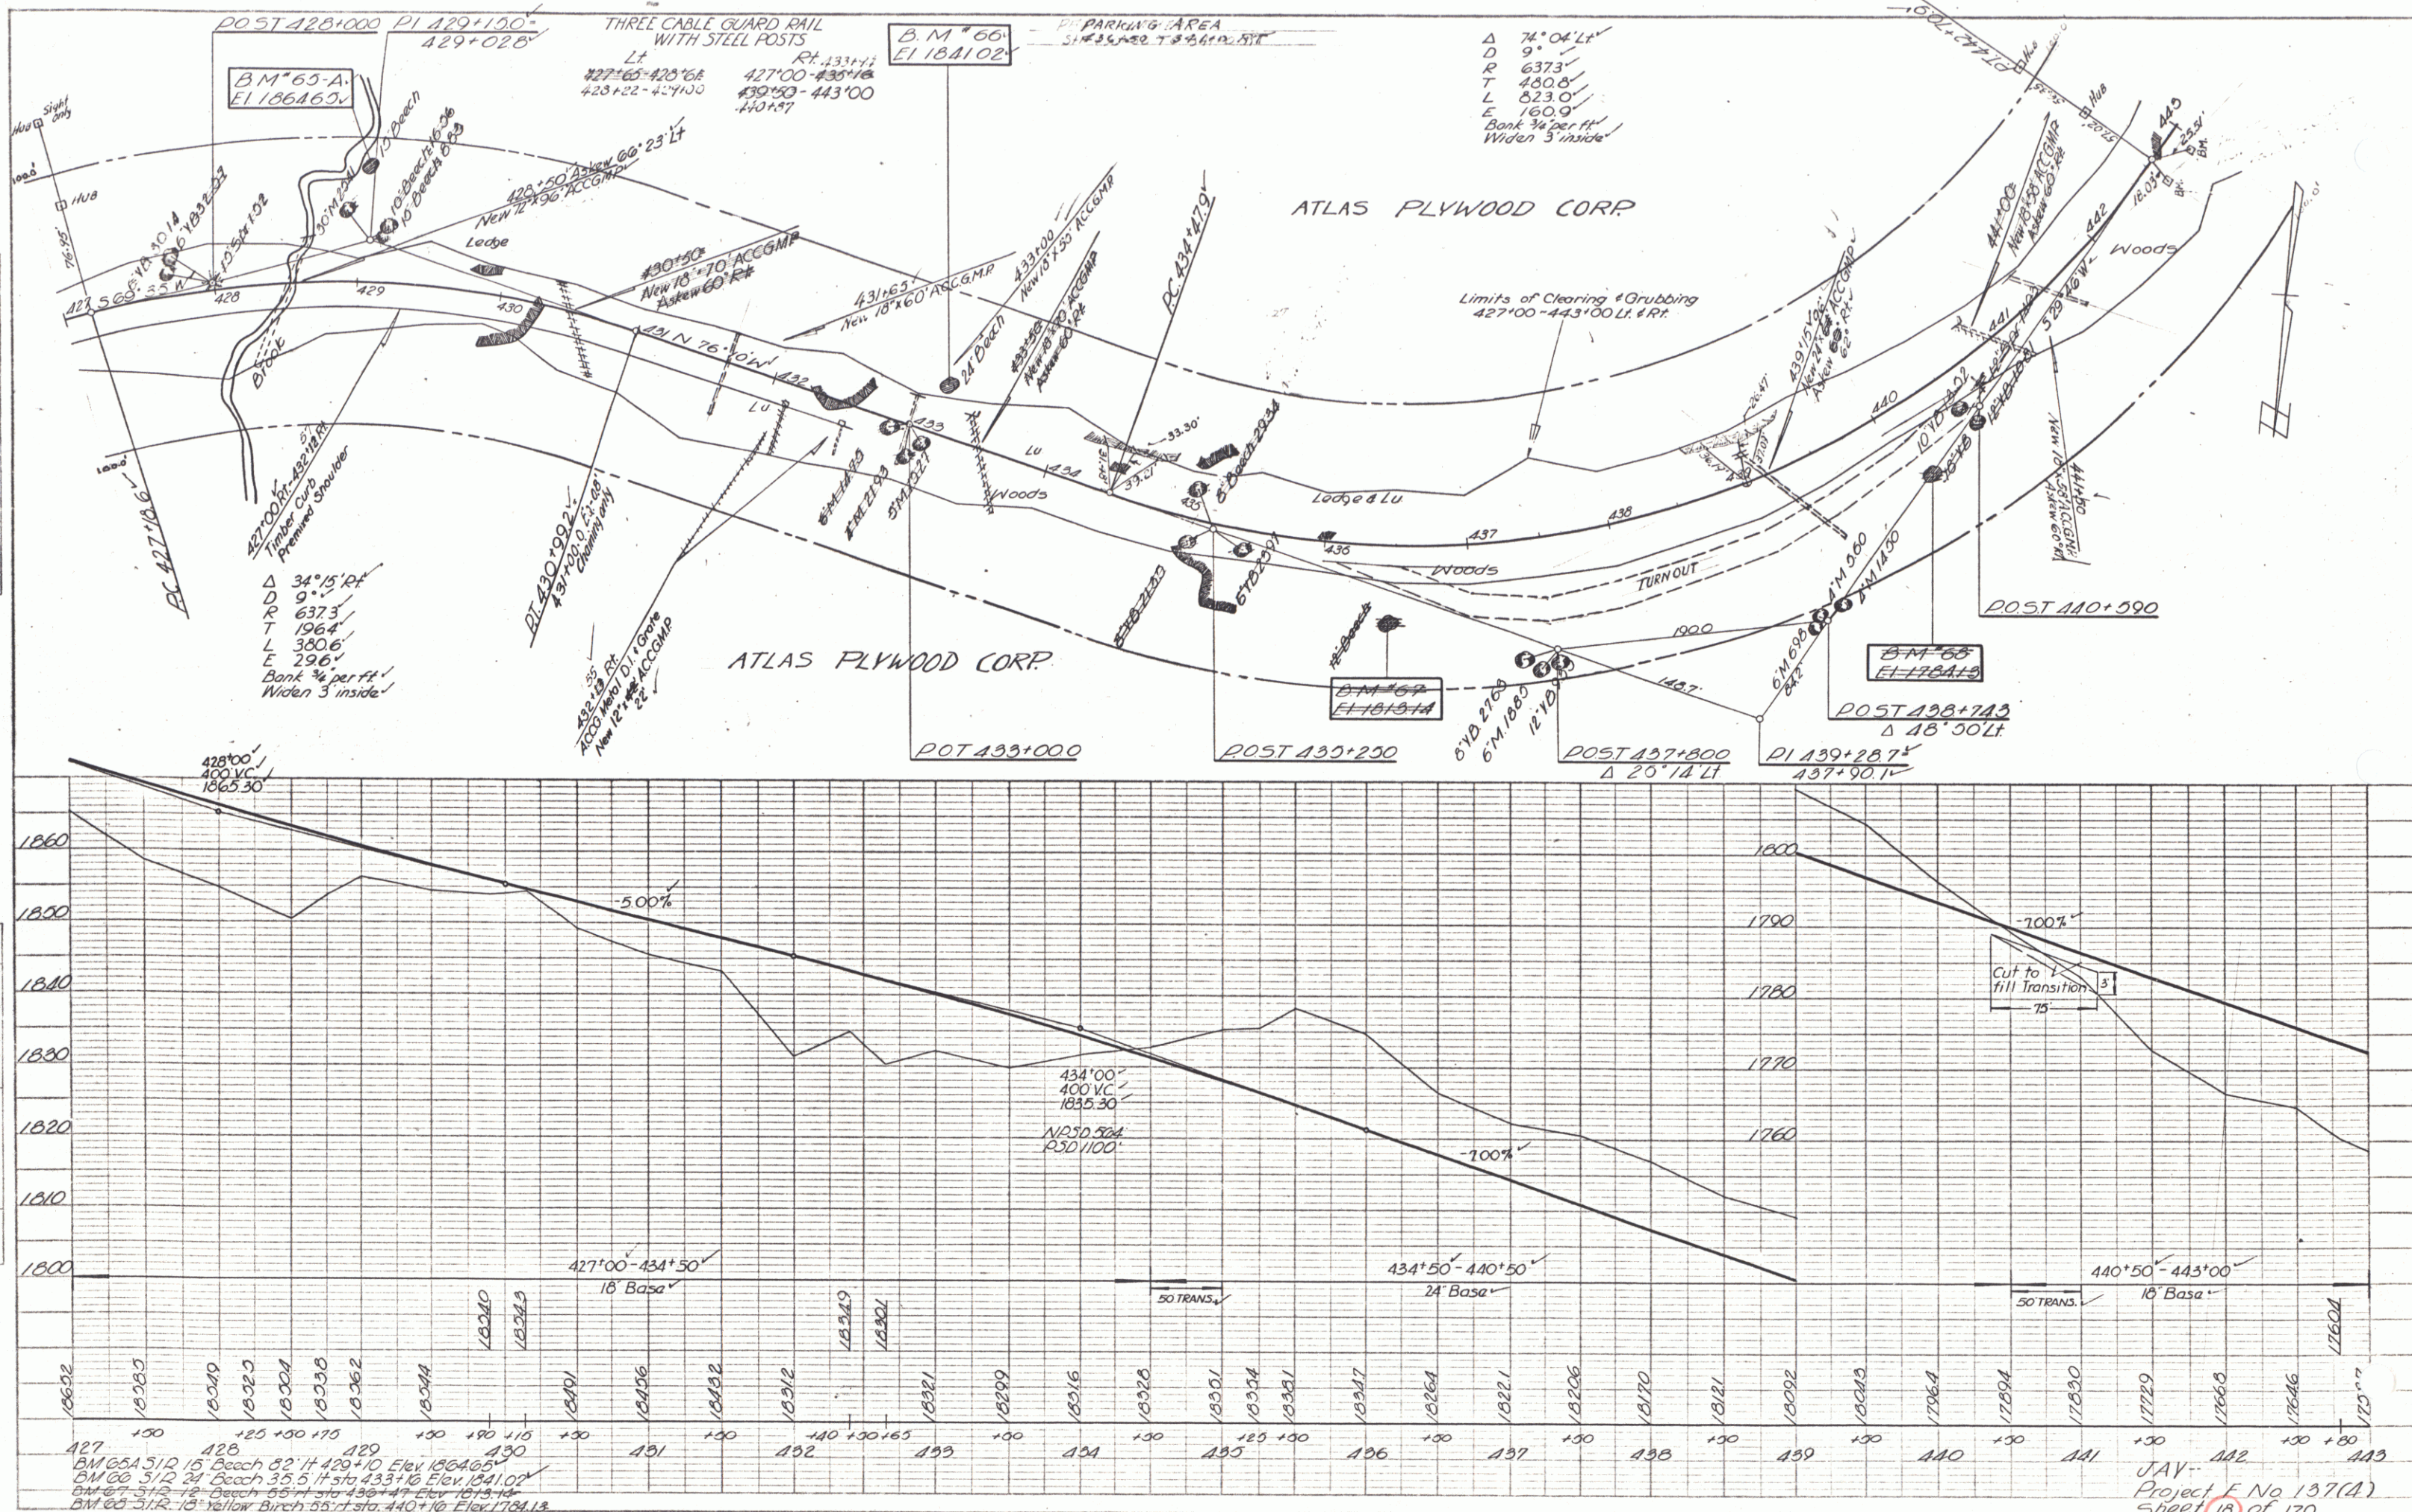

PLAN	DATE	BY	CHECKED	DATE
1-14	5-24	G. L. Palmer	1-14	5-24
1-15	5-24	G. L. Palmer	1-15	5-24
1-16	5-24	G. L. Palmer	1-16	5-24
1-100	5-24	G. L. Palmer	1-100	5-24

PROFILE	DATE	BY	CHECKED	DATE
1-14	5-24	G. L. Palmer	1-14	5-24
1-15	5-24	G. L. Palmer	1-15	5-24
1-16	5-24	G. L. Palmer	1-16	5-24
1-100	5-24	G. L. Palmer	1-100	5-24




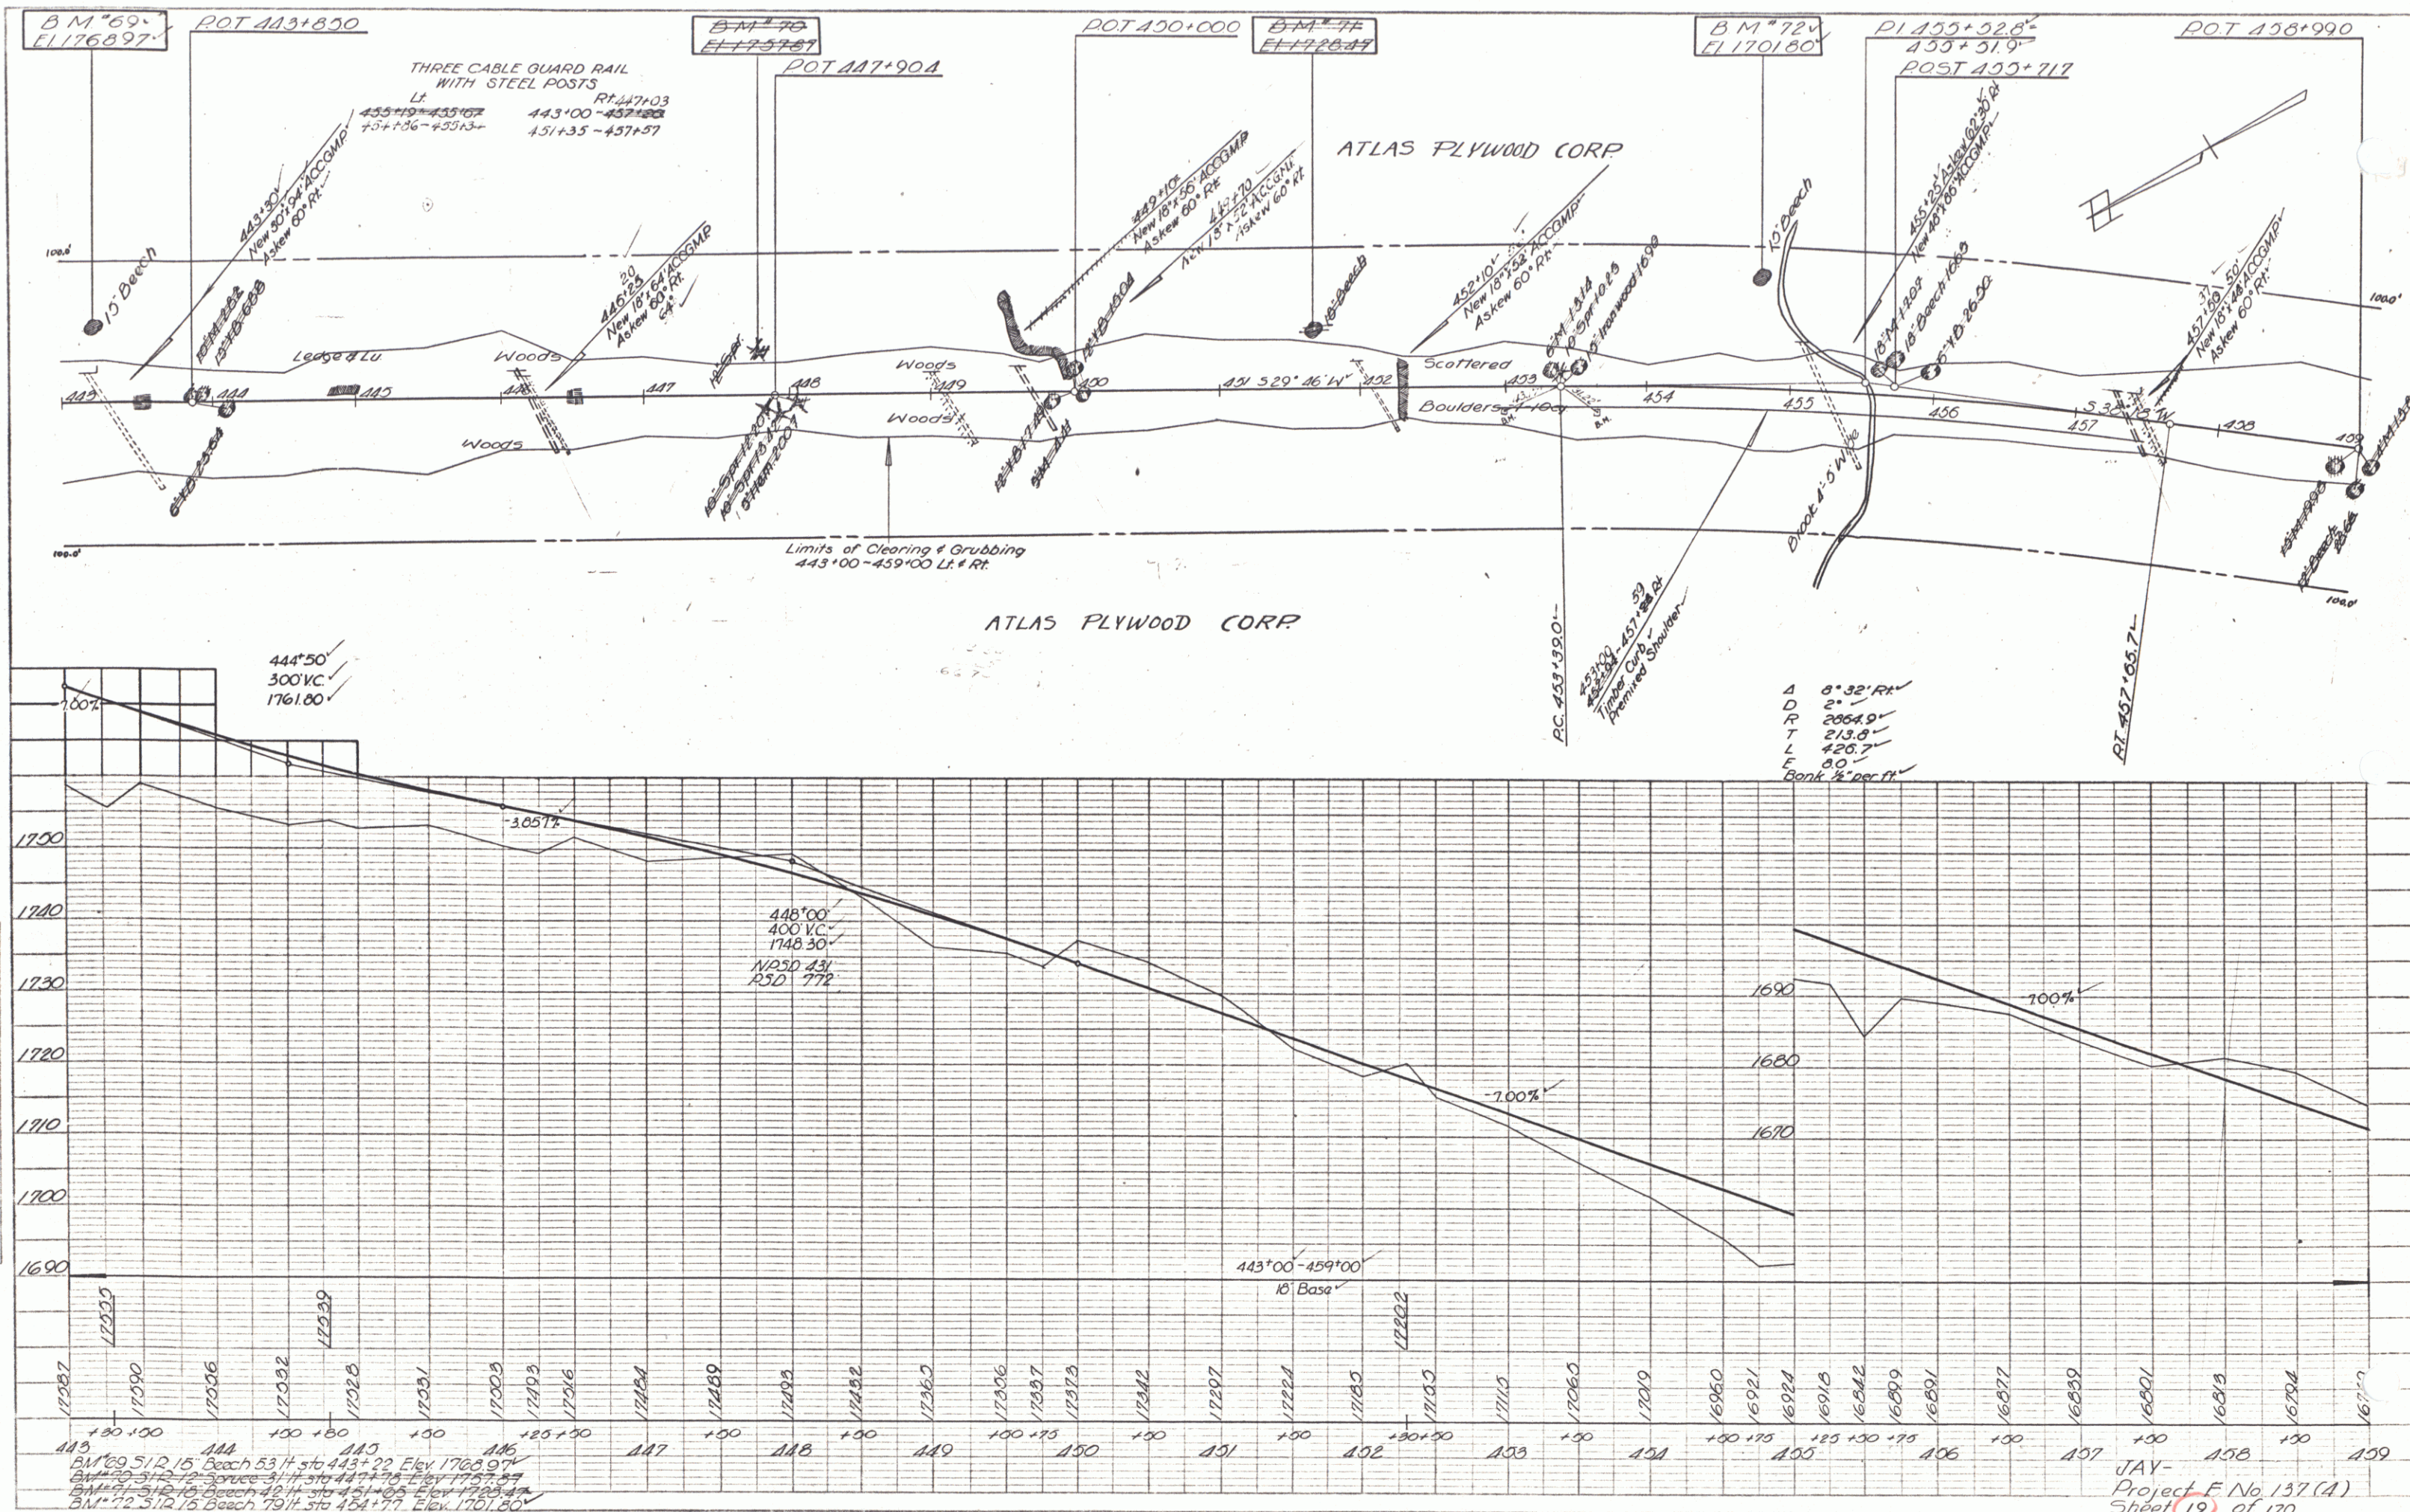



PLATE 1-PLAN-PROFILE OF PARK ROAD
 DESIGNED BY: G. L. PALMER
 DRAWN BY: G. L. PALMER
 CHECKED BY: G. L. PALMER
 DATE: 5-24

JAY-
 Project F No 137 (A)
 Sheet 12 of 170

9

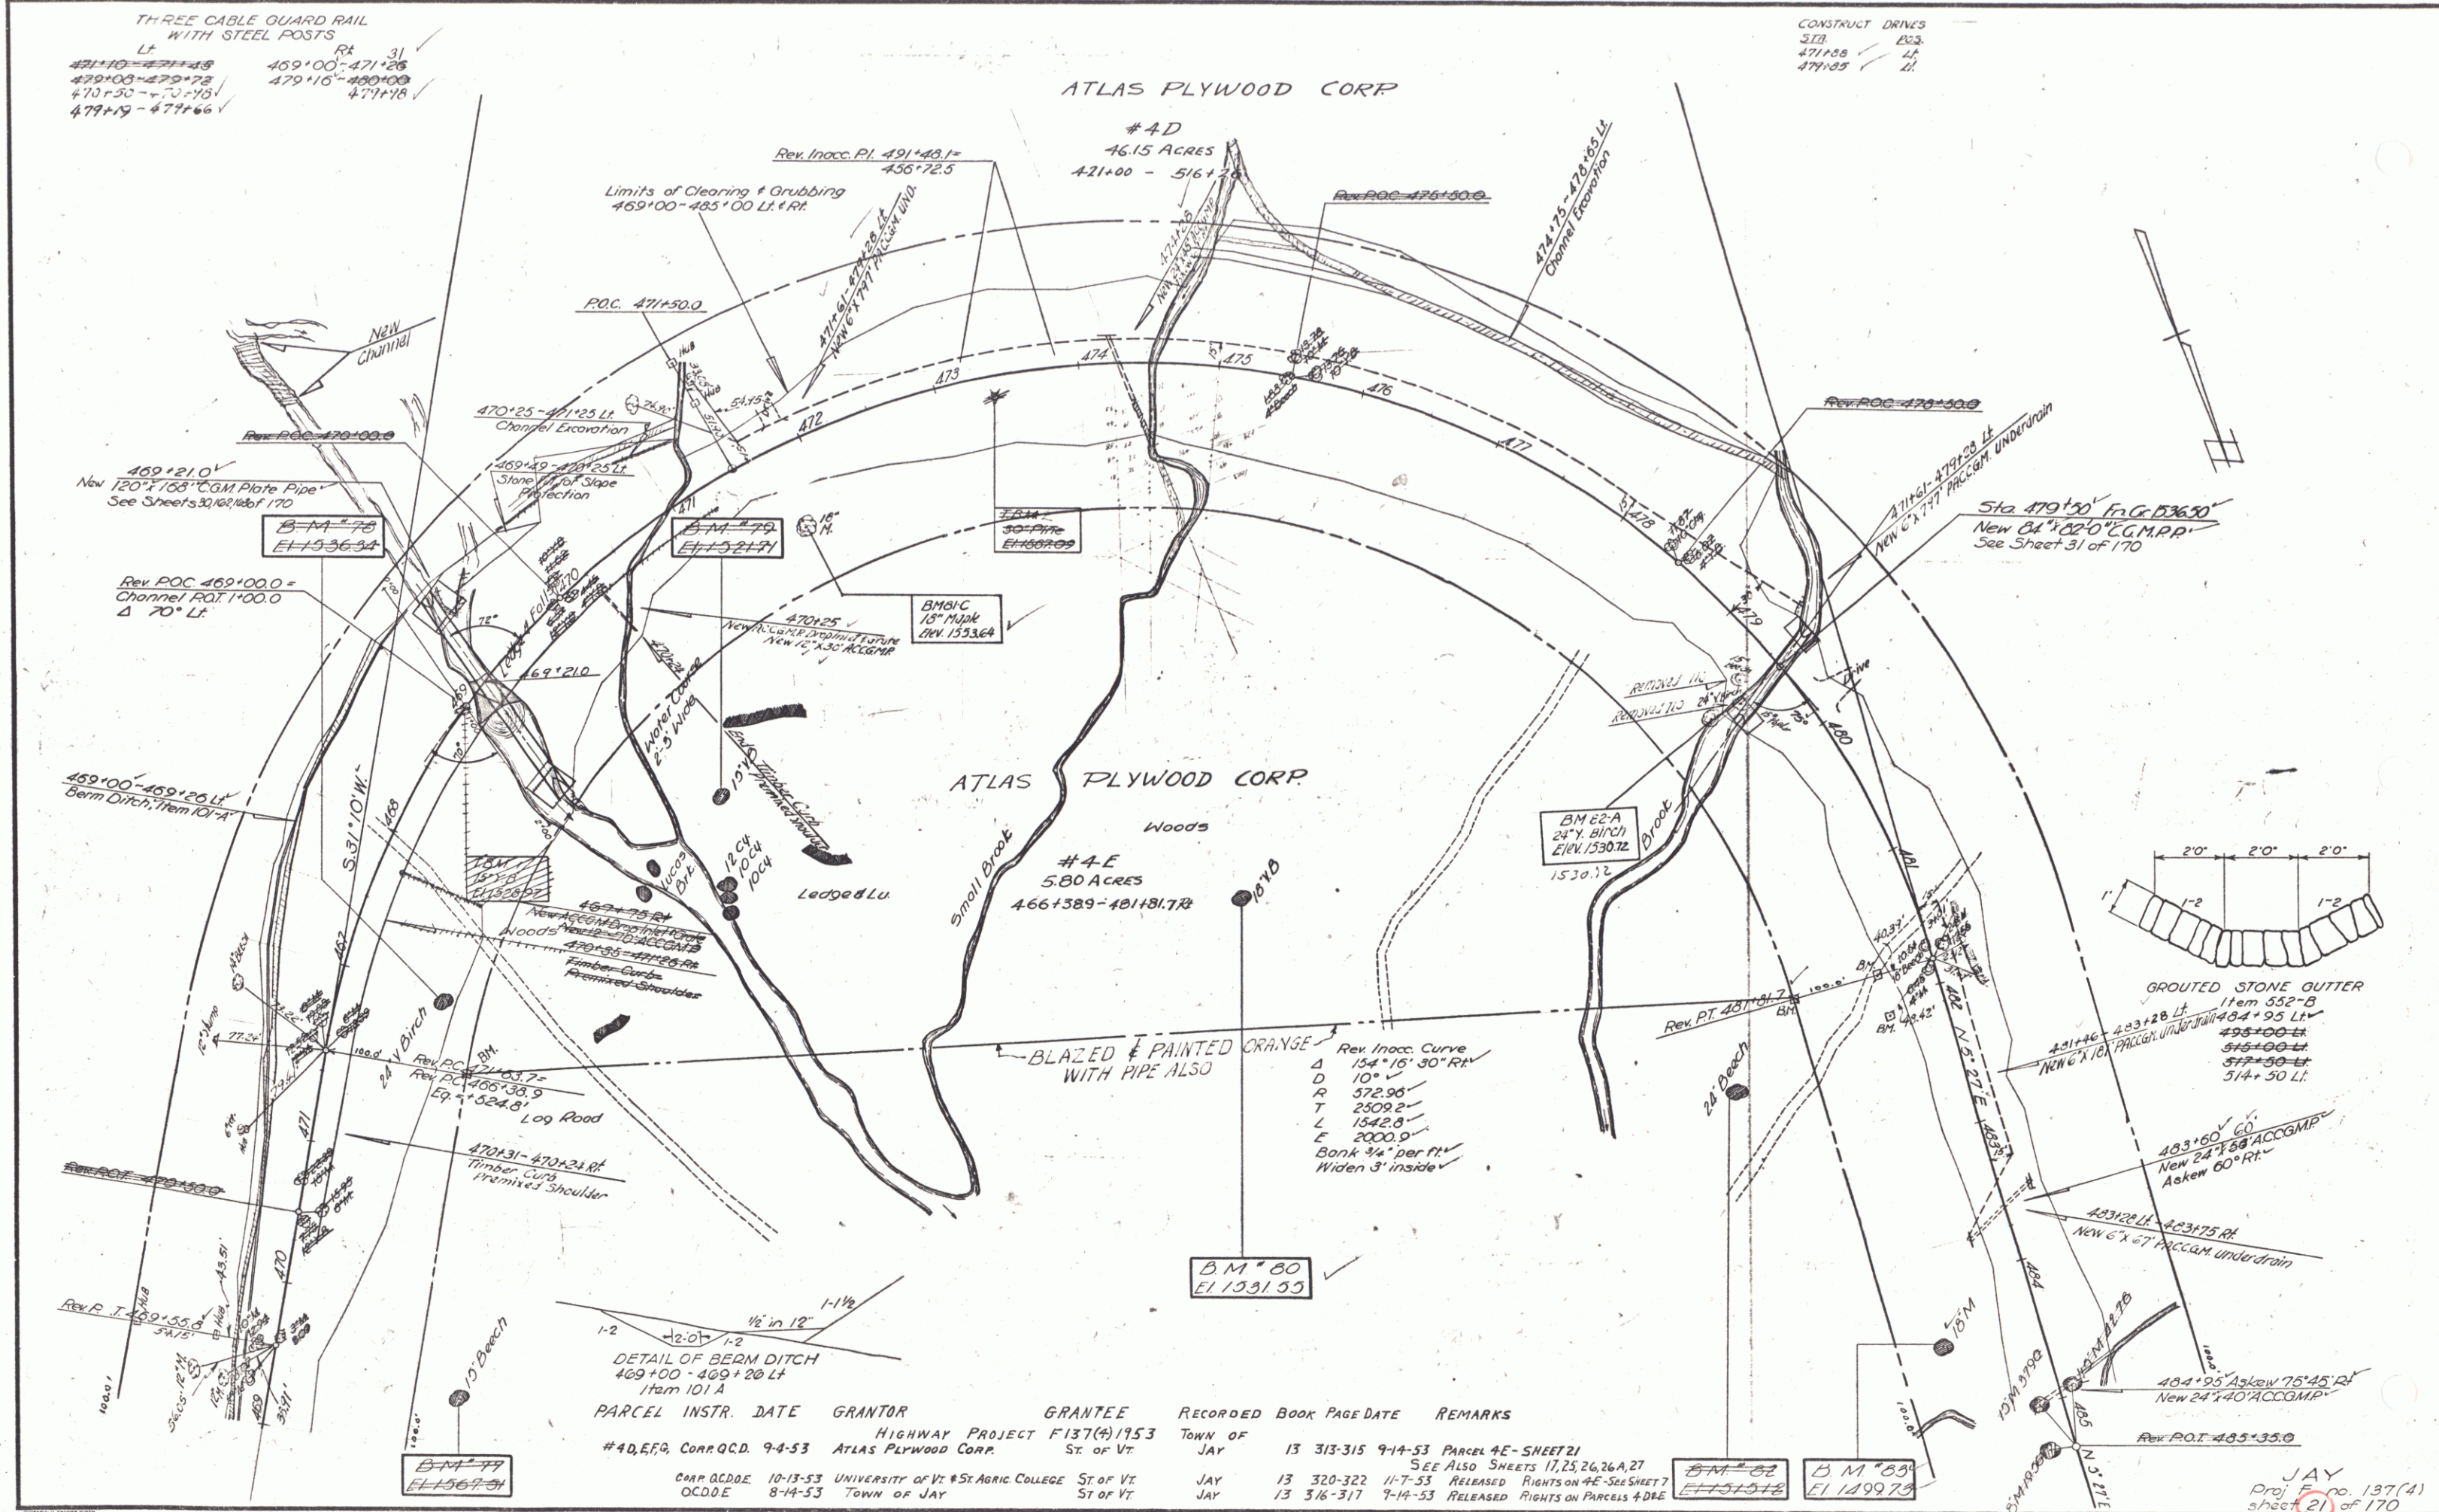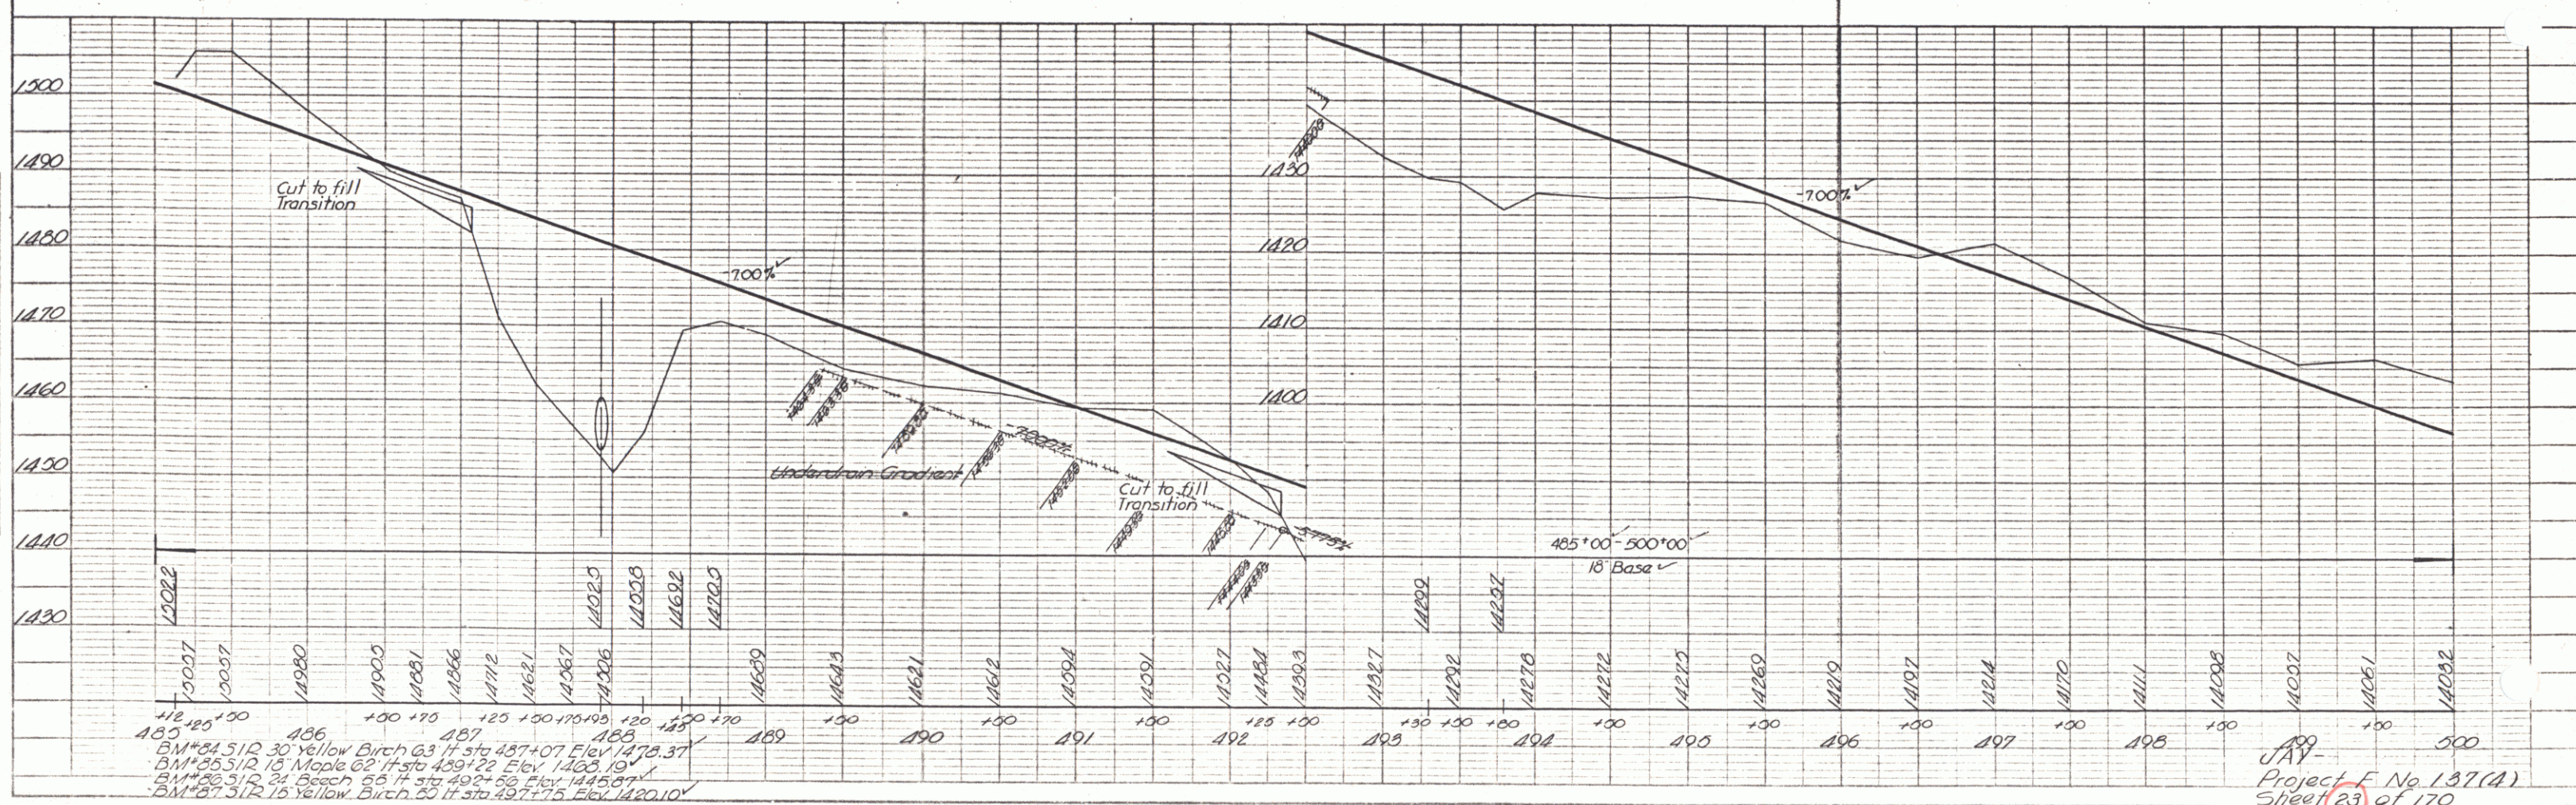


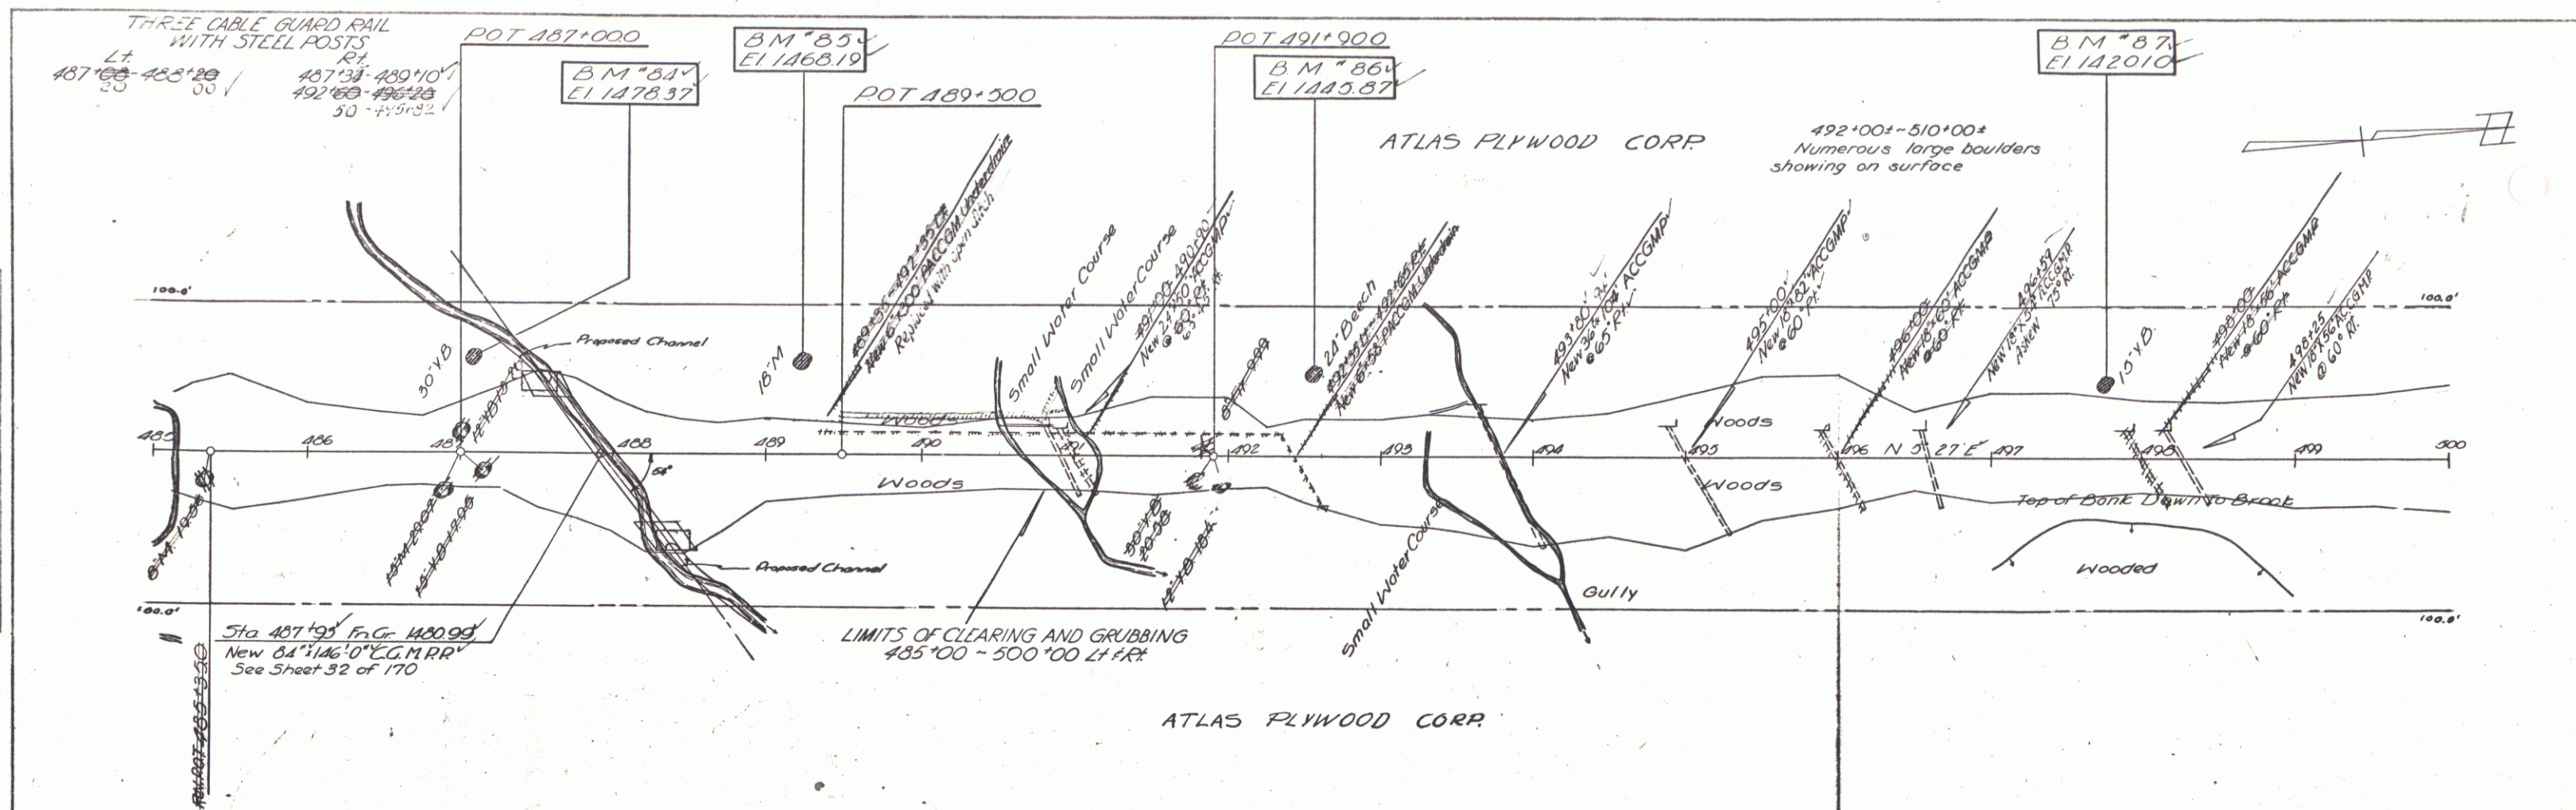

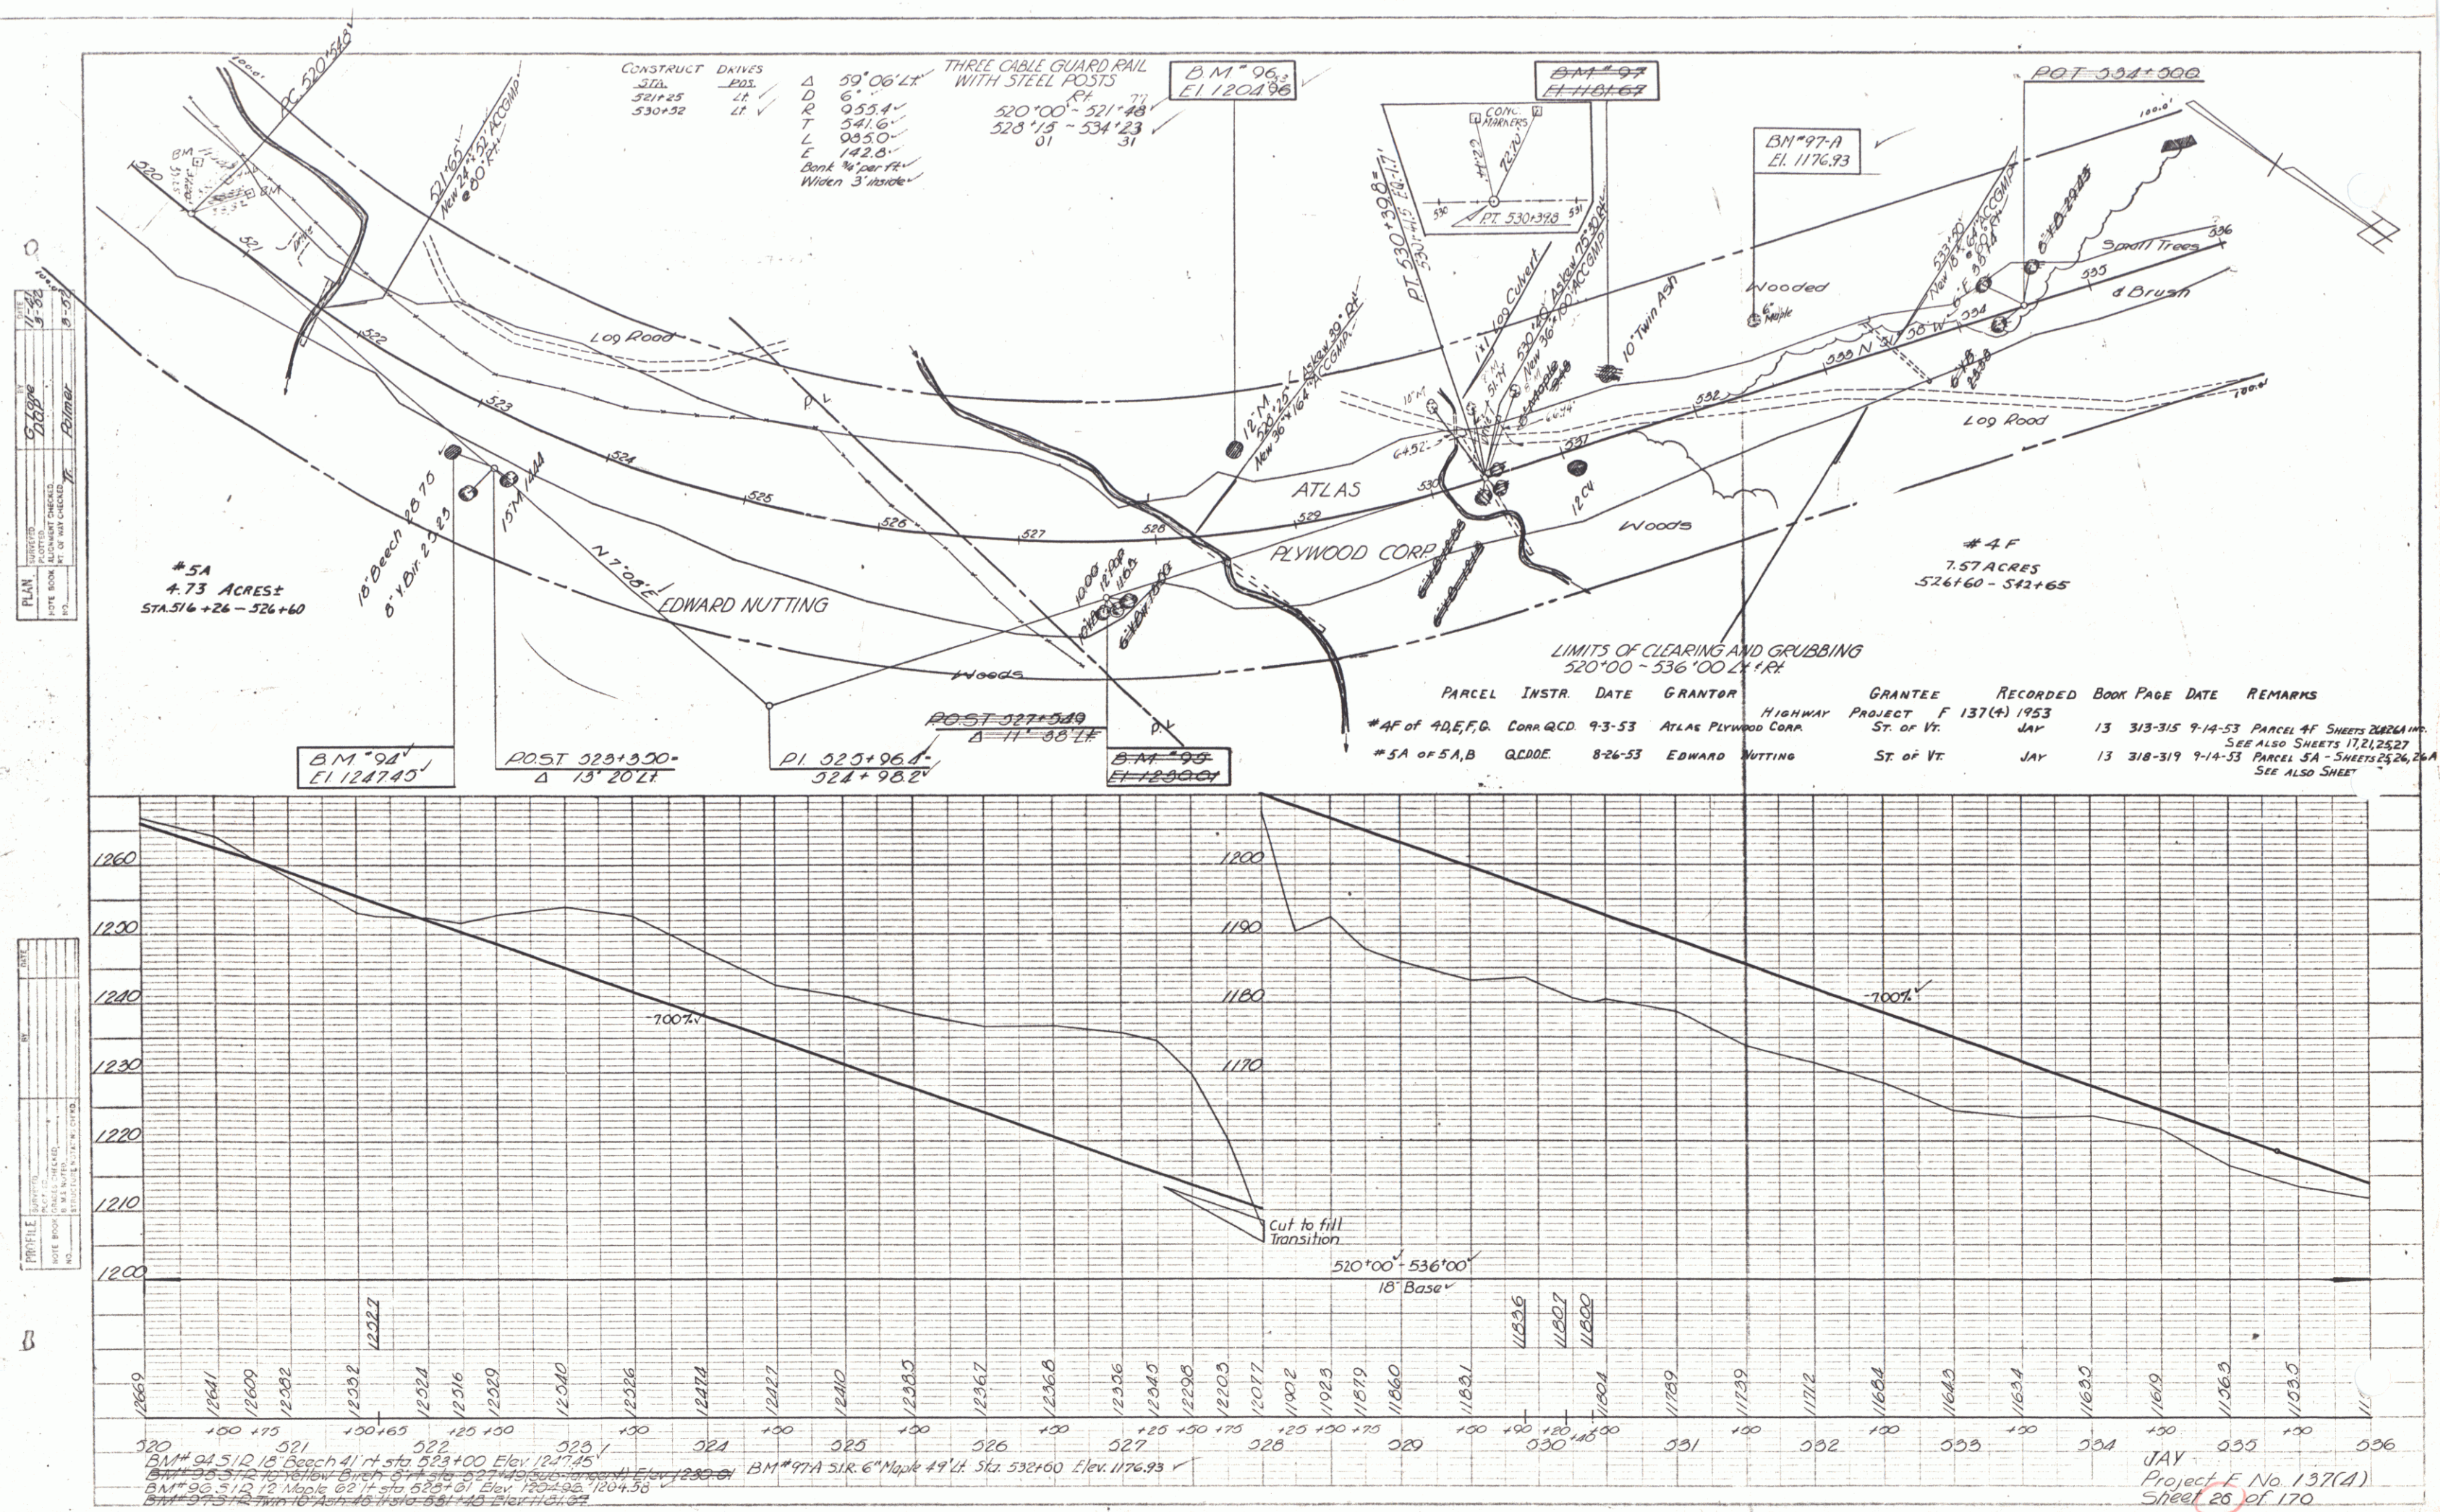

PROFILE	SURVEYED	BY	DATE
	PLOTTED		
NOTE BOOK	CARDS CHECKED		
NO.	B. M. NOTED		
	STRUCTURE NOT IN CHG.		


PARCEL	TAXTR.	DATE	GRANTOR	GRANTEE	RECORDED	BOOK	PAGE	DATE	REMARKS
#4 of ADEFG	CONRAD D.	9-3-53	ATLAS PLYWOOD CORP.	PROJECT ST. OF VT.	F-137(41) 1953 JAY	13	313-315	9-14-53	PARCEL 4F SHEETS 21, 22 SEE ALSO SHEETS 172, 23
#5A of SA,B	GLCDOE	8-26-53	EDWARD NUTTING	ST. OF VT.	JAY	13	318-319	9-14-53	PARCEL 5A SHEETS 23 SEE ALSO SHEETS 26A
CONRAD D.	GLCDOE	10-13-53	UNIVERSITY OF VT. ST. AGRIC. COLLEGE	ST. OF VT.	JAY	13	320-322	11-7-53	RELEASED RIGHTS ON PARTS OF 42 ACRES SEE SHEETS 7 & 21

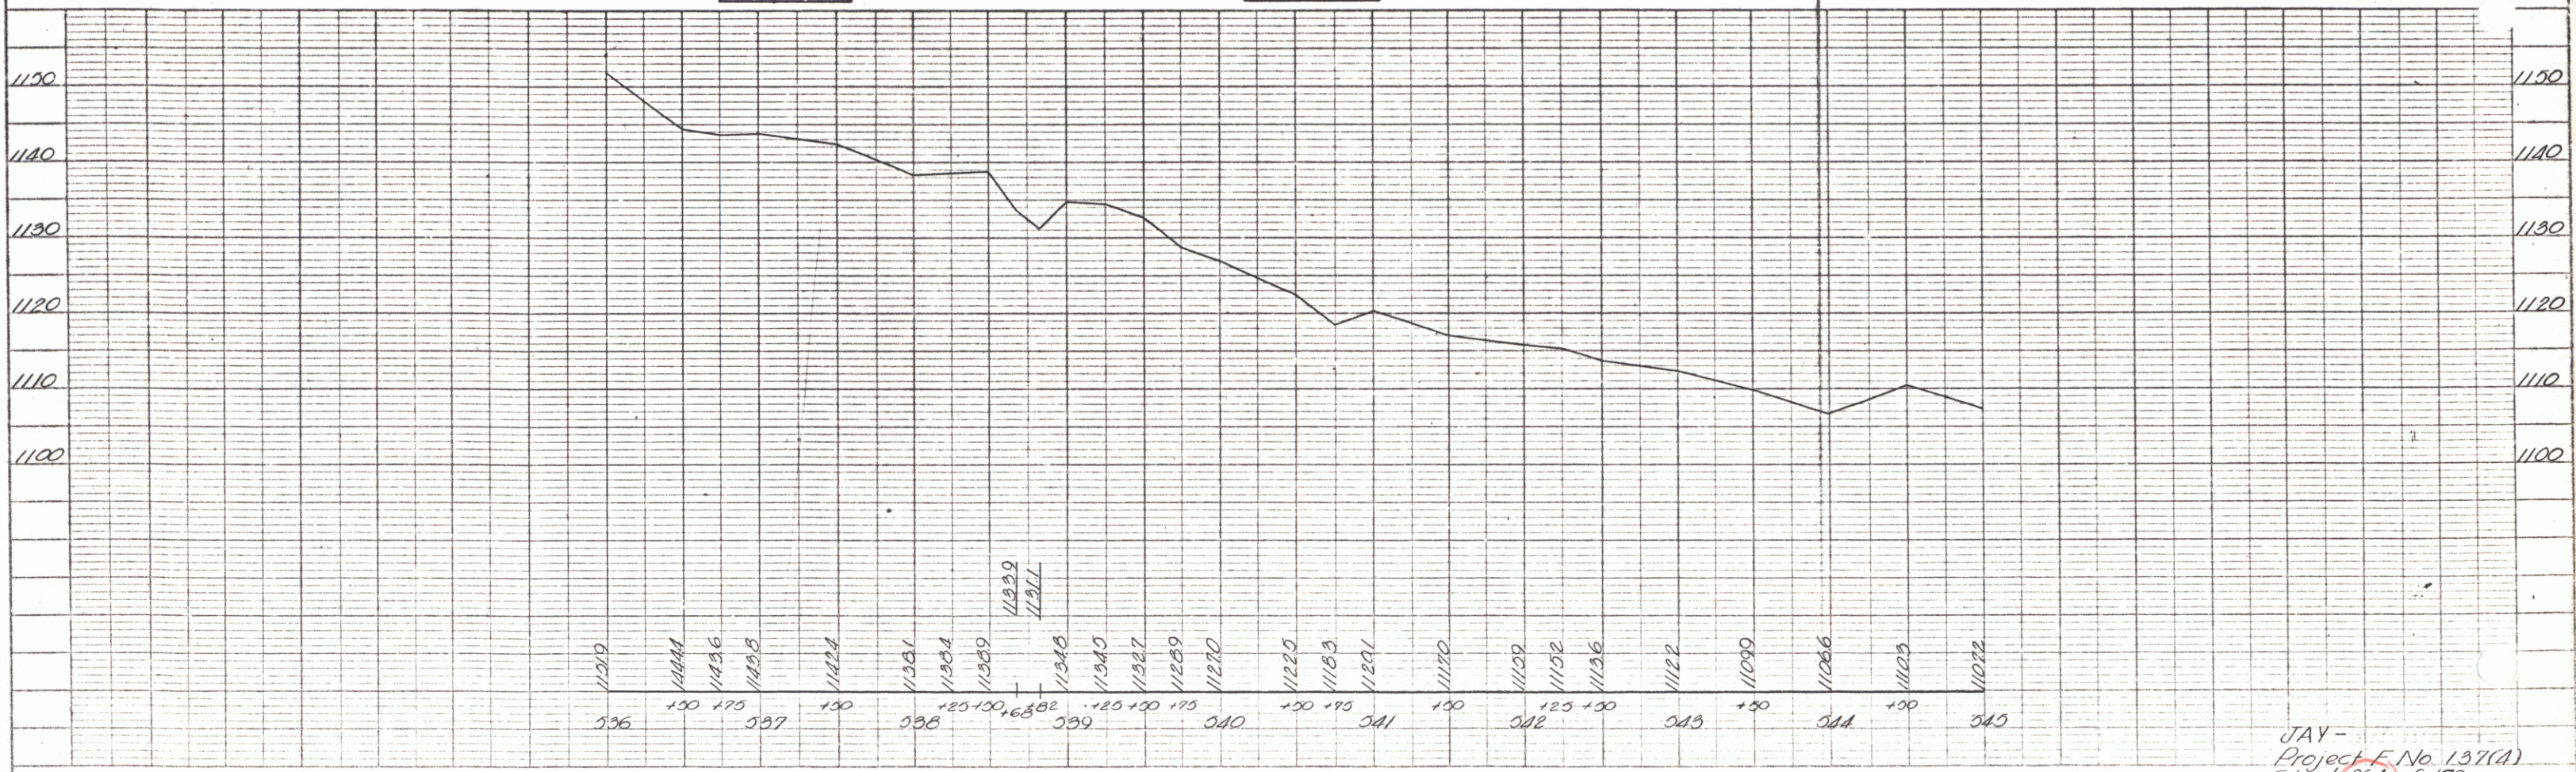

JAY -
Project F No 137(4)
Sheet 26A of 170

PLAN	DATE	BY	CHKD
NO. 1	10/1/53	JAY	JAY
NO. 2	10/1/53	JAY	JAY
NO. 3	10/1/53	JAY	JAY
NO. 4	10/1/53	JAY	JAY
NO. 5	10/1/53	JAY	JAY
NO. 6	10/1/53	JAY	JAY
NO. 7	10/1/53	JAY	JAY
NO. 8	10/1/53	JAY	JAY
NO. 9	10/1/53	JAY	JAY
NO. 10	10/1/53	JAY	JAY

PROFILE	DATE	BY	CHKD
NO. 1	10/1/53	JAY	JAY
NO. 2	10/1/53	JAY	JAY
NO. 3	10/1/53	JAY	JAY
NO. 4	10/1/53	JAY	JAY
NO. 5	10/1/53	JAY	JAY
NO. 6	10/1/53	JAY	JAY
NO. 7	10/1/53	JAY	JAY
NO. 8	10/1/53	JAY	JAY
NO. 9	10/1/53	JAY	JAY
NO. 10	10/1/53	JAY	JAY

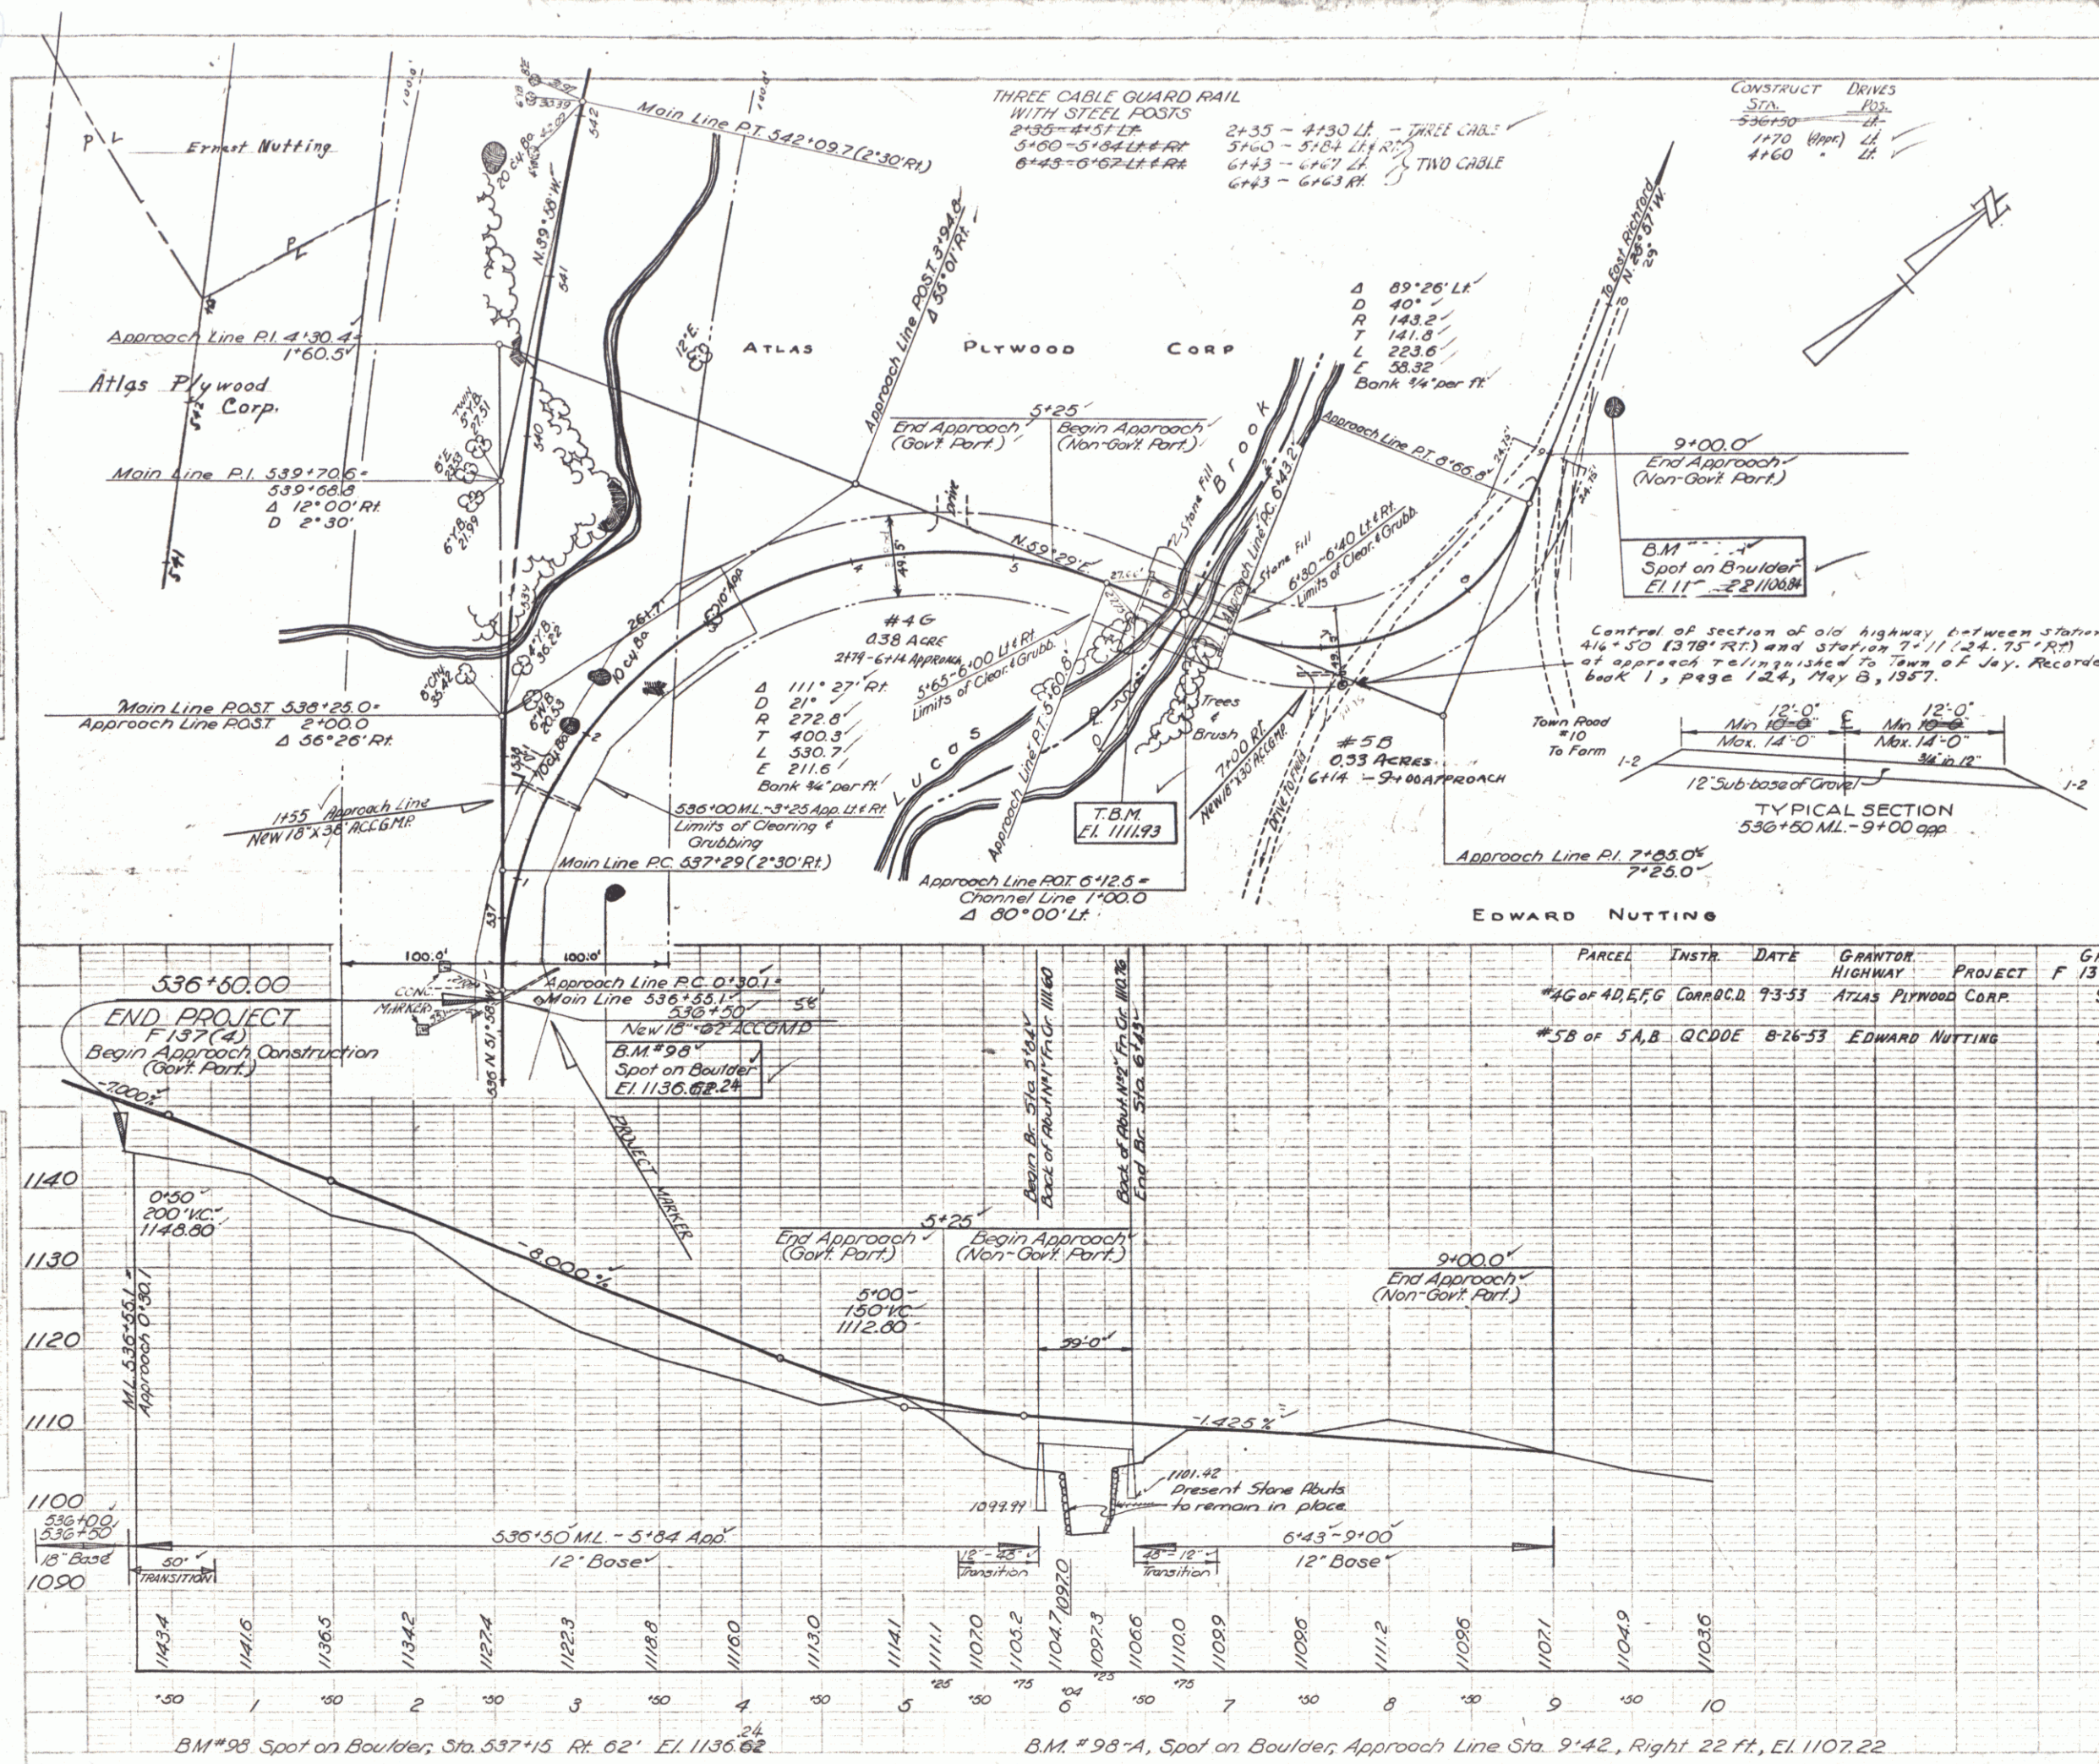

BRIDGE DATA			
	Former	On	L
Type	Log	Cor.	W. Beam
Overall Span	27'	55'	
Roadway Width	12'	24'	
Clear Span on E of Road	24'	55'	
" " Normal to Stream	24'	55'	
Max. H.W. Elev.	1106	1106	
Normal H.W. Elev.	1104	1104	
Waterway to Low Bridge Seat	196"	320"	
Stream Velocity	rapid	light	
Scour			

ESTIMATED QUANTITIES (BRIDGE ONLY)			
Item 106-A Channel Excavation of Earth	311	340	CY
" 107 Structure Excavation (Mod)	46	60	CY
" 401-C Concrete Class C (Mod)	93	110	CY
" 402 Reinforcing Steel	11000	11000	Lbs
" 403-A Structural Steel	39363	39363	Lbs
" 521 Stone Fill	105	370	CY
" 542 Two Cable Guard Rail (on Bridge)		118	LF
" 401-B Concrete Class B (Mod)	40	40	CY

LIST OF SHEETS (BRIDGE ONLY)			
No. 27	Plan & Profile (30 Scale)		
" 34	Detail of Abutment #1		
" 35	" " " "		
" 47	Sid. Dwg. CI 245 (1) Superstructure		
" 48	S.B. 20, Details C, D, V, K, L		
" 49	Channel Sections (2 Sheets)		

PARCEL	INSTR.	DATE	GRANTOR	PROJECT	GRANTEE	RECORDED	BOOK	PAGE	DATE	REMARKS
#46 of 40, 5, 6, 7, 999, 1000										

JAY
Proj. F No. 137(4)
Sheet 27 of 170