

INDEX OF SHEETS

SHEET NO. 1	TITLE PAGE
2	TYPICAL CROSS-SECTION OF IMPROVEMENT
3	STANDARD CROSS-SECTION OF IMPROVEMENT
4-10	PLAN AND PROFILE SHEETS
11	STANDARD STRUCTURE SHEET 5-30 RAIL CULVERTS
12	5-30 RAIL
13	5-30 GRADED RAIL
14	5-30 BANKS, DITCHES, SOVS, AND LIGHTS
15	5-31 BOUNDARY MARKERS
16-36	CROSS SECTIONS

STANDARD SHEET 5-28 AND 5-29 APPROVED
BY THE CHIEF ENGINEER ON JULY 11, 1933.
STANDARD SHEET 5-30 APPROVED BY THE
CHIEF ENGINEER ON AUG. 15, 1933.

FED. ROAD DIST. NO.	STATE	PROJ. NO.	FISCAL YEAR	SHEET NO.	TOTAL SHEETS
9	VT.	89-8	1933	1	36

STATE OF VERMONT STATE HIGHWAY DEPARTMENT

PLAN AND PROFILE OF PROPOSED STATE HIGHWAY

NATIONAL RECOVERY HIGHWAY PROJECT


ISLAND POND VILLAGE

TOWN OF BRIGHTON


DERBY STREET

FROM THE INTERSECTION WITH PLEASANT STREET
WESTERLY 1.543 MI. TO A POINT IN FRONT OF THE
RESIDENCE OF WILLIAM MORRIS.

LENGTH OF PROJECT 1.543 MI. 8149.6 FT.

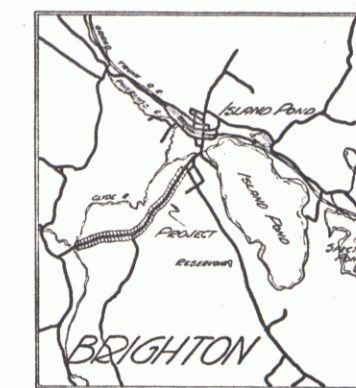

RECORD PLANS

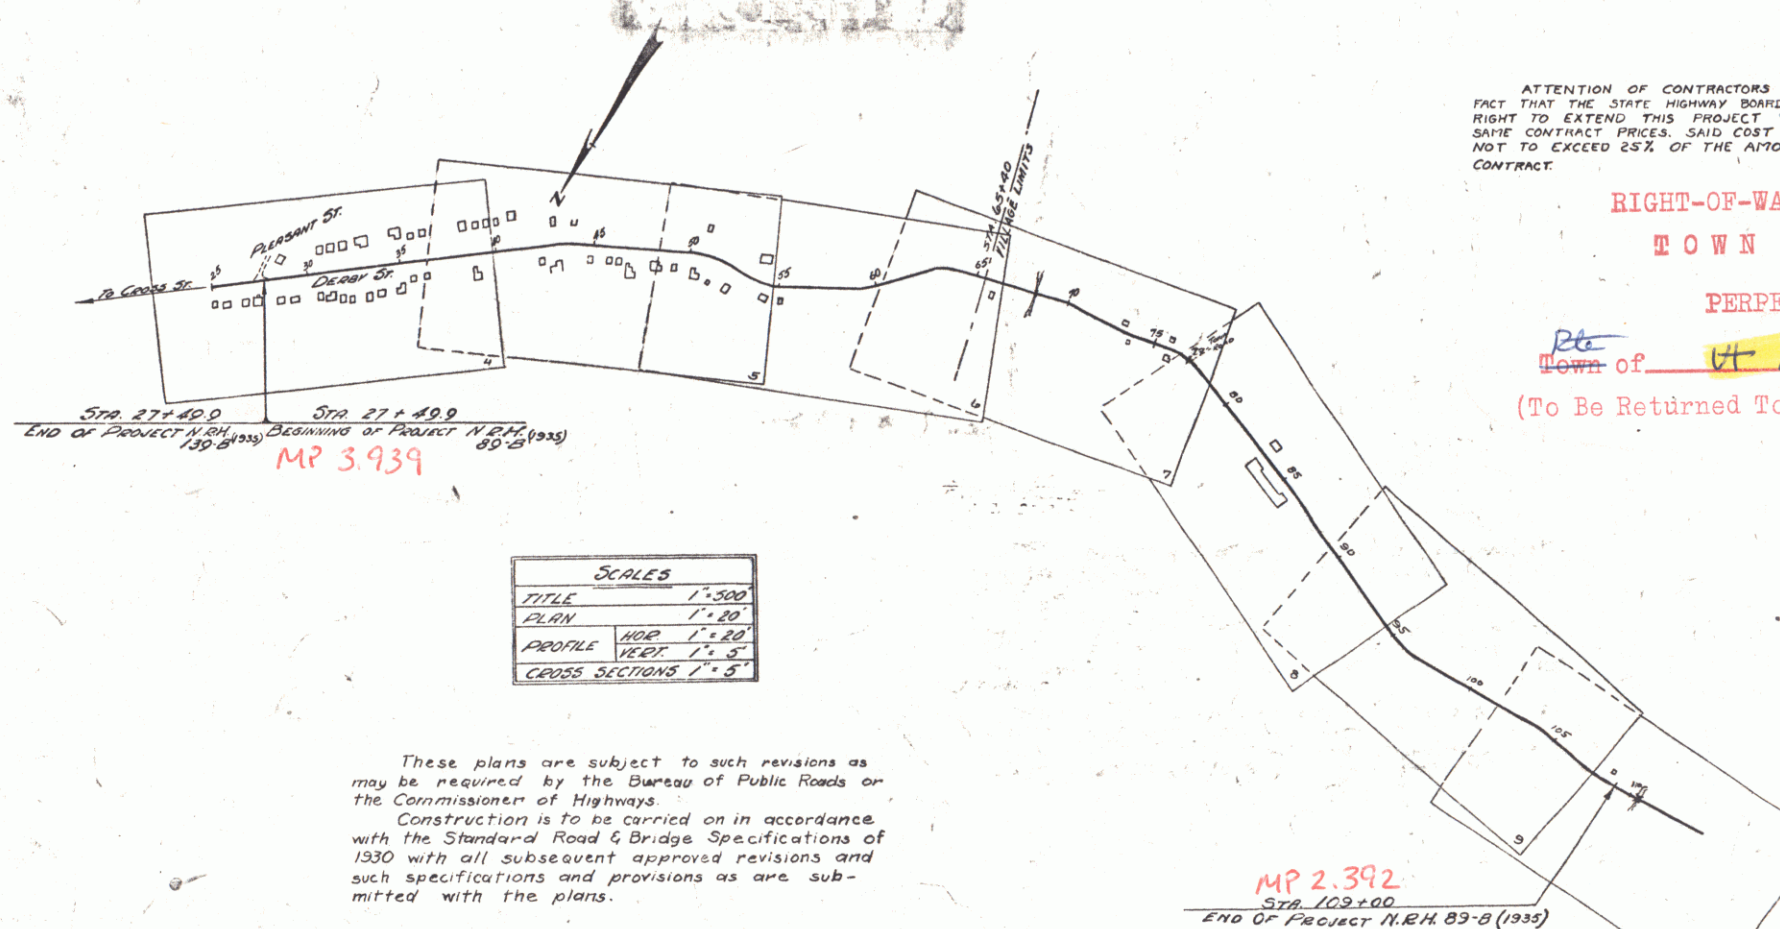

ATTENTION OF CONTRACTORS IS CALLED TO THE
FACT THAT THE STATE HIGHWAY BOARD RESERVES THE
RIGHT TO EXTEND THIS PROJECT WESTERLY AT THE
SAME CONTRACT PRICES, SAID COST OF EXTENSION
NOT TO EXCEED 25% OF THE AMOUNT OF THE
CONTRACT.

RIGHT-OF-WAY DIVISION
TOWN FILE

PERPETUAL

Town of W. 105

(To Be Returned To APPROVED Div. 1034)

H. J. Duggan
Commissioner of Highways

SUBMITTED BY ORDER OF THE STATE HIGHWAY BOARD

NOTE: ANY FURTHER INFORMATION CONCERNING
FISCAL QUANTITIES, AMOUNTS OR OTHER DETAILS
RELATIVE TO THIS PROJECT MAY BE FOUND IN
EITHER THE FIELD BOOKS OR THE ESTIMATE
FILE.

CONVENTIONAL SIGNS

COUNTY LINE	
TOWN LINE	
FENCE LINE	
STONE WALL	
UNFENCED PROPERTY	
GUARD RAIL	
TRAVELED WAY	
RAILROAD	
RETAINING WALL	
CENTER LINE	
SURVEY LINE	
CULVERT	
DROP INLET	
TROLLEY POLE	
POWER POLE	
TELEPHONE POLE	
TREES	
HEDGE	

BRIGHTON, N.H. 89-B
RECORD PLANS
CONTR. B.A. GARDETTO, INC.
FISCAL YEAR 1934

CURVE DATA	
DEFLECTION ANGLE	
DEGREE OF CURVE	
RADIUS OF CURVE	
TANGENT DISTANCE	
LENGTH OF CURVE	
EXTERNAL DISTANCE	
POINT OF INTERSECTION	
POINT OF CURVE	
POINT OF TANGENT	
POINT ON TANGENT	

These plans are subject to such revisions as
may be required by the Bureau of Public Roads or
the Commissioner of Highways.
Construction is to be carried on in accordance
with the Standard Road & Bridge Specifications of
1930 with all subsequent approved revisions and
such specifications and provisions as are sub-
mitted with the plans.

SCALES	
TITLE	1"=500'
PLAN	1"=80'
PROFILE	1"=10'
CROSS SECTIONS	1"=5'


MP 2.392
Sta. 102+00
END OF PROJECT N.H. 89-B (1935)

RECOMMENDED	
DISTRICT ENGINEER	
BUREAU OF PUBLIC ROADS	
RECOMMENDED FOR APPROVAL	
CHIEF ENGINEER	
BUREAU OF	
ROADS	
APPROVED	
DIRECTOR - BUREAU OF PUBLIC ROADS	

SERIES N.H. NO. 89-8 FILED
SHEET 1 OF 36


FED. ROAD DIST. NO.	STATE	FED. AID PROJ. NO.	FISCAL YEAR	SHEET NO.	TOTAL SHEETS
9	VT.	NRN 898	1934	4	36


(1935)

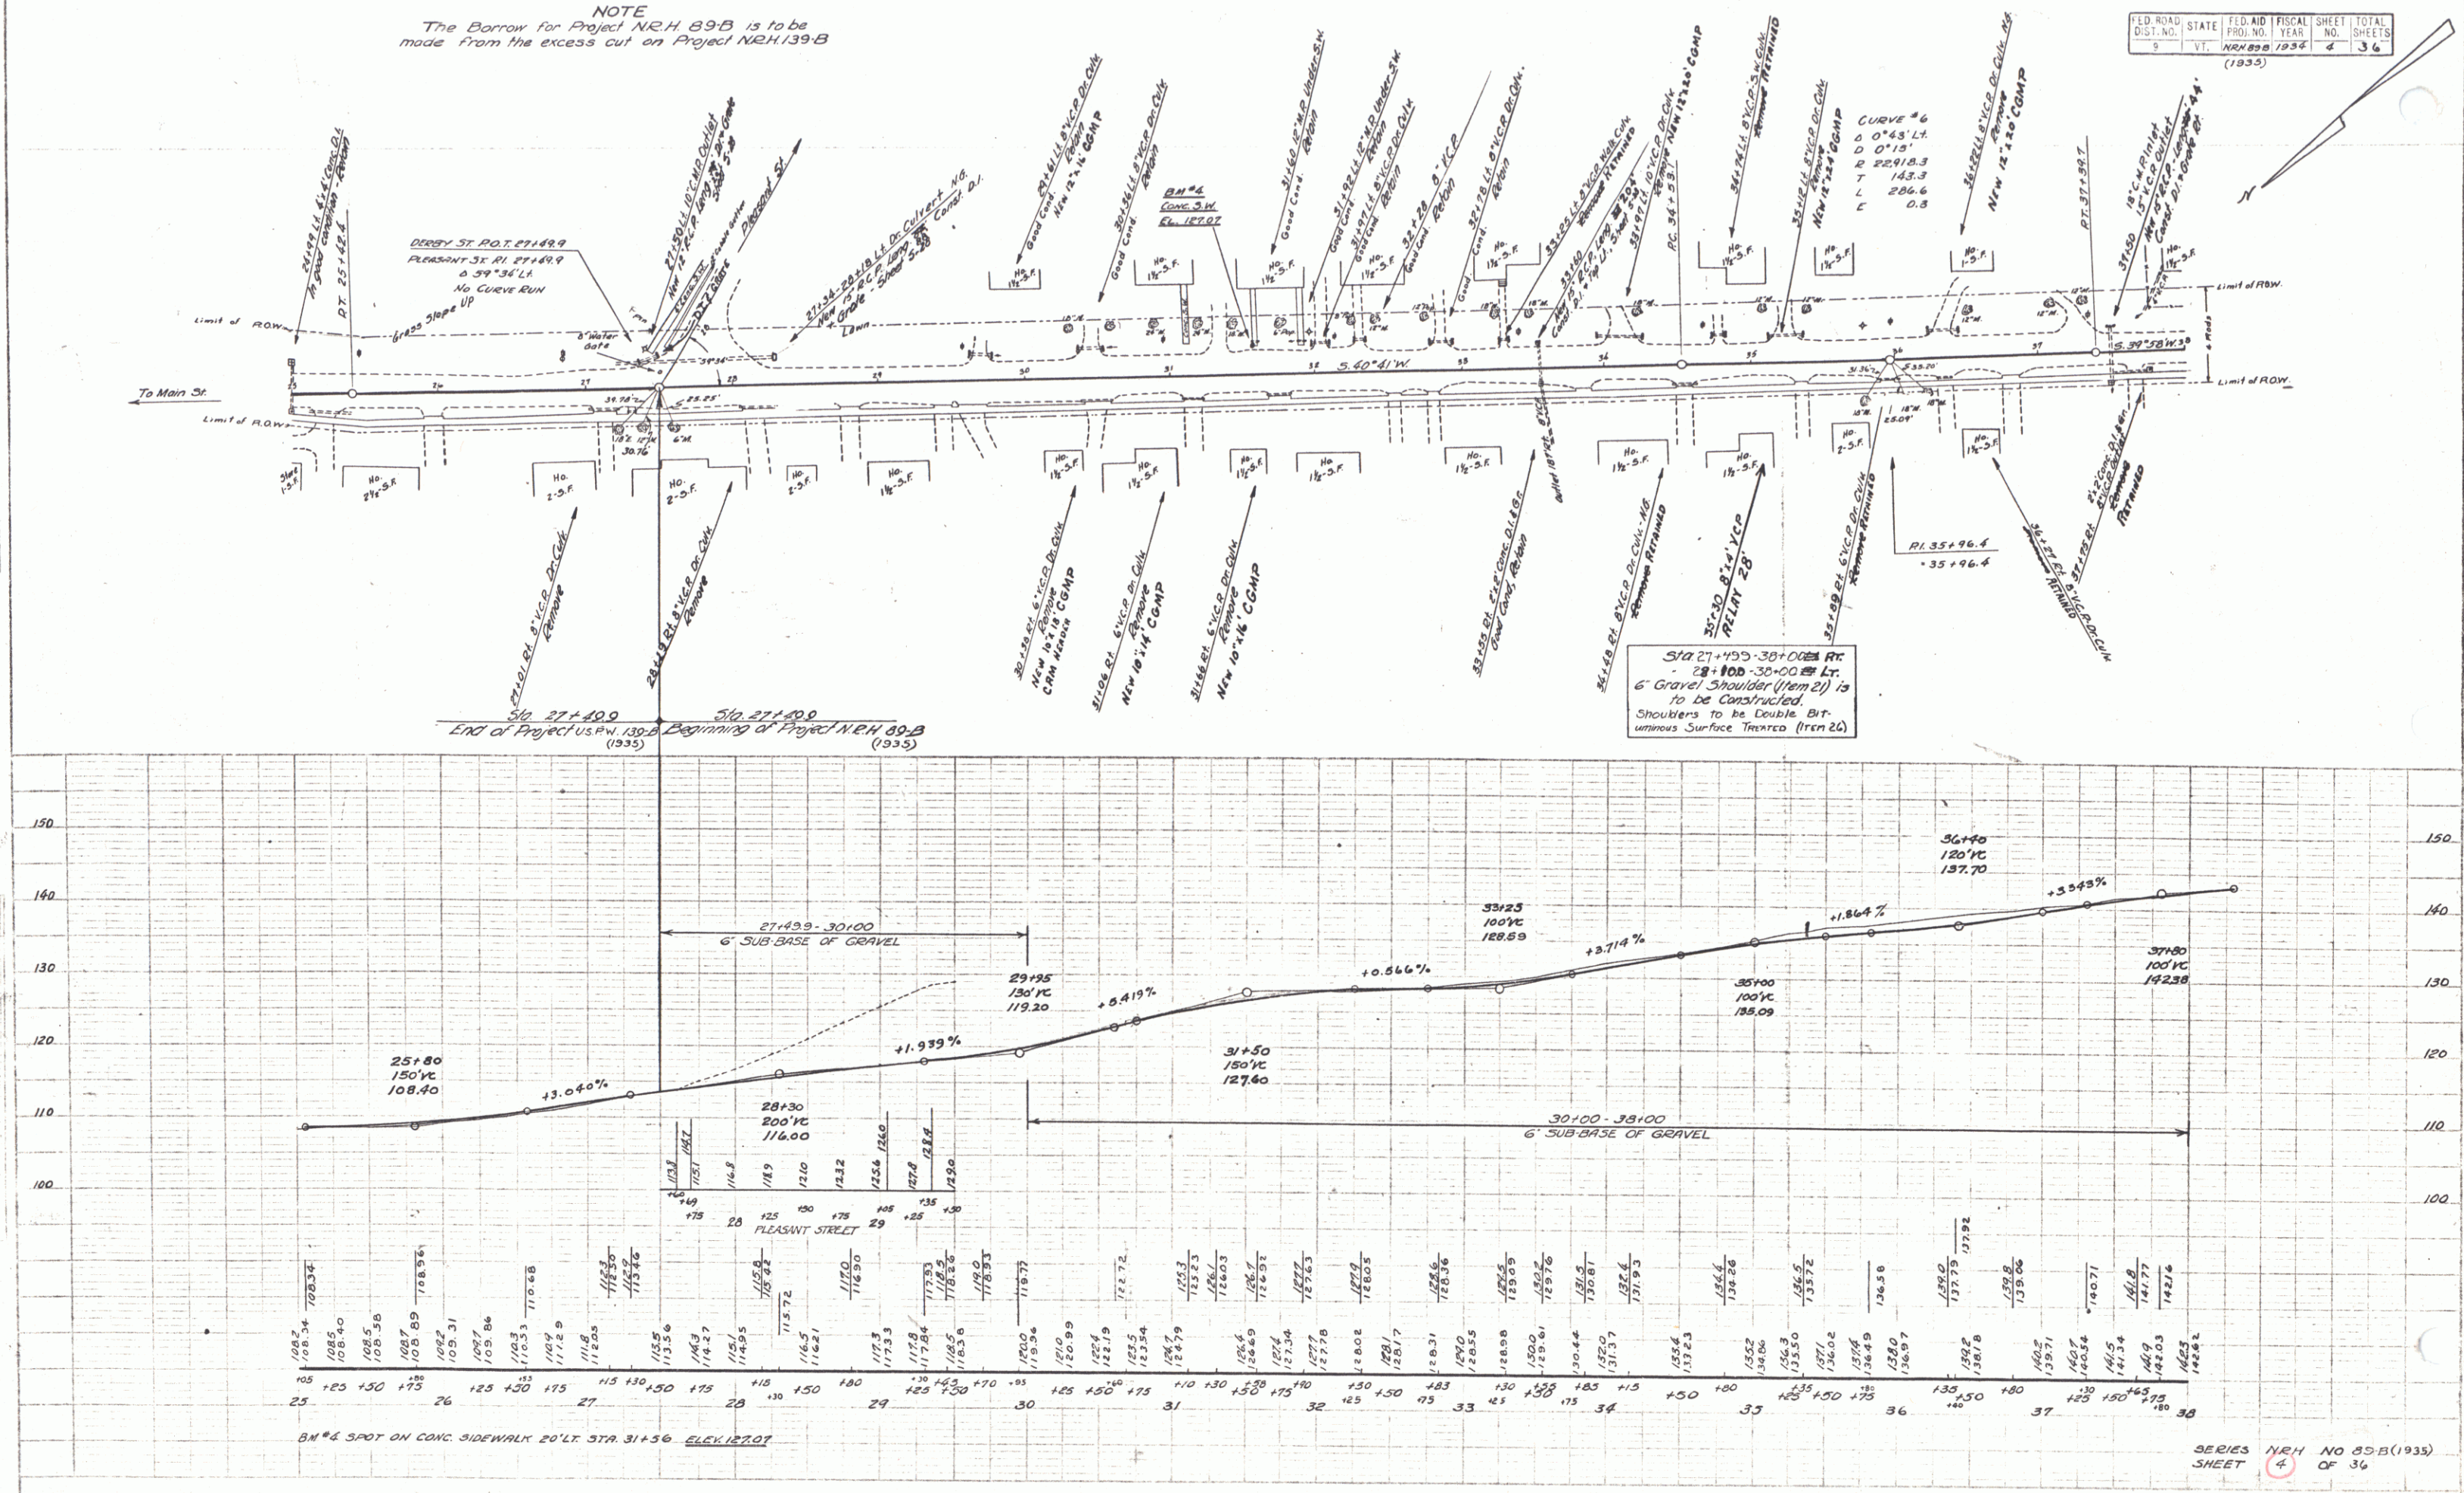

PLAN
Scale
1" = 40'
Notes
1. All work to be done in accordance with the specifications of the Vermont Department of Highways.
2. All work to be done in accordance with the plans and specifications of the Vermont Department of Highways.
3. All work to be done in accordance with the plans and specifications of the Vermont Department of Highways.

SECTION
Scale
1" = 10'
Notes
1. All work to be done in accordance with the specifications of the Vermont Department of Highways.
2. All work to be done in accordance with the plans and specifications of the Vermont Department of Highways.
3. All work to be done in accordance with the plans and specifications of the Vermont Department of Highways.

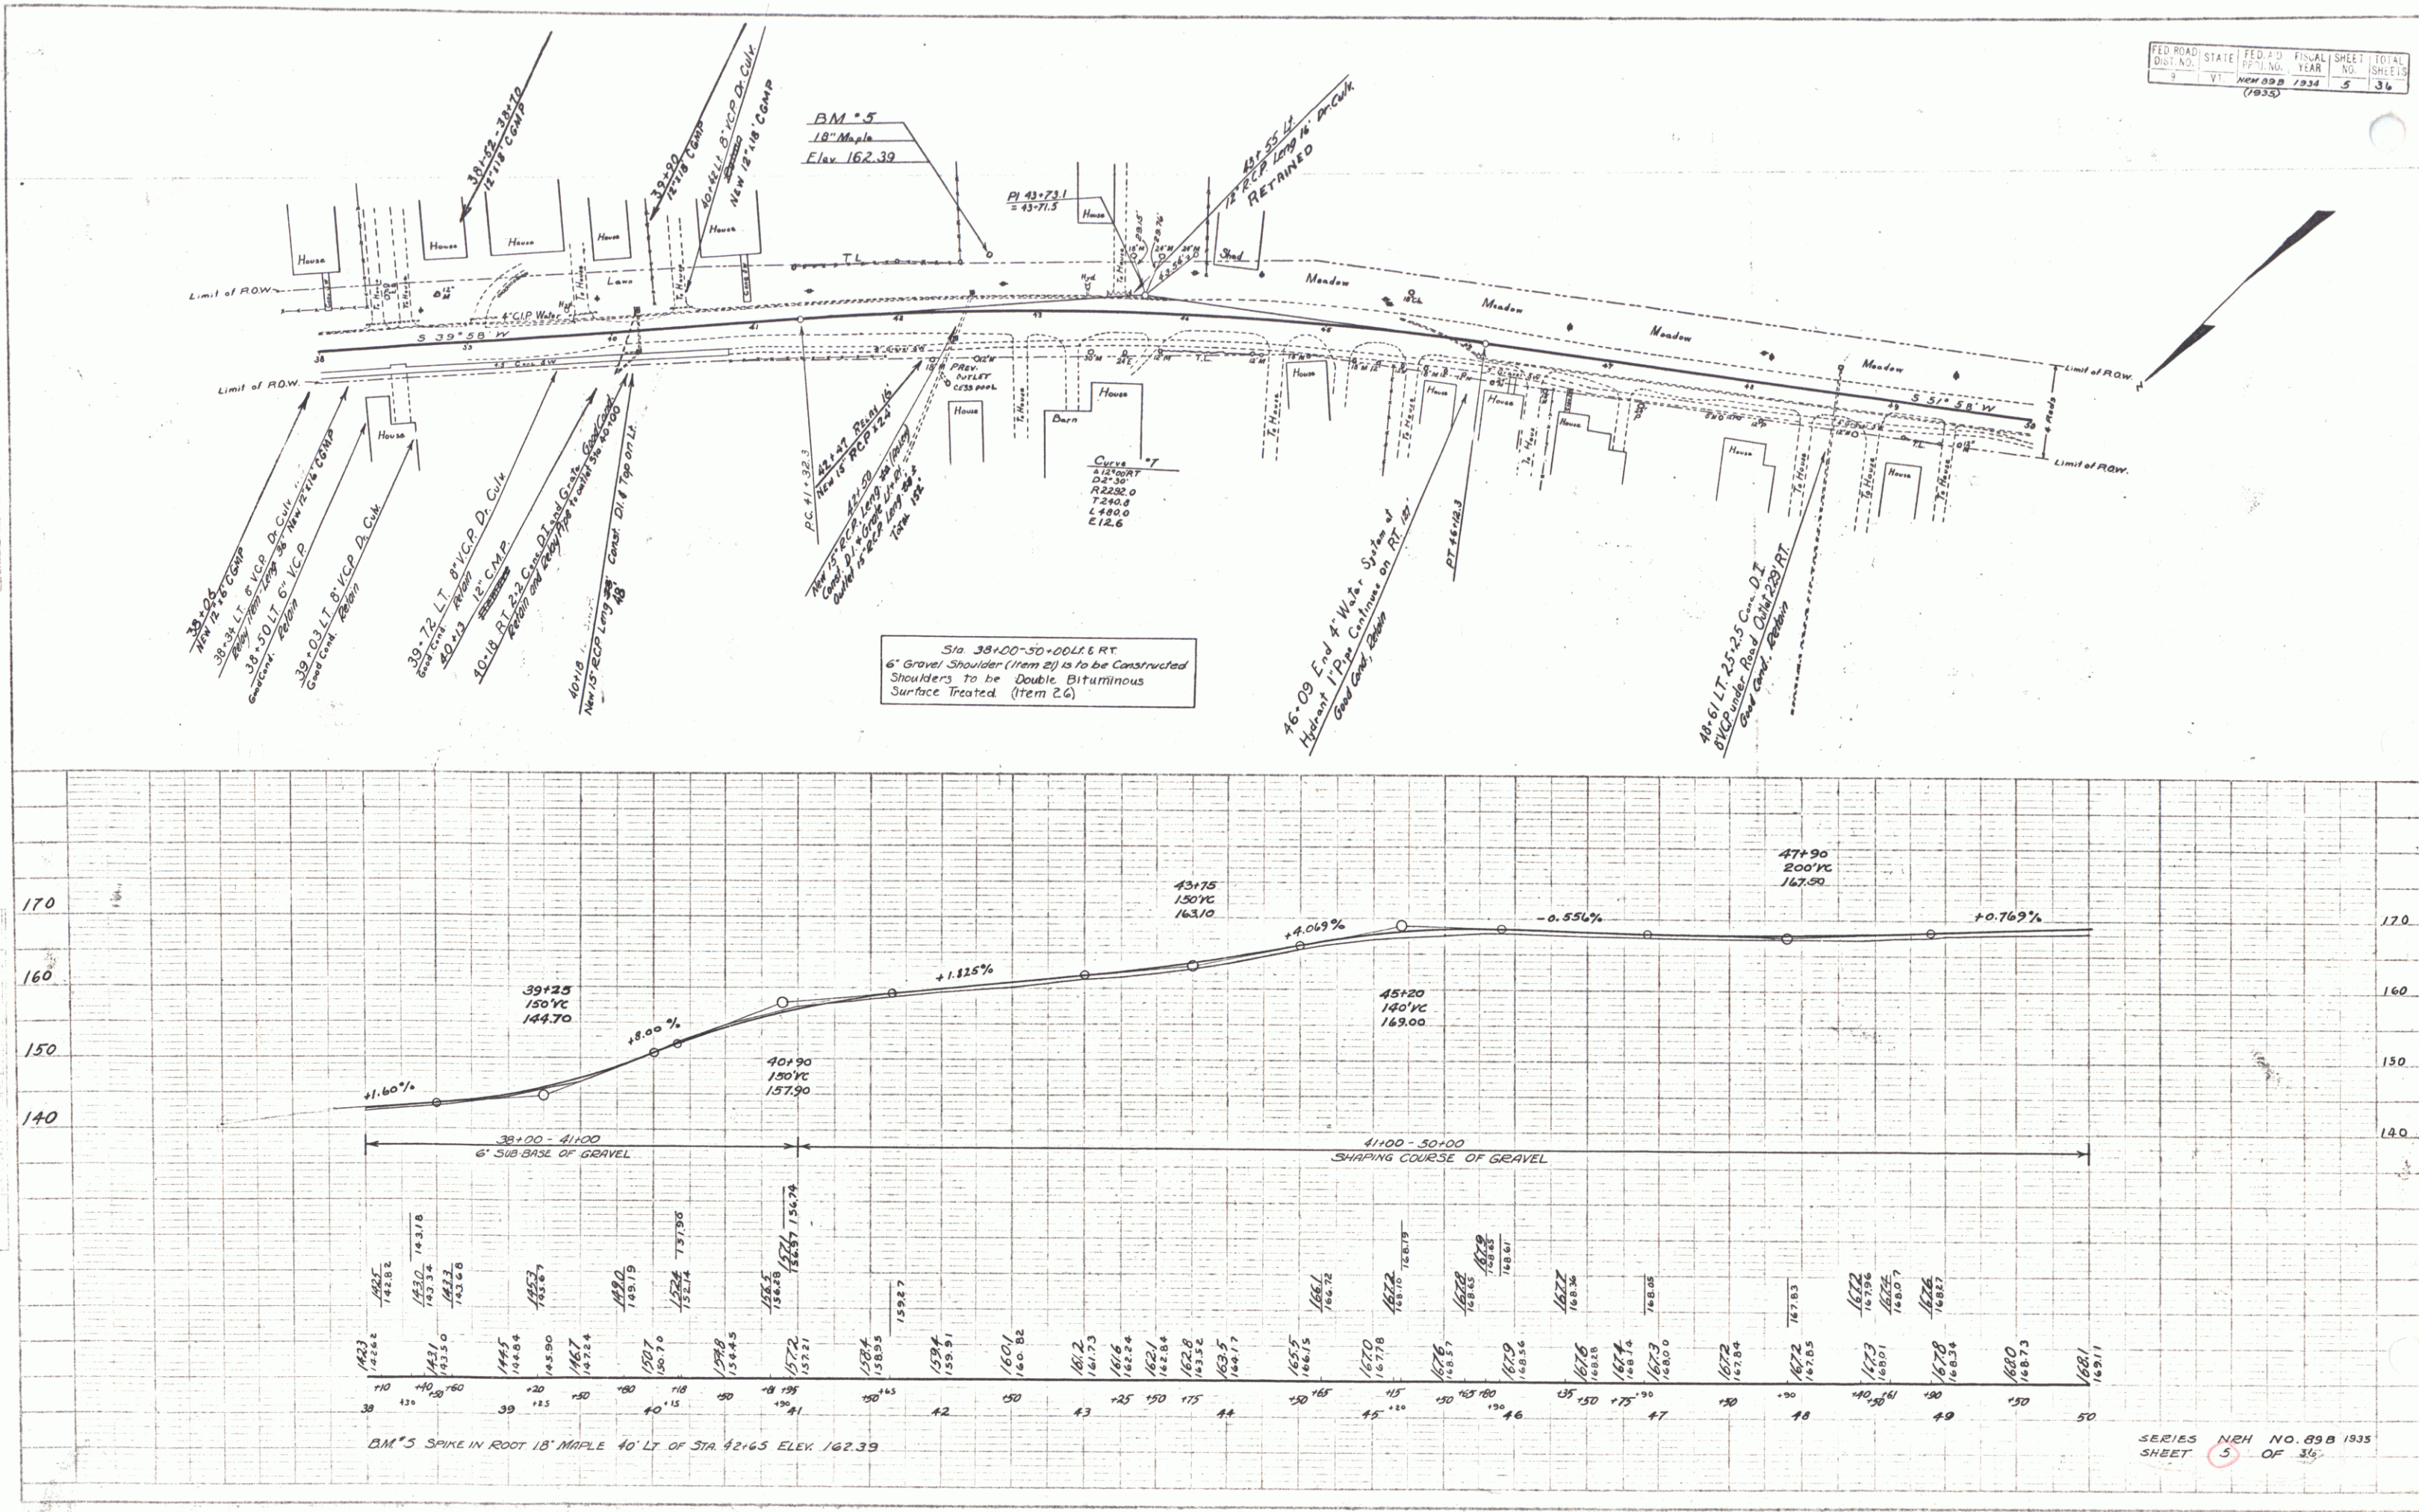


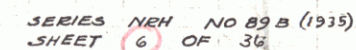

FED. ROAD DIST. NO.	STATE	FED. AID PROJ. NO.	FISCAL YEAR	SHEET NO.	TOTAL SHEETS
9	VT.	NRH 898	1934	7	36

(1935)

PUTNAM
D. MACCHI


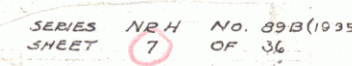


Parcel Map of Date of Grantor Grantee Recorded Remarks
 Instrument Brighton
 Book Page Date
 11-27-34 F. Pufford Stet. H. 19 11-8 12-11-34 City Sta. 2046

FED. ROAD STATE FED. NO. FISCAL SHEET TOTAL
 DIST. NO. PROJ. NO. YEAR NO. SHEETS
 1 1 1934 8 36
 (1935)

B. M. #10
 D. MACCHI

B. M. #10
 D. MACCHI

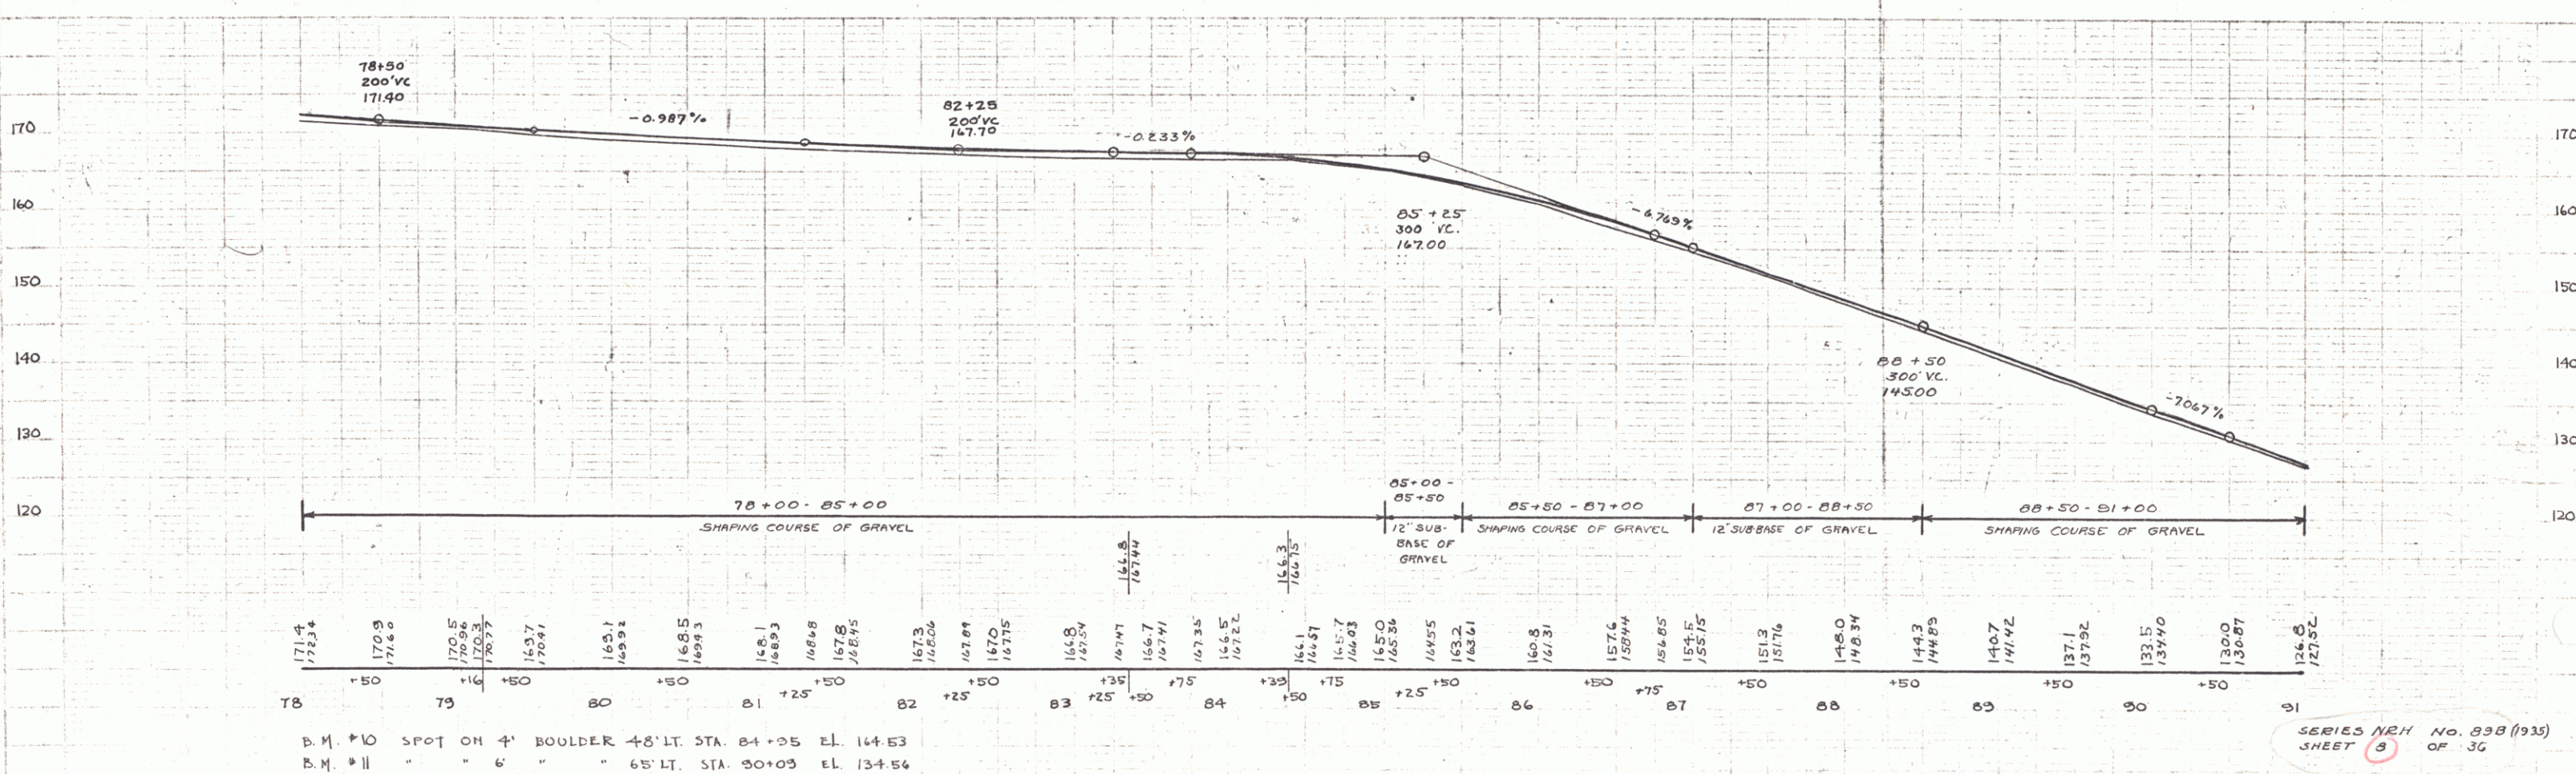
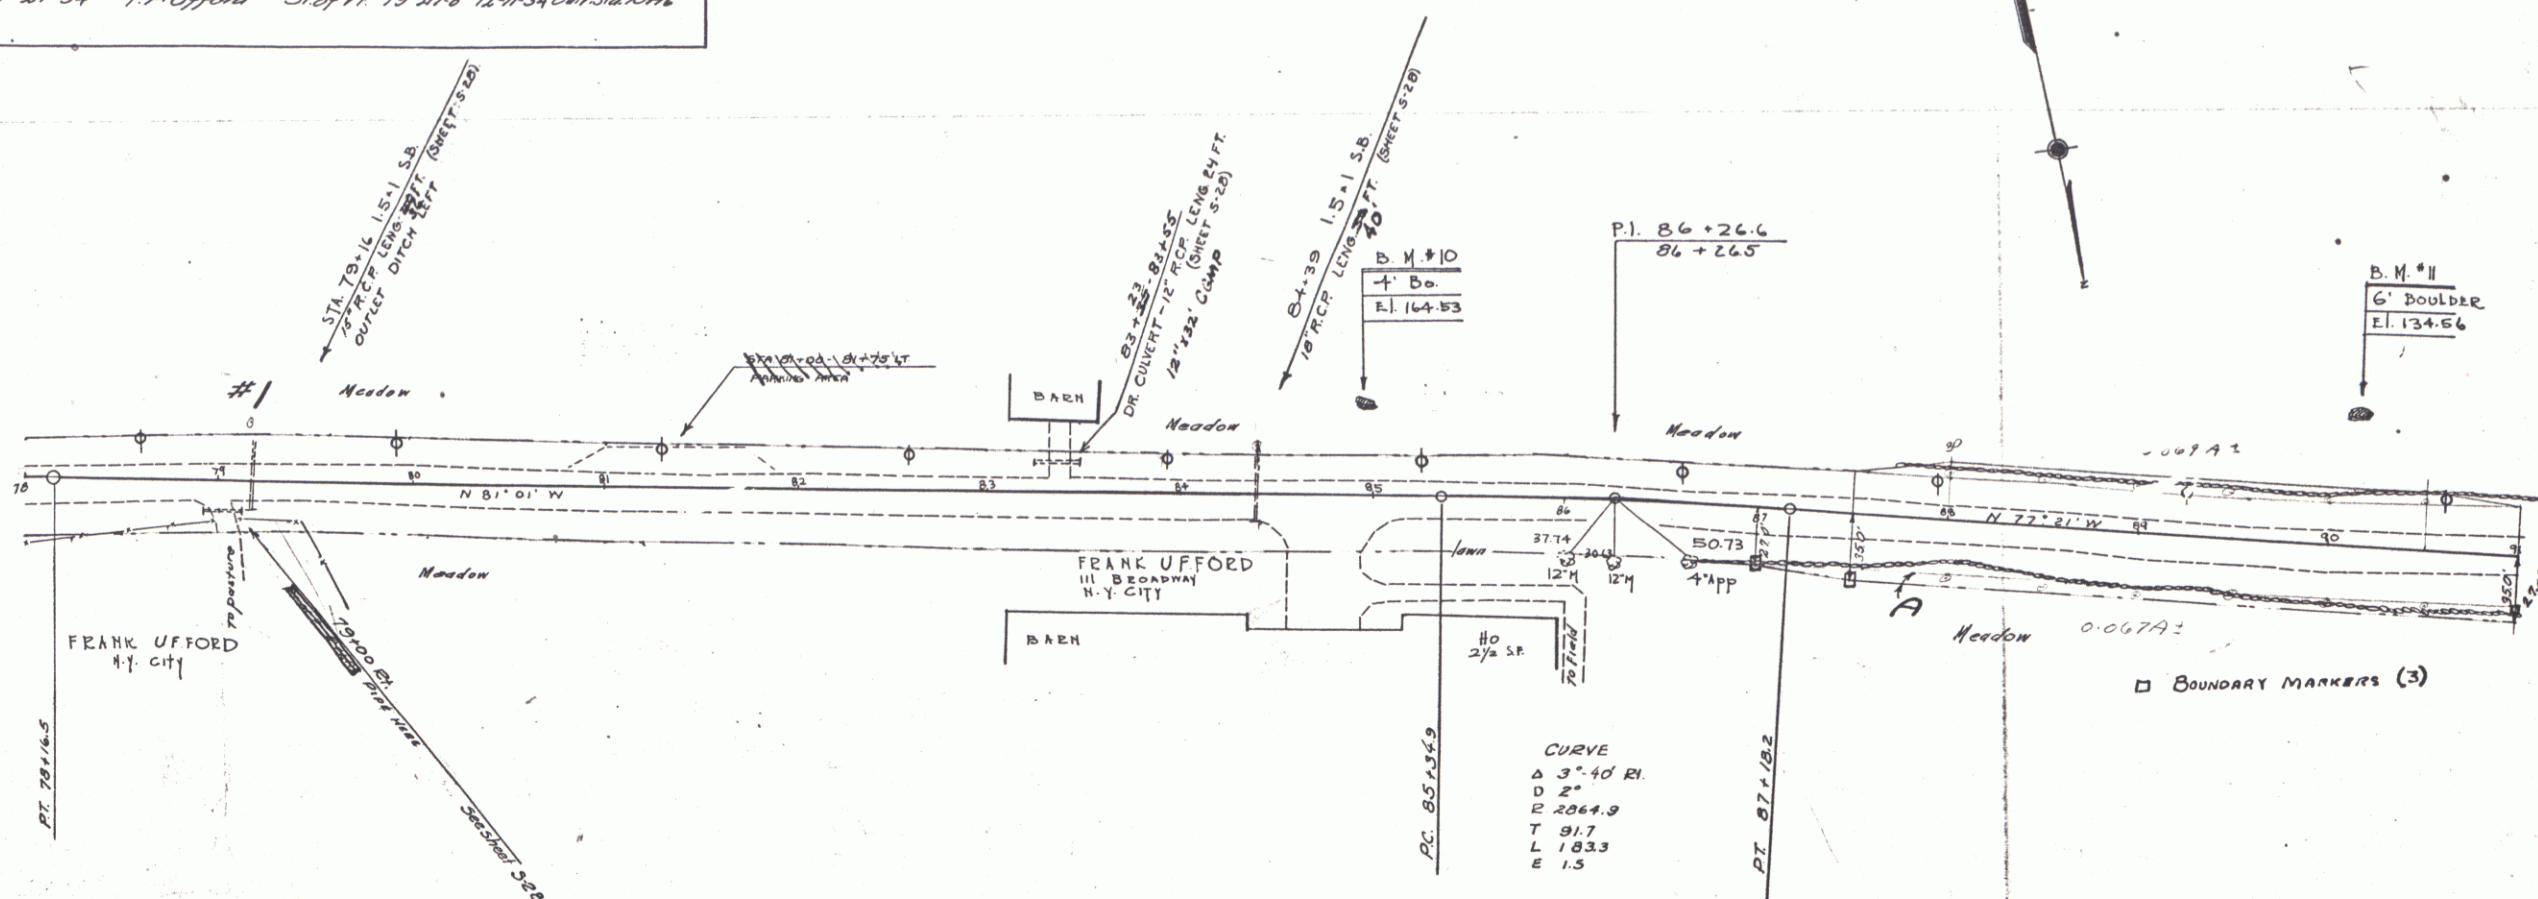


SERIES N.H. No. 938 (1935)
 SHEET 3 OF 36

Parcel Aerial of Date of Grantor Grantee Recorded Remarks
 Instrument
 043 QCD 11-27-34 F. Pufford Slope 13 31-3 12-11-34

1935 ROAD STATE PLD. AND FISCAL SHEET
 NO. 100 PROJ. NO. 1337 9 36
 V. 1. NRH 058 1937 (1935)



POTNAM 7/34
 D. MACCHI 7/34
 LEASED

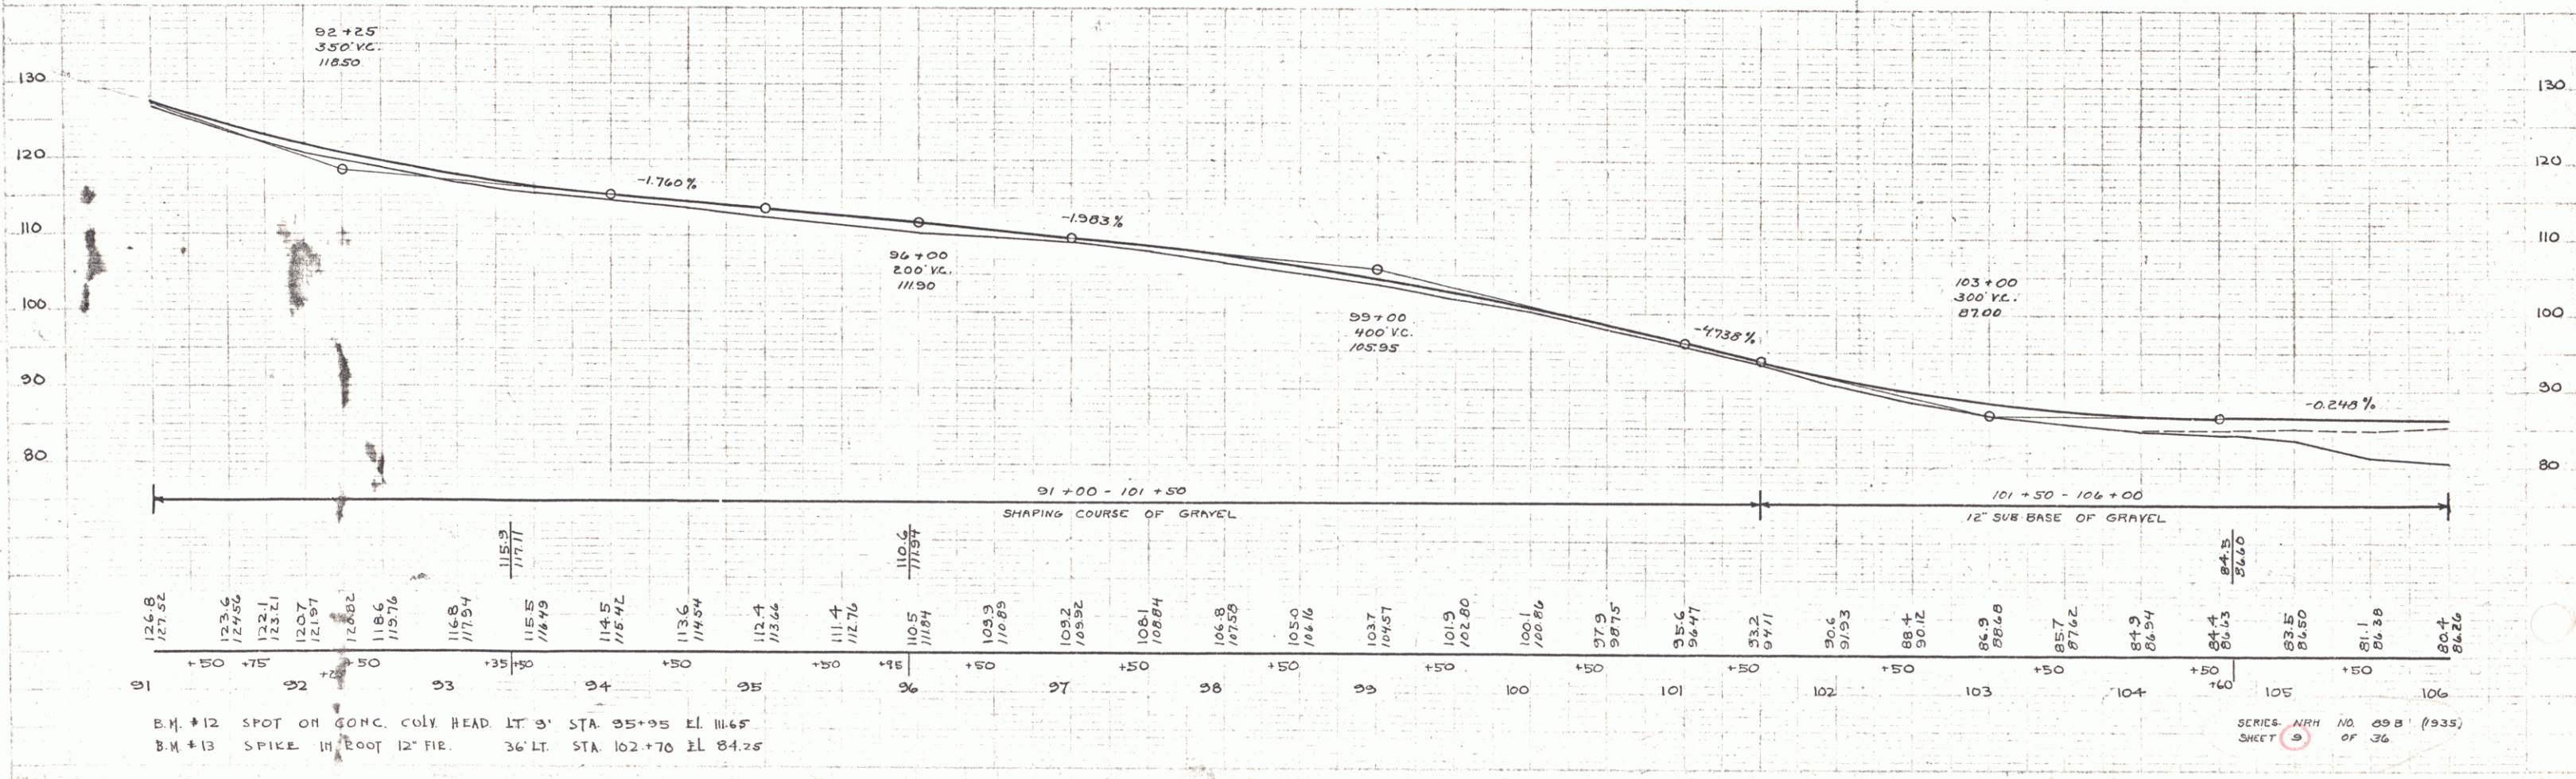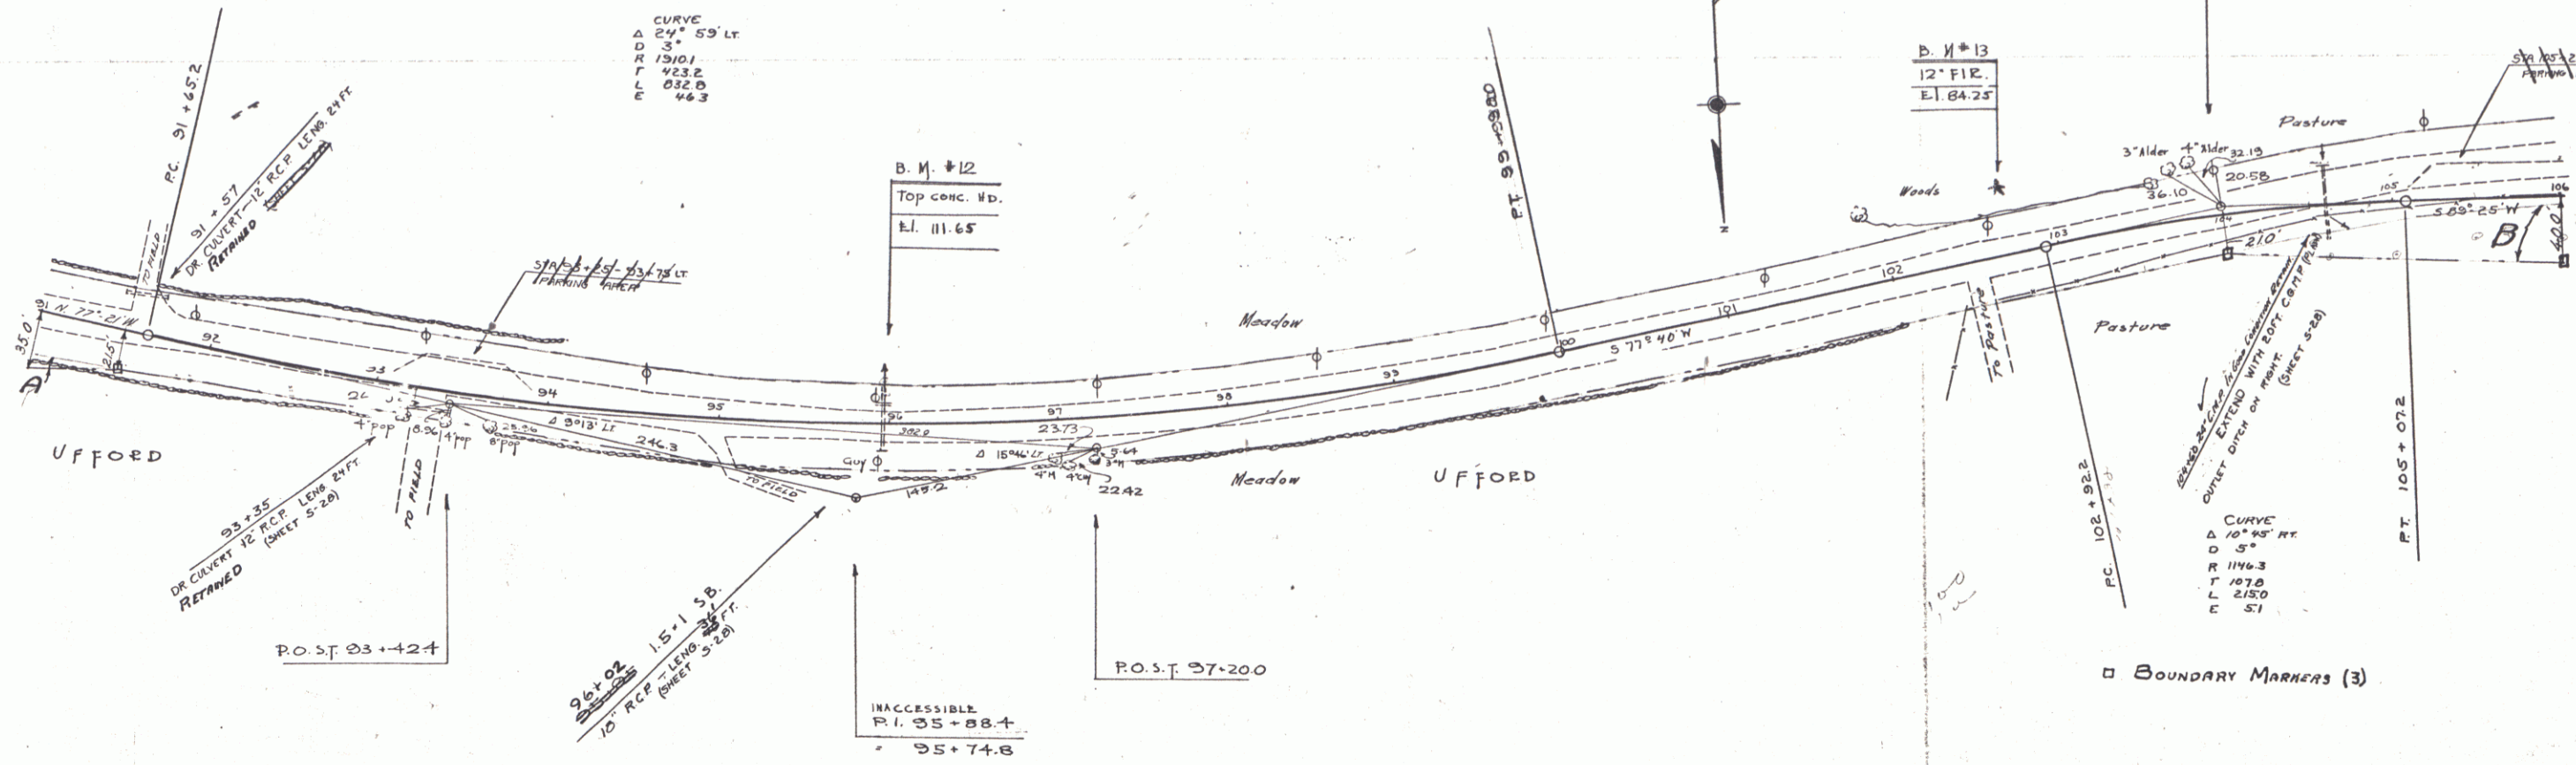

FED. ROAD DIST. NO.	STATE	FED. RD PROJ. NO.	PLAN YEAR	SHEET NO.	TOTAL SHEETS
9	VT.	NRH 098	1934	10	36

(1935)

FED ROAD DIST. NO.	STATE	FED. AID PROJ. NO.	FISCAL YEAR	SHEET NO.	TOTAL SHEETS
4	9T	89C	1936	4	34

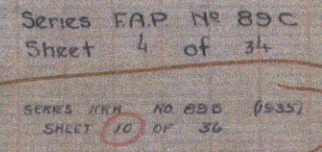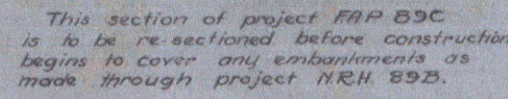

POTNAM
D. MACCHI
1/34
1/34