


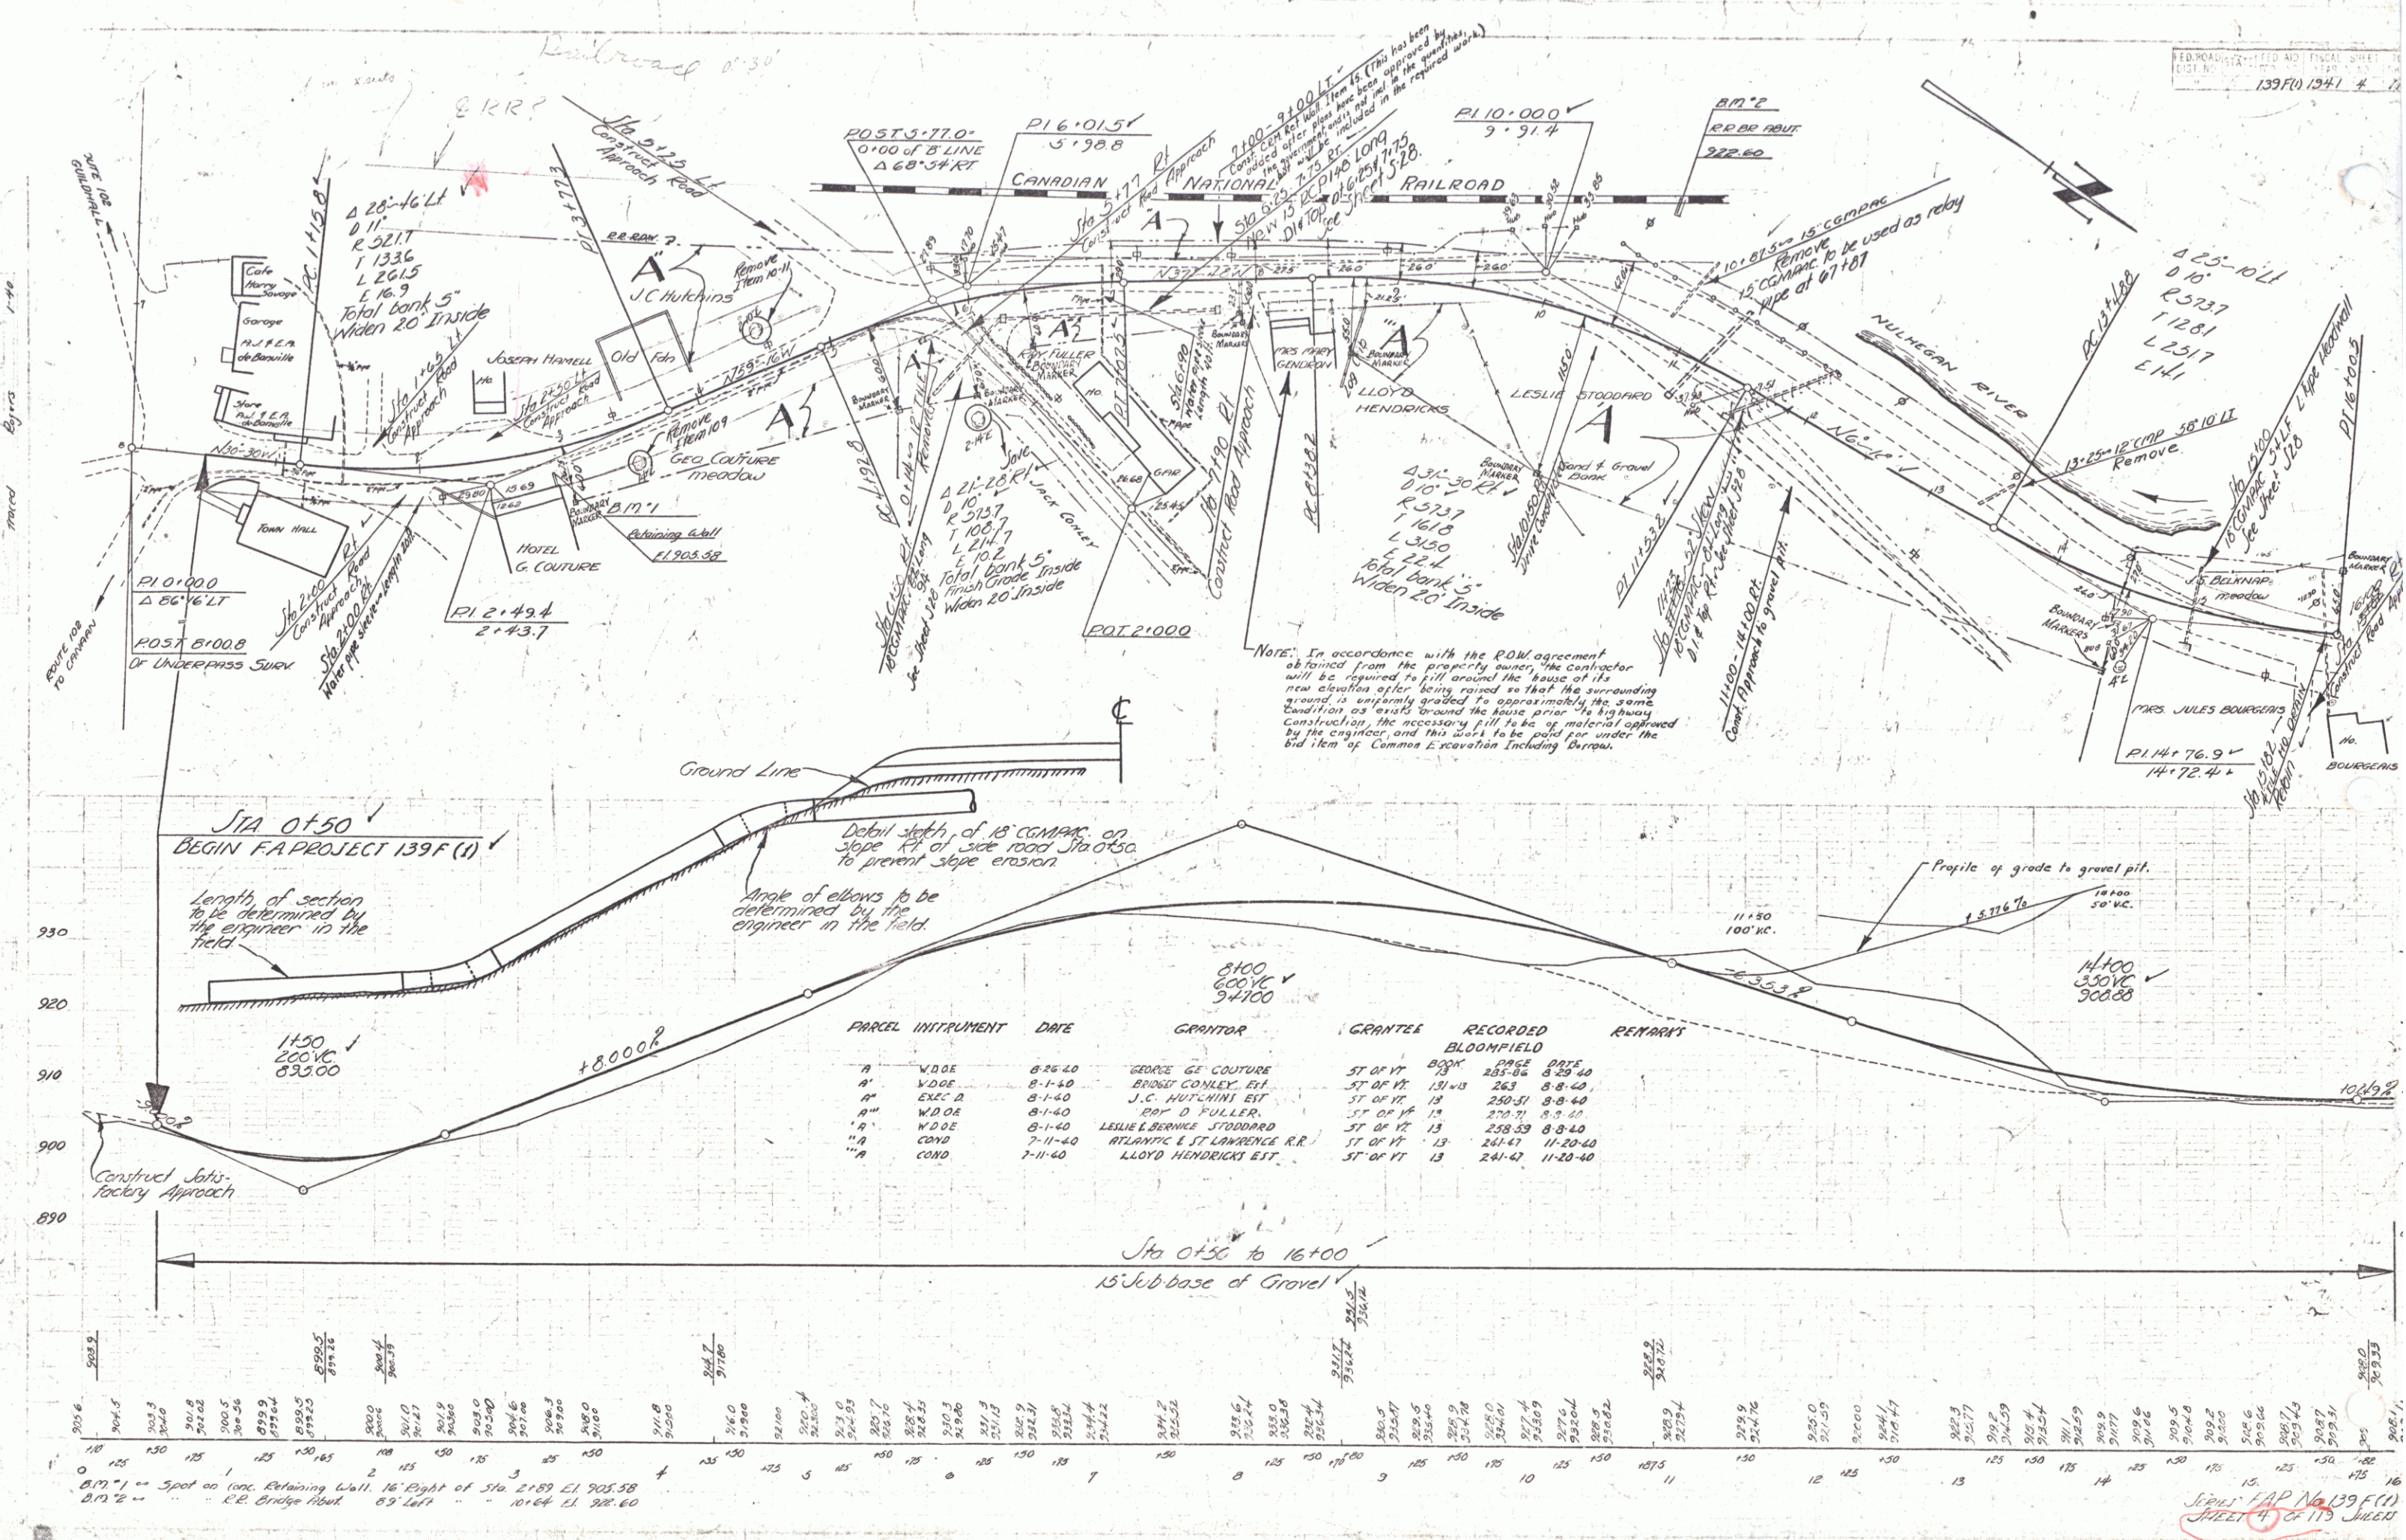

139F(1) 1341 #

Sheet 1 of 115 JUL 67