

INDEX OF SHEETS

SHEET NO.	TITLE PAGE
1	TYPICAL CROSS-SECTION OF IMPROVEMENT { Grading, Base & Drainage, with Guard Rail, and Double Tack Coat of Refined Tar. Item 29.
2	BANKING AND WIDENING TABLES
3	PLAN AND PROFILE STA.
4-18	STANDARD STRUCTURE SHEET
19	STANDARD STRUCTURE SHEET
20	"
21	"
22	"
23	"
24	"
25	"
26	DETAILS OF WINGS FOR 4'x5' RC BOX.
27-119	CROSS SECTION SHEETS.

STANDARD STRUCTURE SHEETS APPROVED
BY THE CHIEF ENGINEER:
S-28 JULY 11, 1933.
S-30 AUG. 15, 1934.

(To Be Returned to R.O.W. Division)
Town of Bloomfield
Perpetual
Right-of-Way Division

STATE OF VERMONT STATE HIGHWAY DEPARTMENT

PLAN AND PROFILE OF PROPOSED STATE HIGHWAY

FEDERAL AID PROJECT


TOWN OF BLOOMFIELD

BLOOMFIELD-ISLAND POND ROAD Route VT 105

BEGINNING AT THE INTERSECTION OF ROUTE 102
AND 105 IN BLOOMFIELD VILLAGE AND EXTENDING
NORTHWESTERLY ON ROUTE 105 4.213 MILES.

LENGTH OF PROJECT 21,697.4 FT.=4.109 MI.


FED. ROAD DIST. NO.	STATE	FED. AID PROJ. NO.	FISCAL YEAR	SHEET NO.	TOTAL SHEETS
9	VT.	139-F(1)	1941	1	119

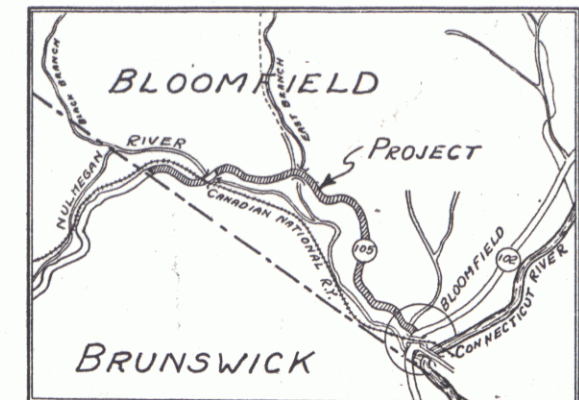

SCALE: 1" = 1 MILE

RECORD PLANS

By AC Birnie 6/5/42

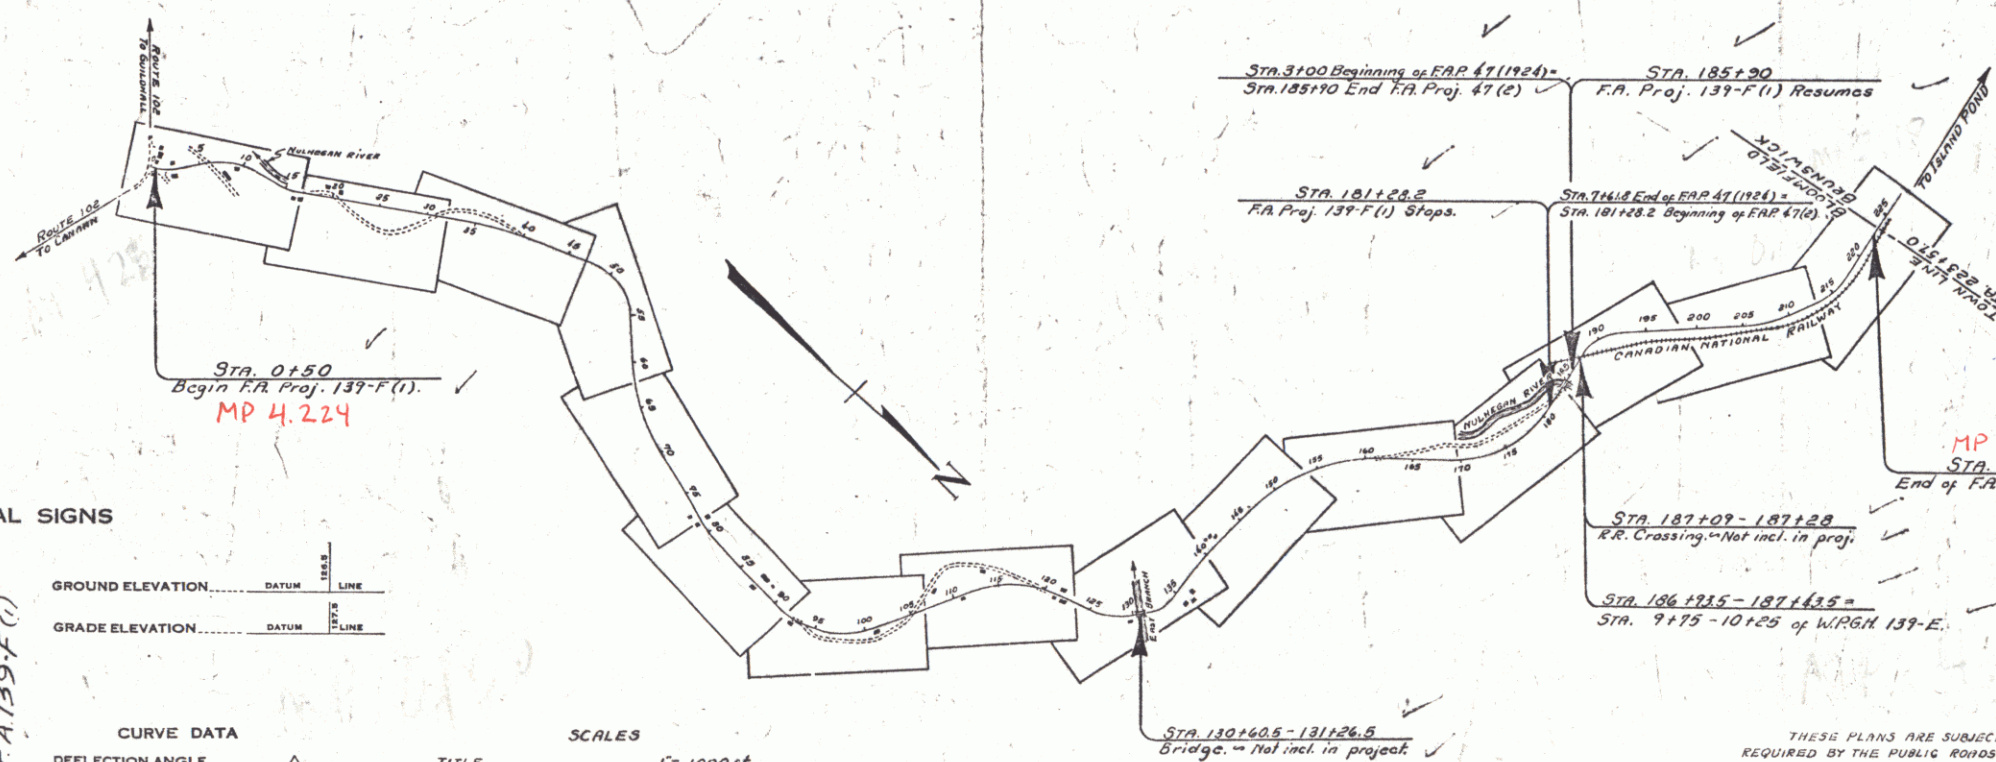

ENTIONAL SIGNS

GROUND ELEVATION.....	DATUM	LINE
GRADE ELEVATION.....	DATUM	LINE

CURVE DATA

DEFLECTION ANGLE.....	Δ
DEGREE OF CURVE.....	D
RADIUS OF CURVE.....	R
TANGENT DISTANCE.....	T
LENGTH OF CURVE.....	L
EXTERNAL DISTANCE.....	E
POINT OF INTERSECTION.....	P. I.
POINT OF CURVE.....	P. C.
POINT OF TANGENT.....	P. T.
POINT ON TANGENT.....	P. O. T.

SCALES

TITLE.....	1" = 1000 ft.
TYPICAL.....	1" = 50 ft.
PLAN.....	1" = 100 ft.
PROFILE.....	1" = 50 ft.
CROSS SECTIONS.....	1" = 5 ft.

THESE PLANS ARE SUBJECT TO SUCH REVISIONS AS MAY BE REQUIRED BY THE PUBLIC ROADS ADMINISTRATION OR THE COMMISSIONER OF HIGHWAYS.

CONSTRUCTION IS TO BE CARRIED ON IN ACCORDANCE WITH THE PLANS AND THE STANDARD ROAD AND BRIDGE SPECIFICATIONS OF 1936, AS APPROVED DECEMBER 28TH, 1936, BY THE PUBLIC ROADS ADMINISTRATION, INCLUDING ALL SUBSEQUENT APPROVED REVISIONS AND SUCH REVISED SPECIFICATIONS AND SPECIAL PROVISIONS AS ARE SUBMITTED WITH THE PLANS.

APPROVED: May 31, 1942

H. J. Langford

COMMISSIONER OF HIGHWAYS

SUBMITTED BY ORDER OF THE STATE HIGHWAY BOARD

RECOMMENDED FOR APPROVAL


DISTRICT ENGINEER
PUBLIC ROADS ADMINISTRATION
FEDERAL WORKS DIVISION

APPROVED


COMMISSIONER
PUBLIC ROADS ADMINISTRATION
FEDERAL WORKS DIVISION

APPROVED: May 31, 1942	APPROVED: June 1, 1942	SERIES: F.A.P. No. 139-F(1) FILED
ENGINEER	DISTRICT HIGHWAY COMMISSIONER	SHEET 1 OF 119


DIST. # 9 PLANS

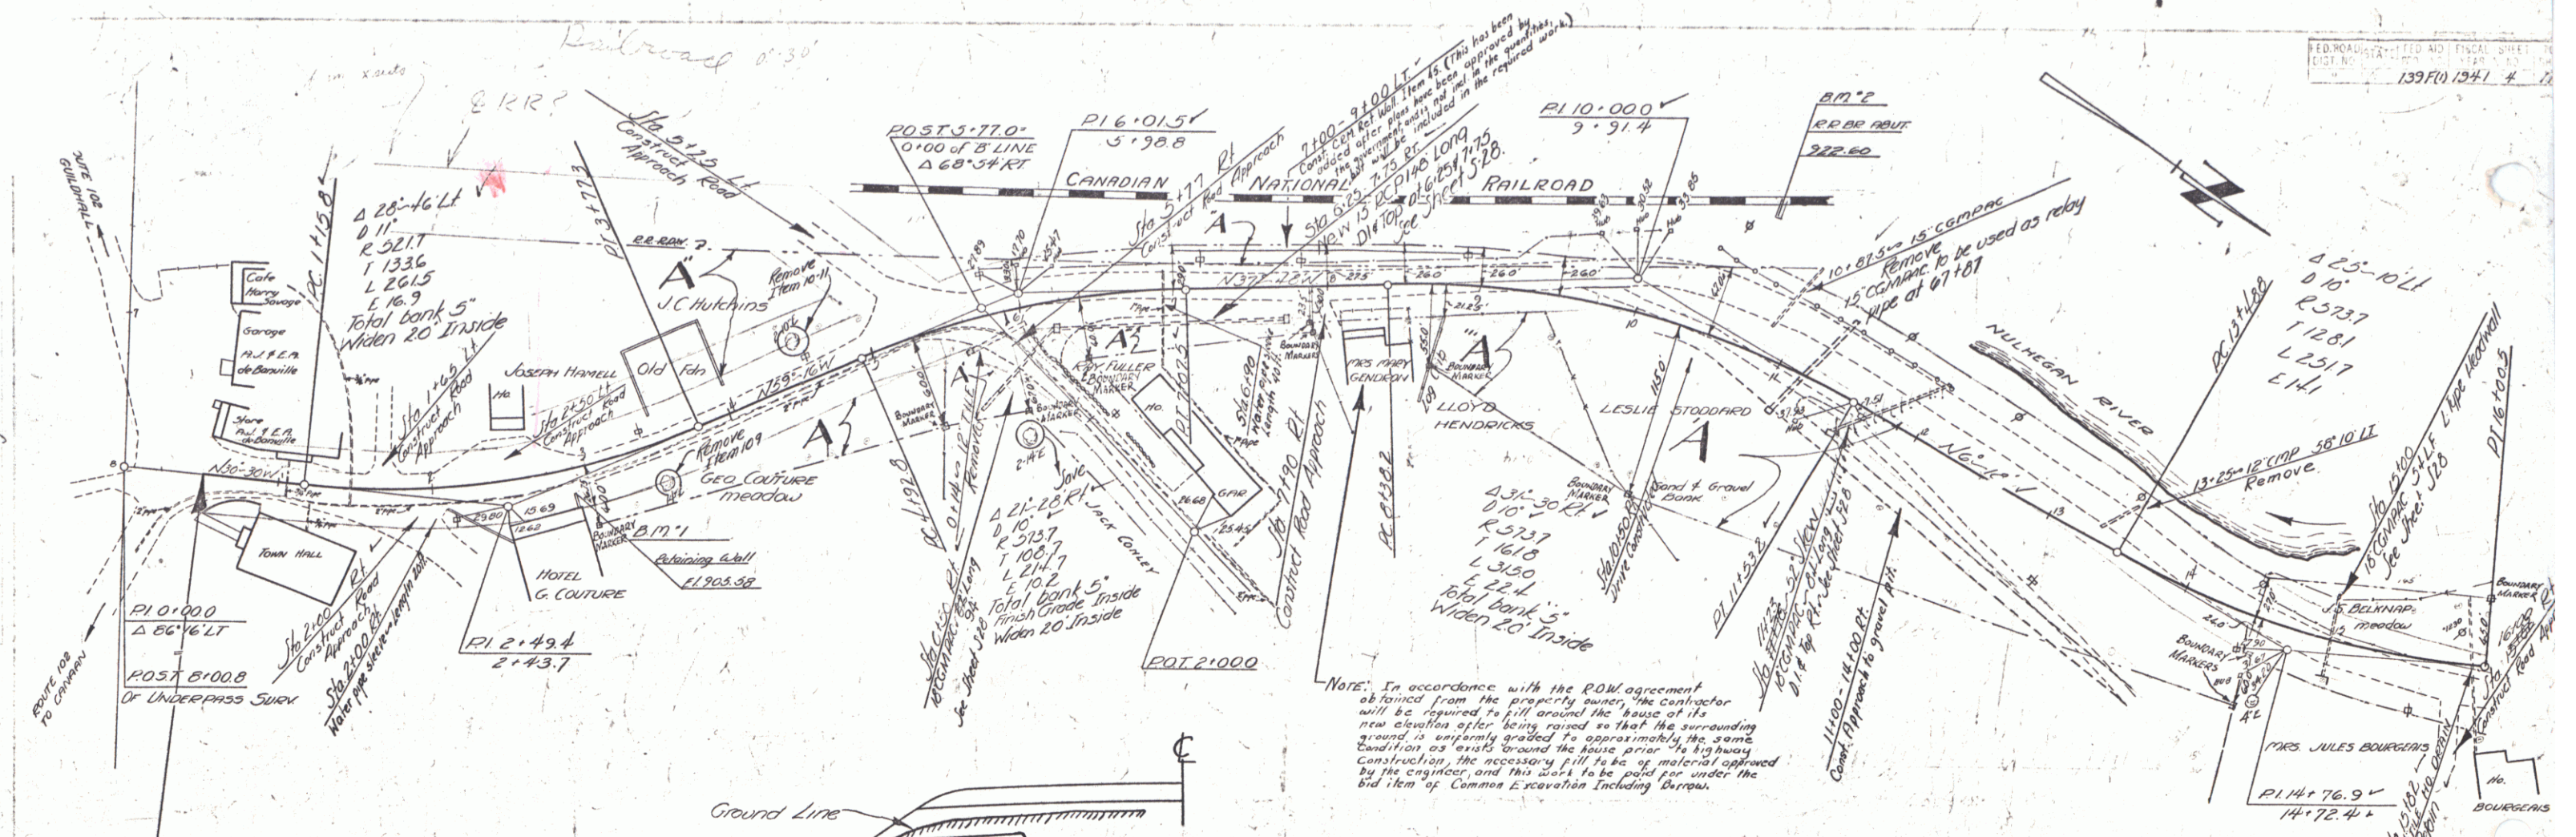


Note: In accordance with the ROW agreement obtained from the property owner, the contractor will be required to fill around the base of its new structure after being raised so that the surrounding ground is uniformly graded to approximately the same condition as exists around the base prior to highway construction. The necessary fill to be paid for under the bid item of Common Excavation including Surplus.

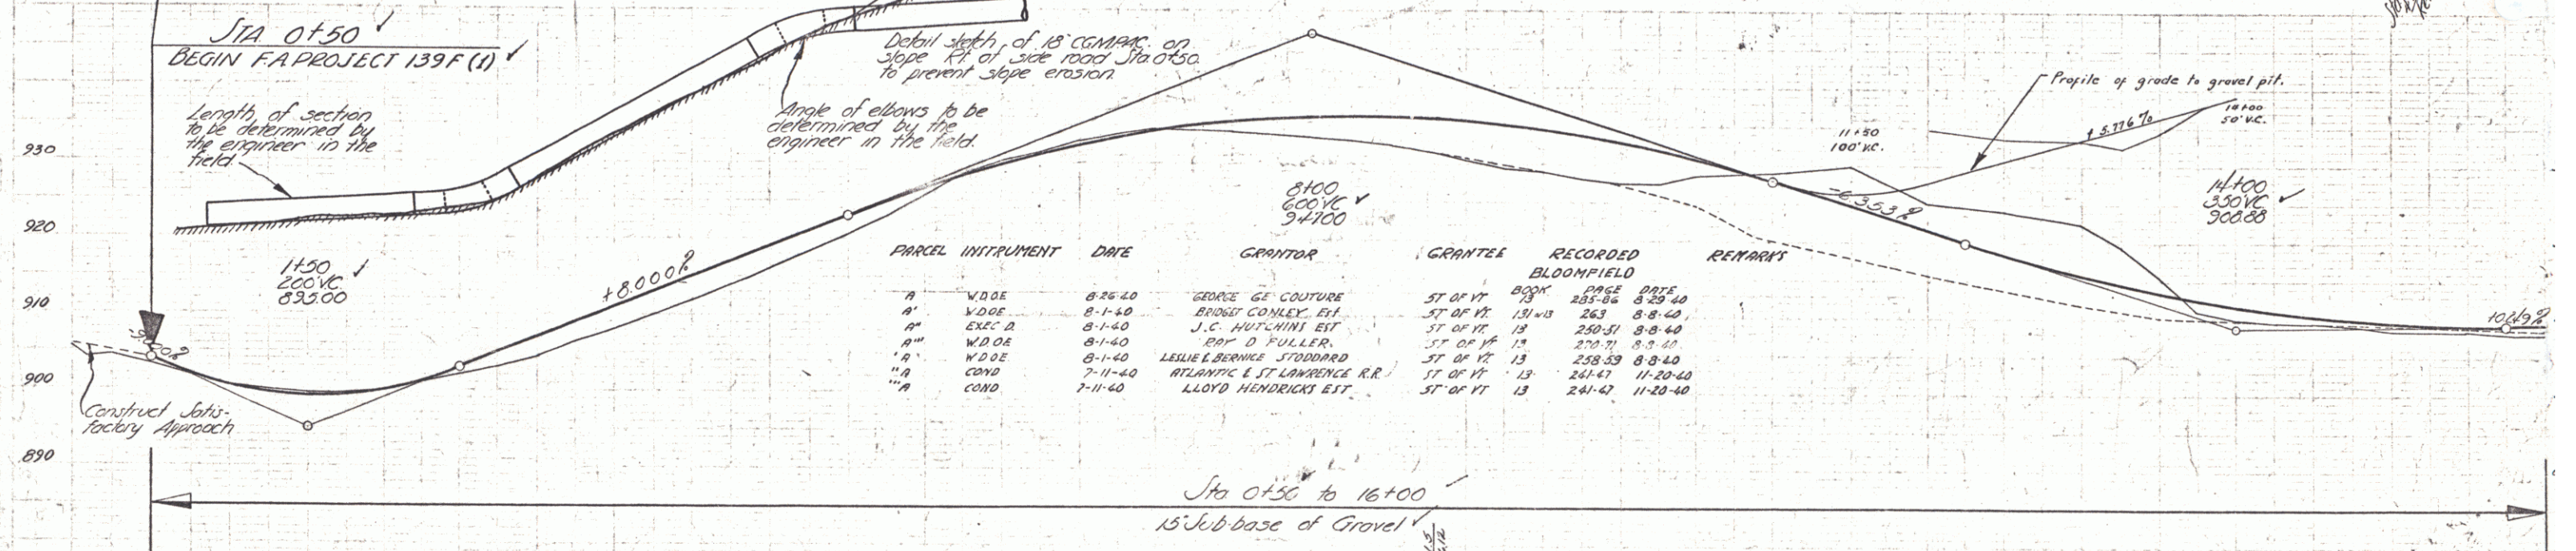


PARCEL	INSTRUMENT	DATE	GRANTOR	GRANTEE	RECORDED	REMARKS
A	W.D.O.E.	8-25-40	GEORGE G. COUTURE	ST. OF VT.	BOOK PAGE DATE	
A'	W.D.O.E.	8-1-40	BROOK CONLEY, ET.	ST. OF VT.	131-13 253 8-8-40	
A''	EXEC. D.	8-1-40	J.C. HUTCHINS ET.	ST. OF VT.	250-51 8-8-40	
A'''	W.D.O.E.	8-1-40	ED. D. FULLER	ST. OF VT.	270-71 8-8-40	
A''''	W.D.O.E.	8-1-40	LESLIE E. BERNES STODDARD	ST. OF VT.	258-33 8-8-40	
A'''''	COND.	7-11-40	ATLANTIC & ST. LAWRENCE R.R.	ST. OF VT.	241-47 11-20-40	
A''''''	COND.	7-11-40	LLOYD HENDRICKS ET.	ST. OF VT.	241-47 11-20-40	

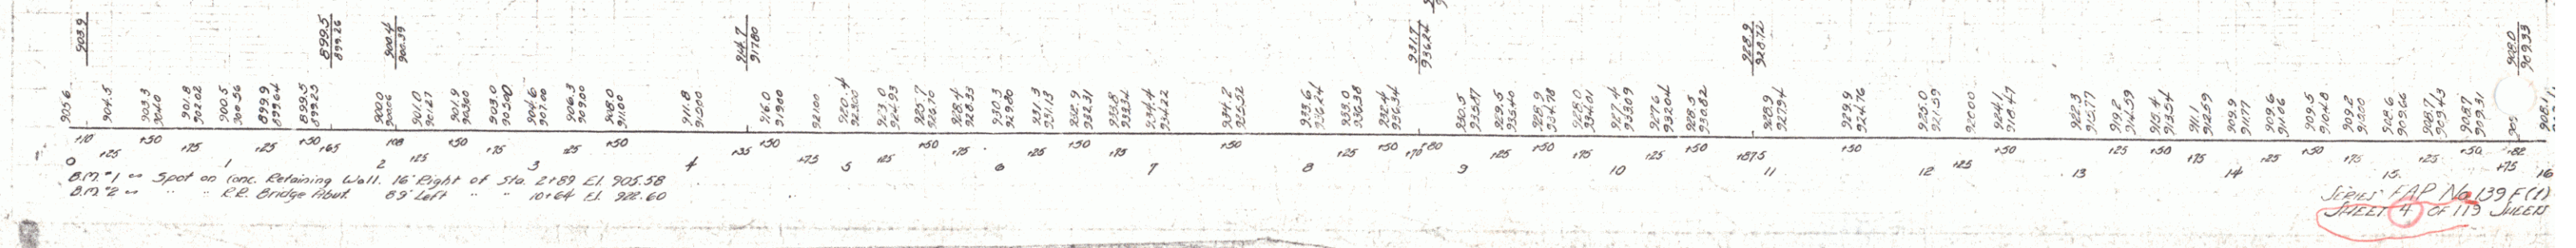


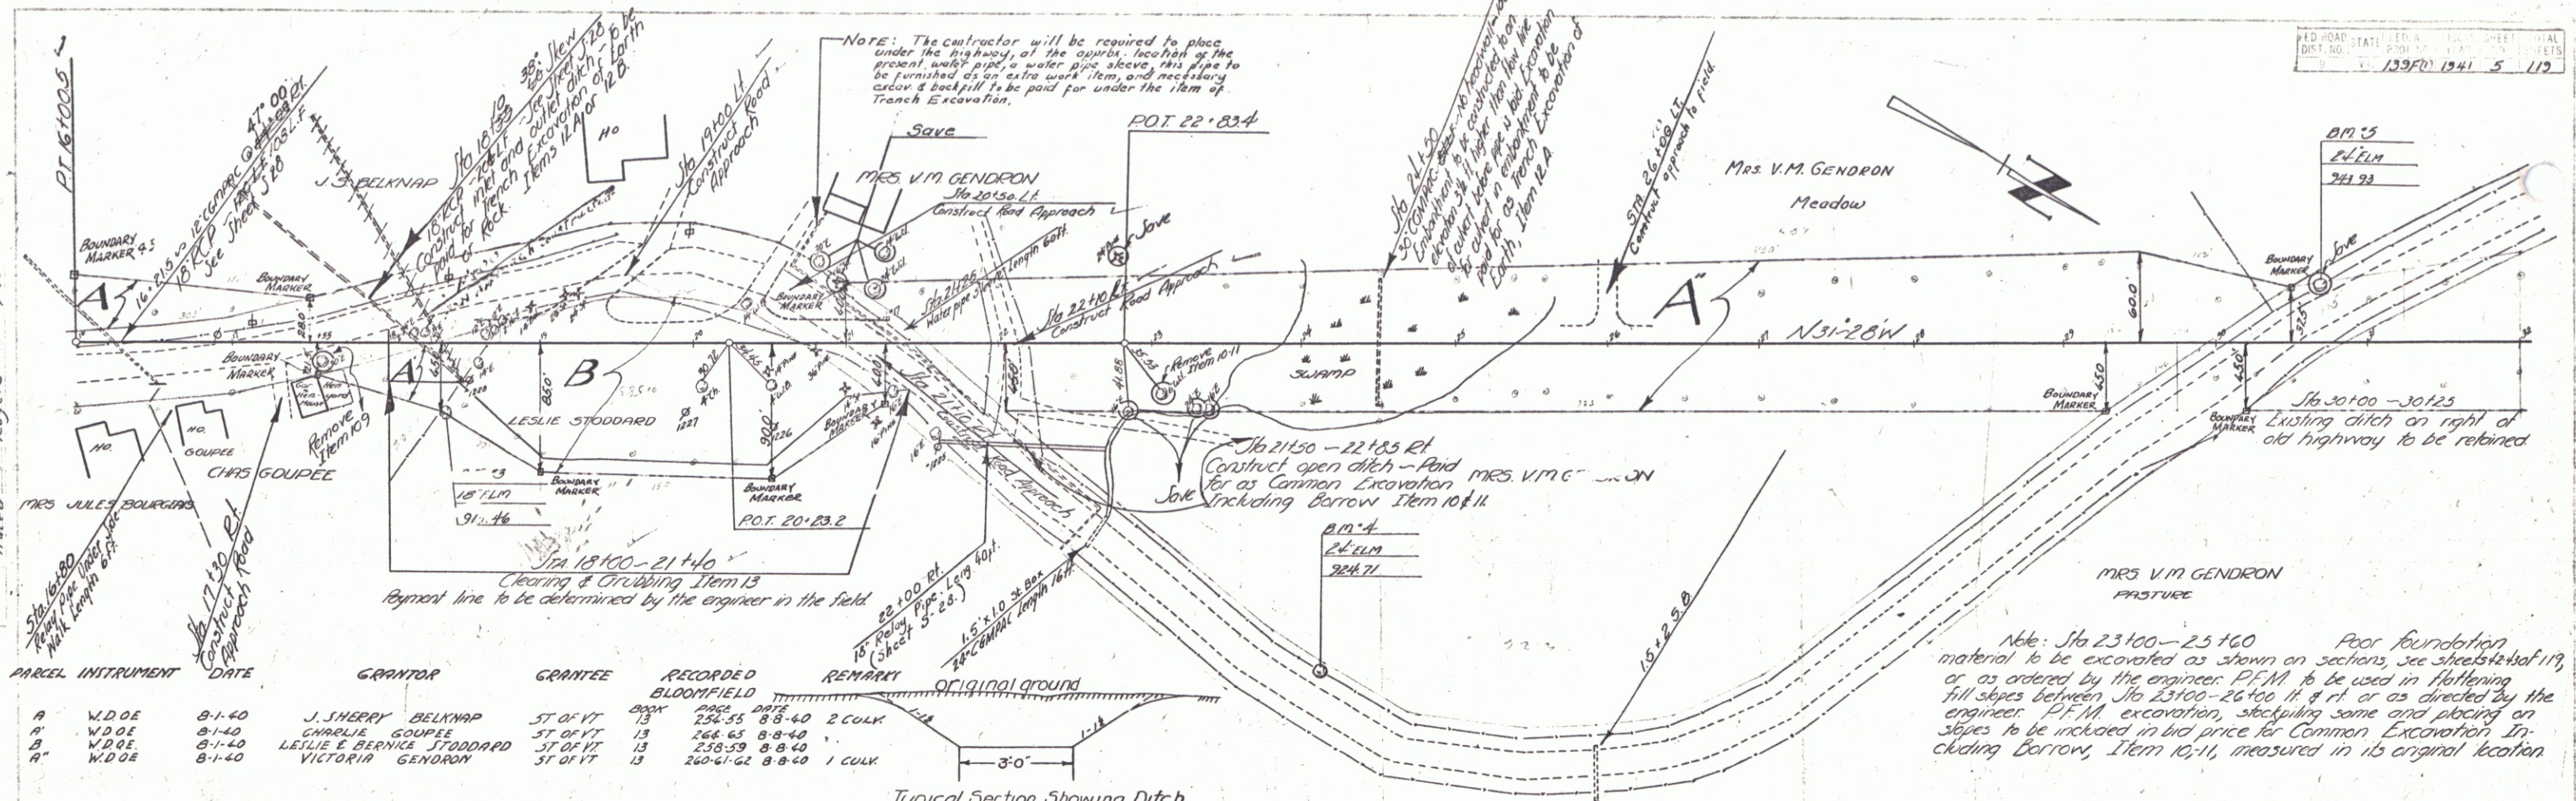


PARCEL	INSTRUMENT	DATE	GRANTOR	GRANTEE	RECORDED	REMARKS
A	W.D.O.E.	8-1-40	J. SHERRY BELKNAP	ST. OF VT.	13	258-55 8-8-40 2 CUL.
A'	W.D.O.E.	8-1-40	CHARLIE GOUPEE	ST. OF VT.	13	258-55 8-8-40 2 CUL.
B	W.D.O.E.	8-1-40	LESLIE E. BERNICE STODDARD	ST. OF VT.	13	258-55 8-8-40 2 CUL.
A''	W.D.O.E.	8-1-40	VICTORIA GENDRON	ST. OF VT.	13	260-61-62 8-8-40 1 CUL.

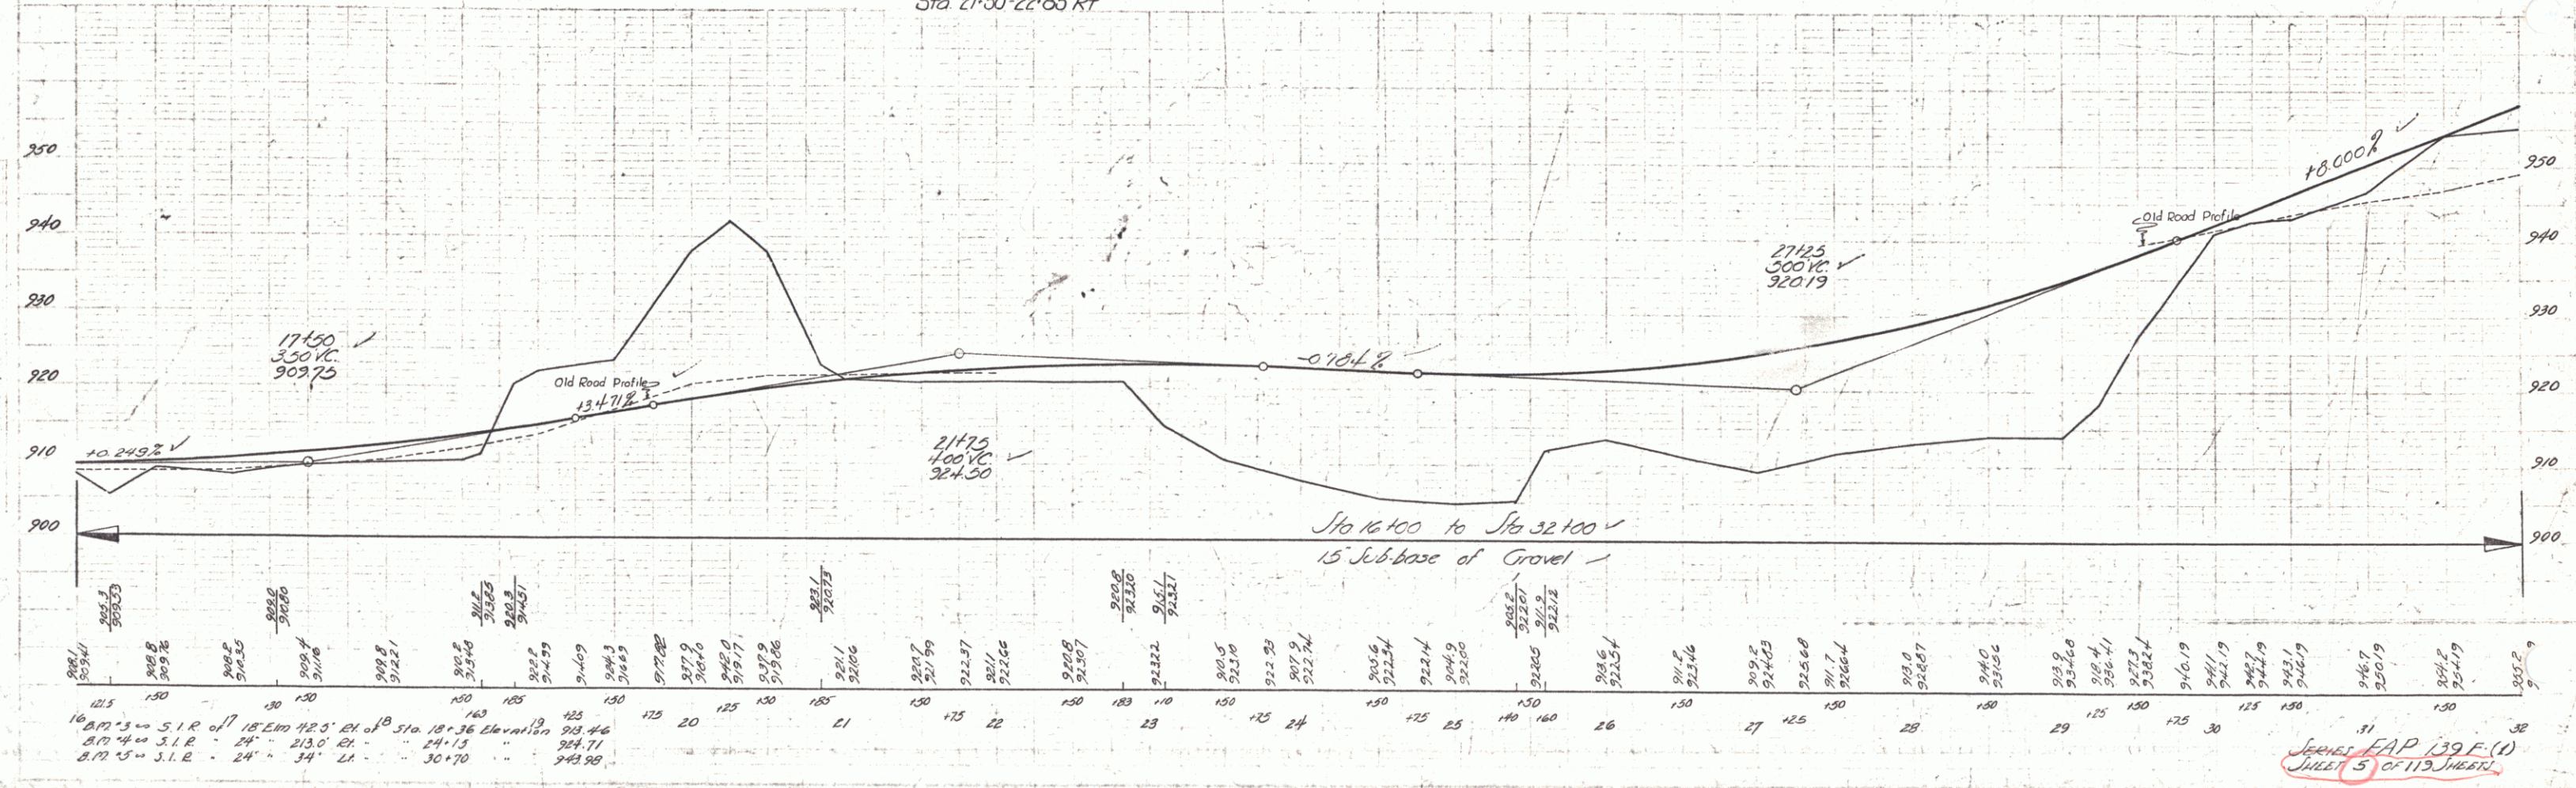


SEE PLAN 139 F. (1)
JULY 5 OF 113 SHEETS



FED. ROAD DIST. NO.	STATE	FED. AID FUNDAL. SHEET	TOTAL SHEET
9	VI.	139(R) 1941 6	119

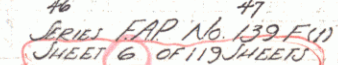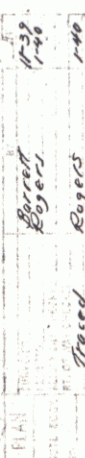


By	By	By	By
100	100	100	100
100	100	100	100
100	100	100	100

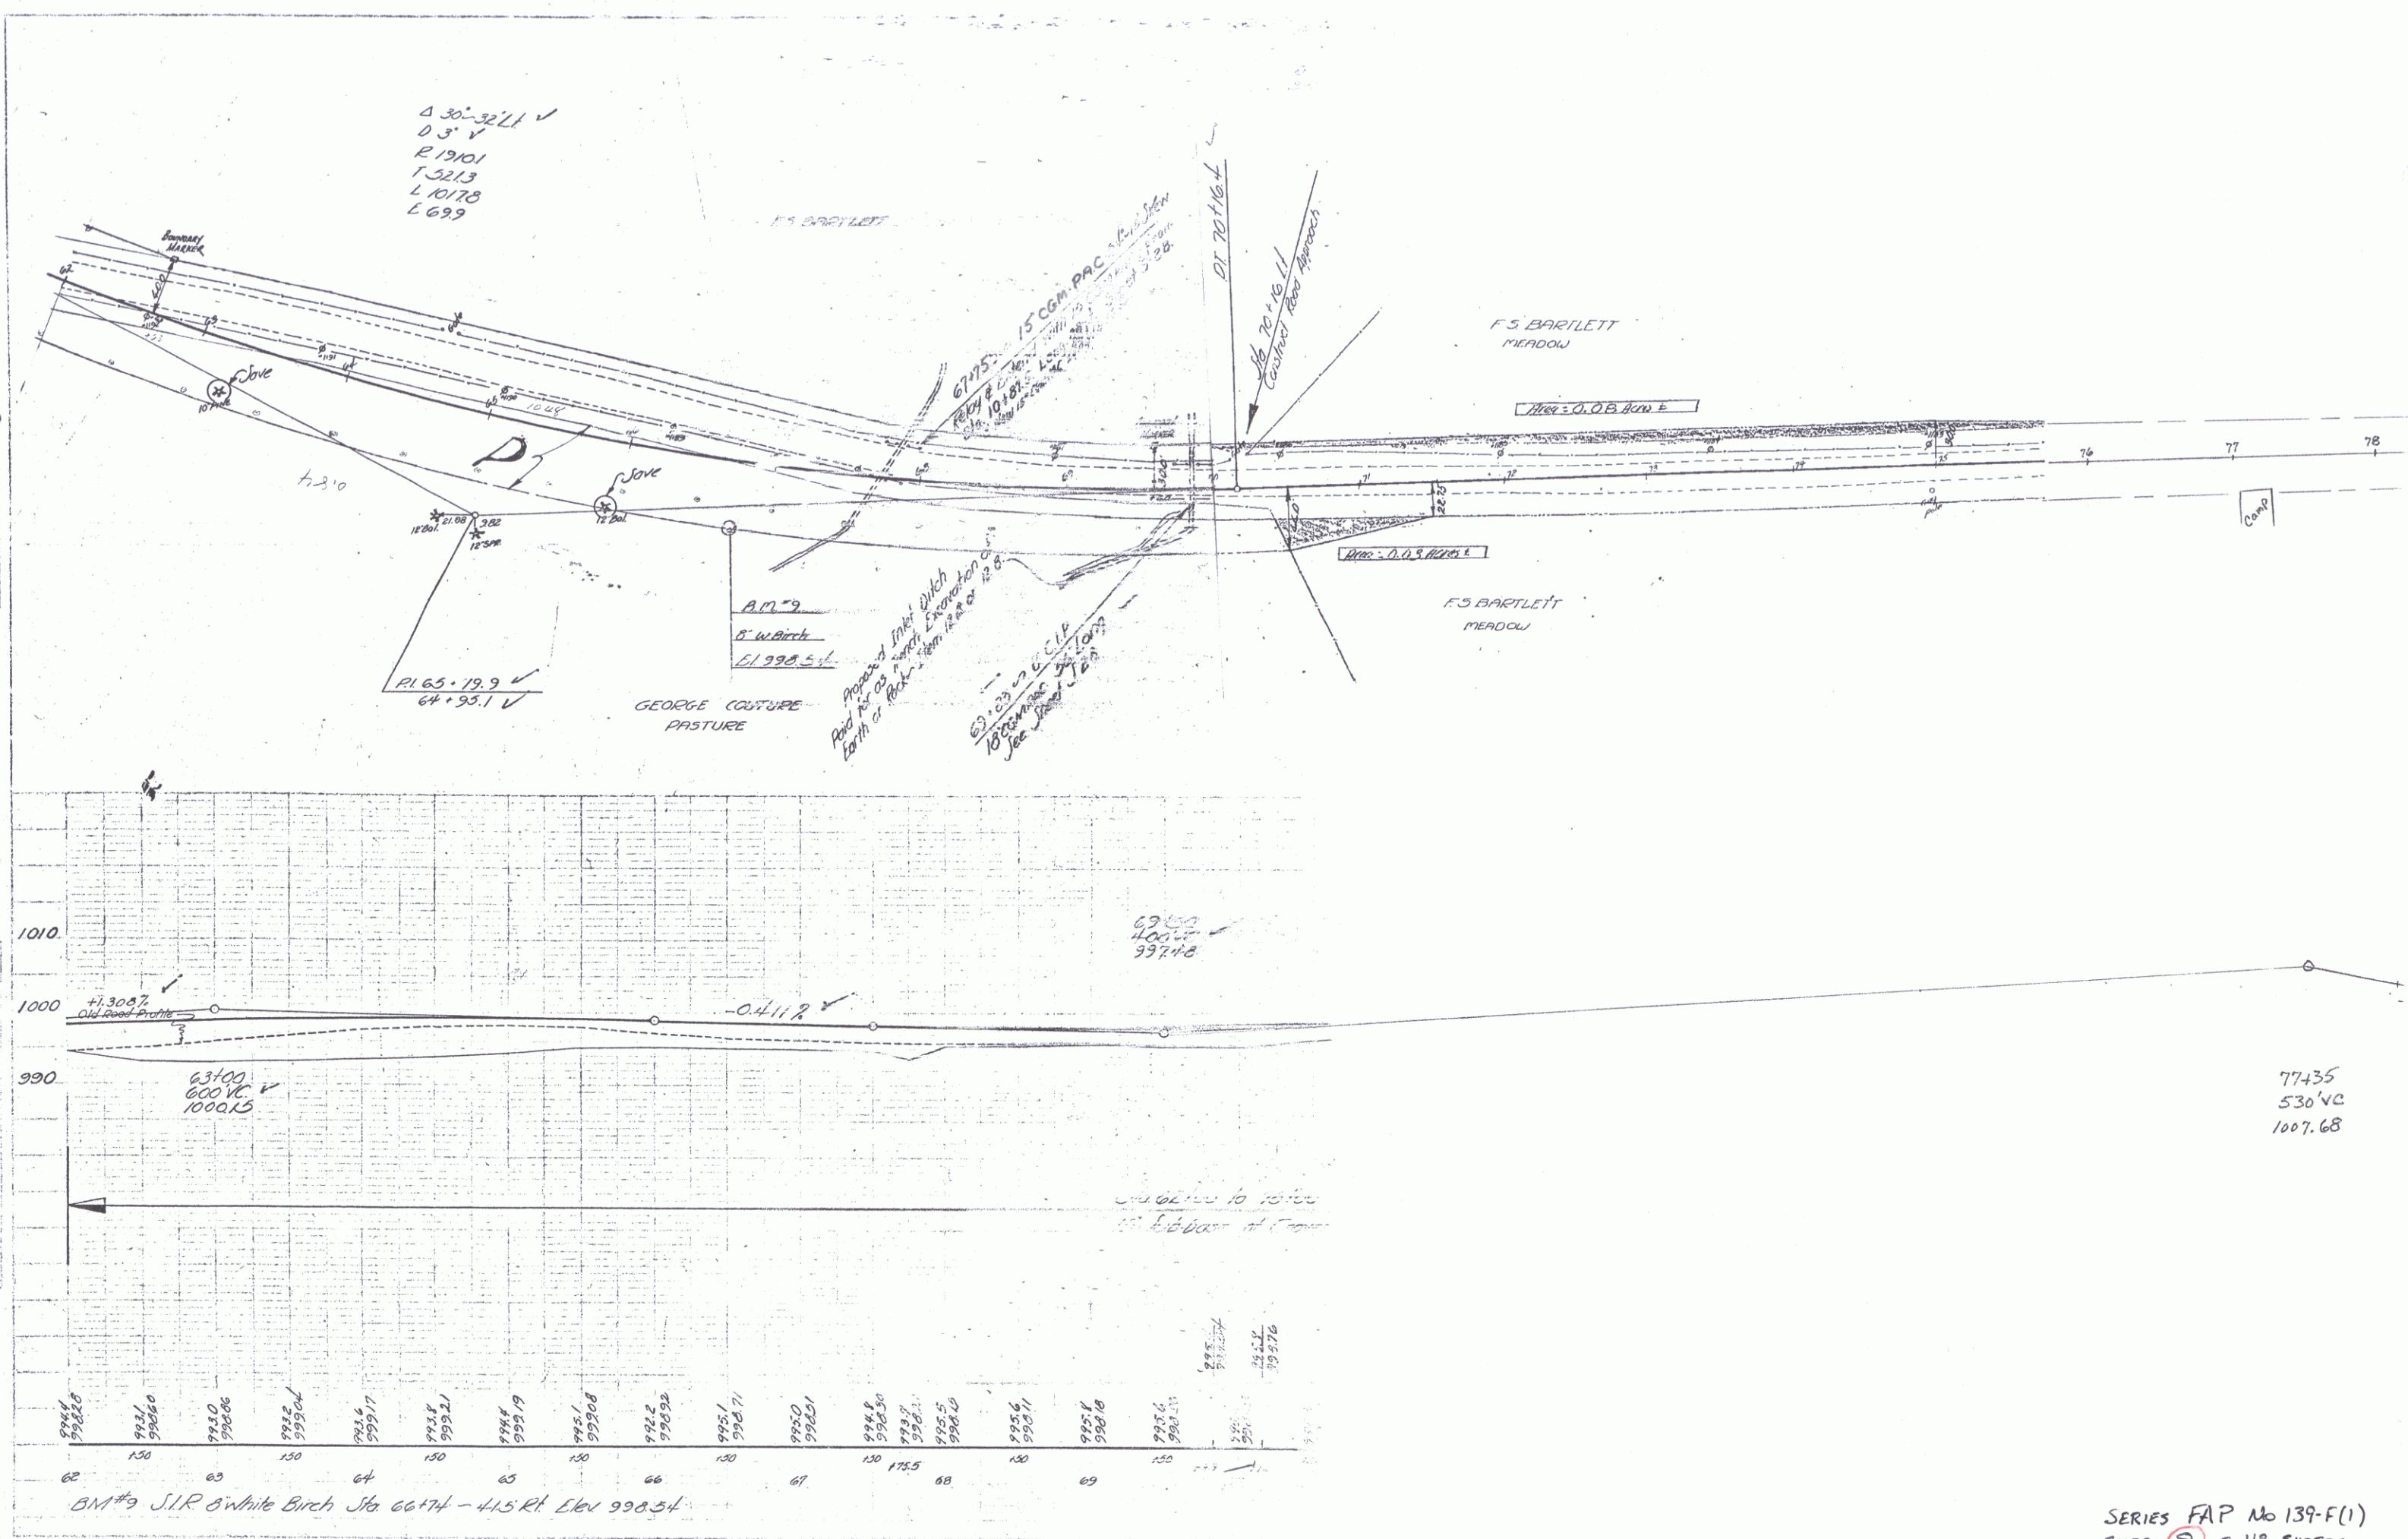


SERIES FAP No 139-F(1)
SHEET 8 OF 119 SHEETS

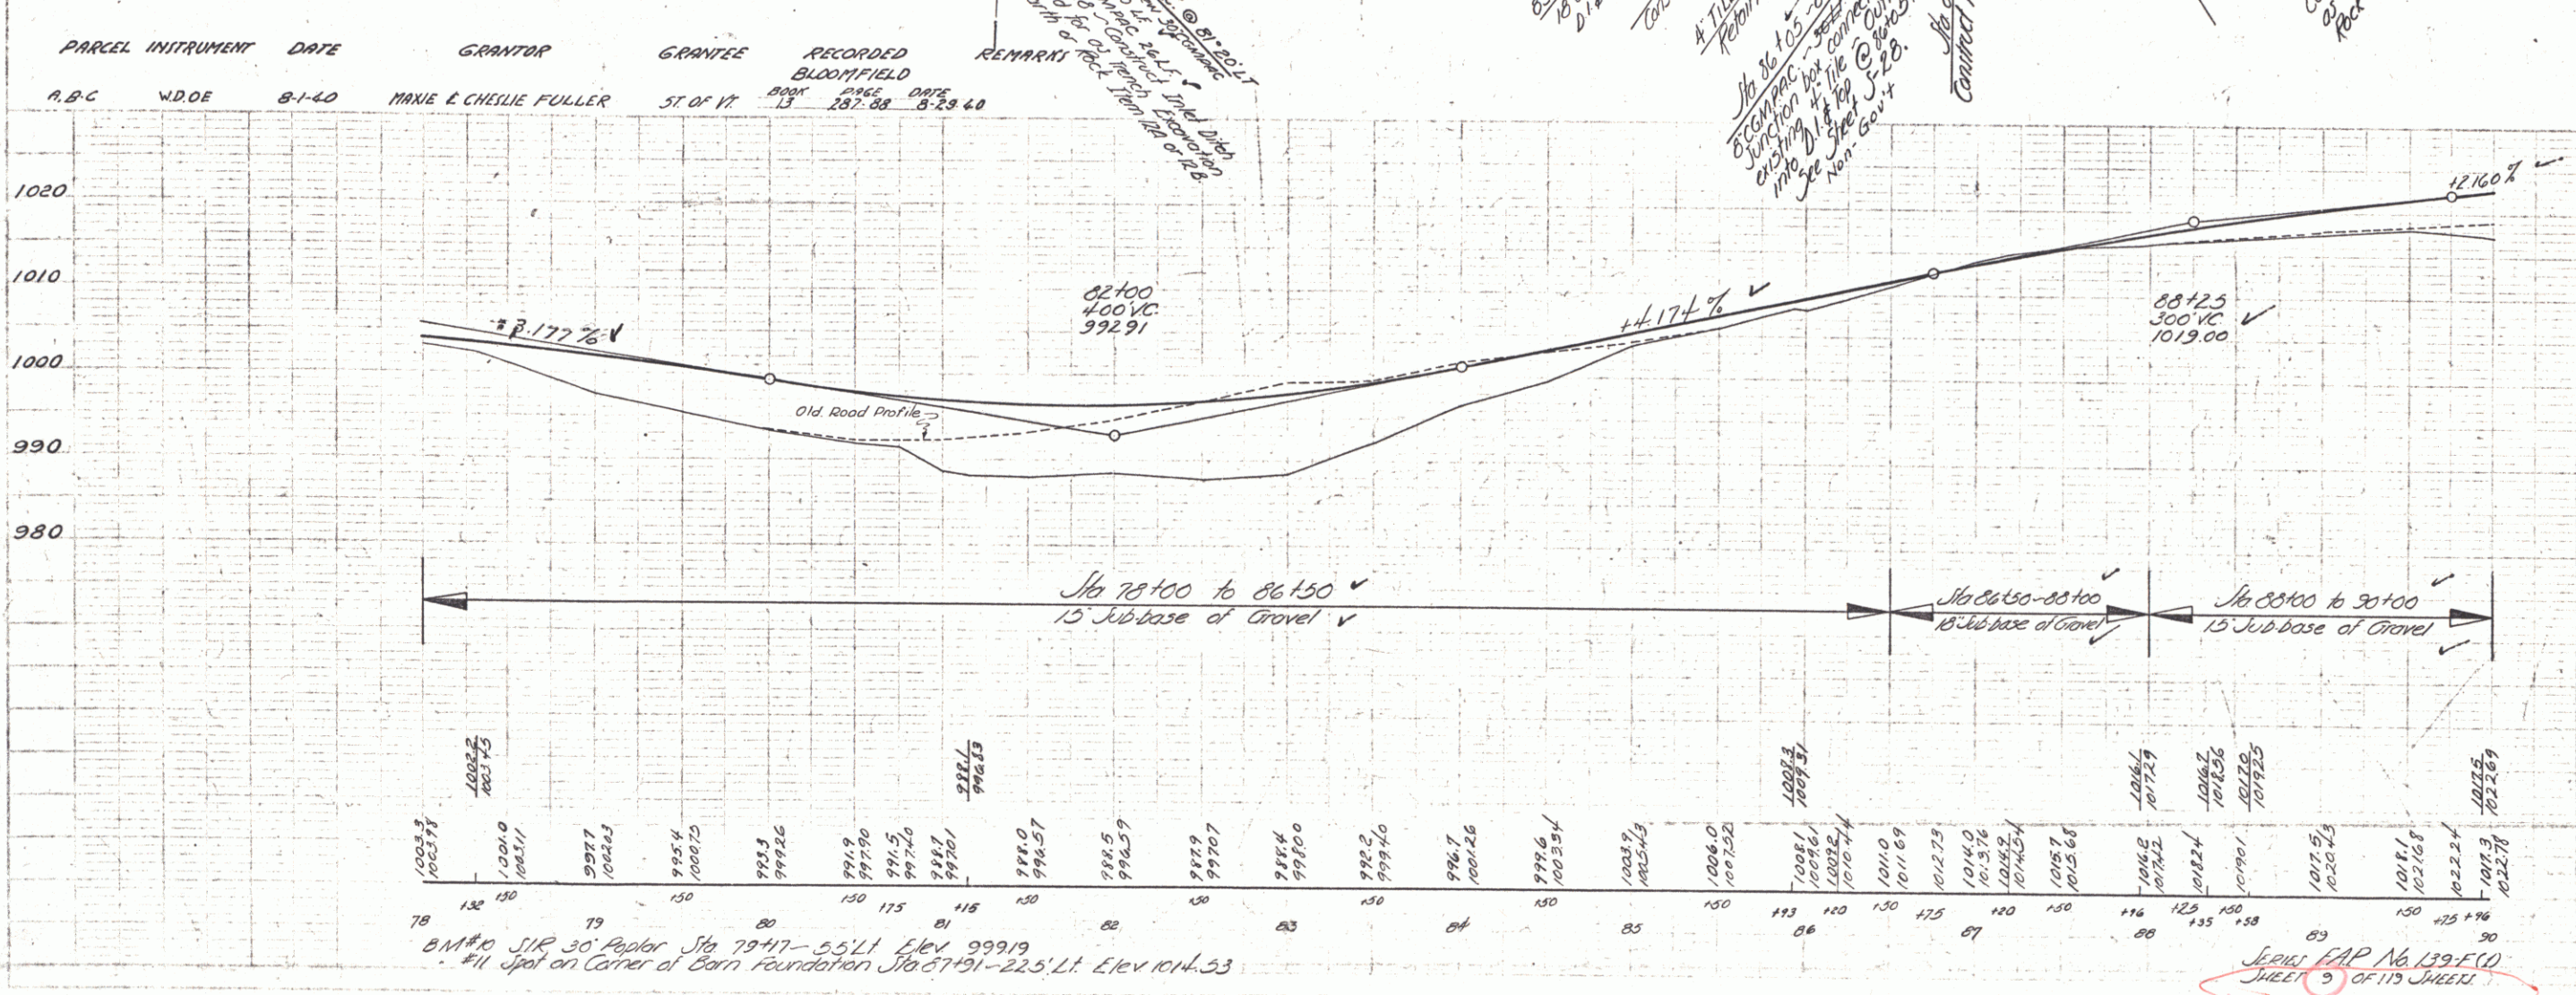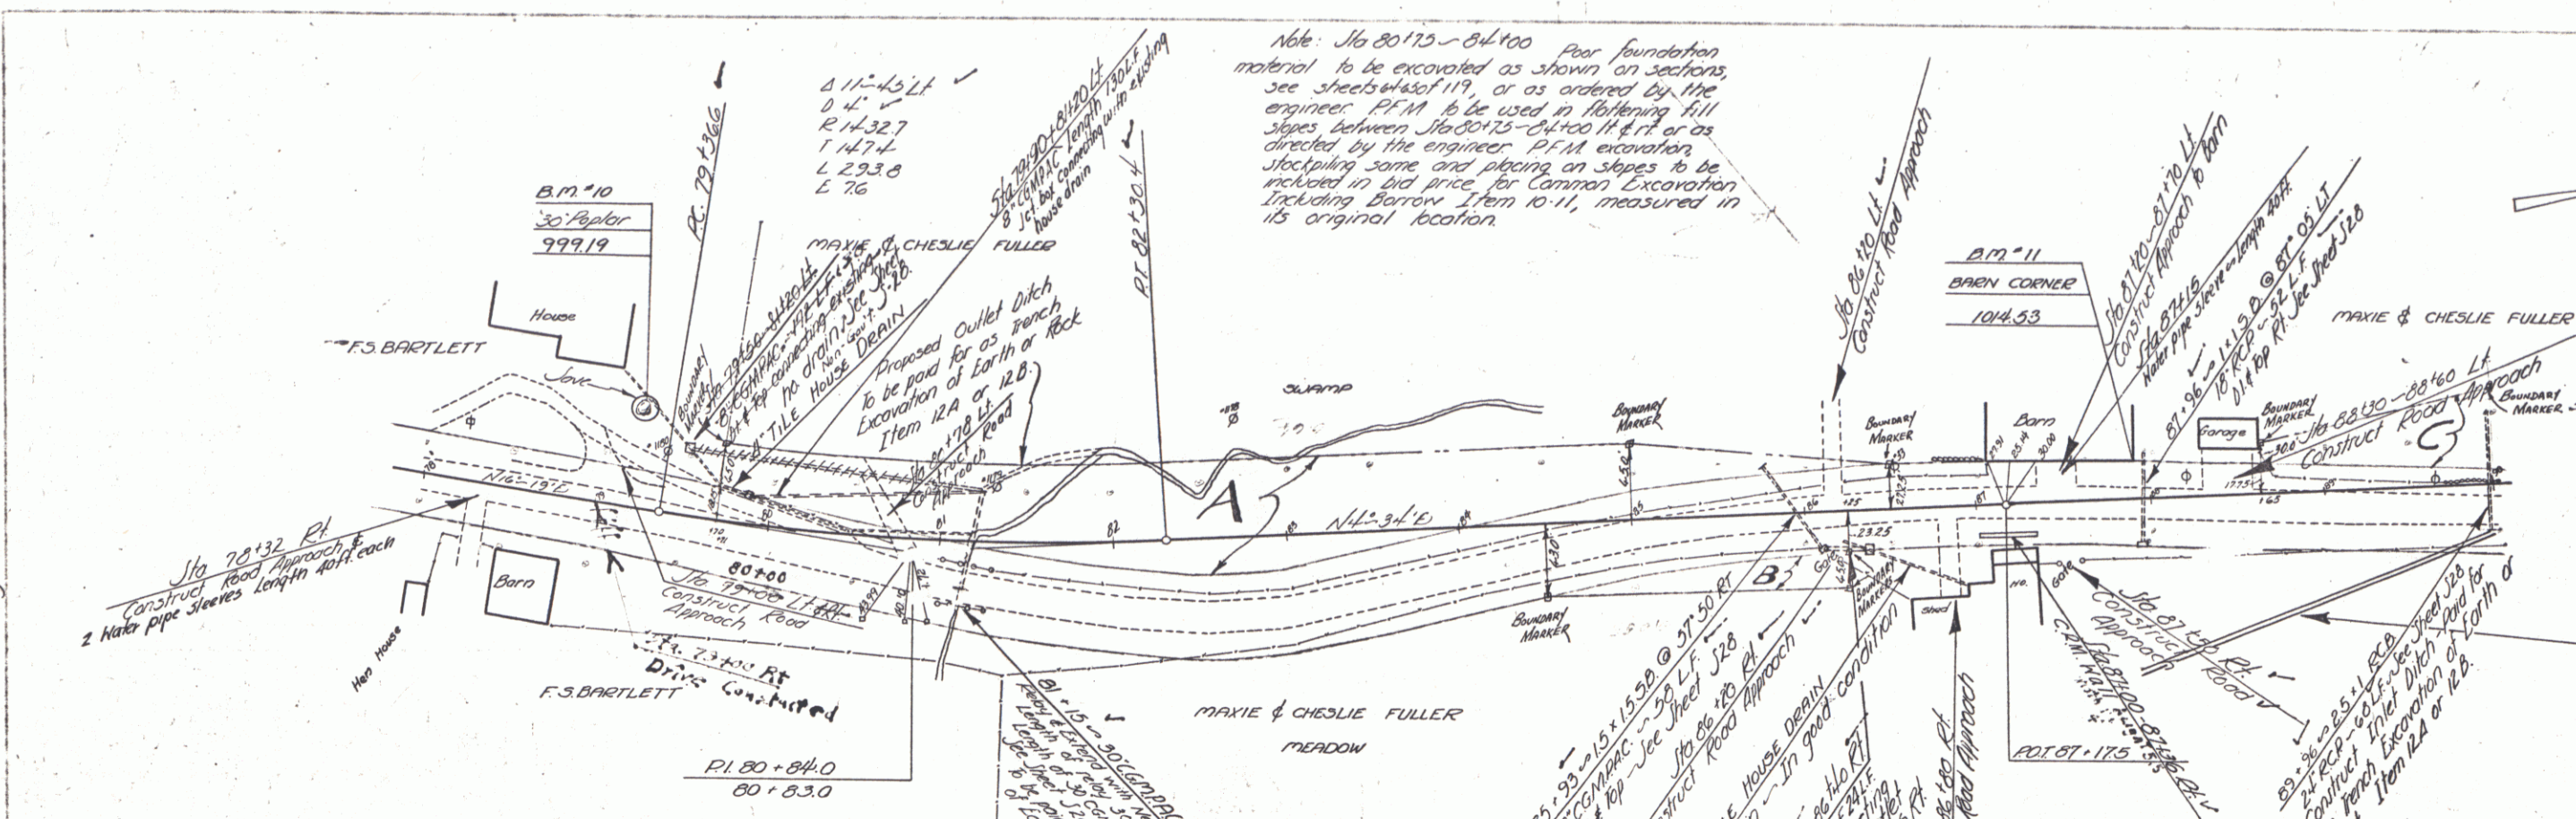

Sheet 10 of 113 Sheets

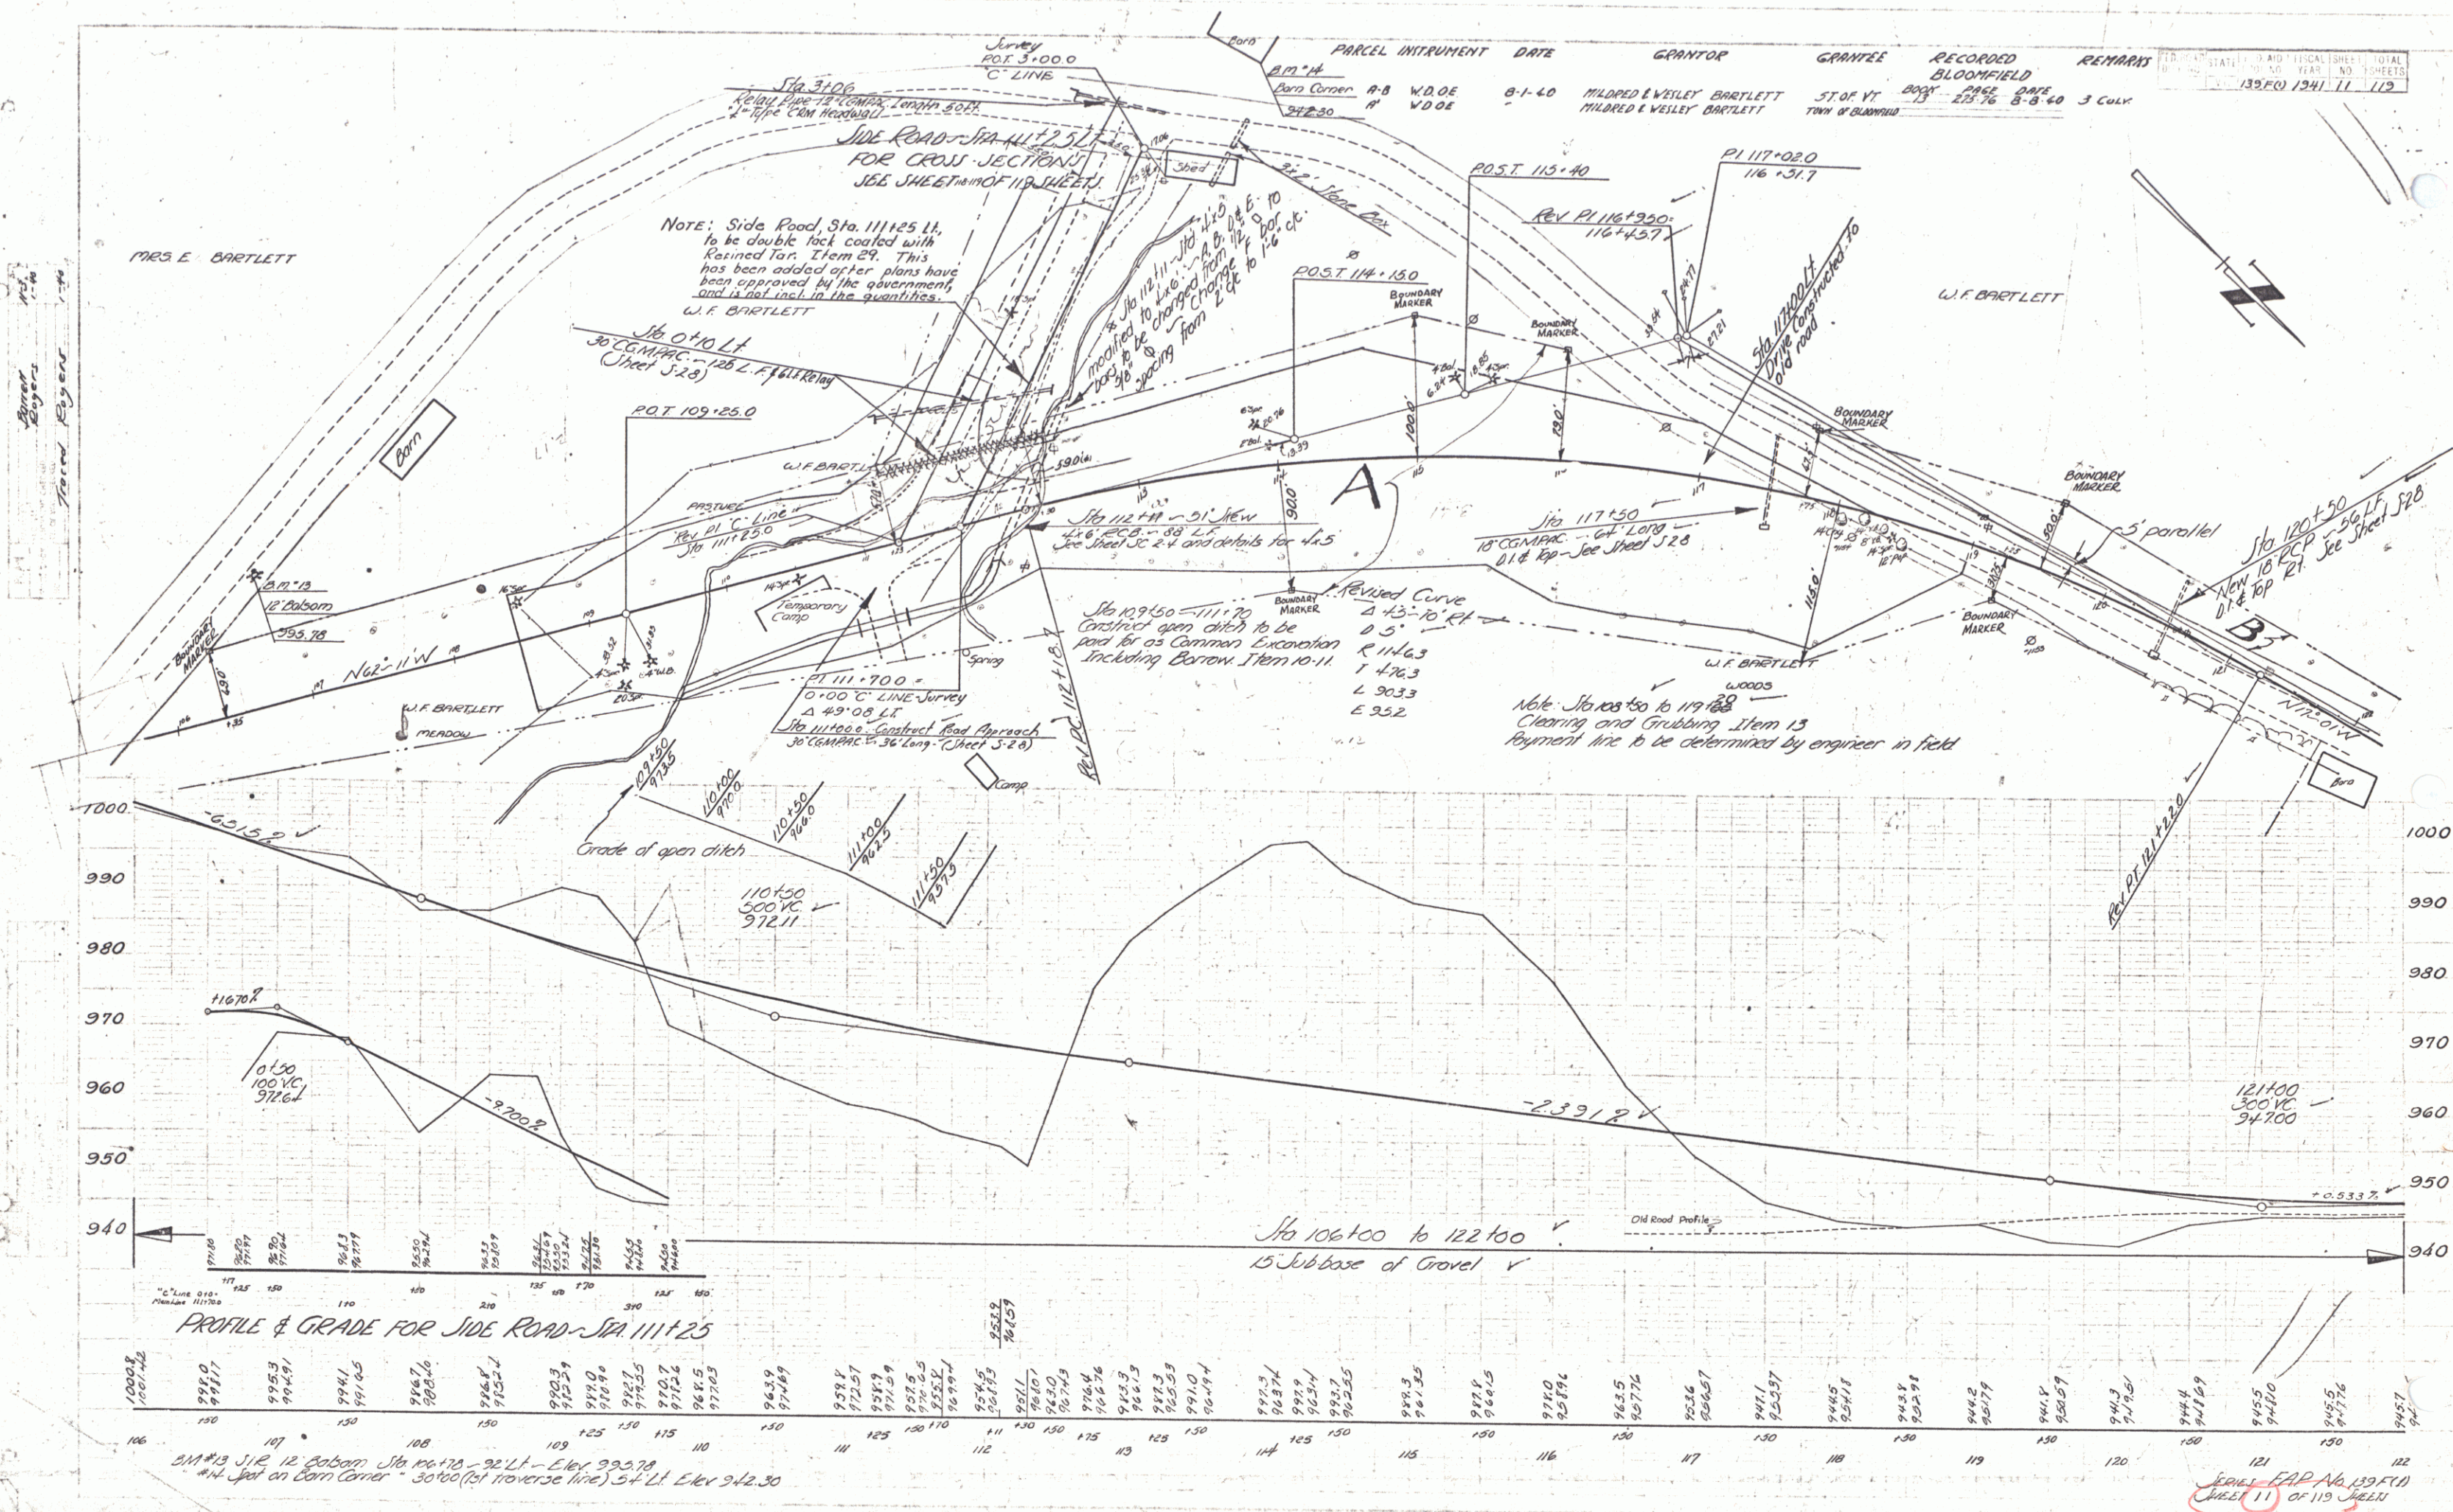


122
 123
 124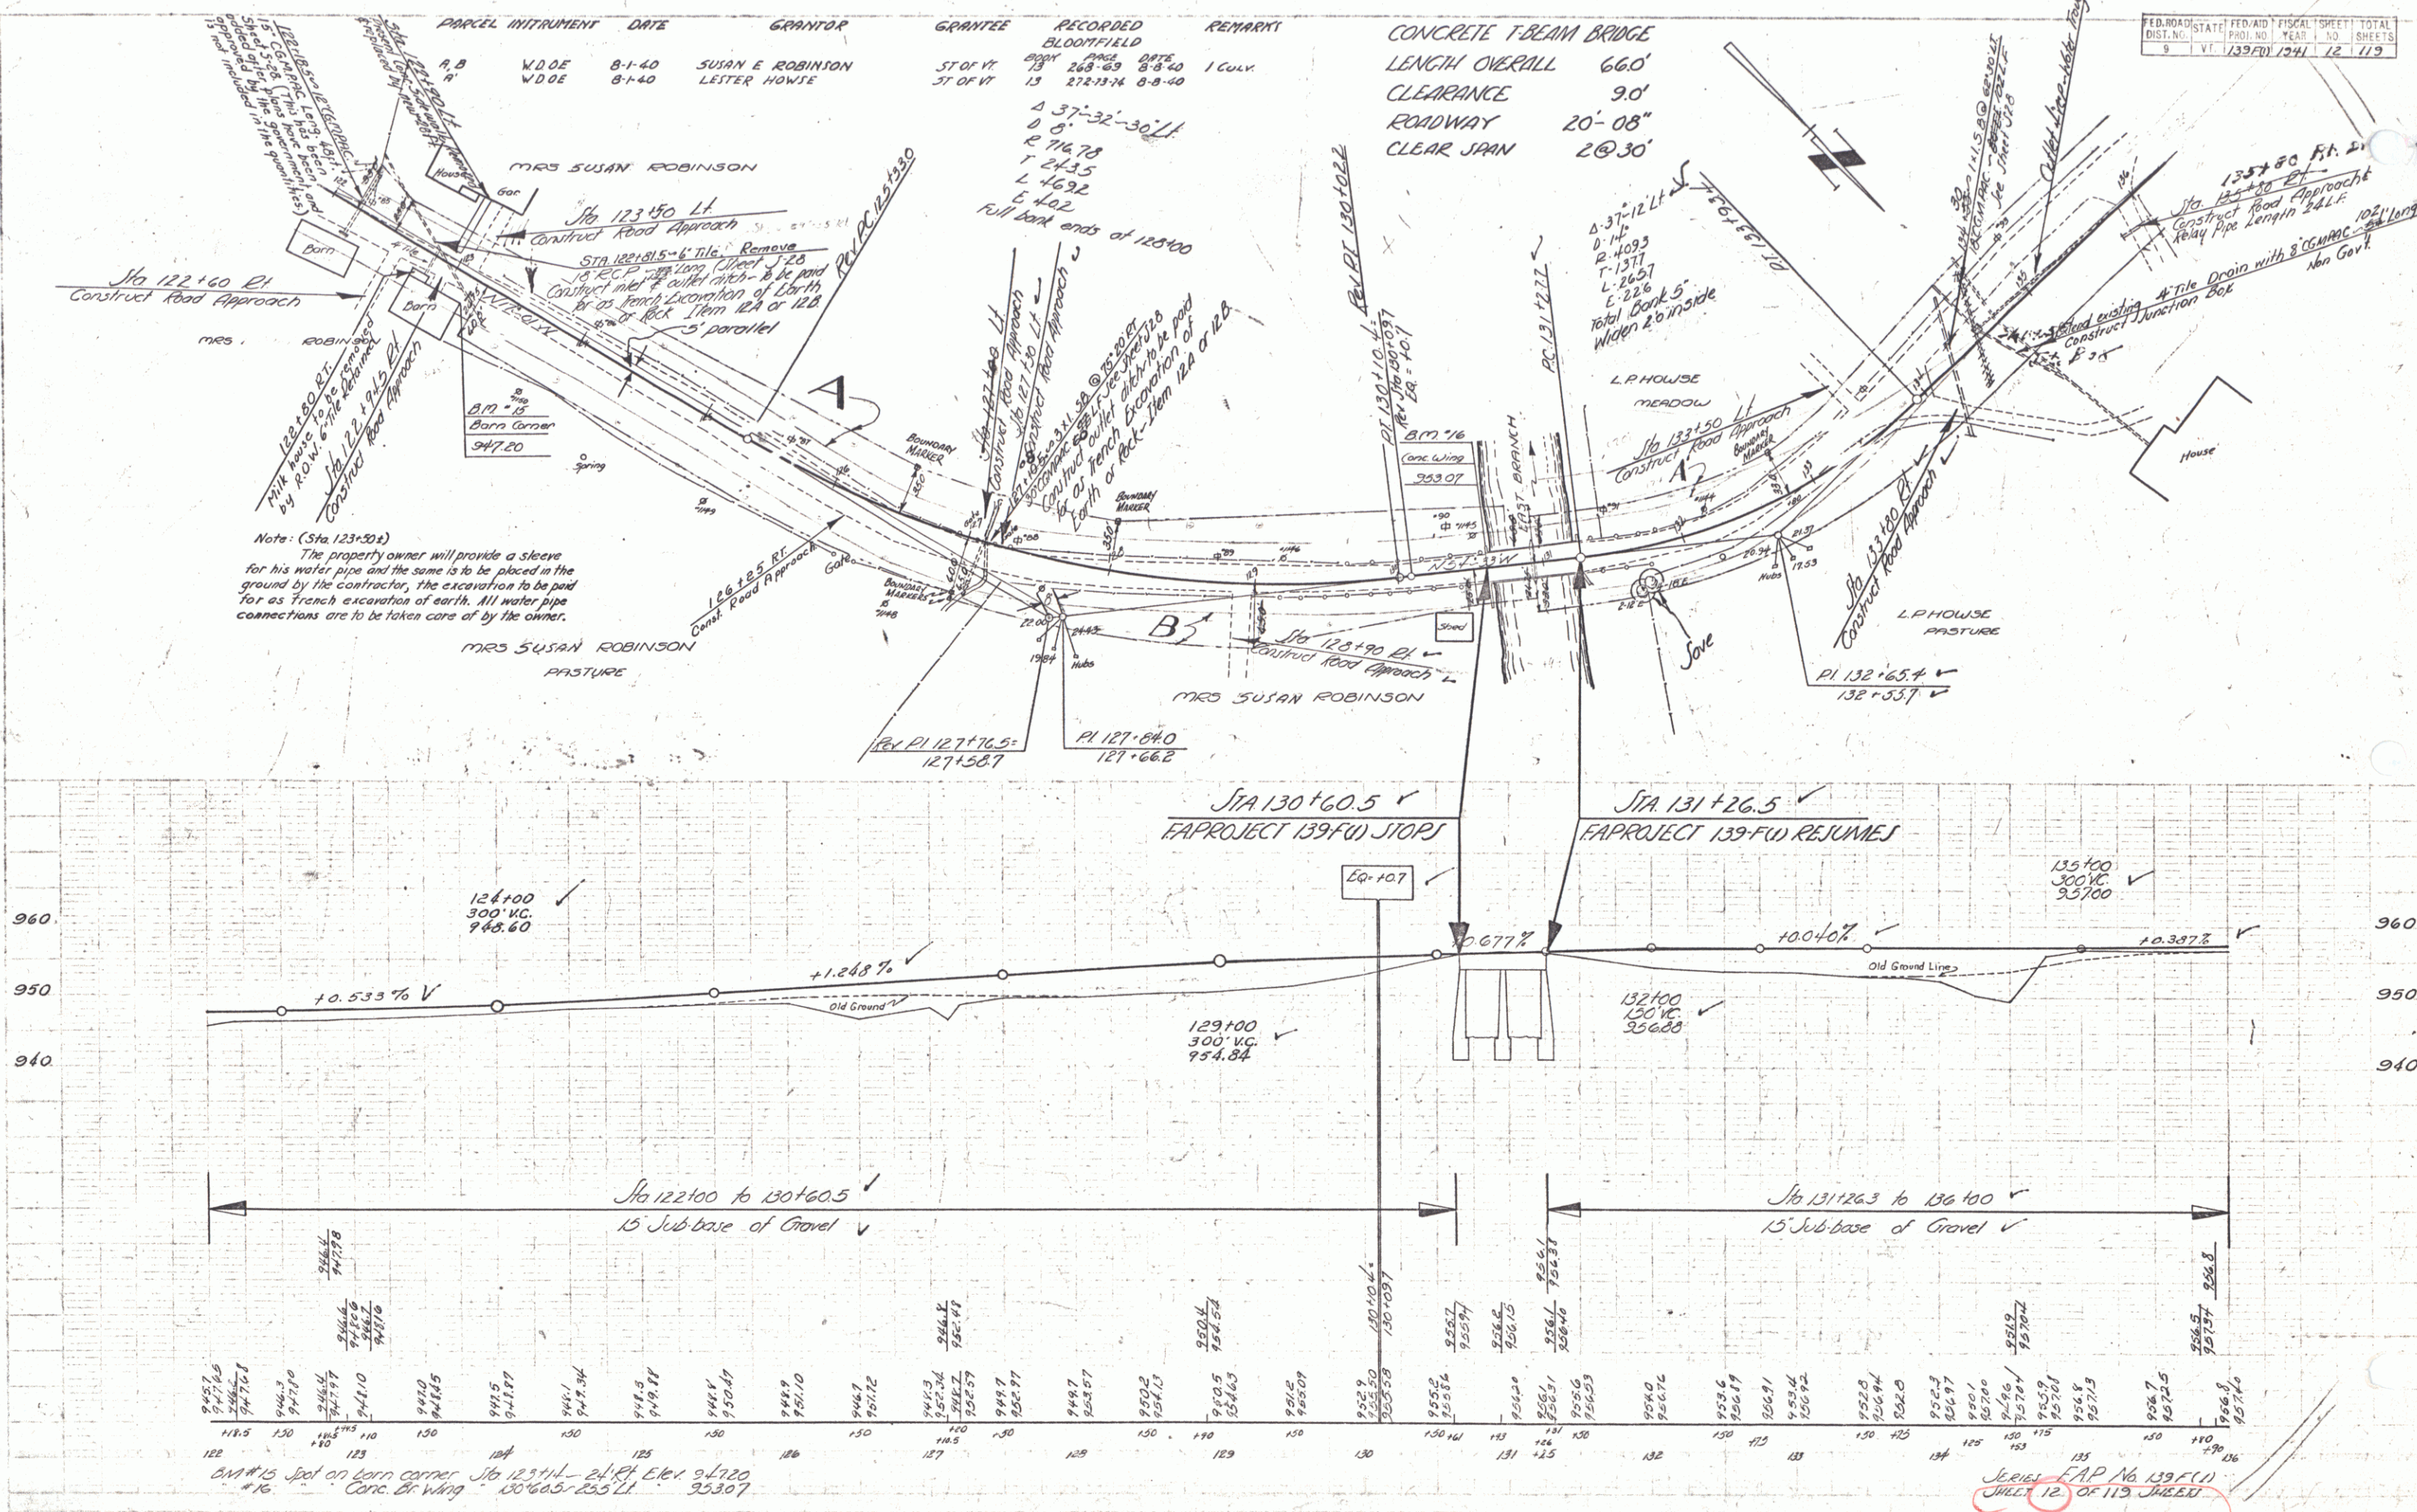
FED. ROAD DIST. NO.	STATE	FED. AID FISCAL YEAR	SHEET NO.	TOTAL SHEETS
9	VT	139	124	129

SERIES EAP No 139 F(1)
 SHEET 12 OF 113 SHEETS


PLAN
Scale 1" = 40'
Sheet 13 of 113

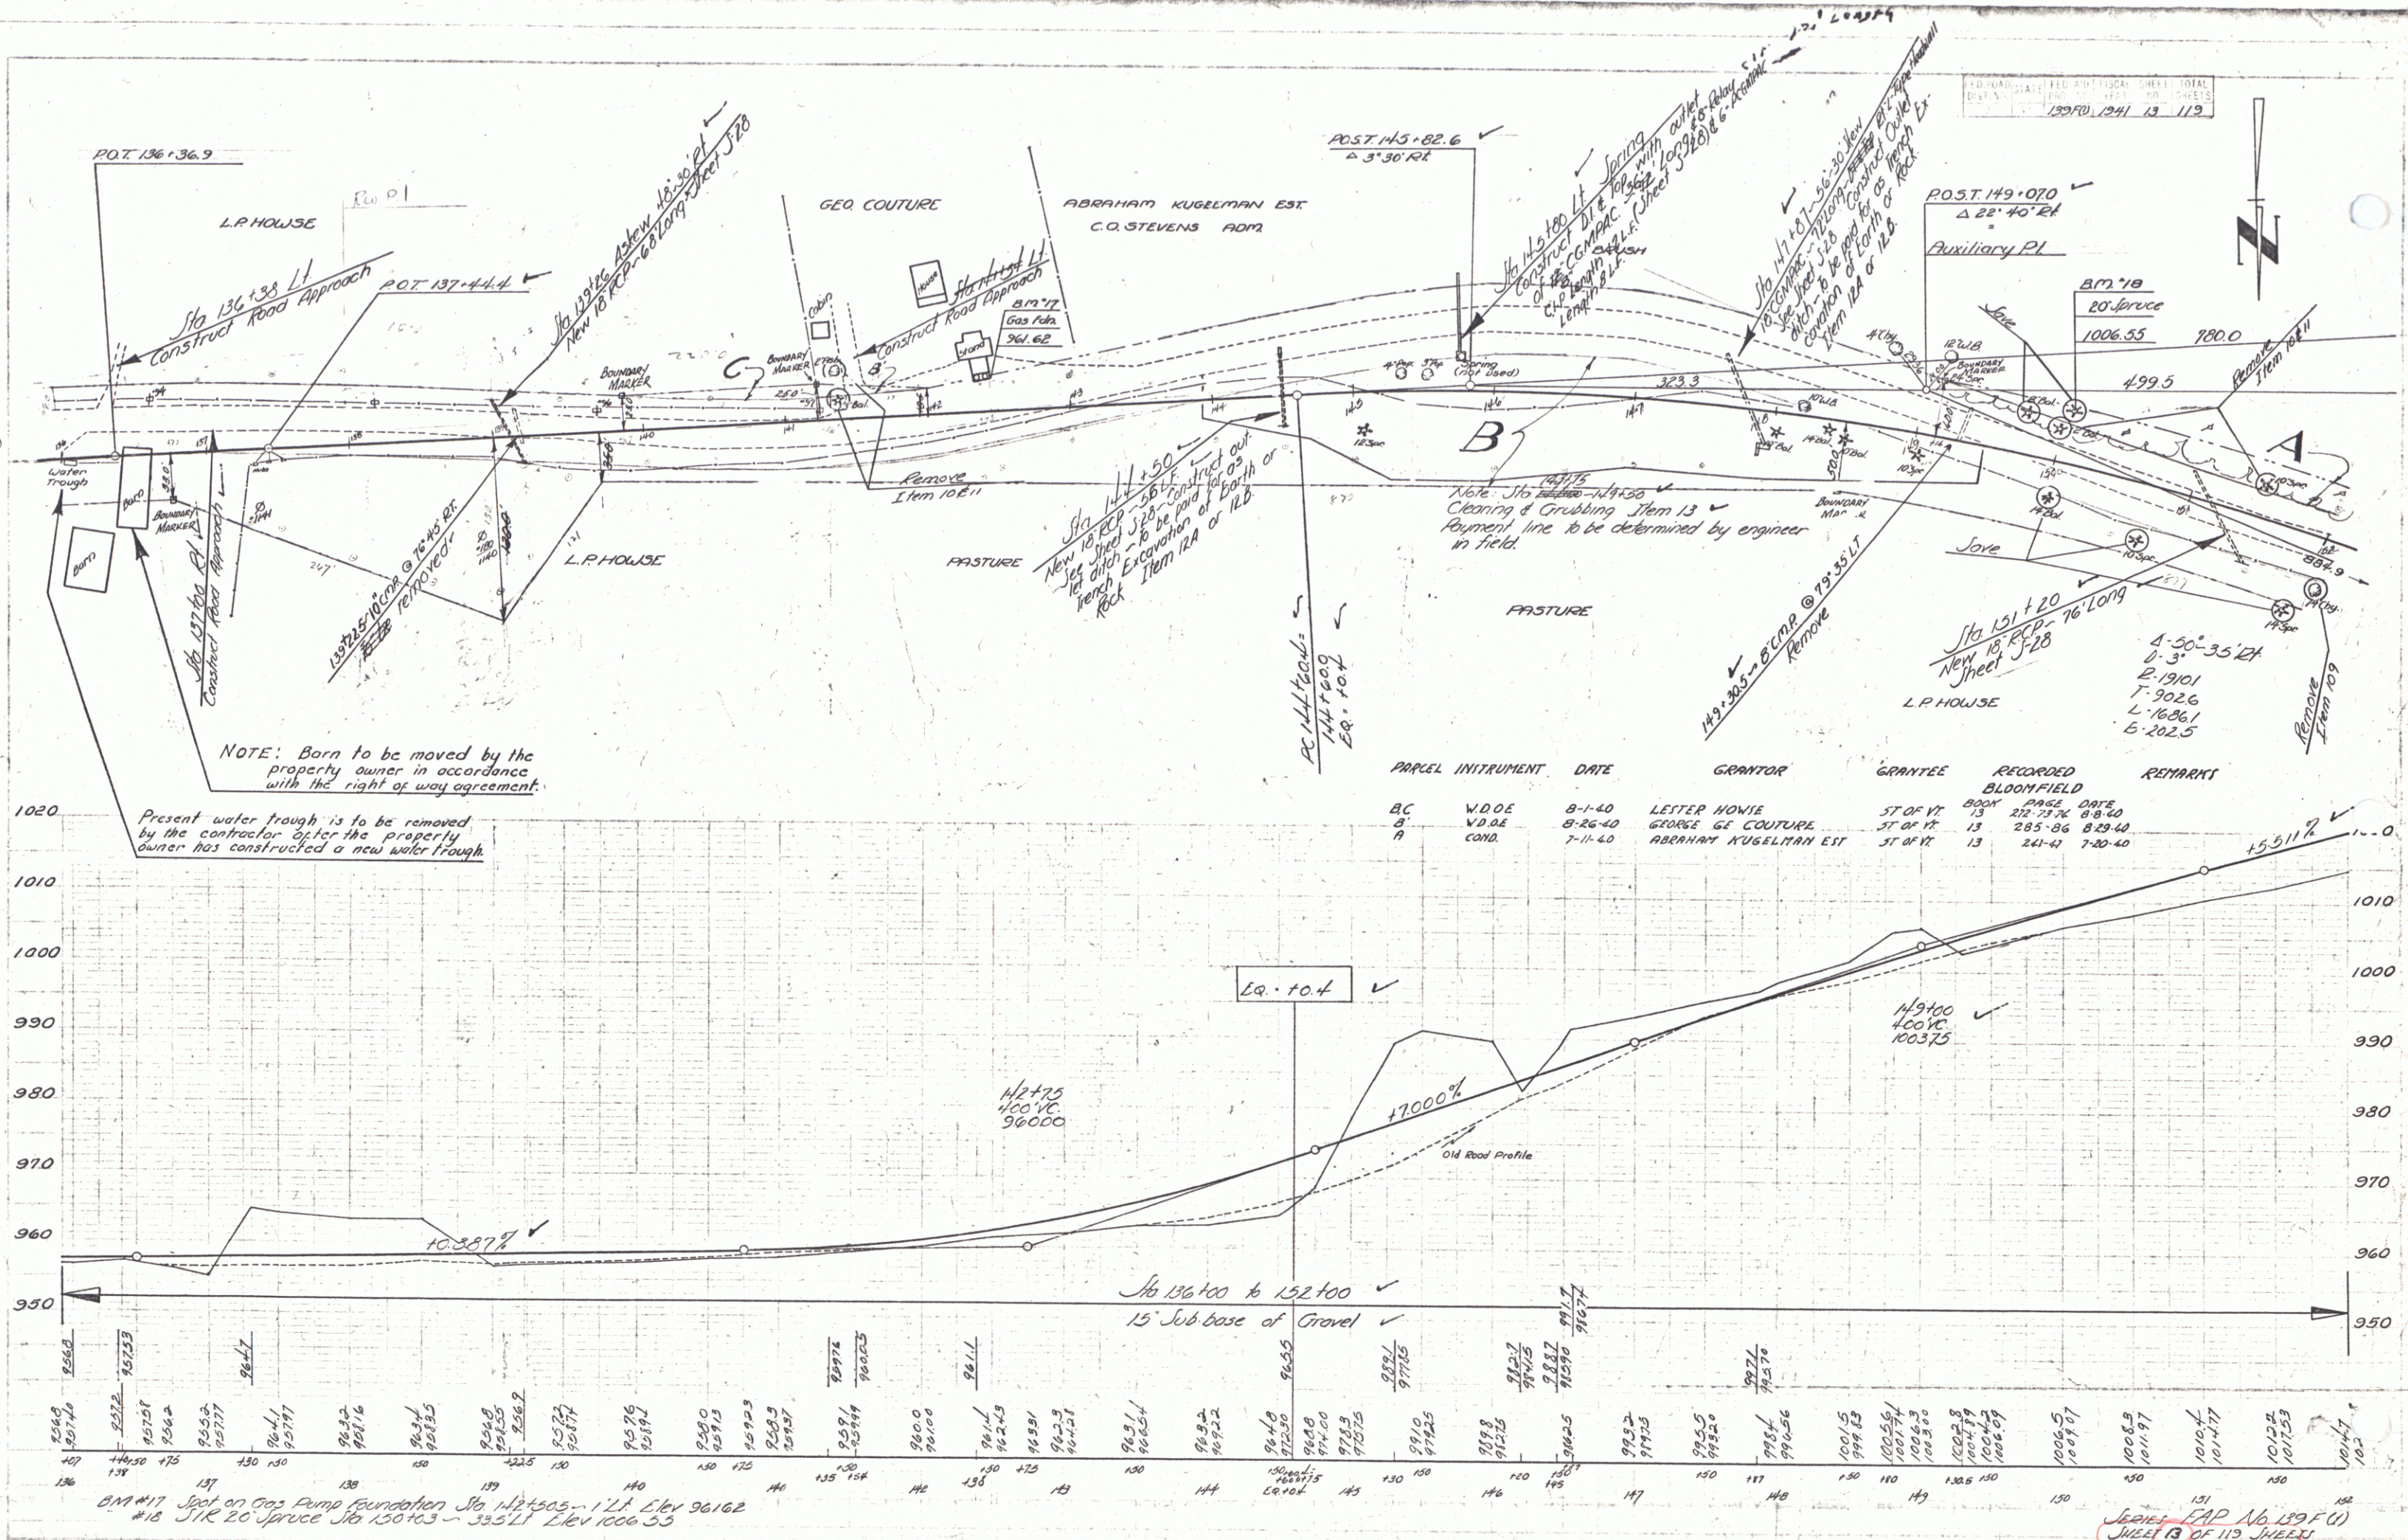

PARCEL	INSTRUMENT	DATE	GRANTOR	GRANTEE	RECORDED	REMARKS
BC	W.D.O.E.	8-1-40	LESTER HOWSE	ST OF VT	13	
A	V.D.A.E.	8-26-40	GEORGE G. COUTURE	ST OF VT	13	
	COND.	7-11-40	ABRAHAM KUGELMAN EST.	ST OF VT	13	


B.M. #17 Set on Gas Pump foundation Sta 136+00 - 1 L.T. Elev 96.162
#18 Set on Spruce Sta 136+00 - 33.2 L.T. Elev 1006.55

SHEET 13 OF 113 SHEETS

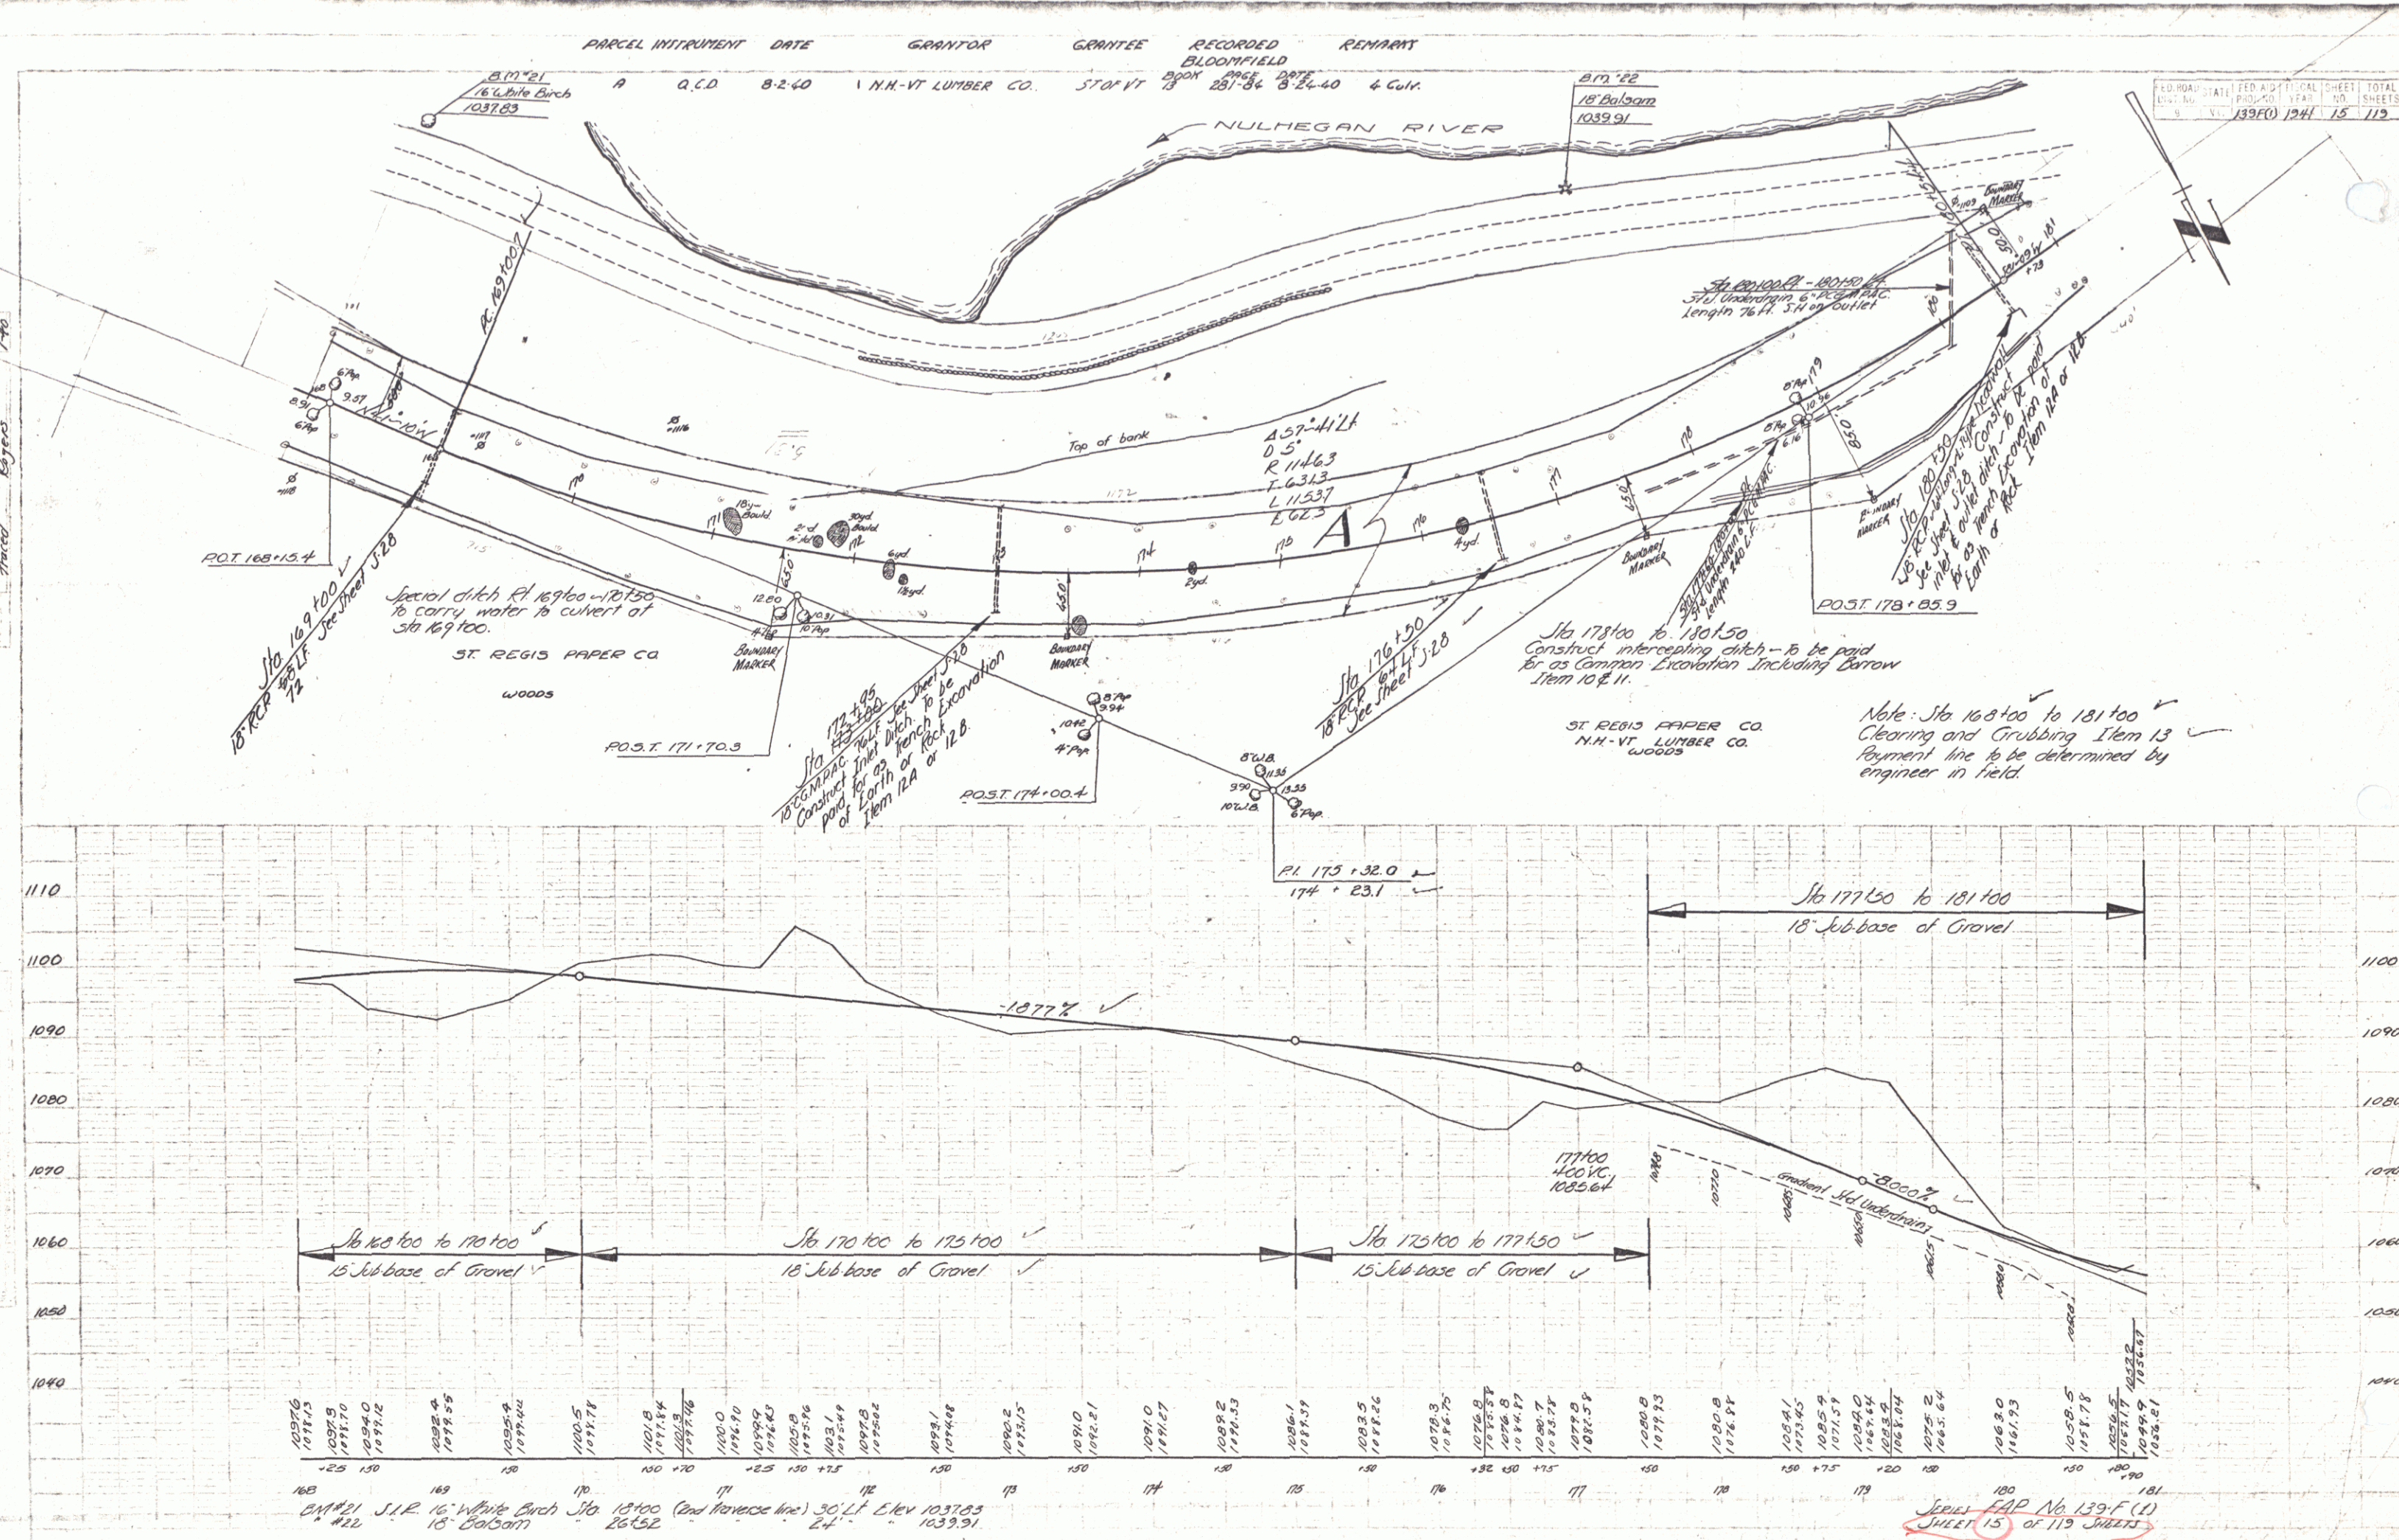


PARCEL INSTRUMENT	DATE	GRANTOR	GRANTEE	RECORDED	REMARKS
B.C.	A.C.D.	8-2-40	N.H.-VT LUMBER CO	ST. VT	

FILE NO.	STATE	FILE NO.	FILE NO.	FILE NO.	TOTAL
139F(1)	VT	139F(2)	139F(3)	139F(4)	139F(5)

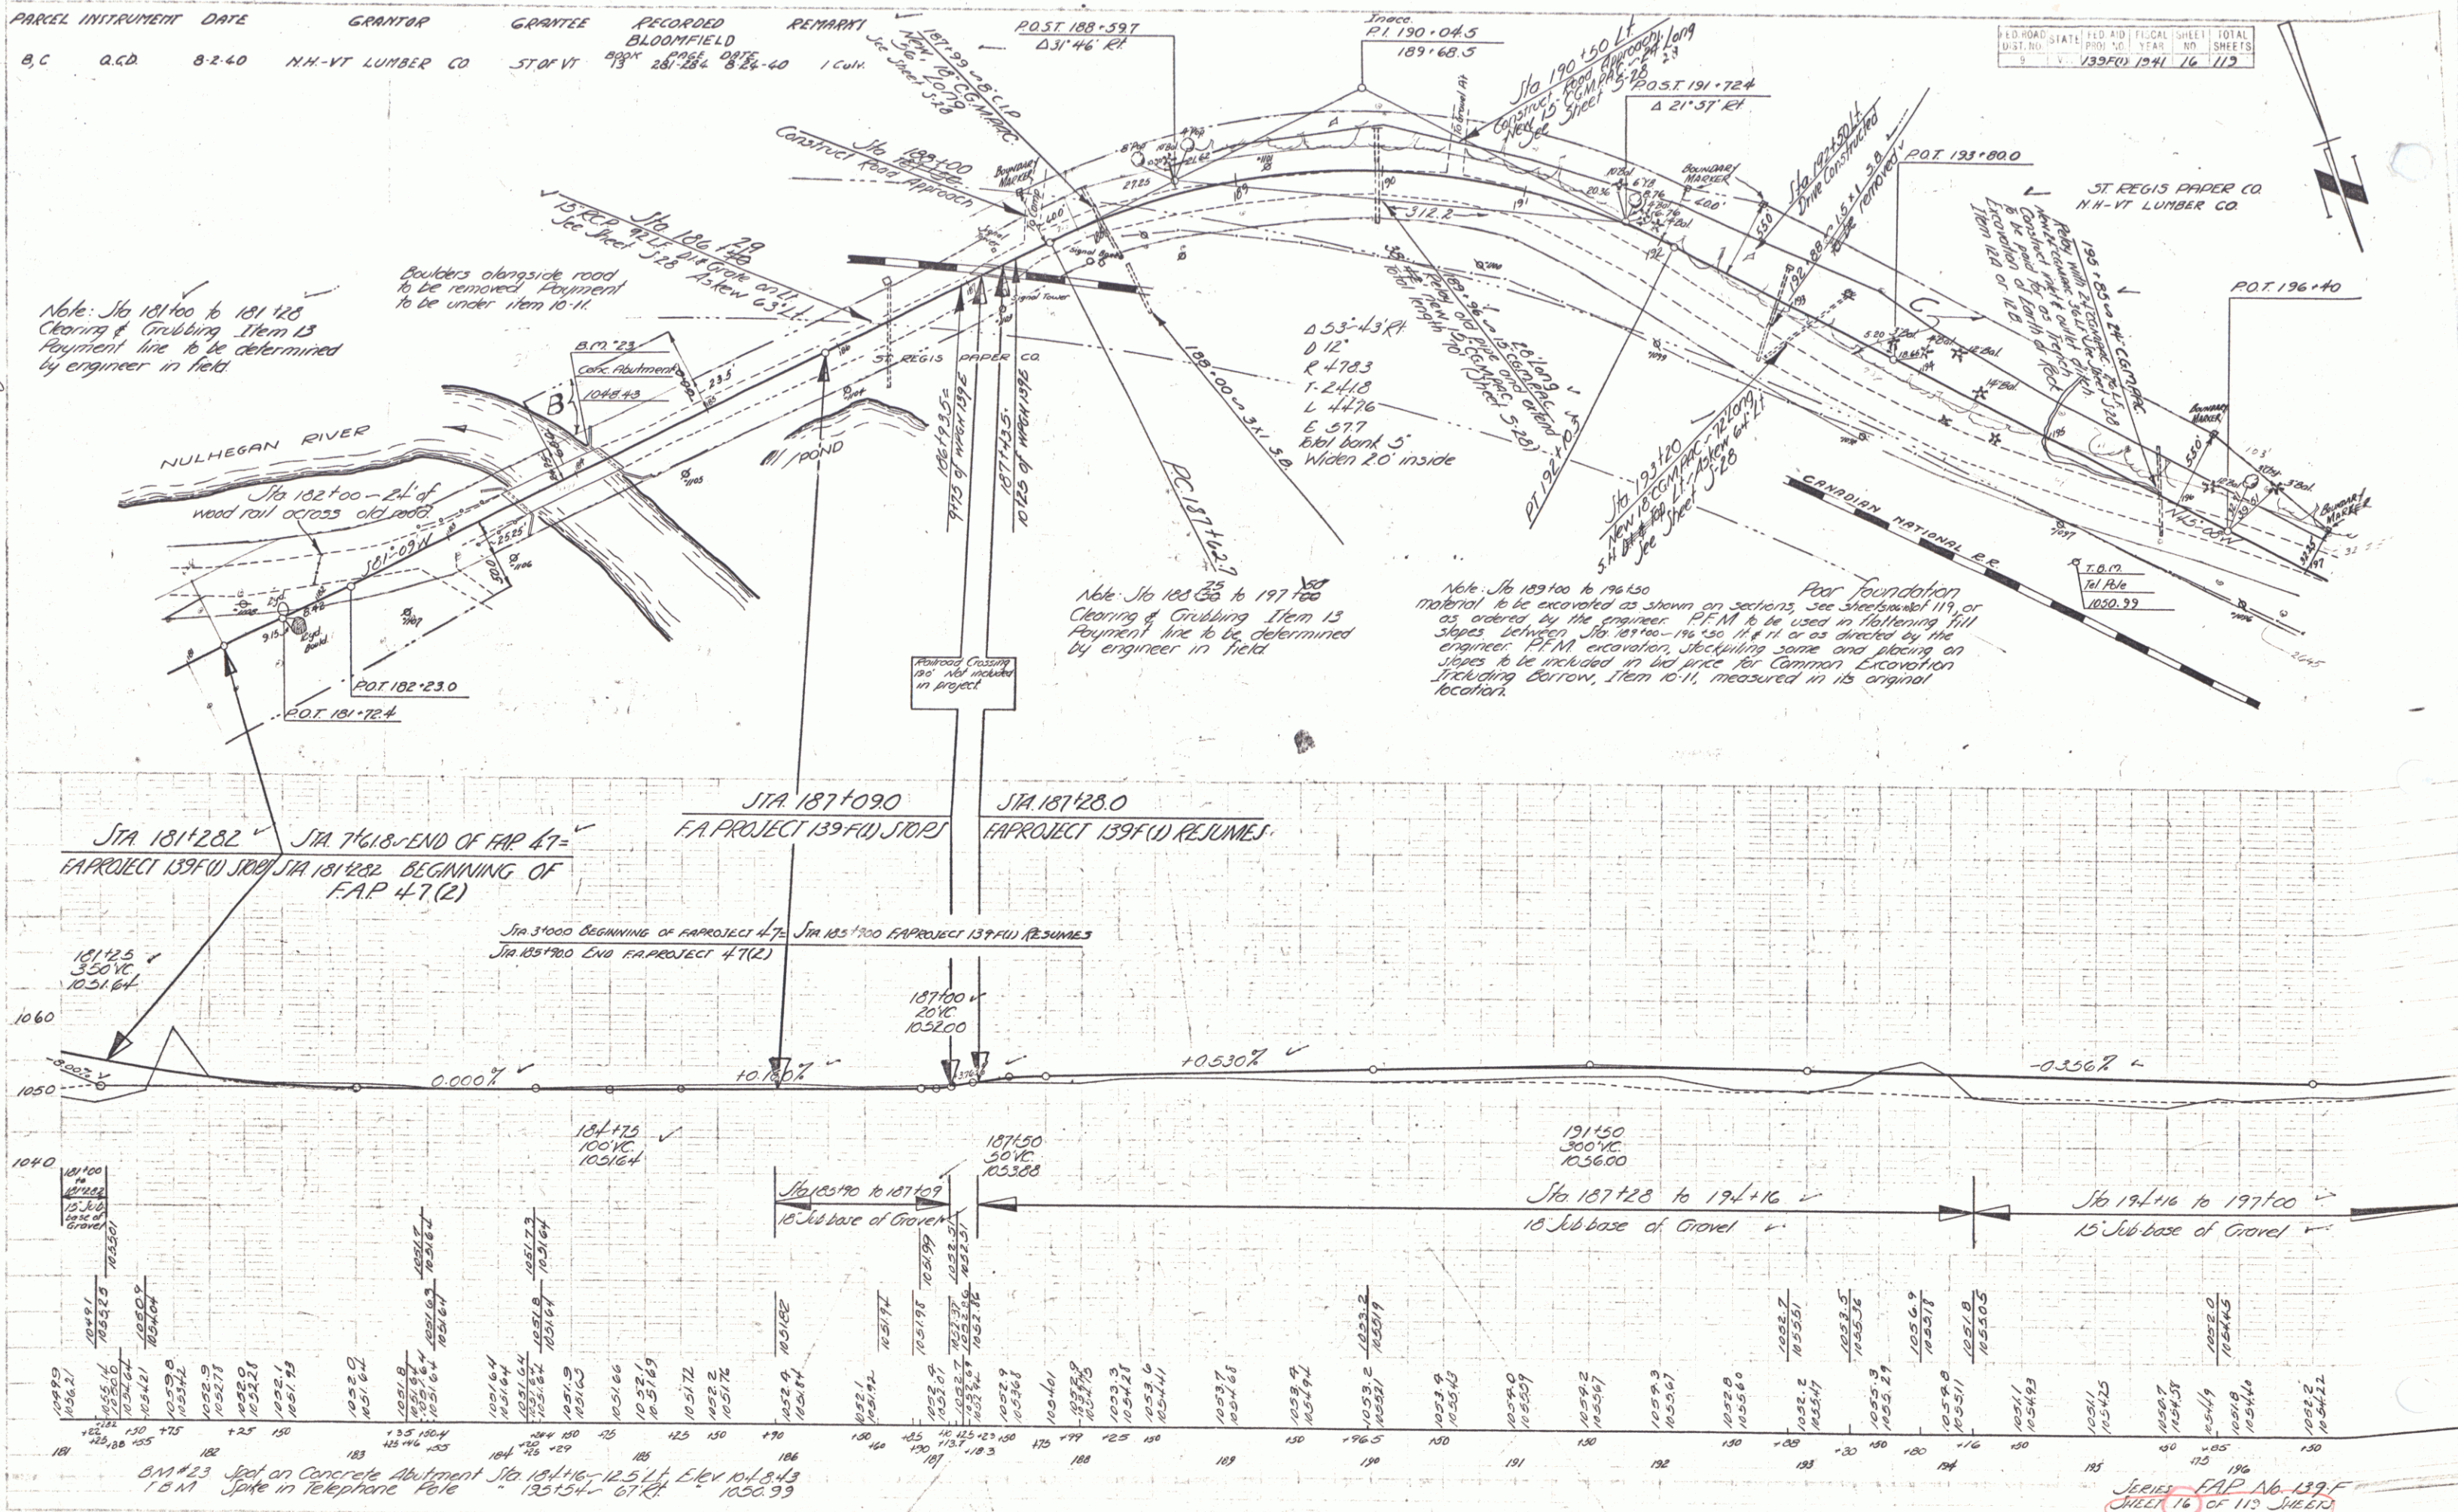


Note: Jts ²⁰⁰¹²⁰~~200110~~ to 212100
Clearing and Grubbing Item 13
Payment line to be determined by
engineer in field

FED. ROAD DIST. NO.	STATE	FED. AID (P. 40), NO.	FISCAL YEAR	SHEET NO.	TOTAL SHEET
9		139F0	1941	17	119

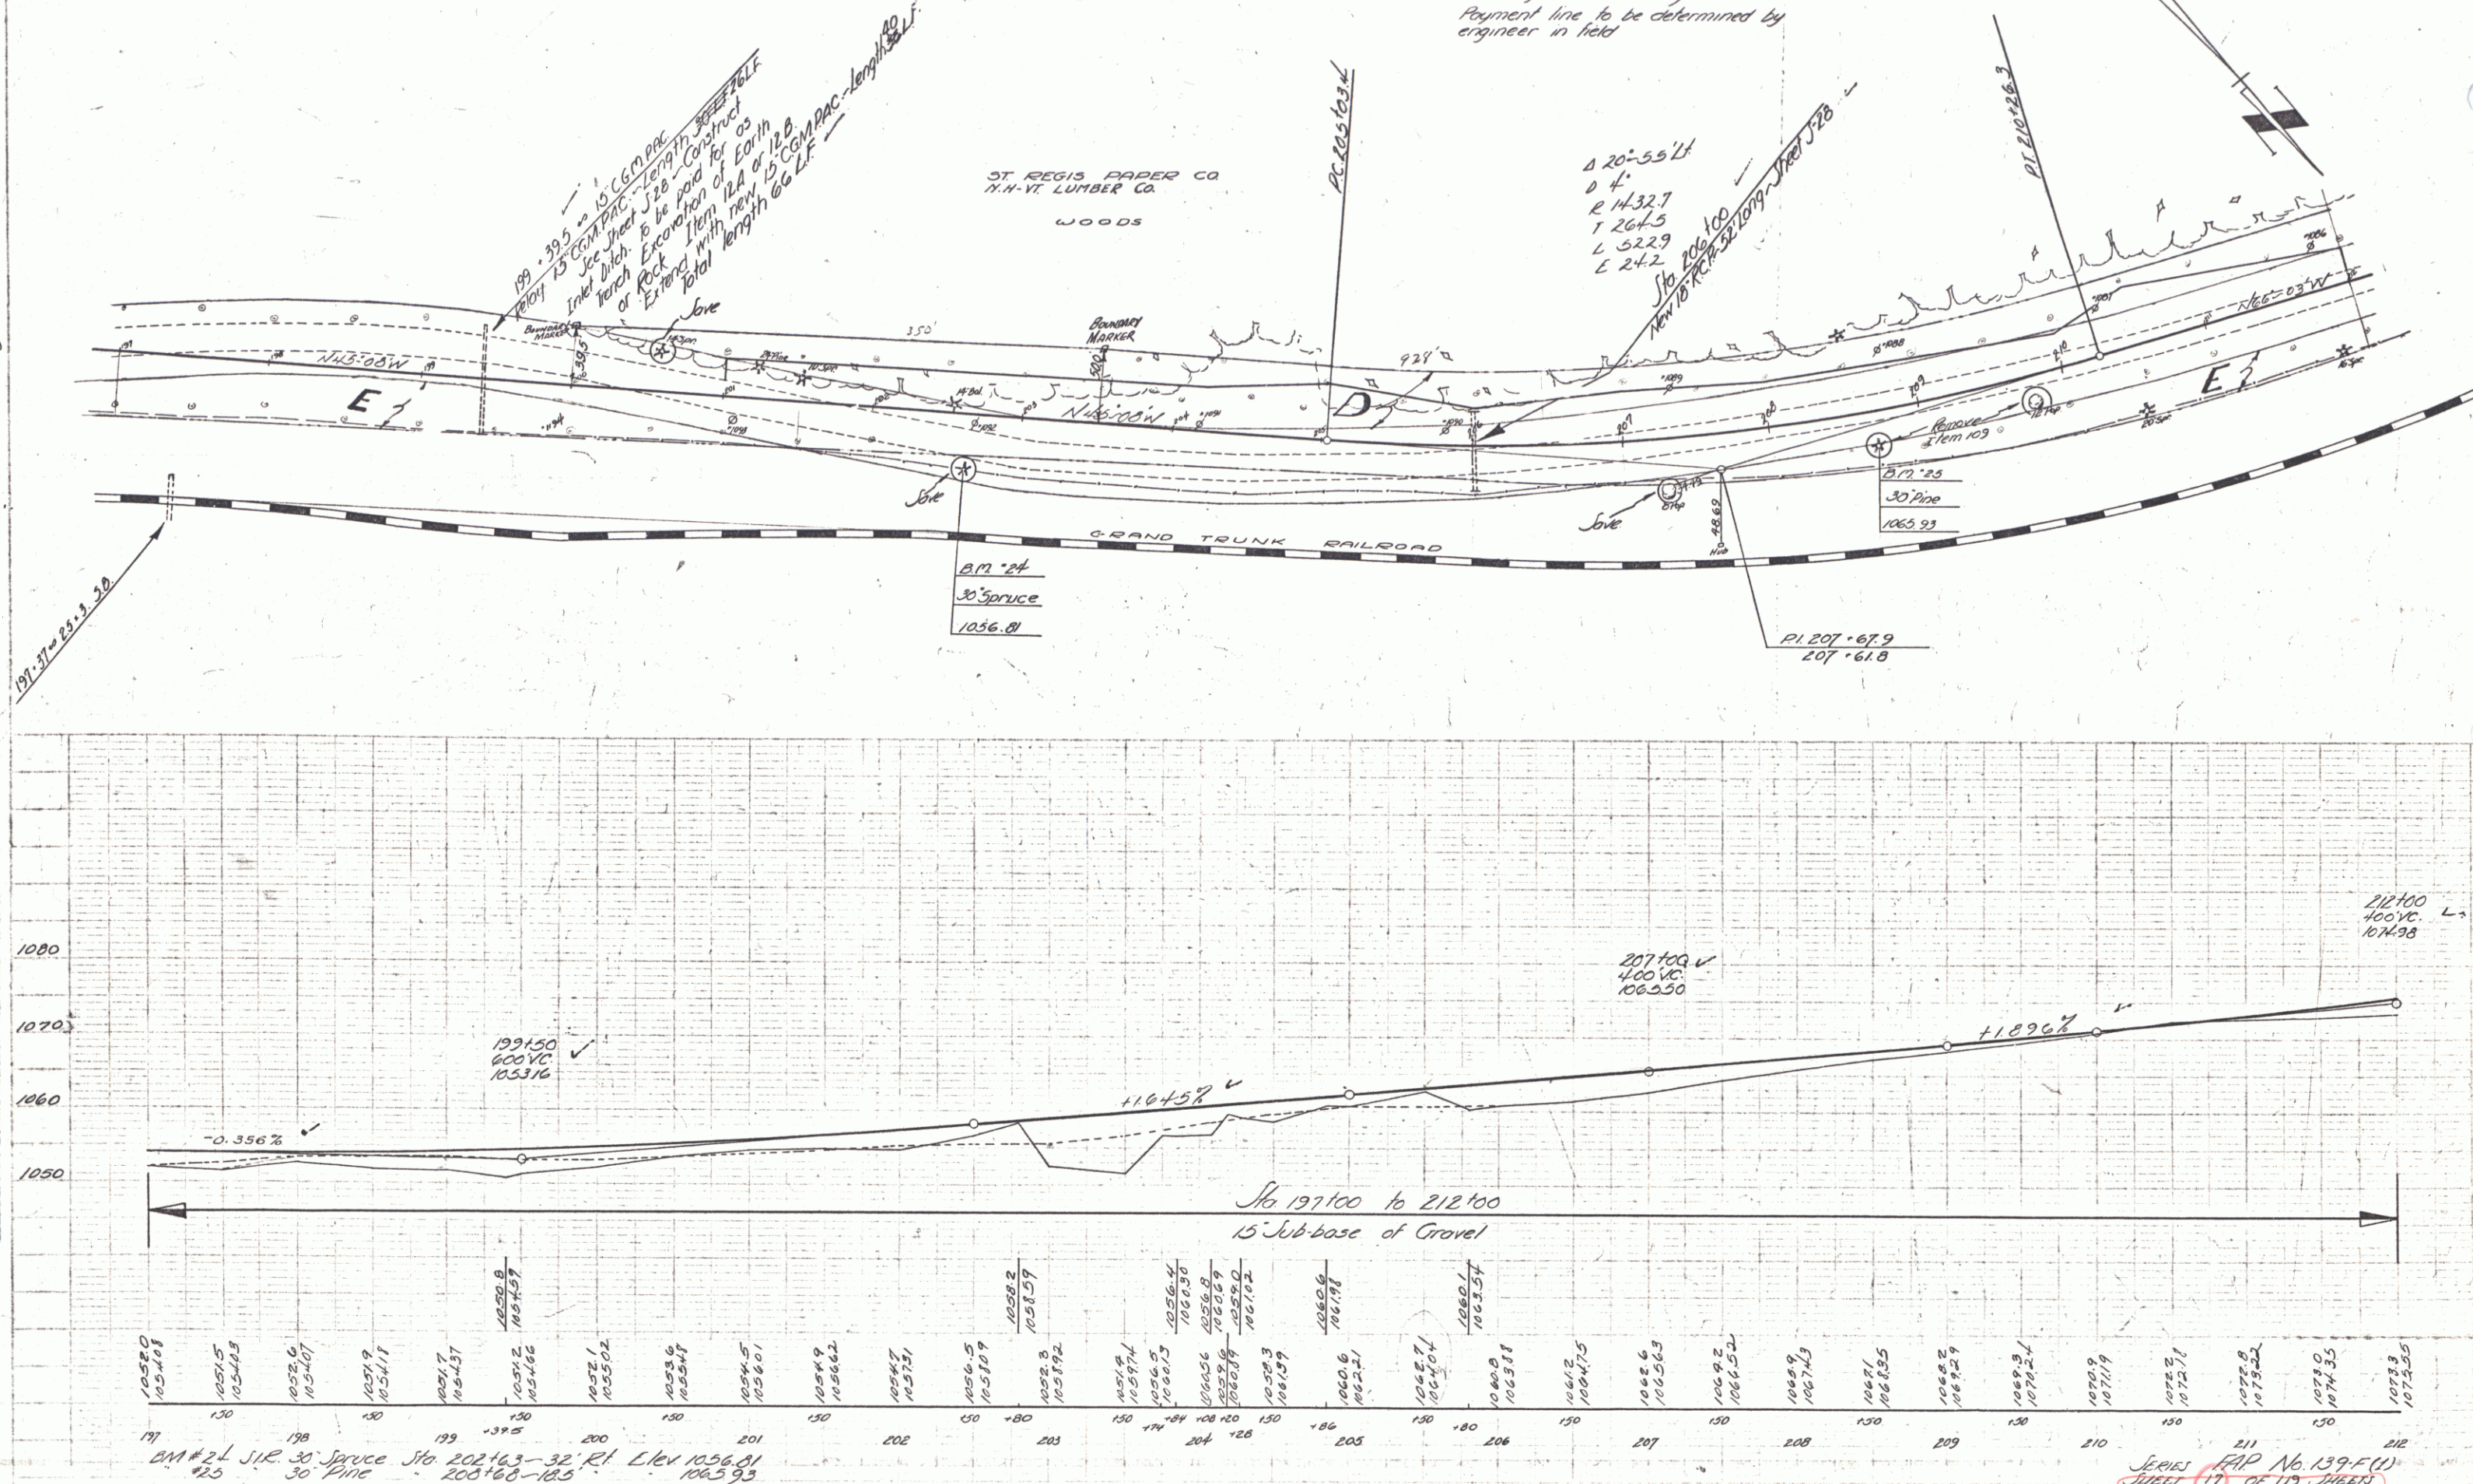

PARCEL	INSTRUMENT	DATE	GRANTOR	GRANTEE	RECORDED BLOOMFIELD	REMARK
21229	D E Q.C.D.	8-2-40	N.H.-VT LUMBER CO.	ST OF VT	BOOK 13 PAGE 281-284	DATE 8-24-40

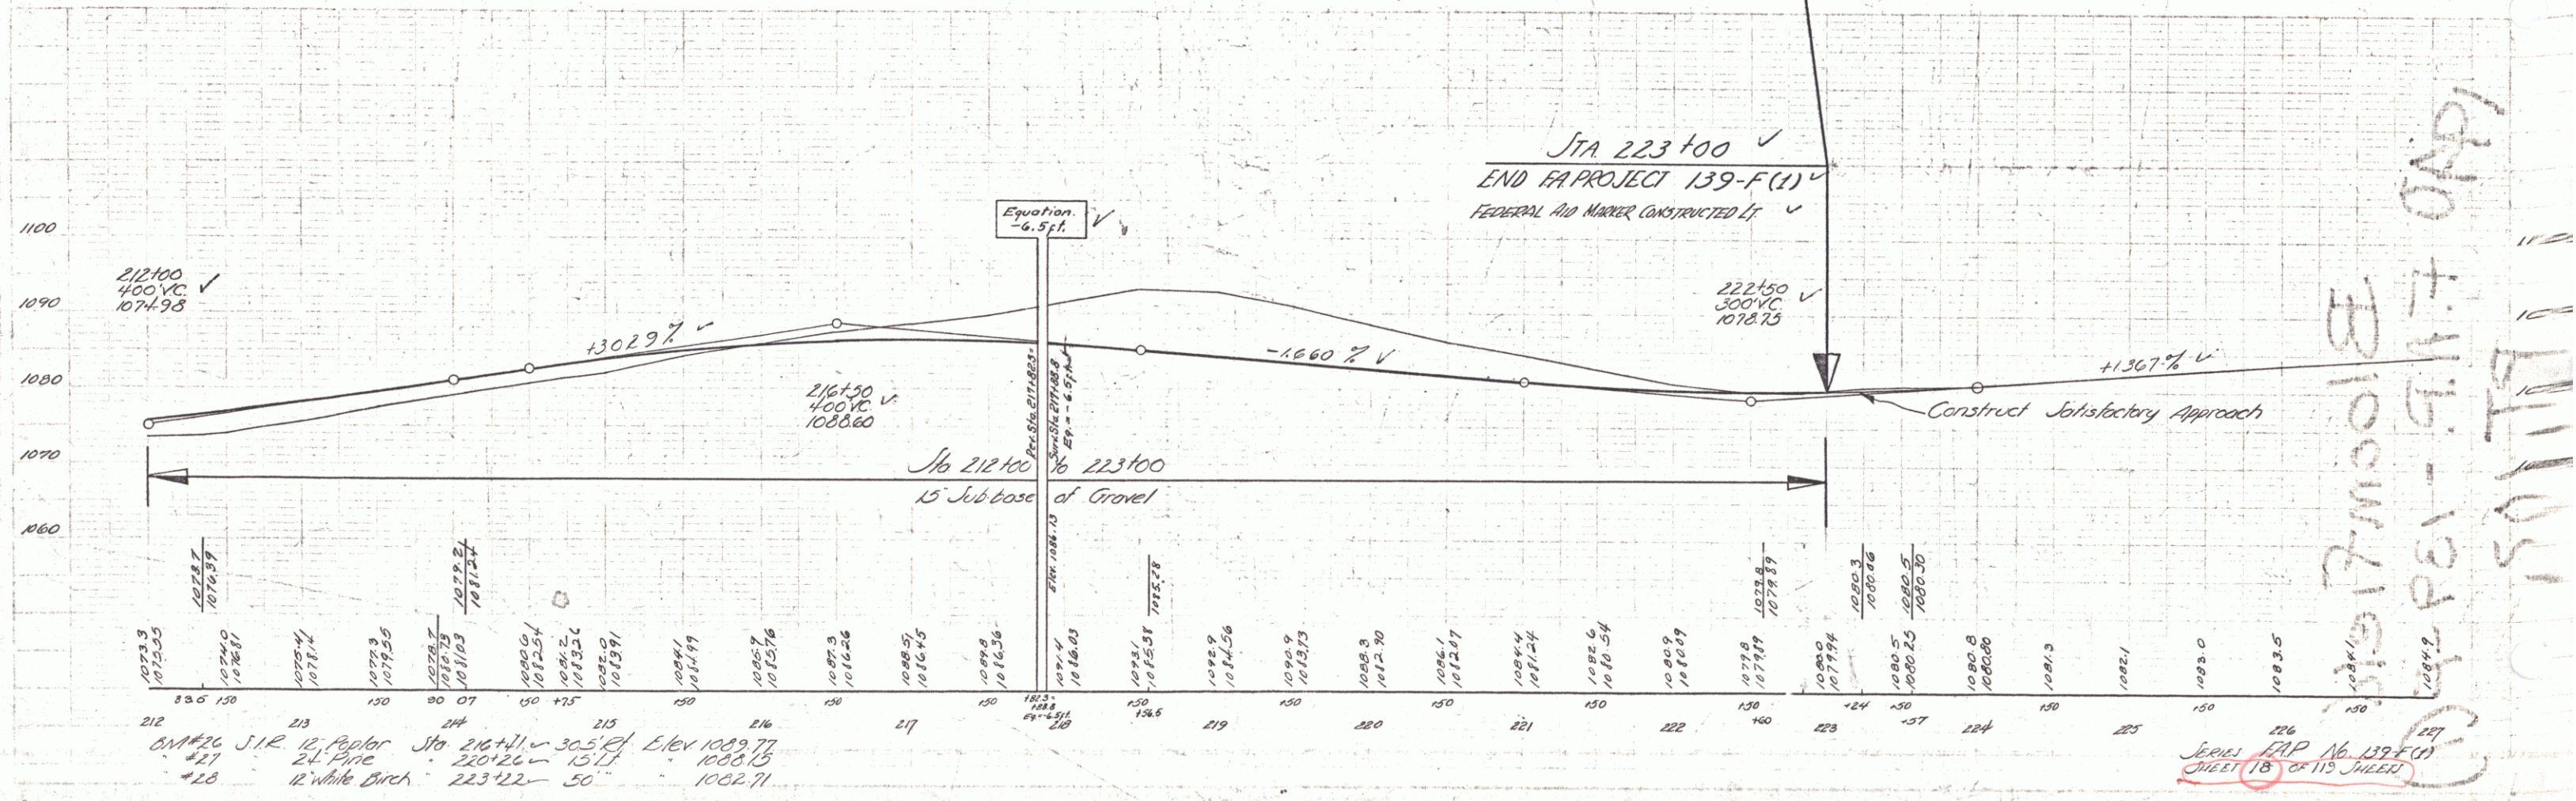

108411 108410 108409 108001 107999 107998 107997 107826