
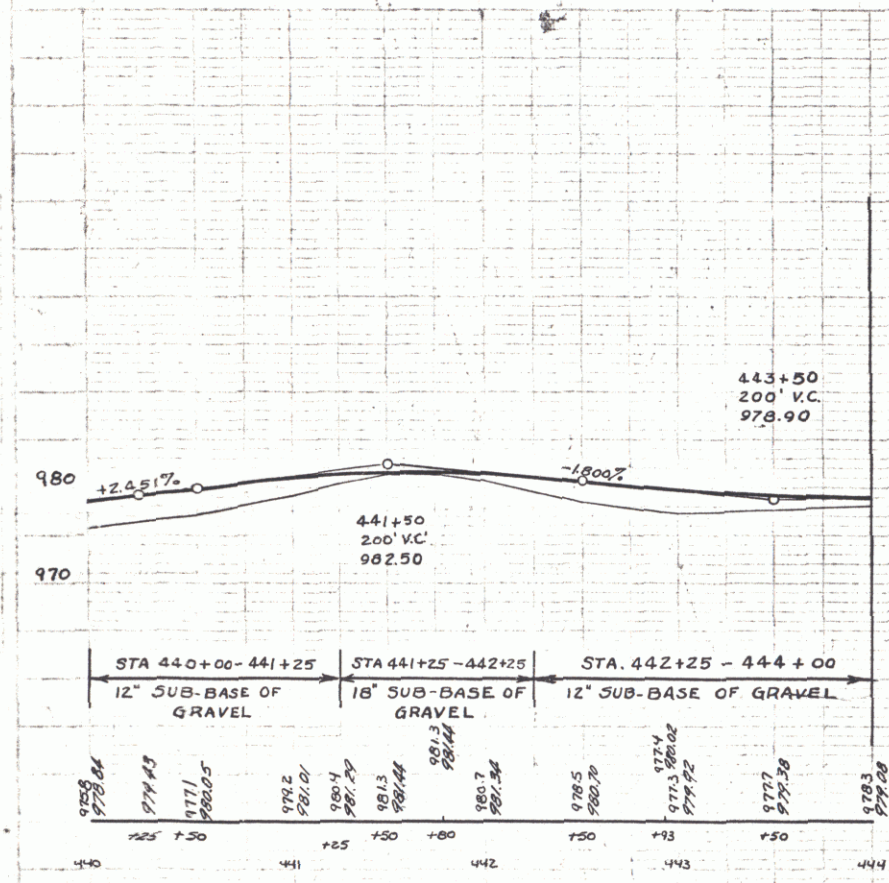


ARTHUR
O'NEILL
TACED

ARTHUR
O'NEILL

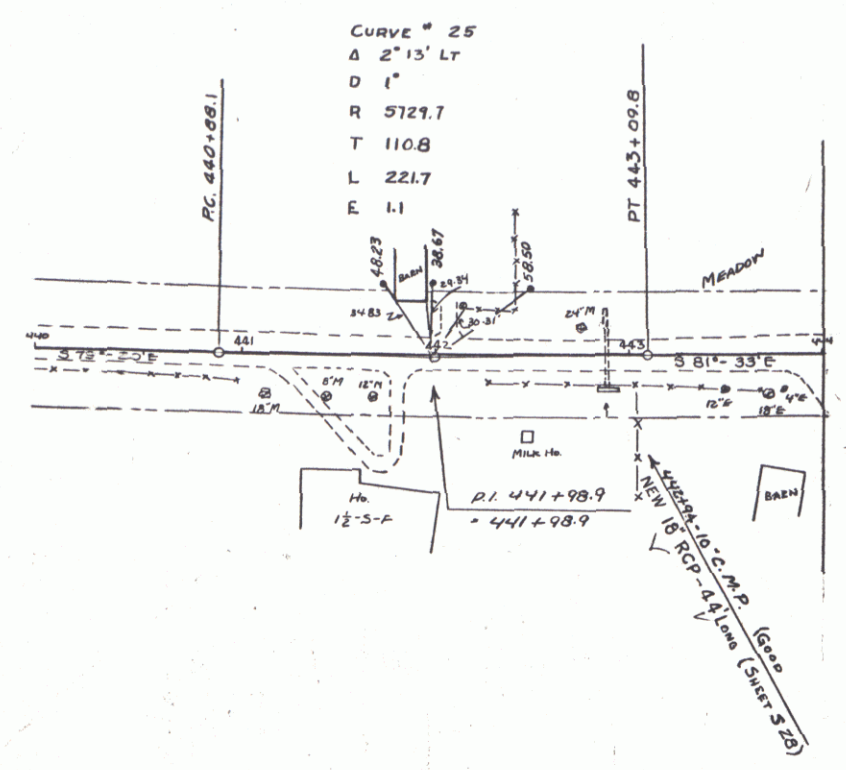

PROJECT NO.	STATE	FISCAL YEAR	SHEET NO.	TOTAL SHEETS
90-D	VT	1994	9	70

SERIES RFP NO 90-D
 SHEET 9 OF 70