


PUTNAM
D. MACCHI
TRACED

STATE ROAD NO. 10
30 D 1956 10 70

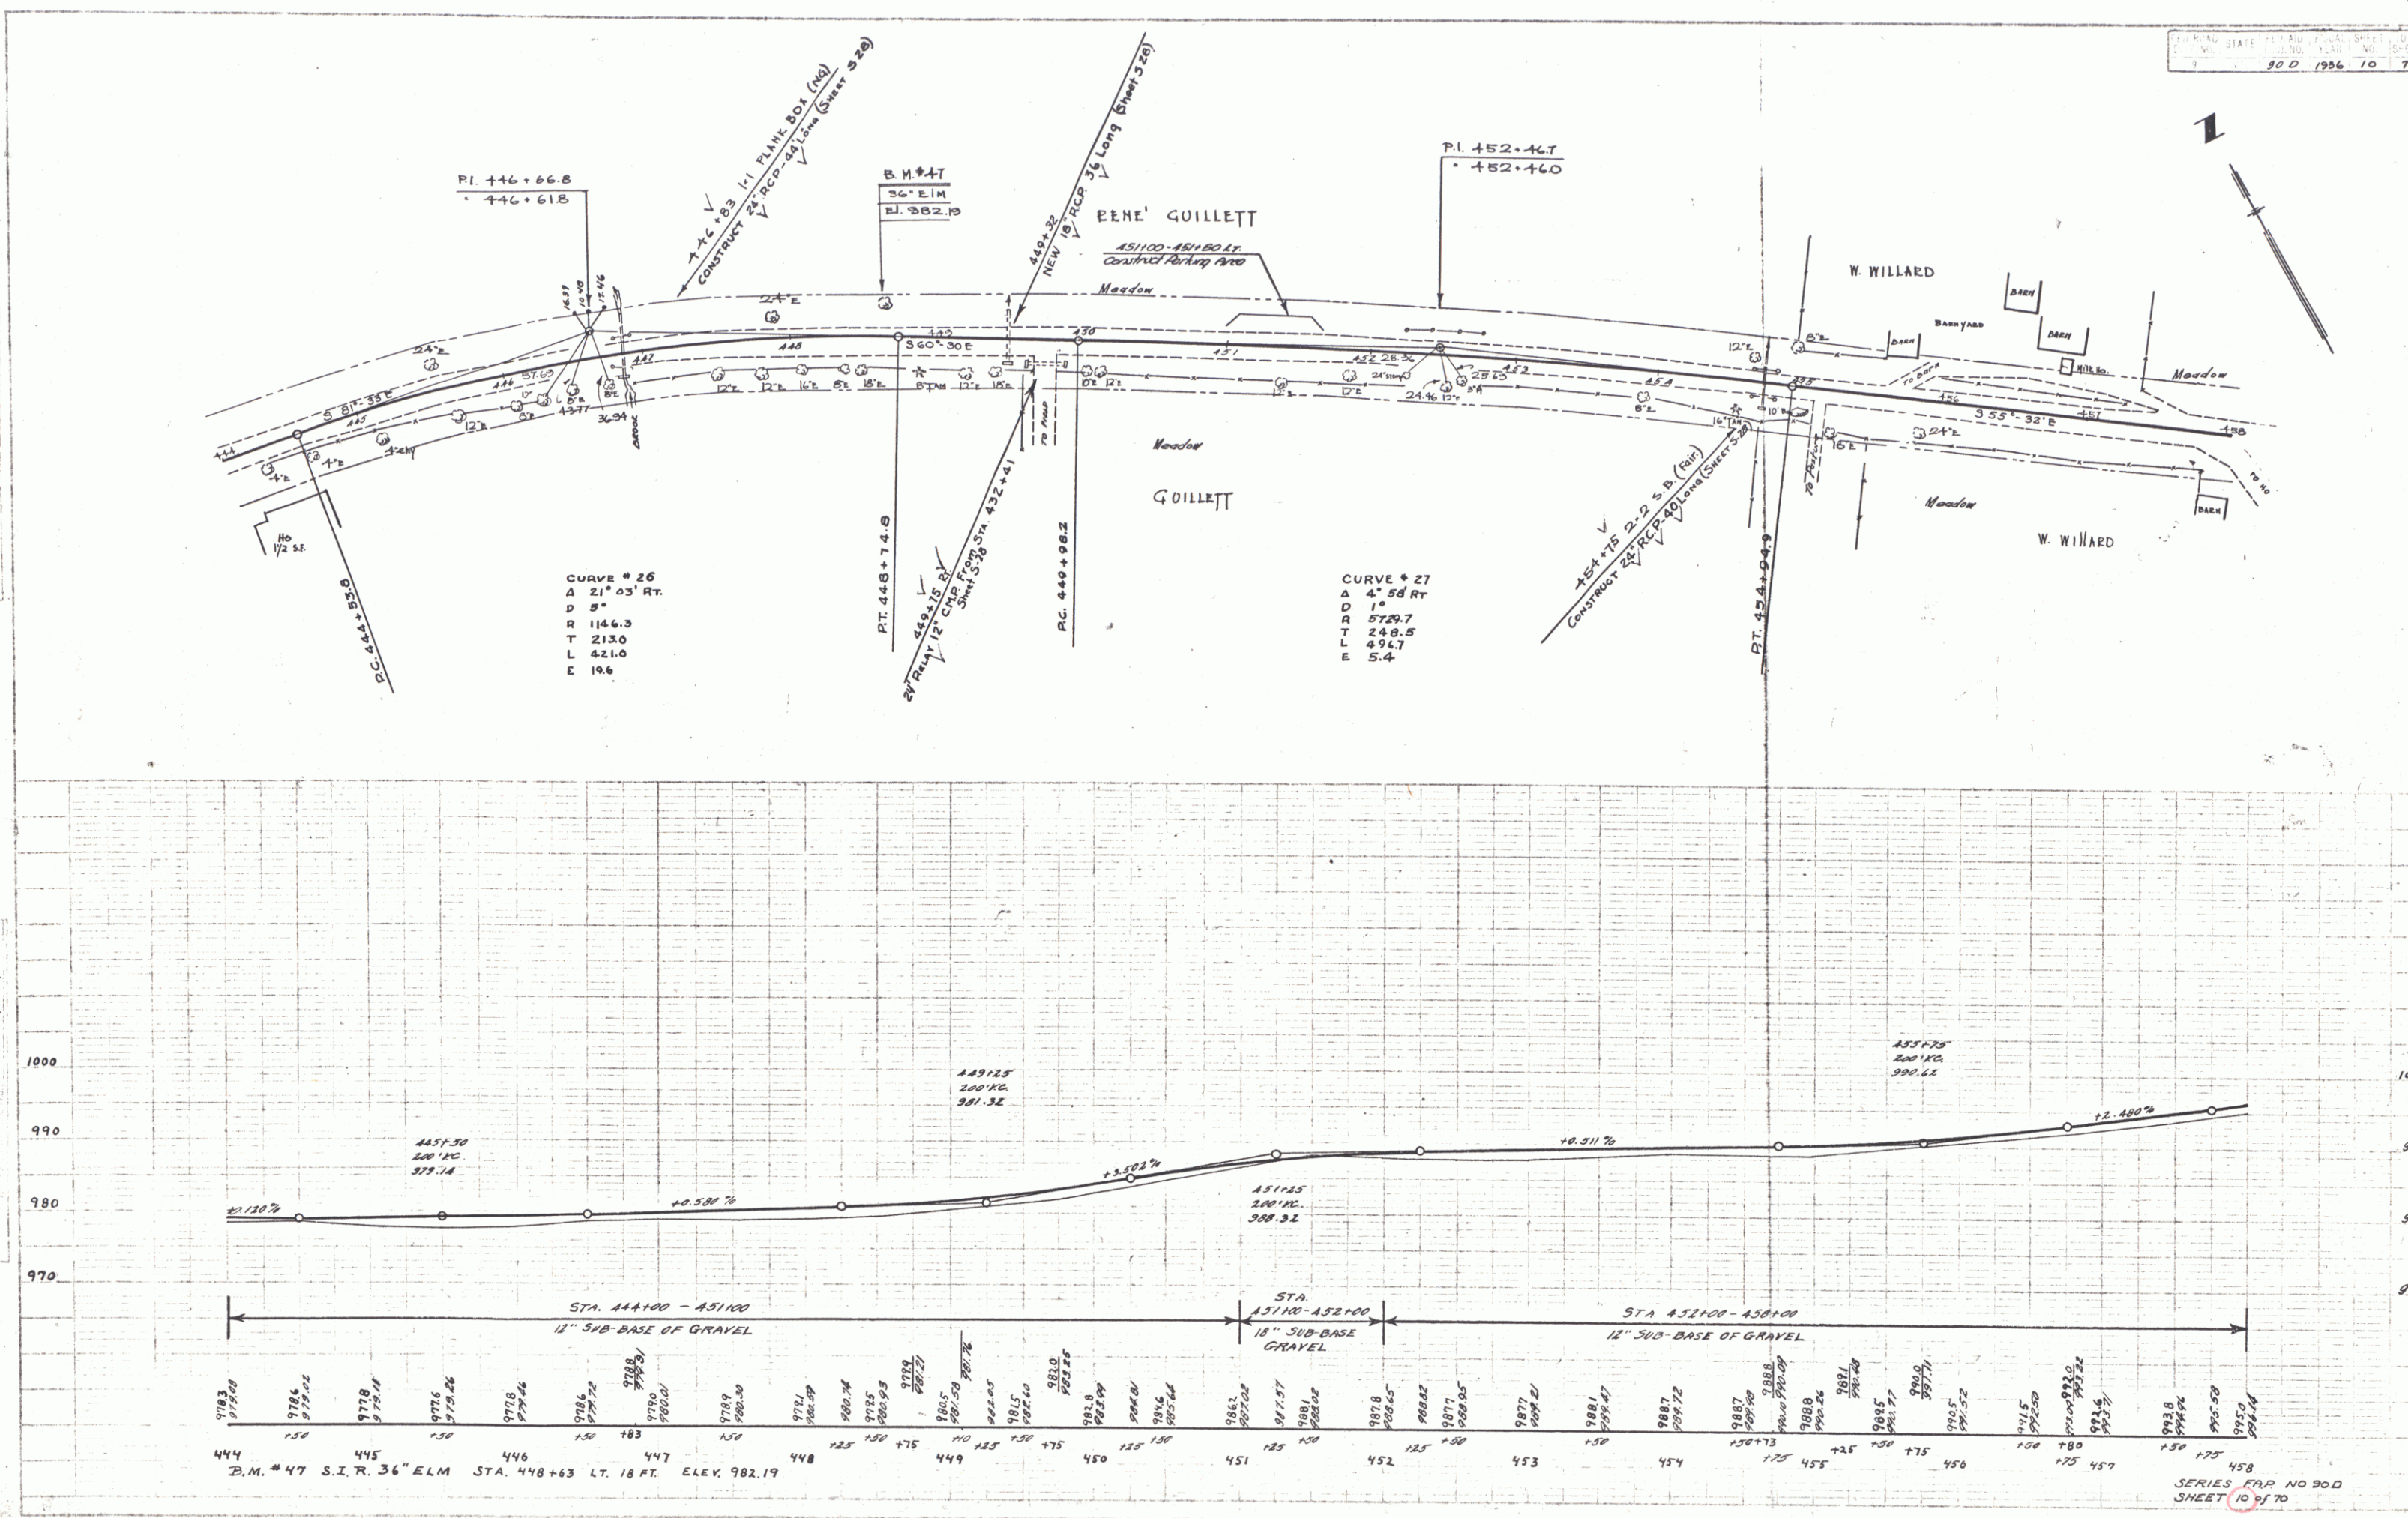

SERIES MAP NO 900
SHEET 10 OF 70