

PROPOSED IMPROVEMENT

FEDERAL AID PROJECT
1966-1967

COUNTY OF FRANKLIN
VT. ROUTE 105

Pin# 00R213

BEGINNING AT A POINT ON VT. ROUTE 105 IN THE VILLAGE OF EAST BERKSHIRE, 2.385 MILES SOUTHERLY OF THE BERKSHIRE-RICHFORD TOWN LINE AND EXTENDING NORTHERLY 2.365 MILES, INCLUDING BRIDGE.

LENGTH OF ROADWAY 12,440.46 FEET = 2.356 MILES
LENGTH OF BRIDGE 151.92 FEET = 0.029 MILES

LENGTH OF PROJECT 12,592.38 FEET = 2.385 MILES

LENGTH OF PROJECT 12,592.38 FEET = 2.385 MILES

ADT (1960)	900
ADT (1985)	1750
DHV (1985)	270
D	61%
T	7 1/2%
V	50 M2H


RIGHT-OF-WAY DIVISION

T O W N F I L E


PERPETUAL

~~Town~~ of U4105

(To Be Returned To R.O.W. Division)

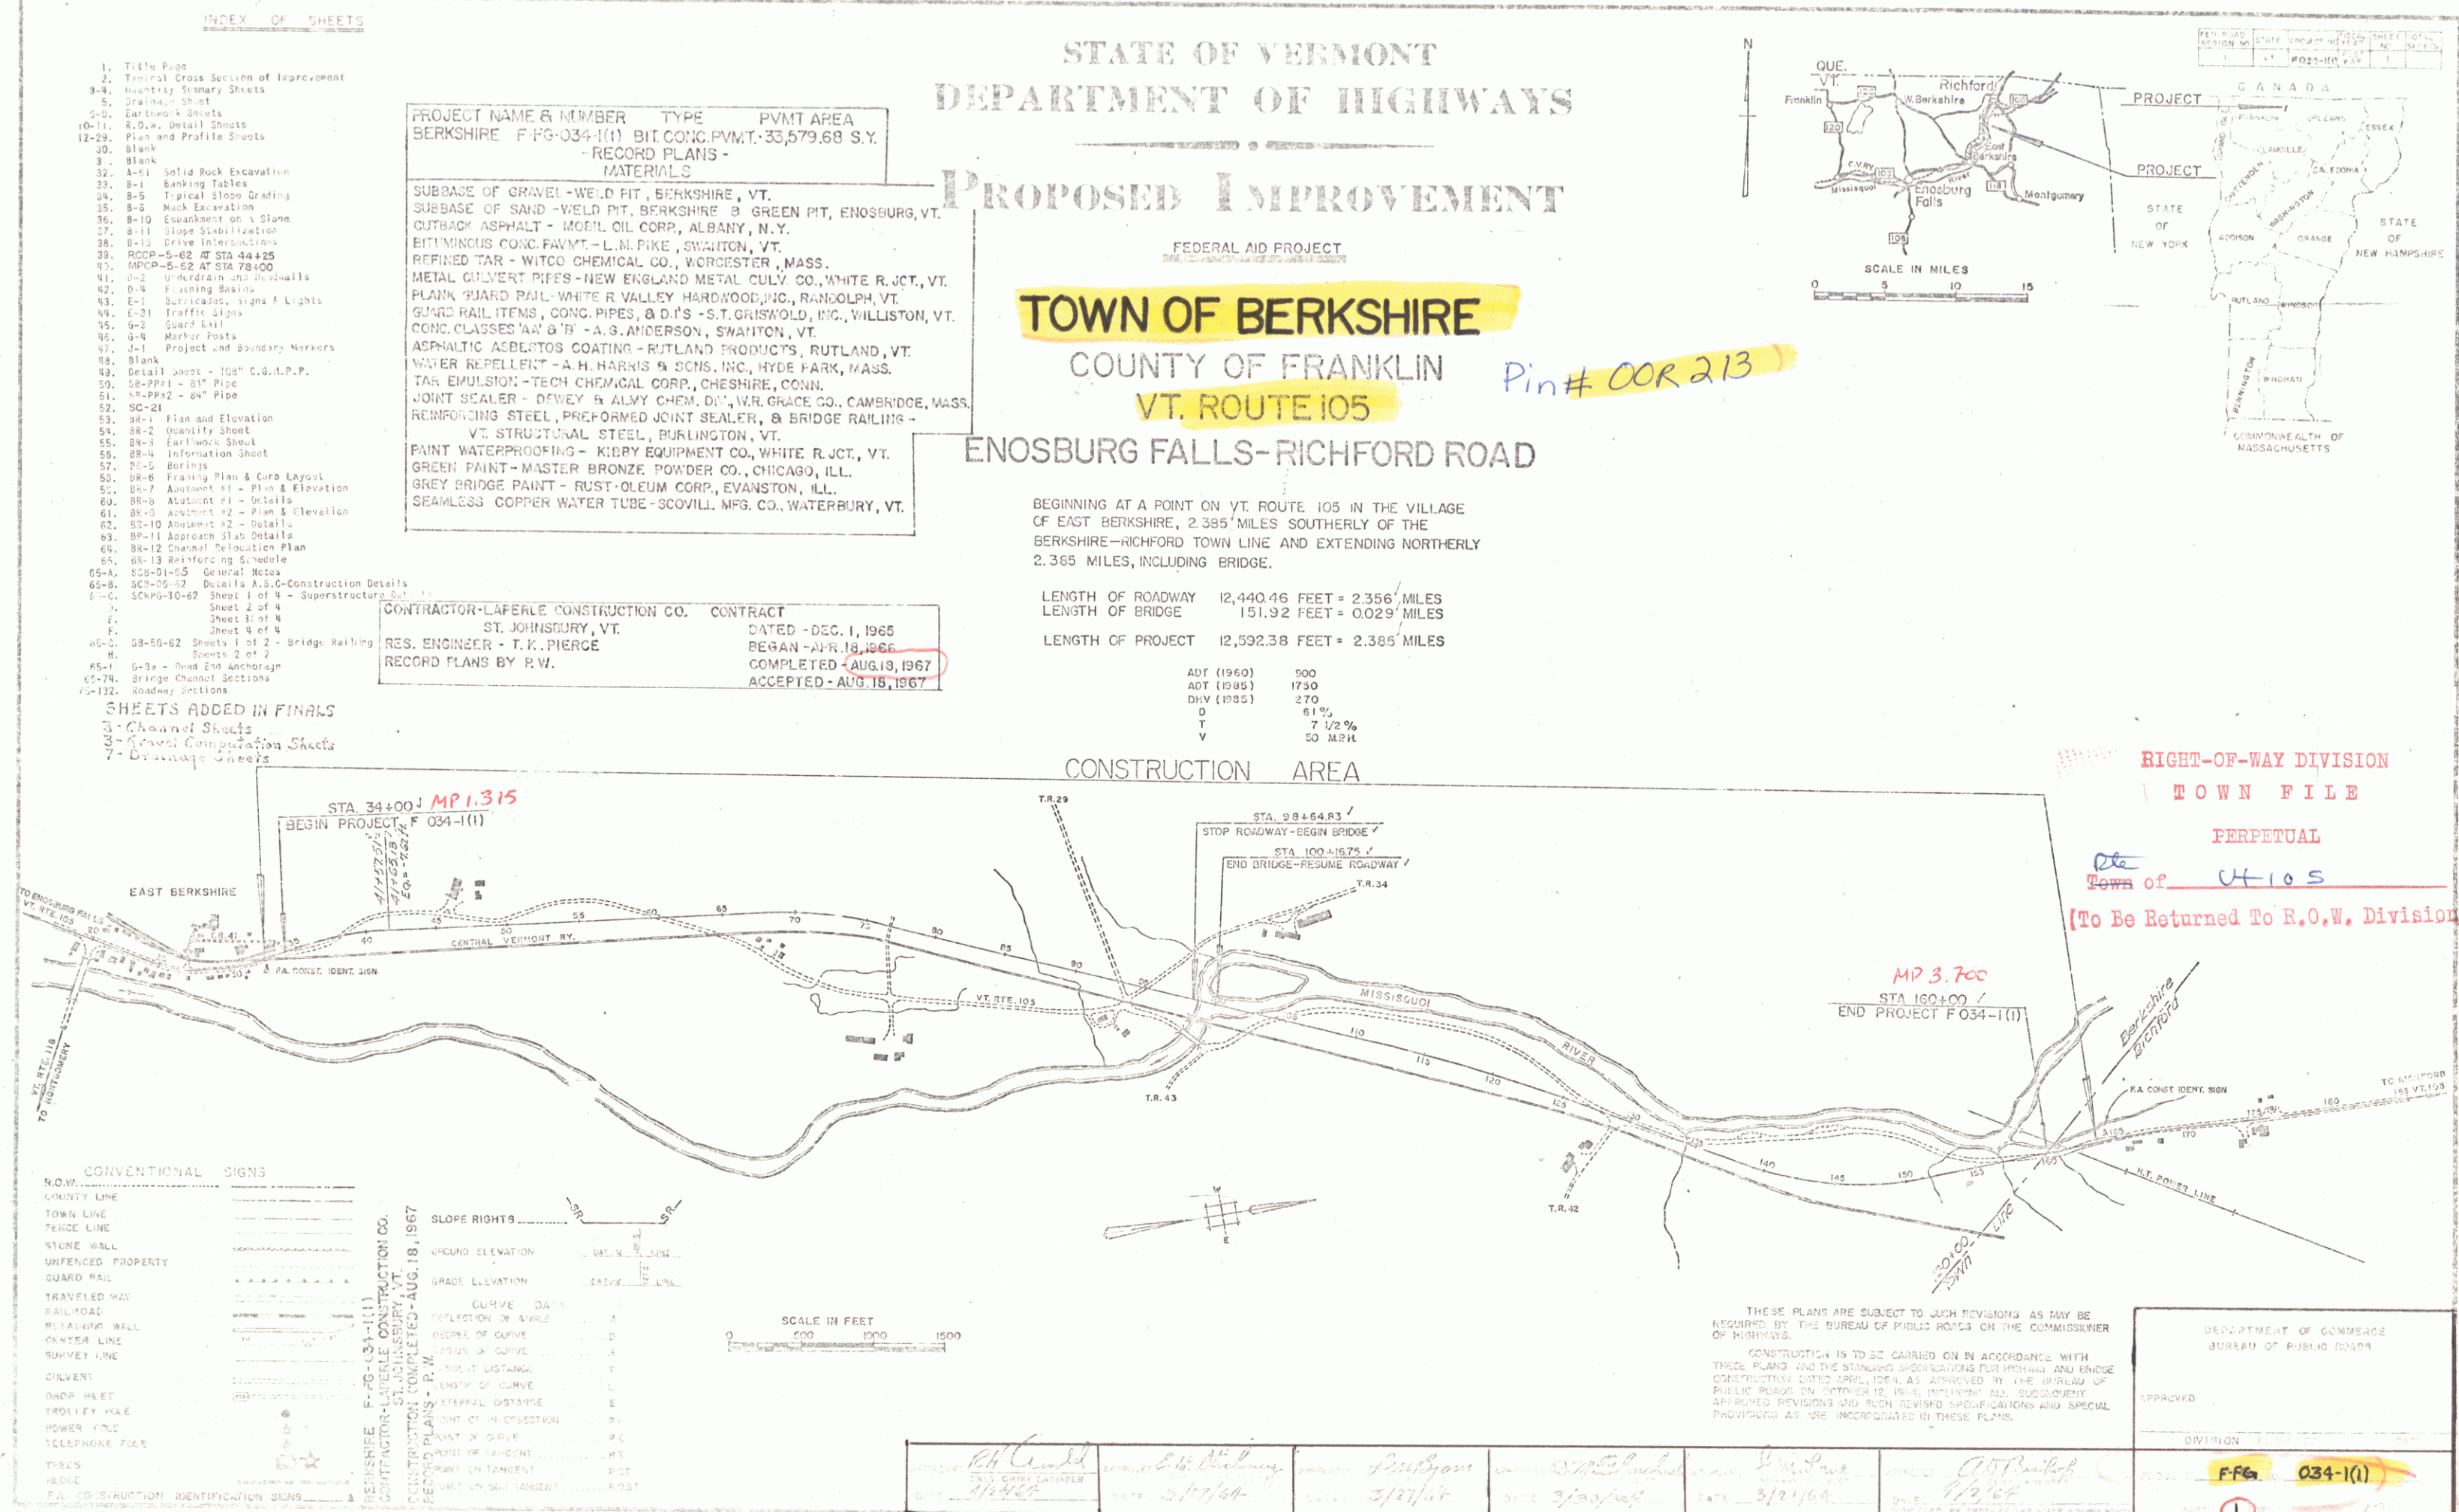

PLAN	BY	DATE
1. PREPARED BY	W. J. H. H.	1942
2. CHECKED BY	W. J. H. H.	1942
3. APPROVED BY	W. J. H. H.	1942
4. REVISIONS		
5. NOTES		

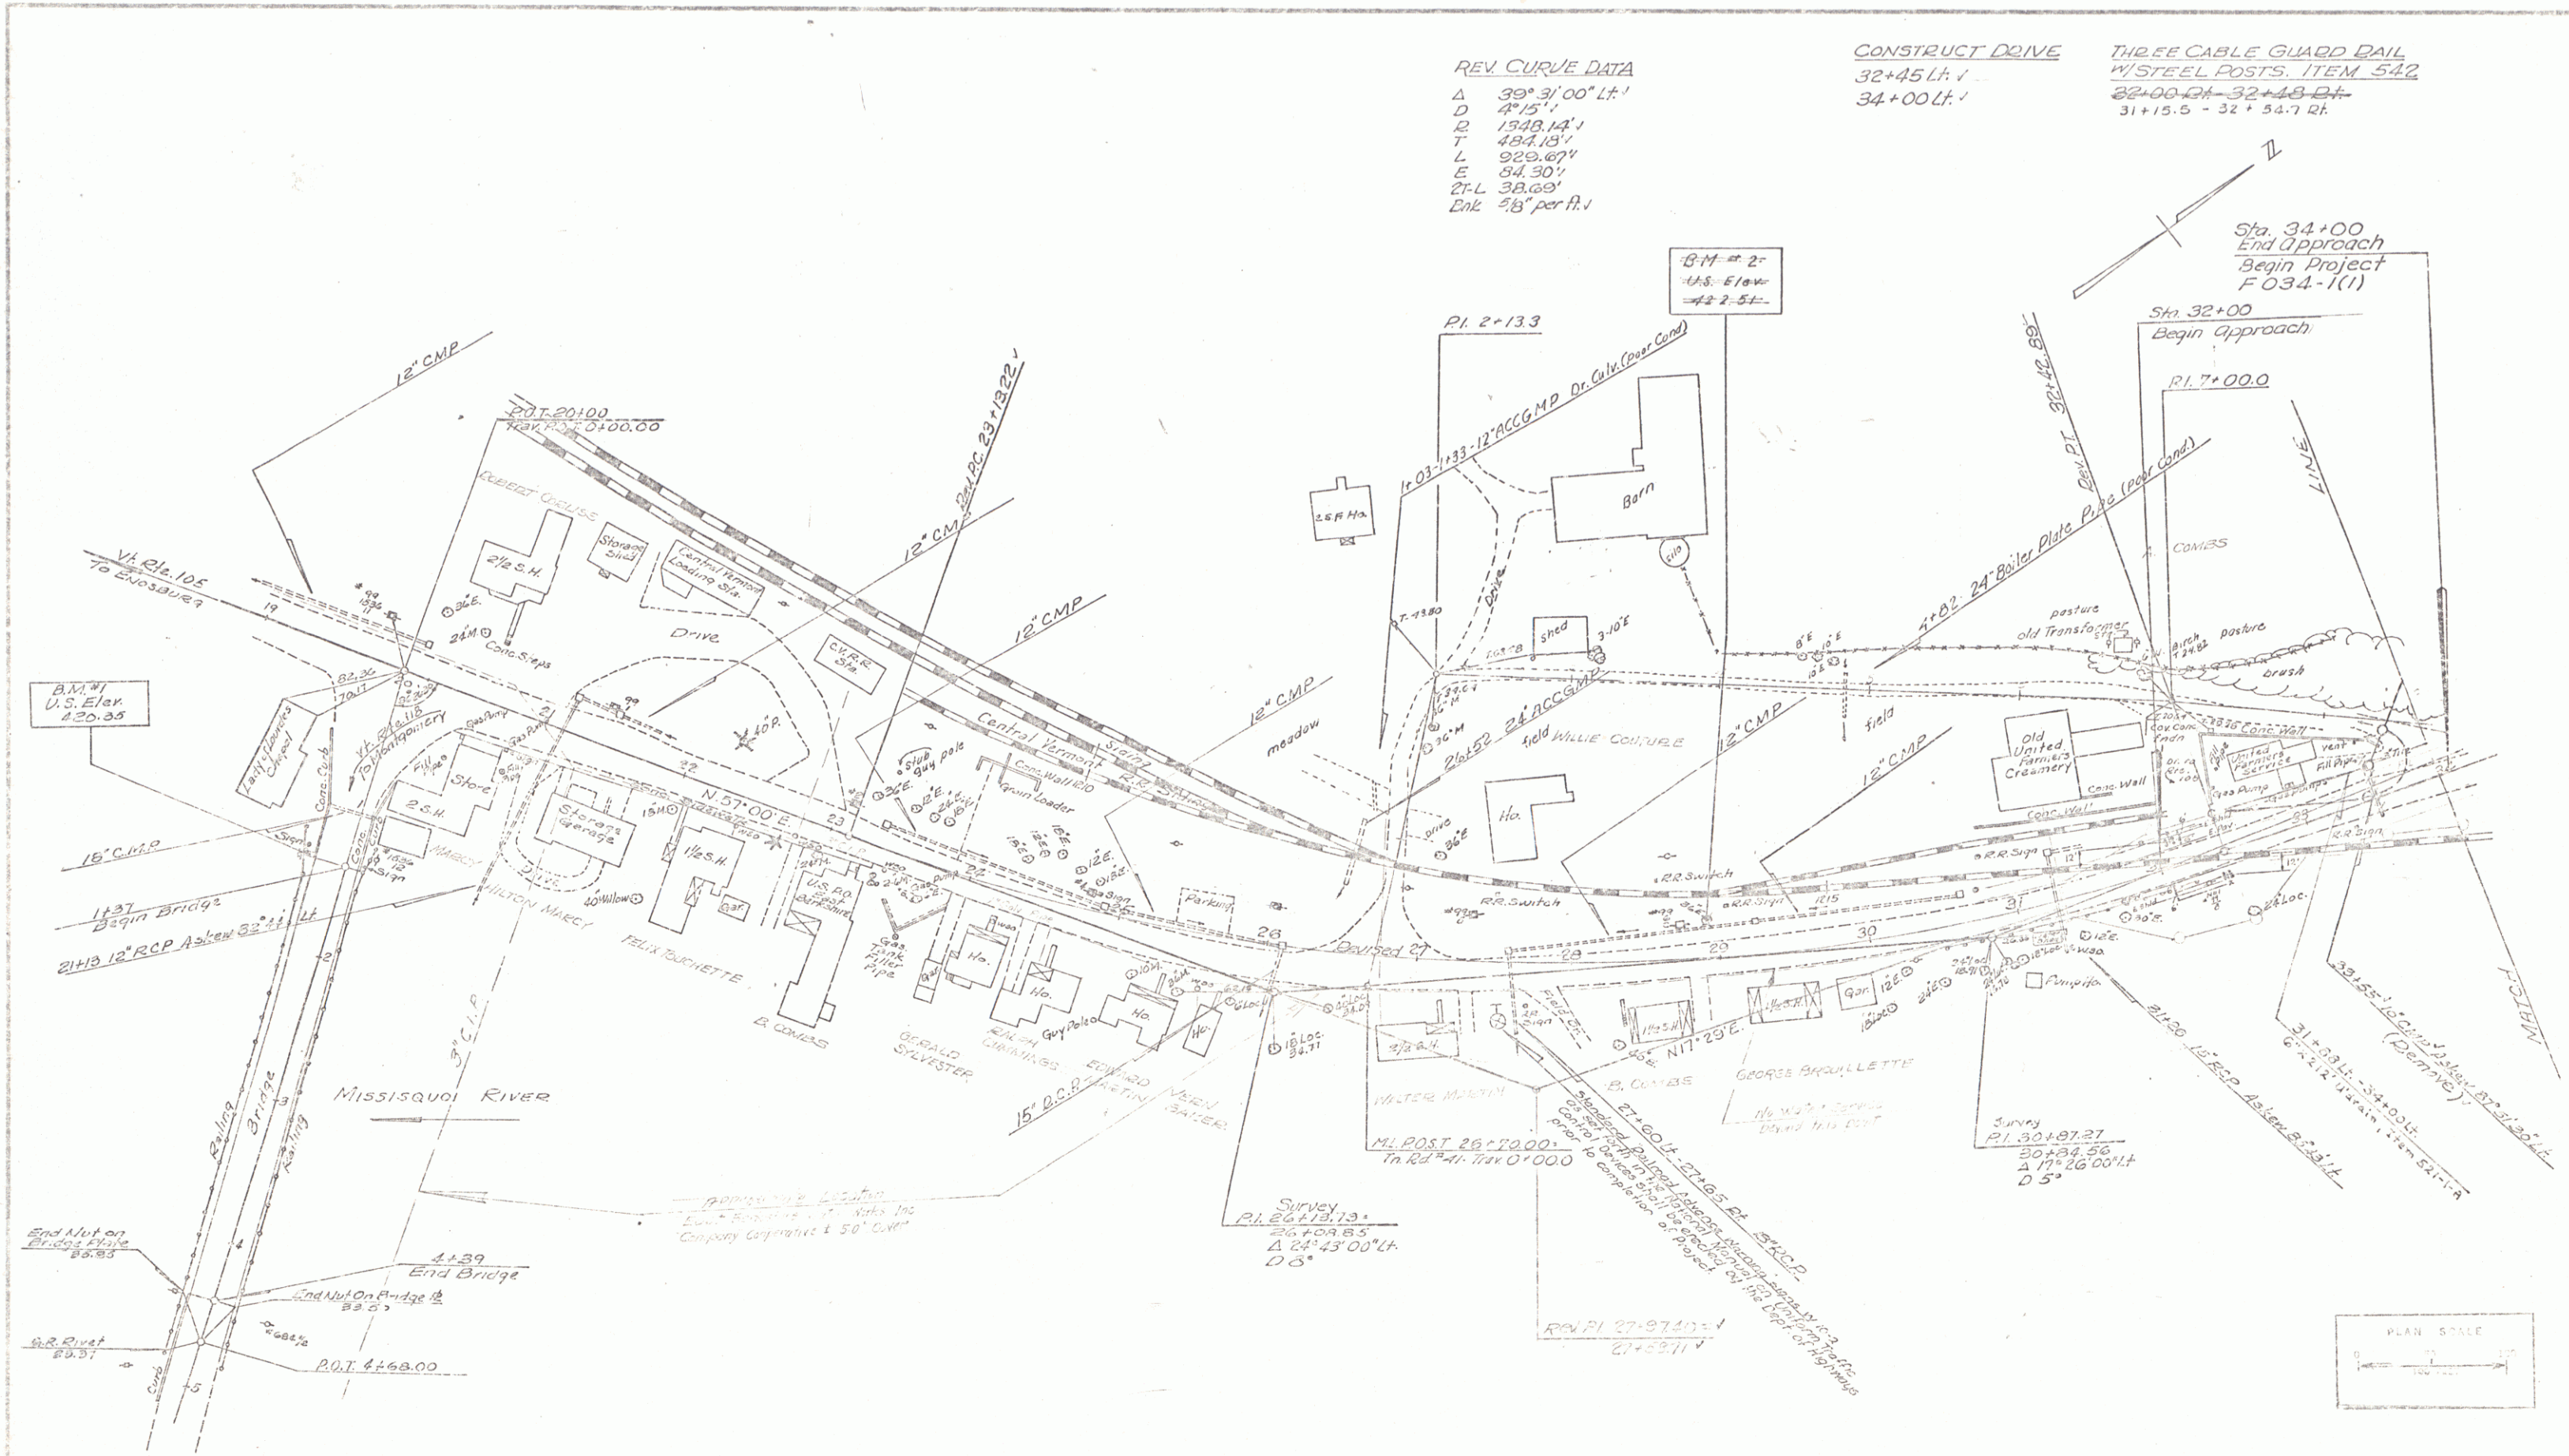

REV. CURVE DATA
 $\Delta 39^\circ 31' 00''$
 $D 4' 15''$
 $R 1348.14'$
 $T 484.13'$
 $L 929.67'$
 $E 84.30'$
 $2FL 38.69'$
 $Ent 2.8'$ per ft.


CONSTRUCT DRIVE
 32+45 L.F.
 34+00 L.F.

THREE CABLE GUARD RAIL
 W/STEEL POSTS. ITEM 542
 32+00-32+45 R.F.
 31+15.5 - 32+54.7 R.F.


Sta. 34+00
 End Approach
 Begin Project
 F034-1(1)

BECKSHIRE
 F-EG-034-1(1)
 Sheet 12 of 132 Sheets

PLAN	SECTION	DATE	BY	CHKD
1	2	3	4	5
6	7	8	9	10
11	12	13	14	15
16	17	18	19	20
21	22	23	24	25
26	27	28	29	30
31	32	33	34	35
36	37	38	39	40
41	42	43	44	45
46	47	48	49	50
51	52	53	54	55
56	57	58	59	60
61	62	63	64	65
66	67	68	69	70
71	72	73	74	75
76	77	78	79	80
81	82	83	84	85
86	87	88	89	90
91	92	93	94	95
96	97	98	99	100

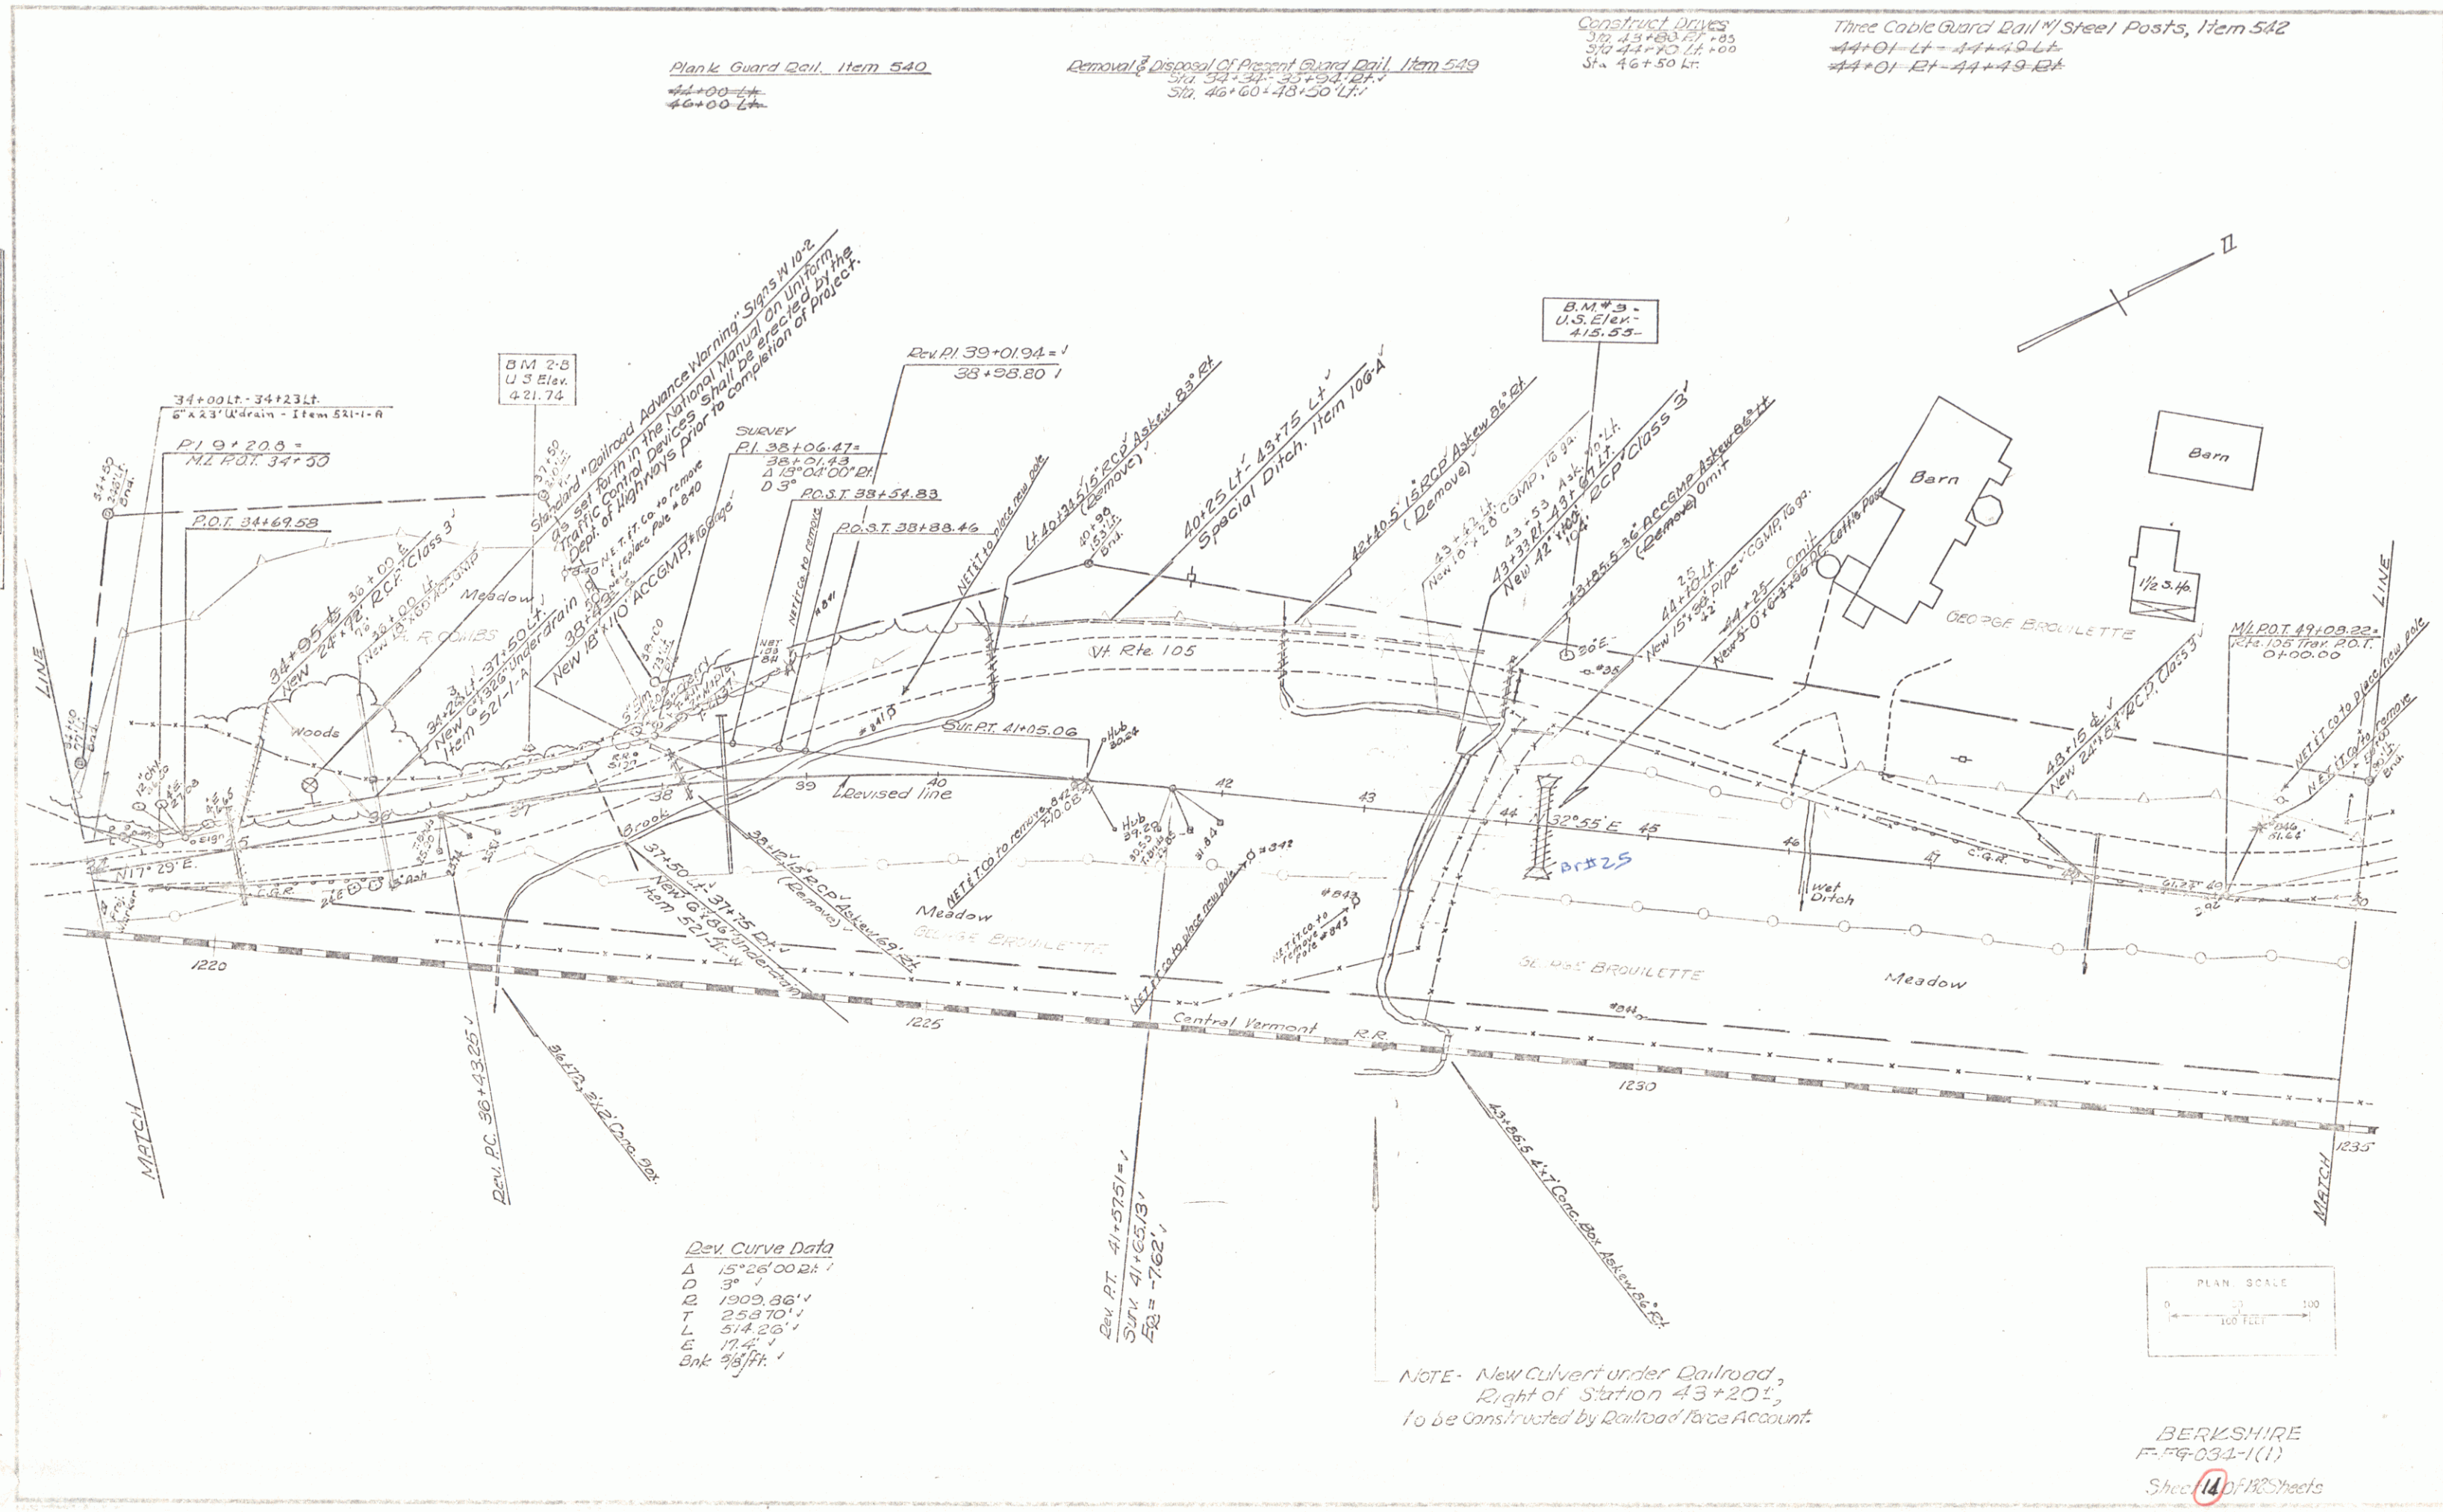


PLAN	SURVEYED	BY	24
	ROUTED	BURNEY	
	ALIGNMENT CHECKED	MASON	4/23
POINTS SHOWN	BY		
BY	ROUTED	SWELL	4/23
	TEASER		

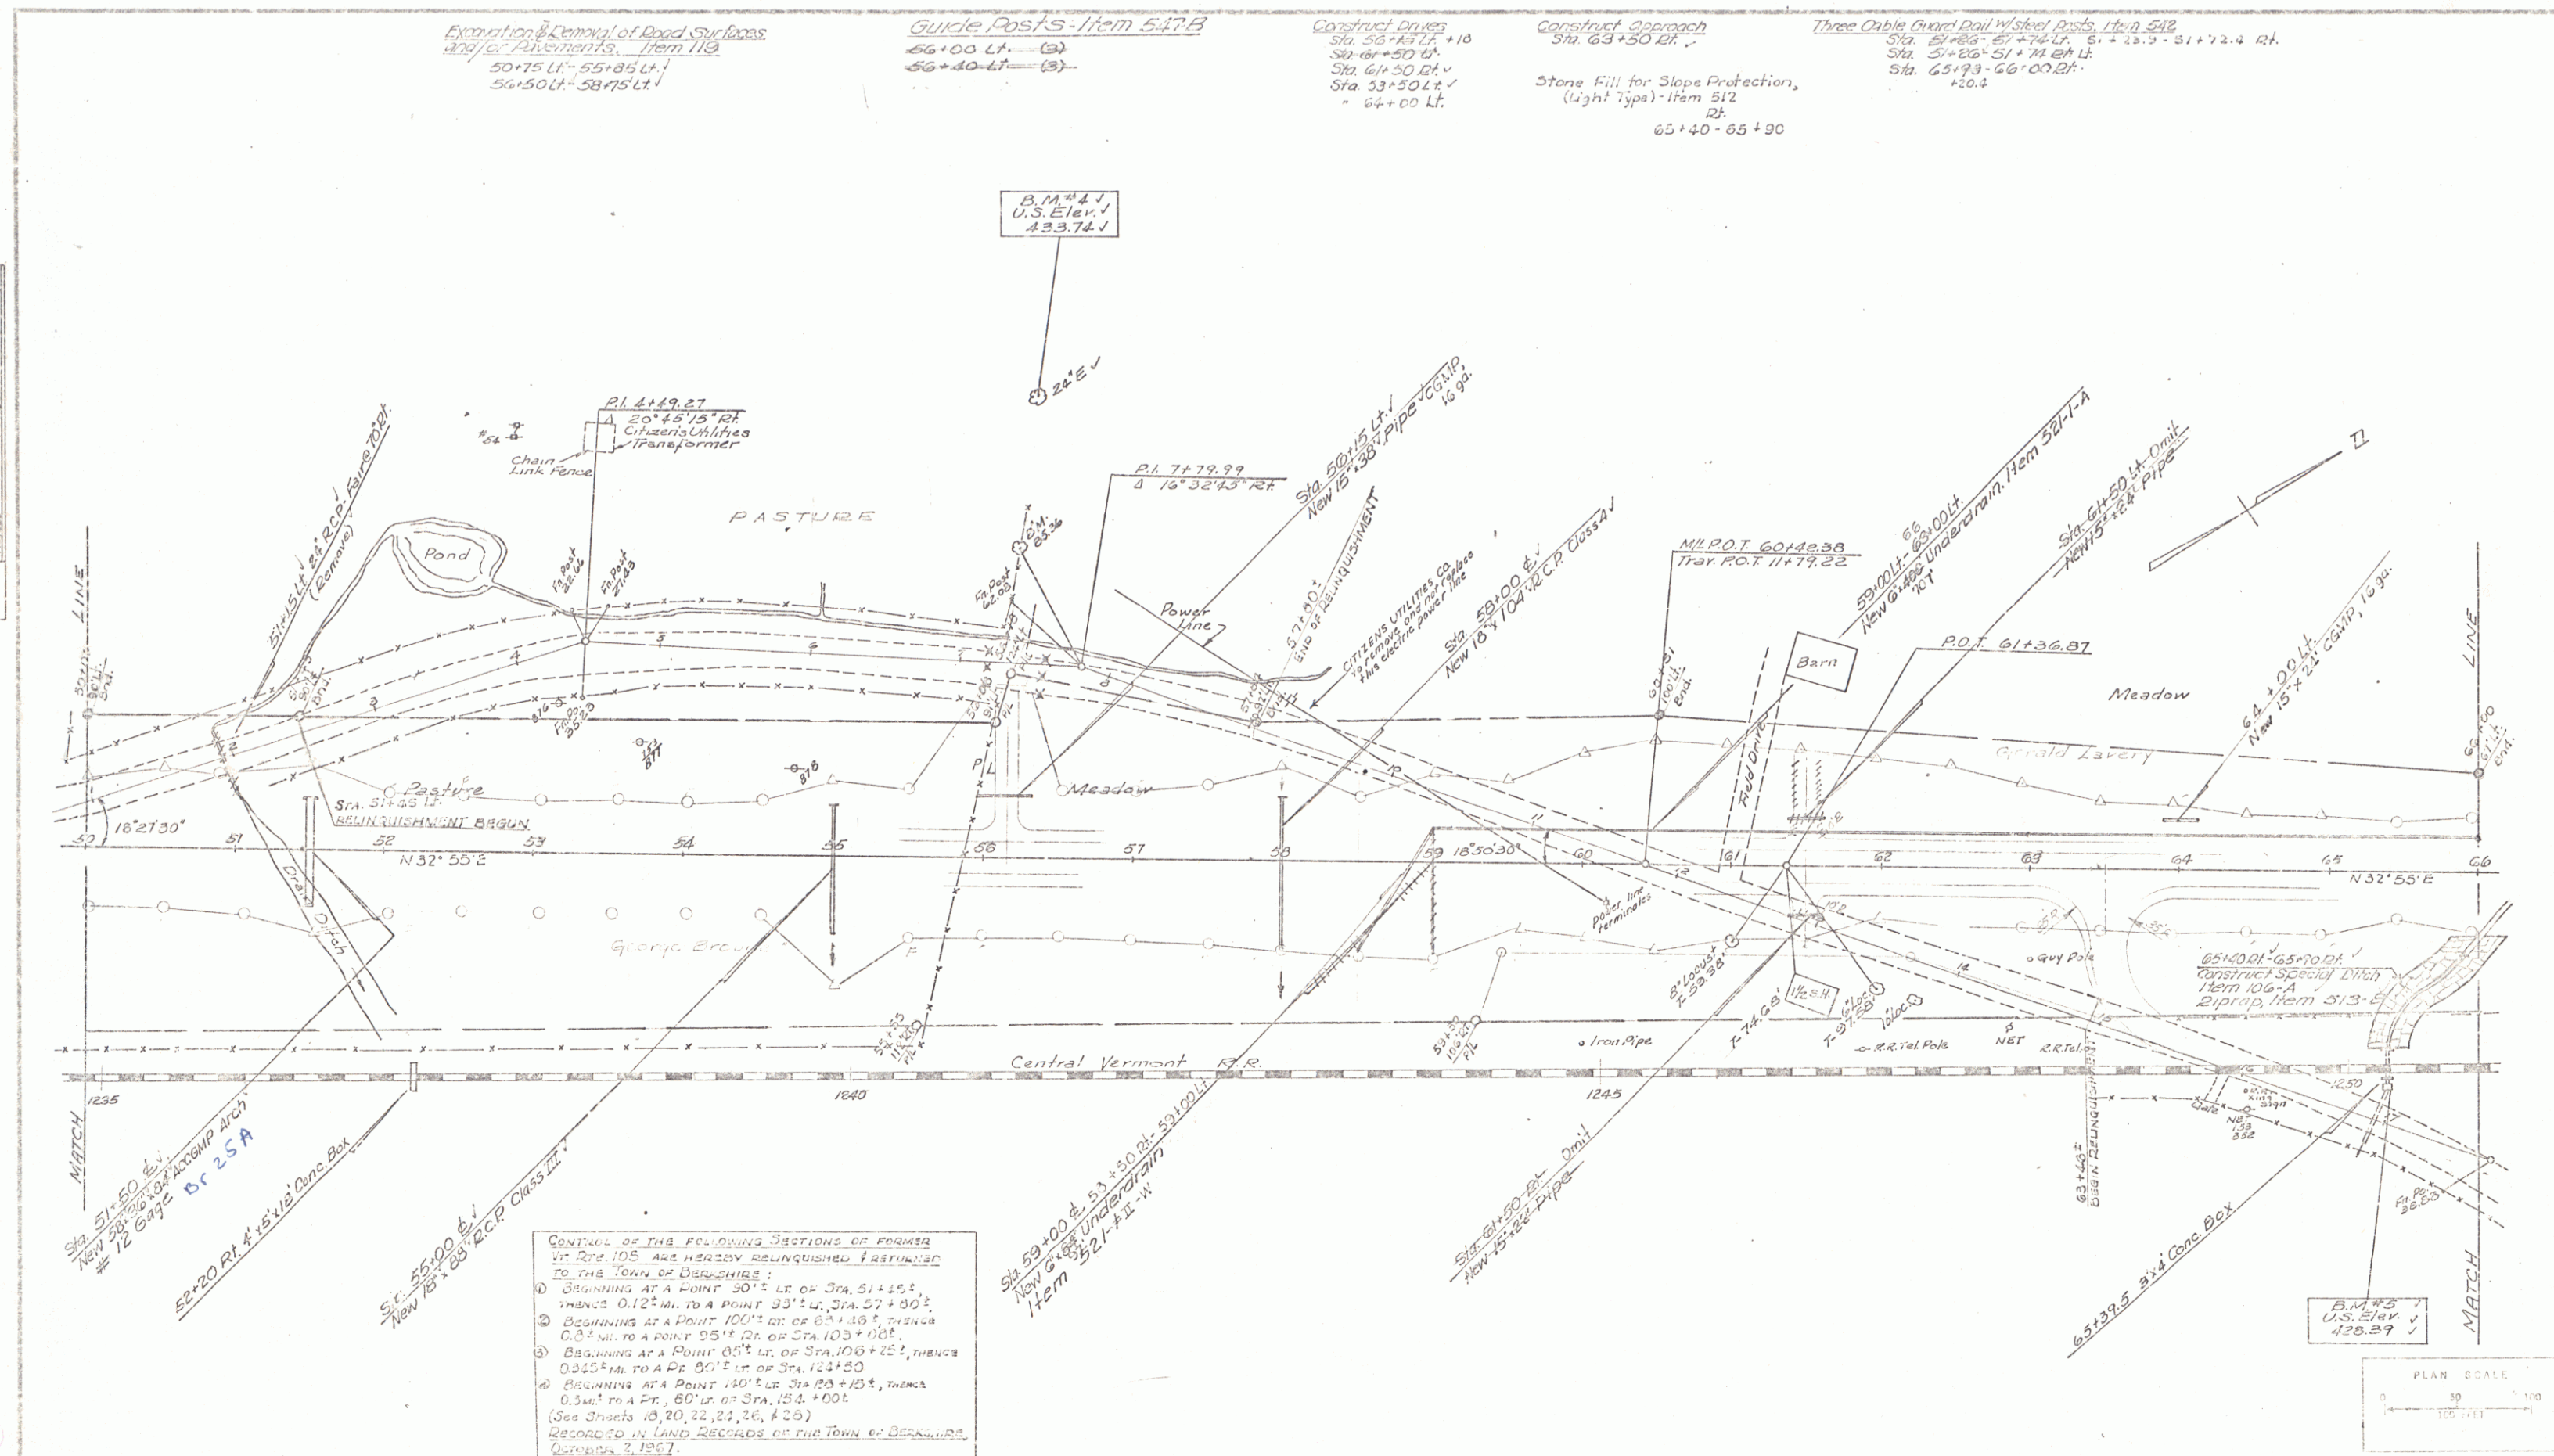


BEDKSHIRE
F-FG-034-1(1)
Sheet 16 of 132 Sheets

PLAN	BY	DATE
DESIGNED	BY	DATE
CHECKED	BY	DATE
NOTED	BY	DATE
REVISION	BY	DATE

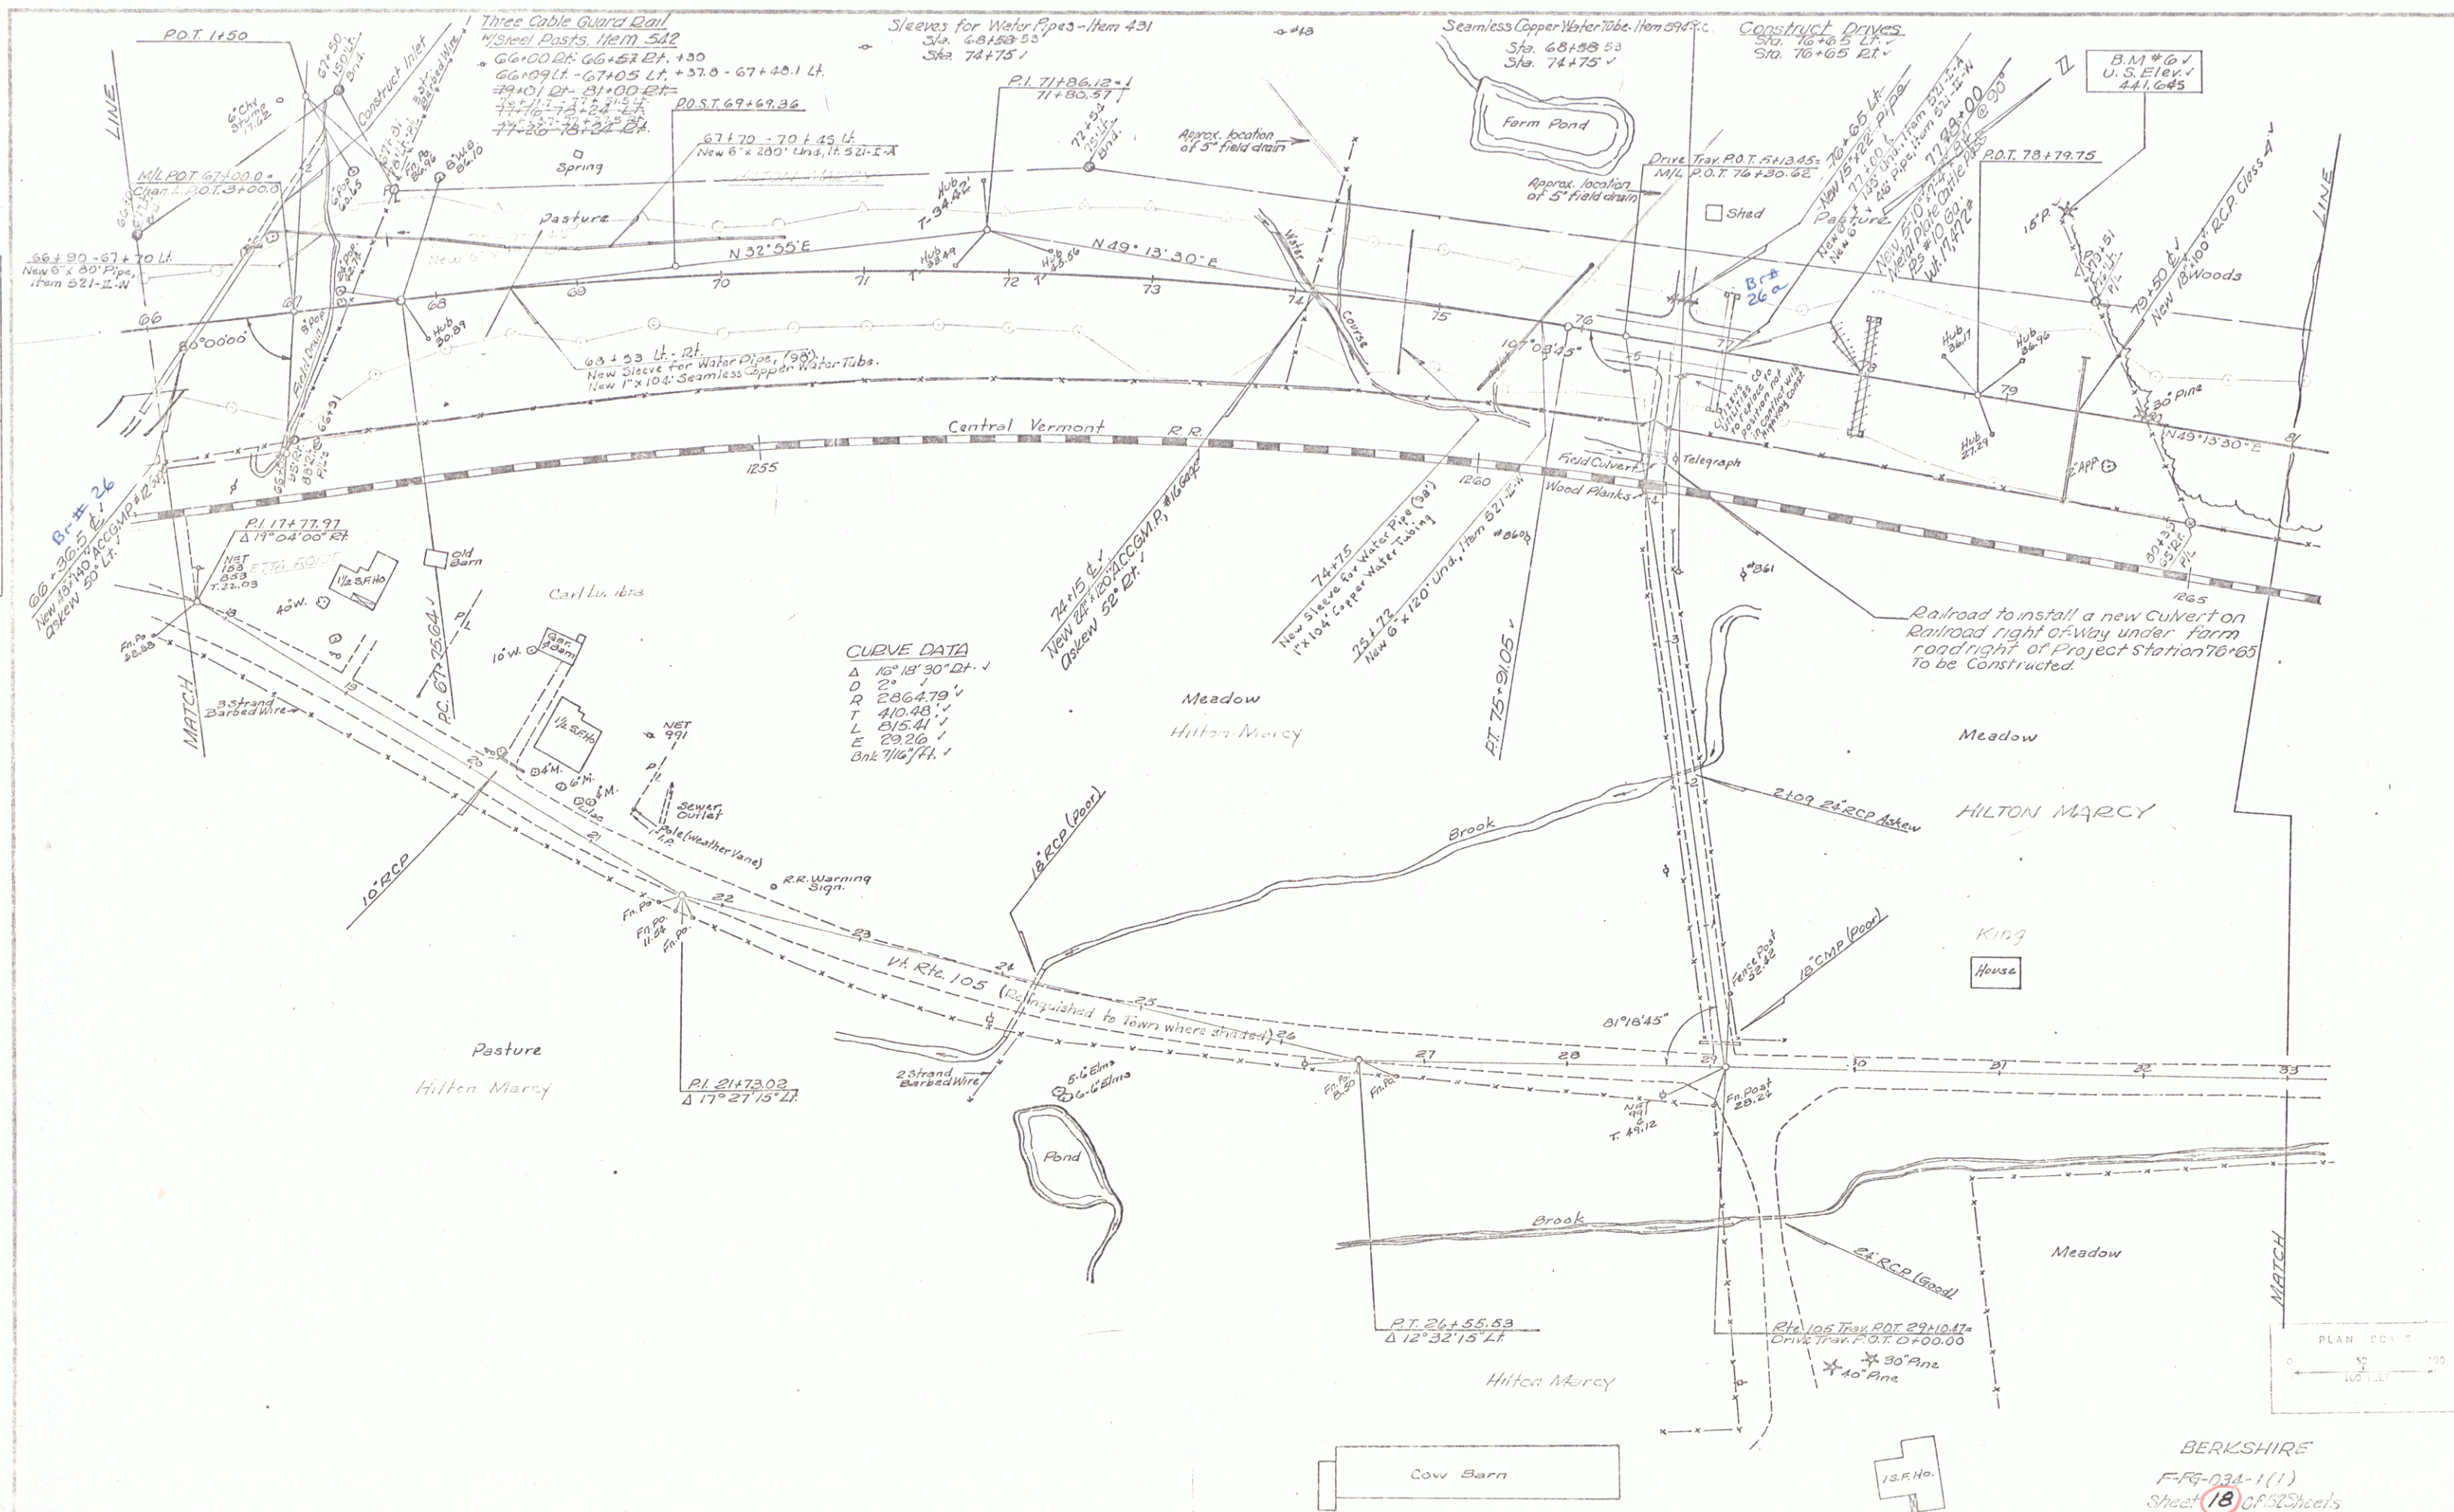

PLAN	DATE	BY	CHKD	DATE
DESIGNED	10/25/50	W. J. MASON		
CHECKED	11/1/50	W. J. MASON		
NOTED	11/1/50	W. J. MASON		
DATE	11/1/50	W. J. MASON		

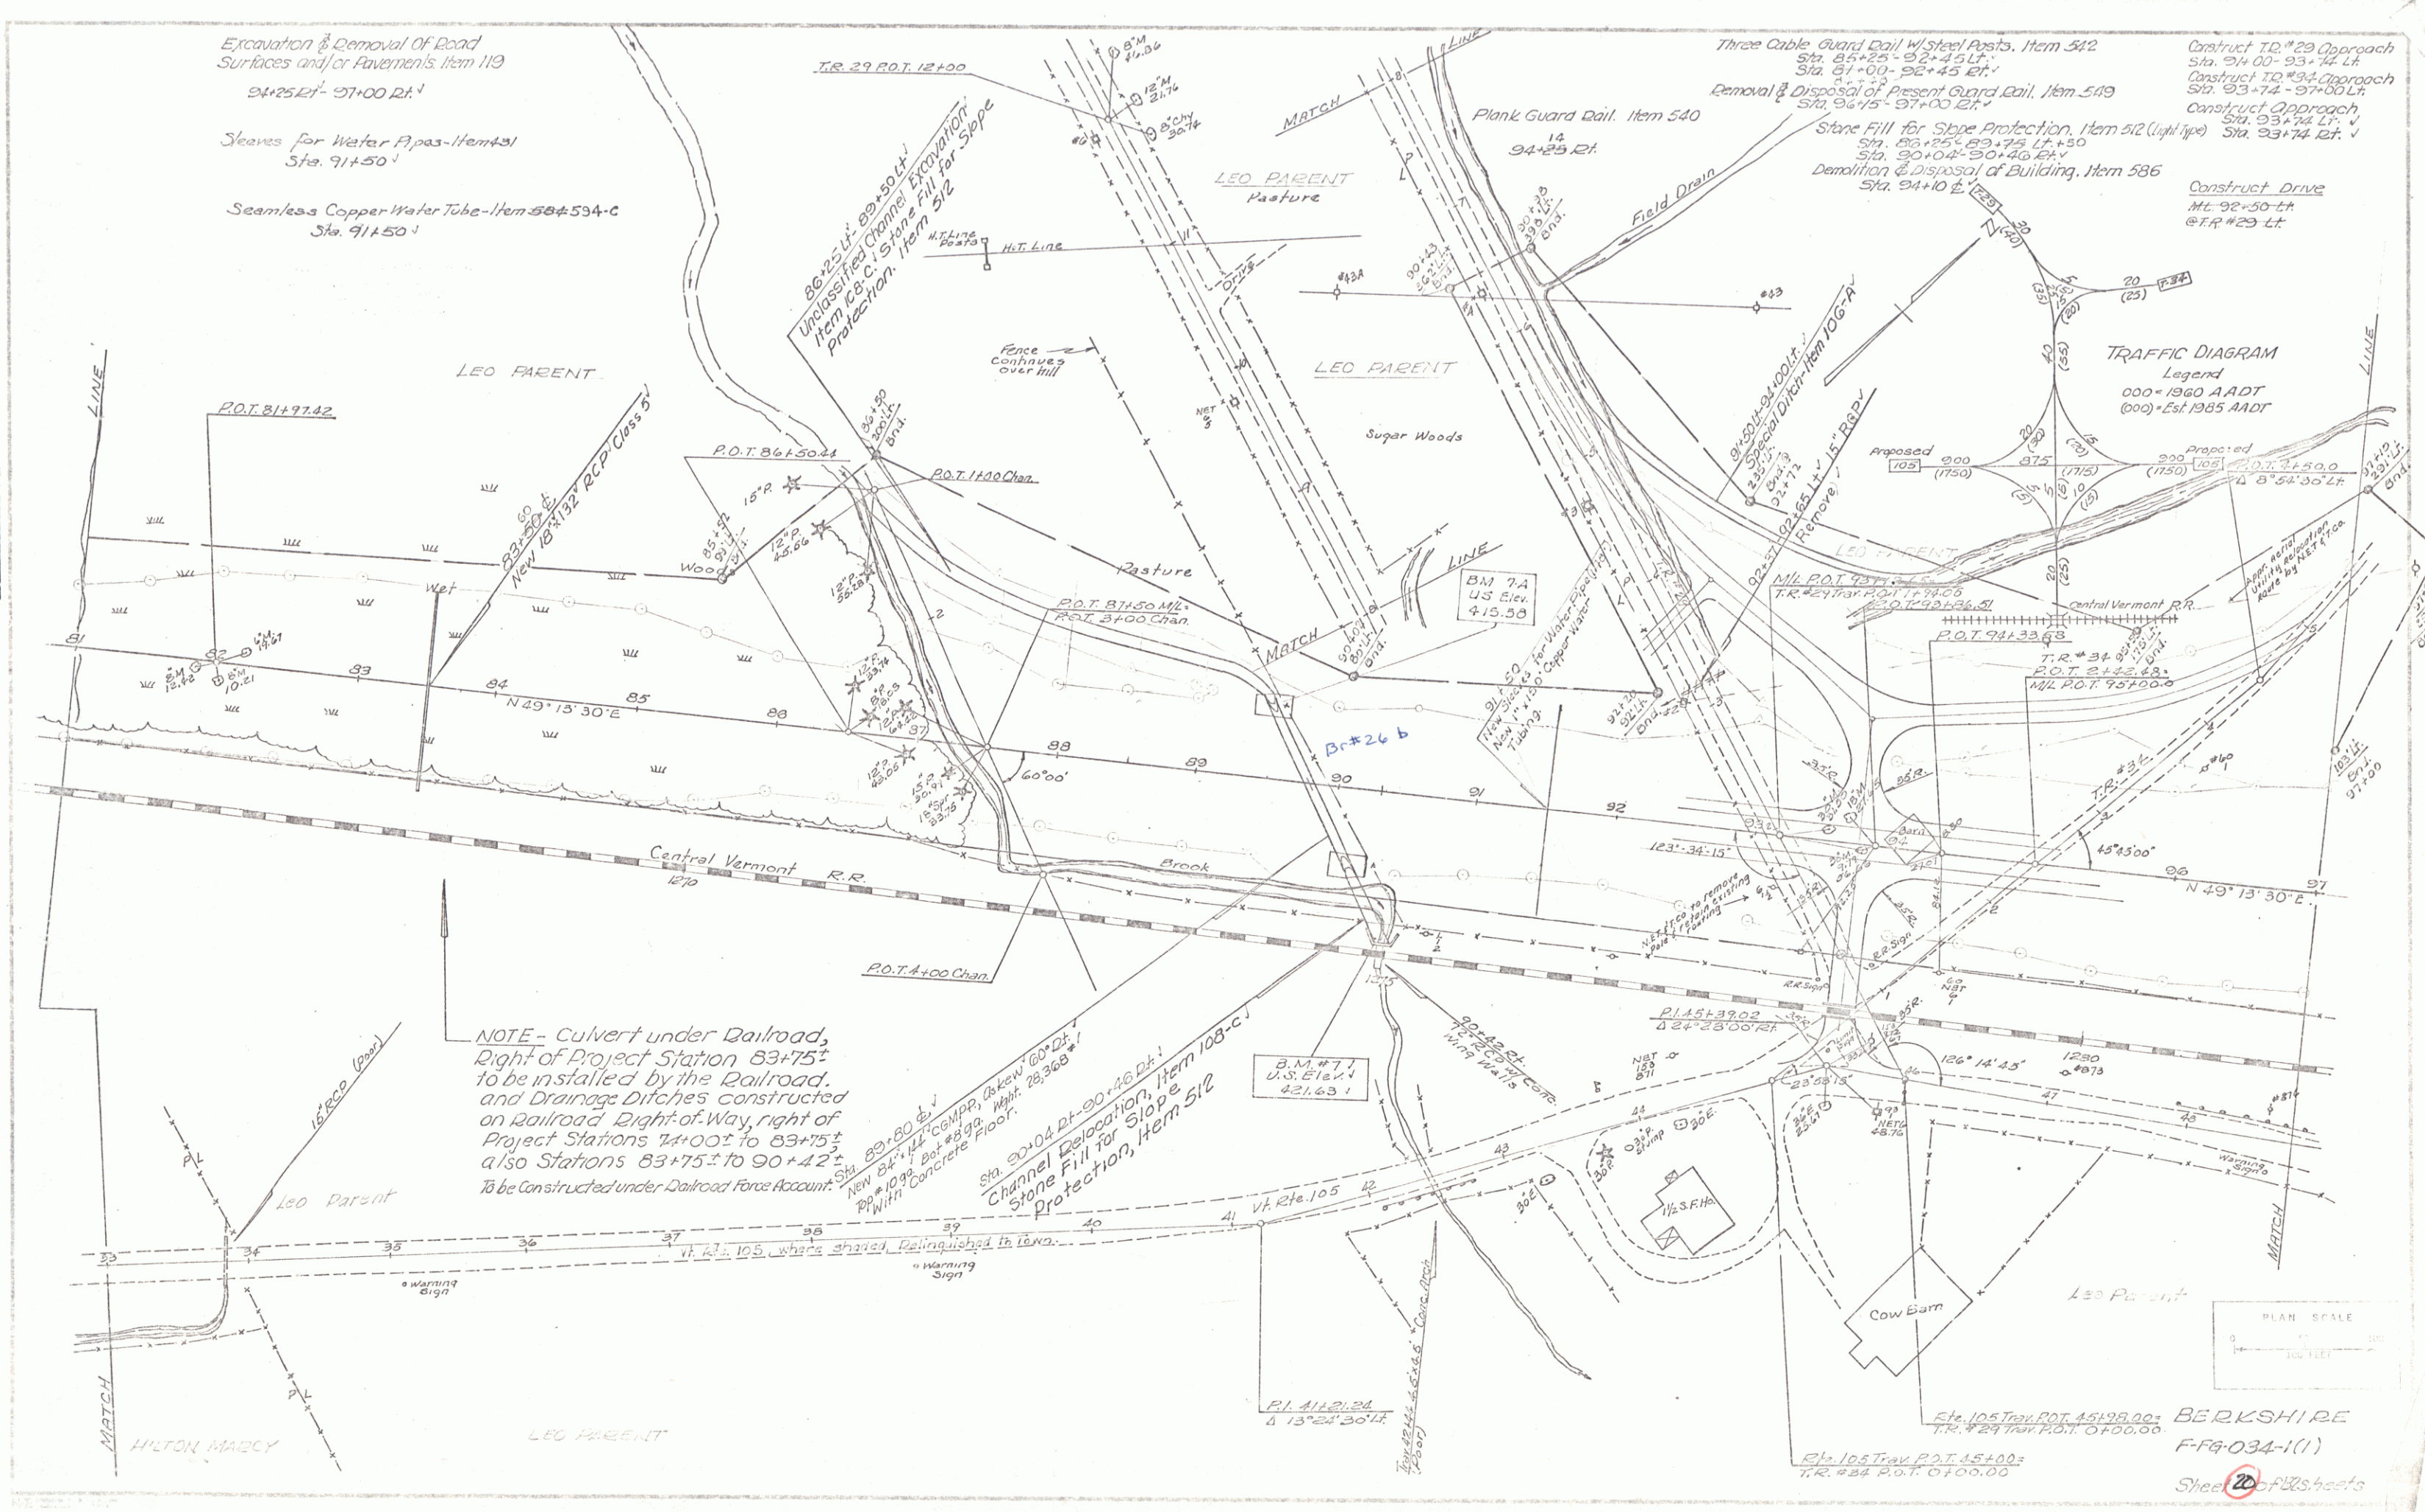



Construct TD #29 Approach
Sta. 94+00 - 93+74 Lt.
Construct TD #34 Approach
Sta. 93+74 - 97+00 Lt.
Construct Approach
Sta. 93+74 Lt.
Construct Drive
Mt. 92+50 Lt.
@ R.R. #29 Lt.



TRAFFIC DIAGRAM
Legend
000 - 1960 AADT
(000) - Est 1985 AADT

NOTE - Culvert under Railroad,
Right of Project Station 83+75 to
be installed by the Railroad,
and Drainage Ditches constructed
on Railroad Right of Way, right of
Project Stations 74+00 to 83+75,
also Stations 83+75 to 90+42,
to be constructed under Railroad Force Account.

BERKSHIRE
F-9-034-1(1)
Sheet 20 of 20 sheets

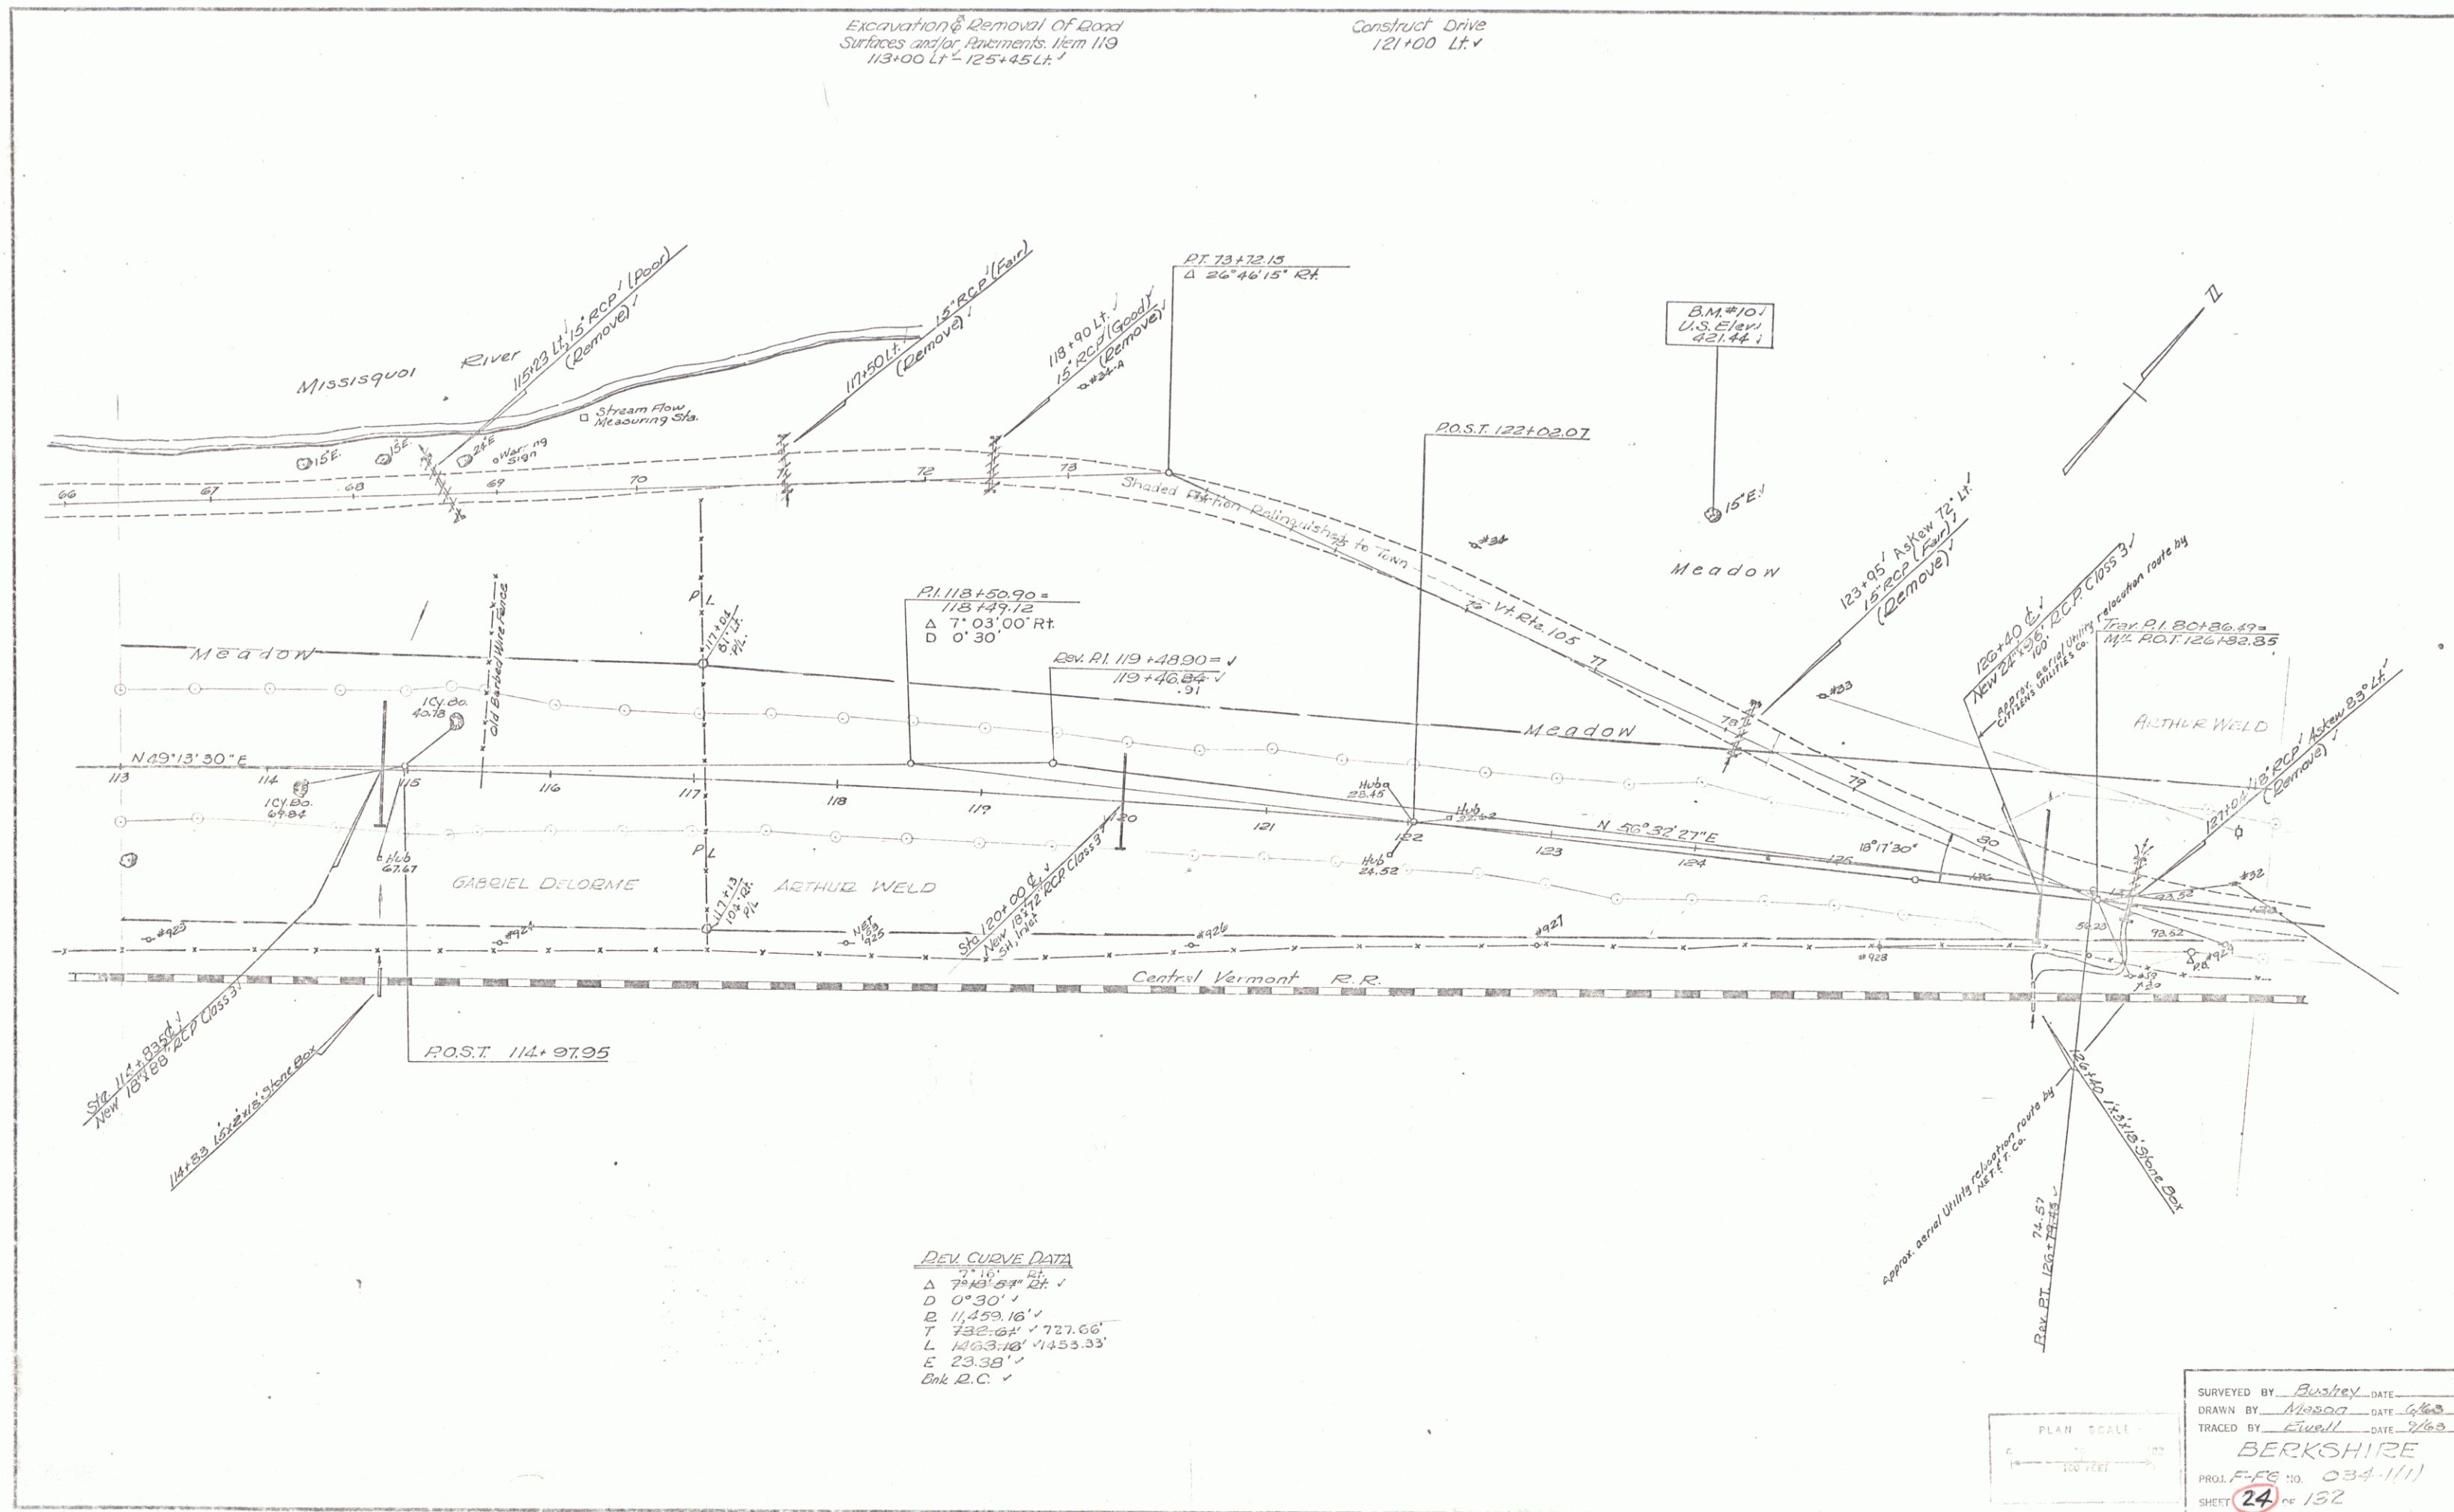

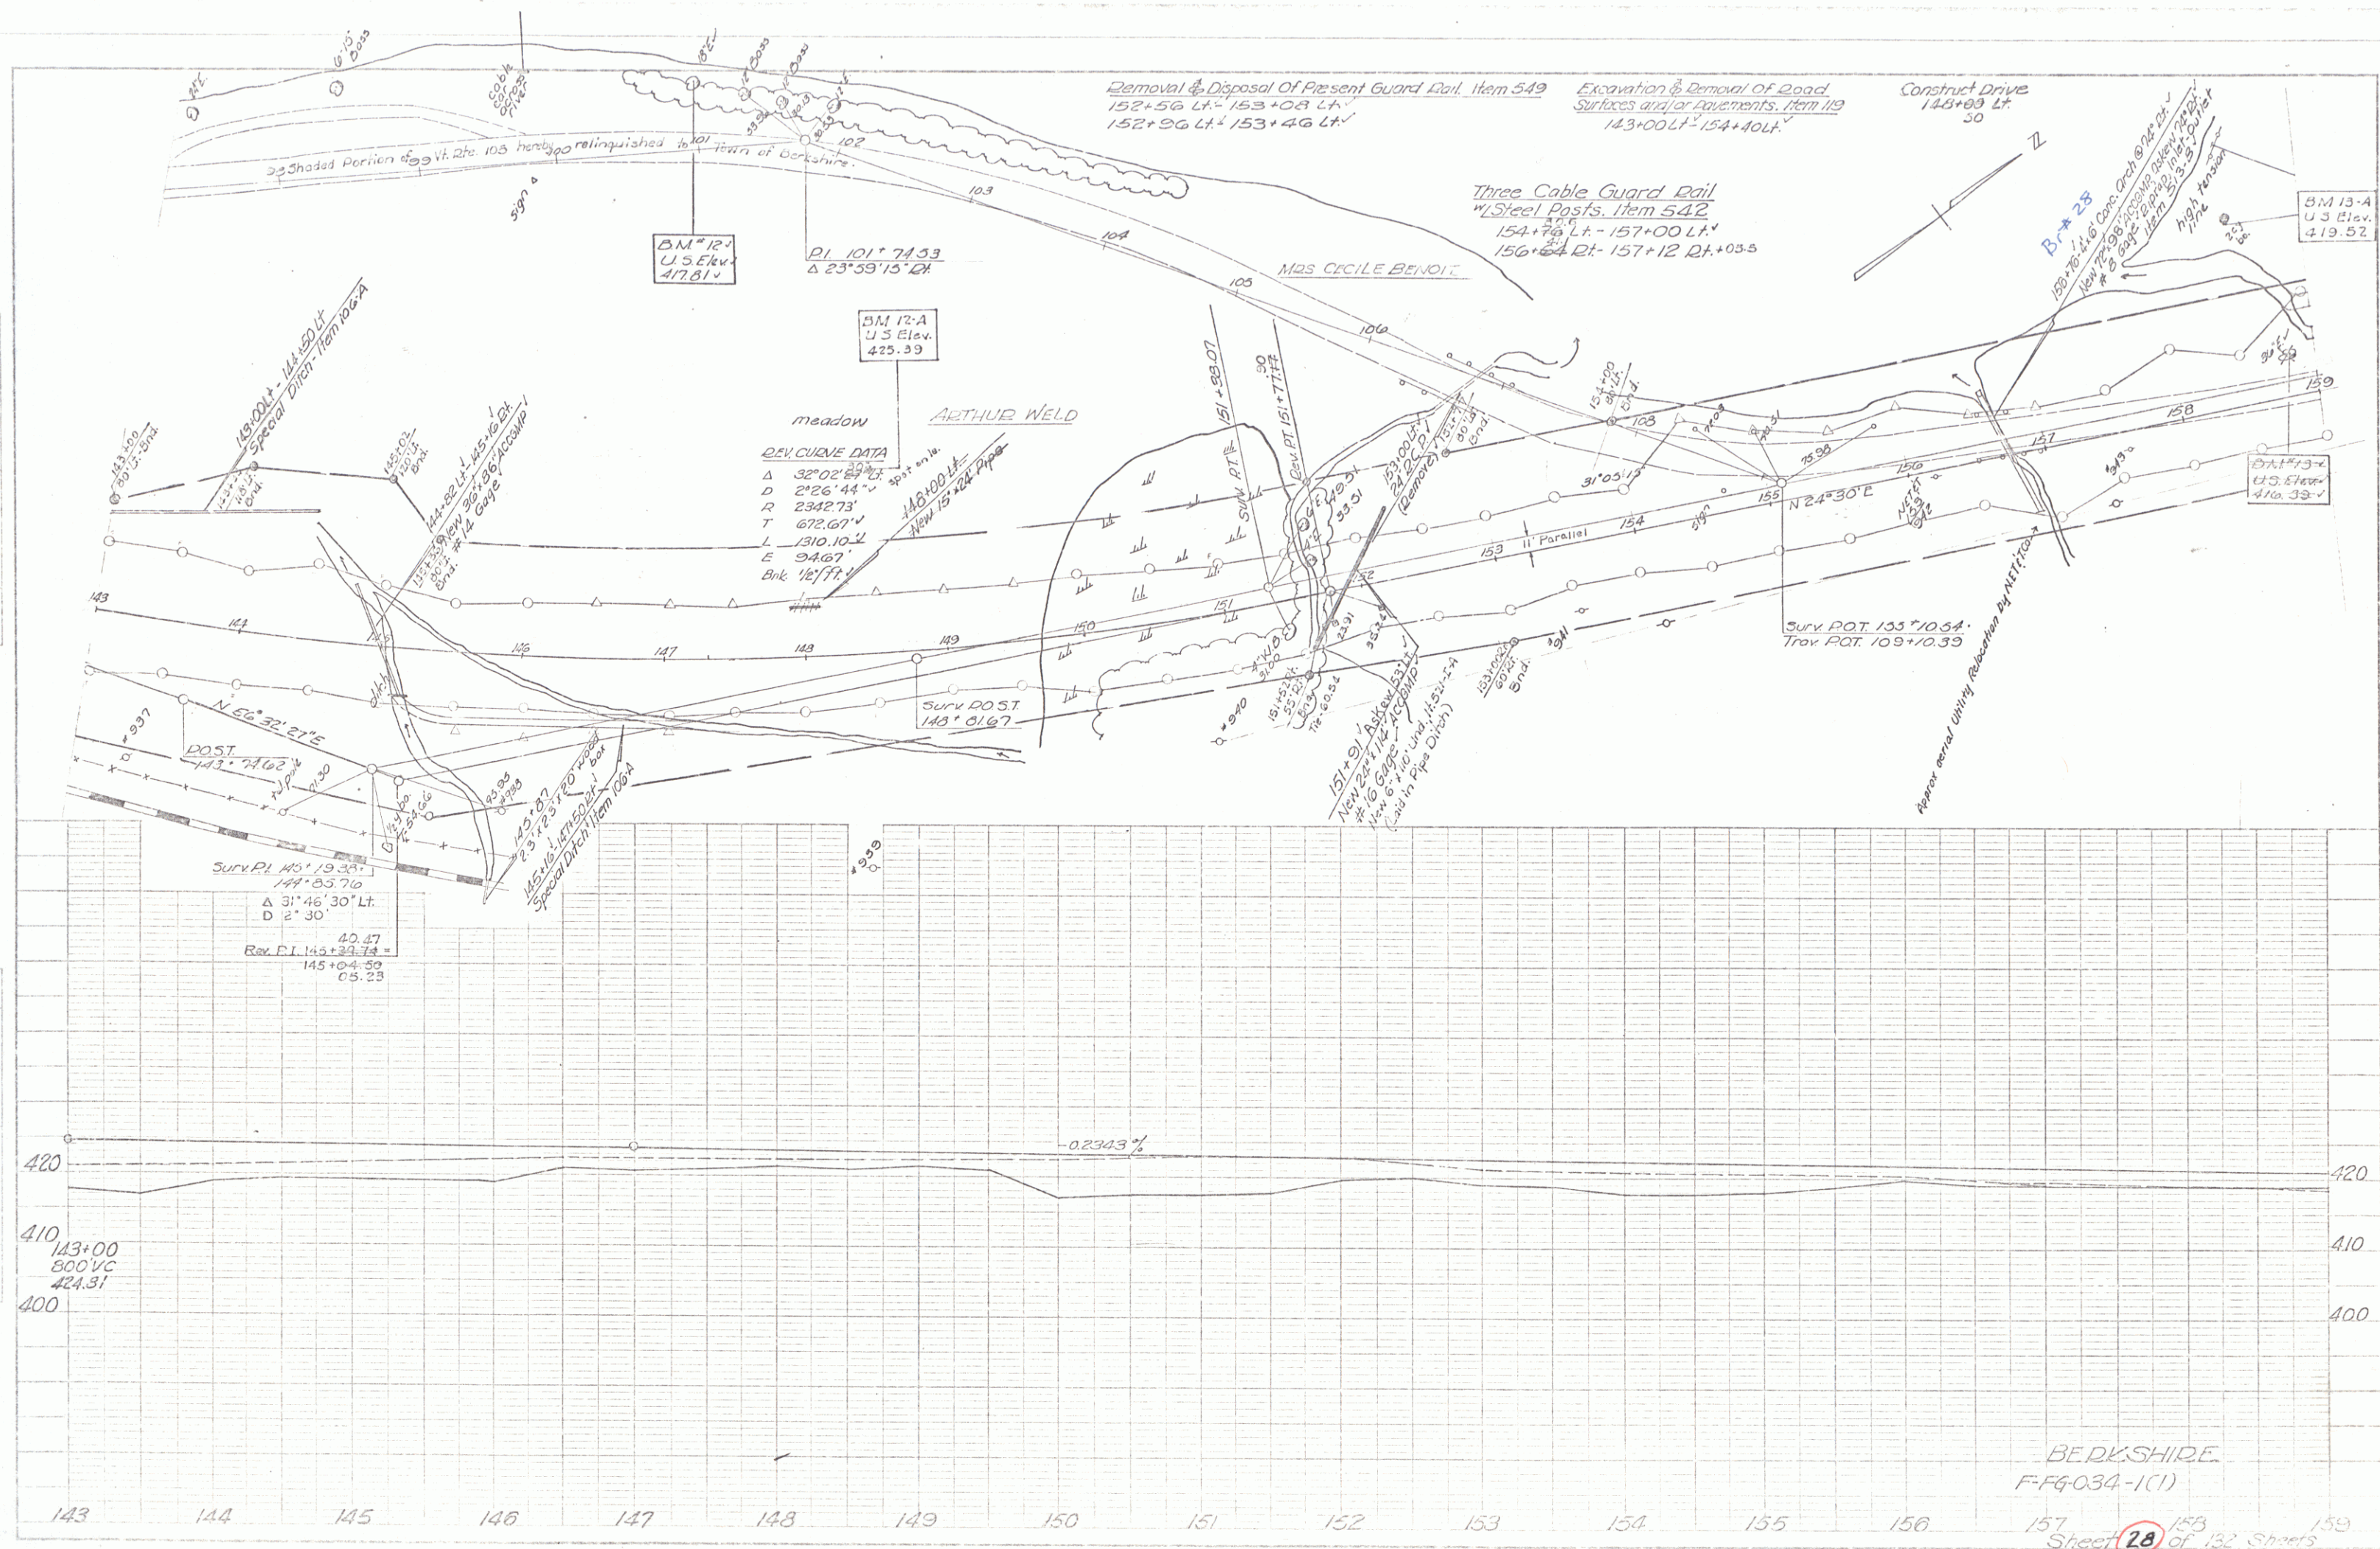

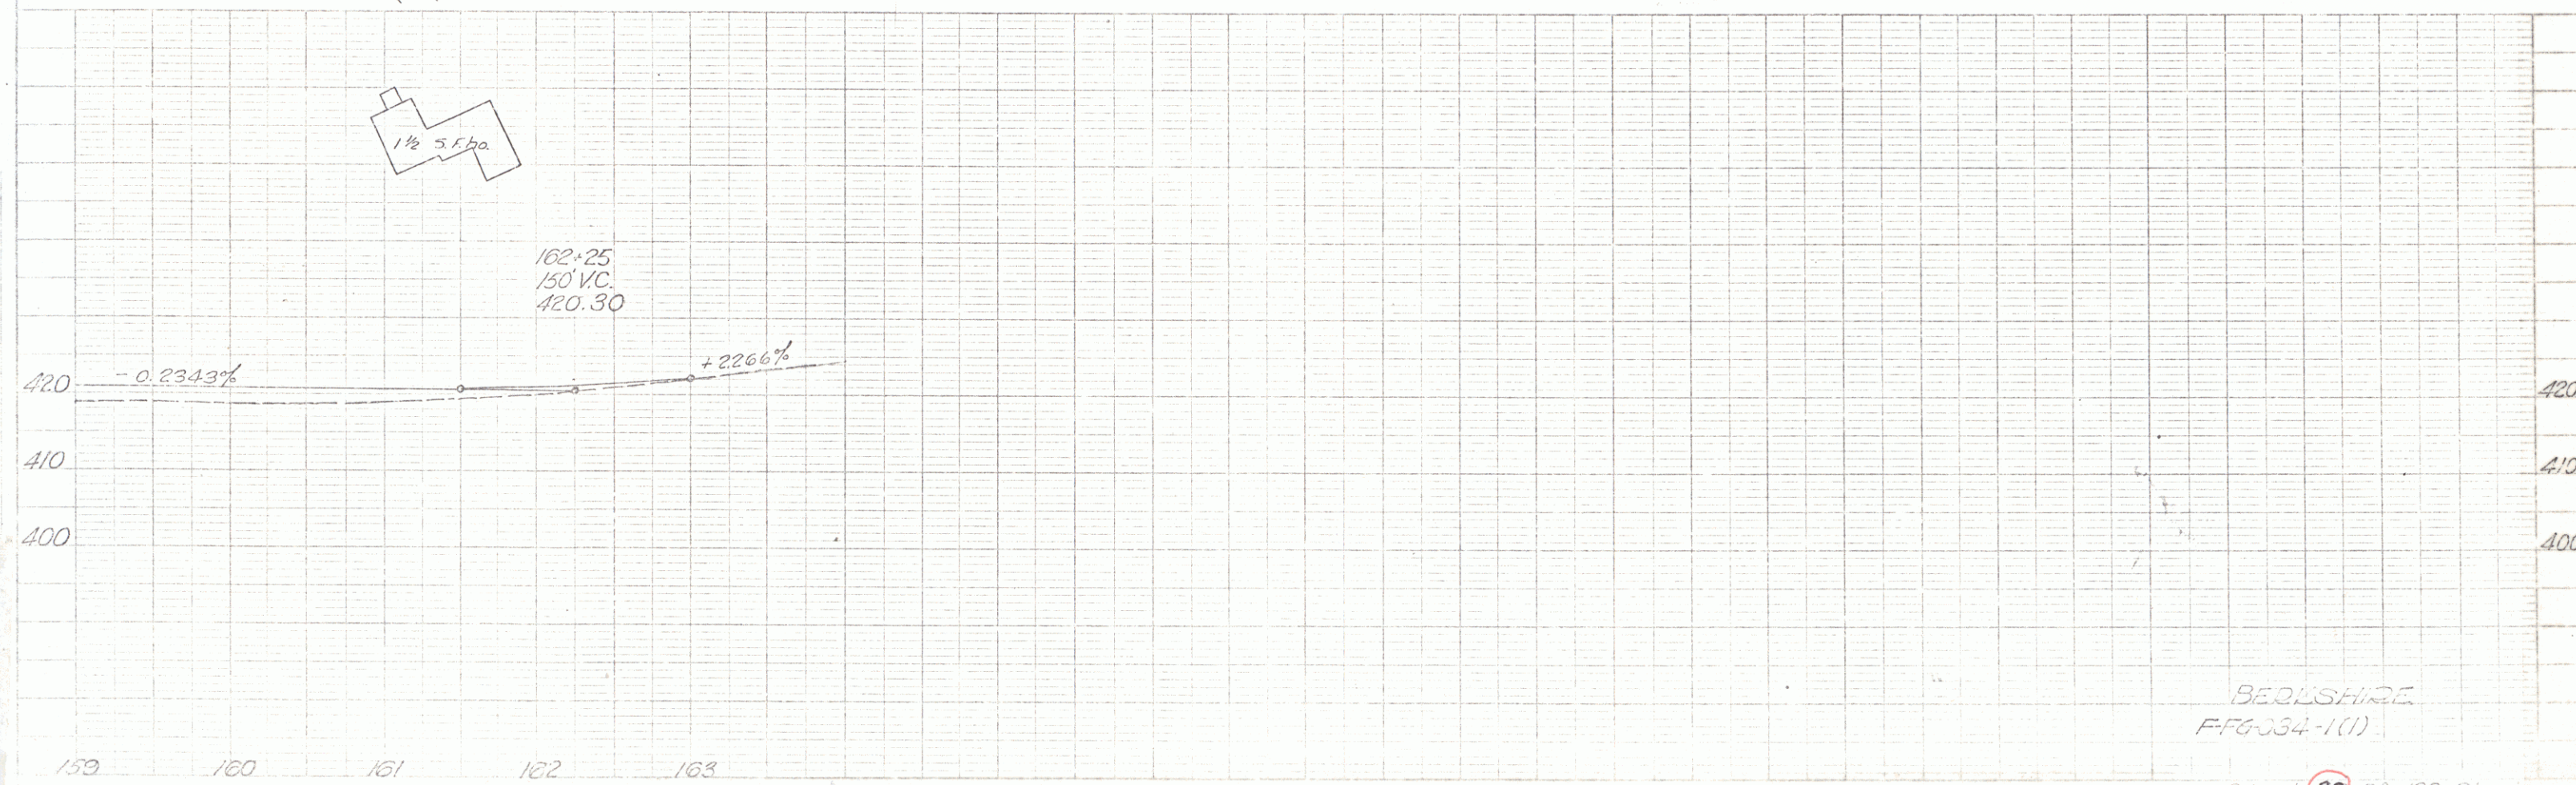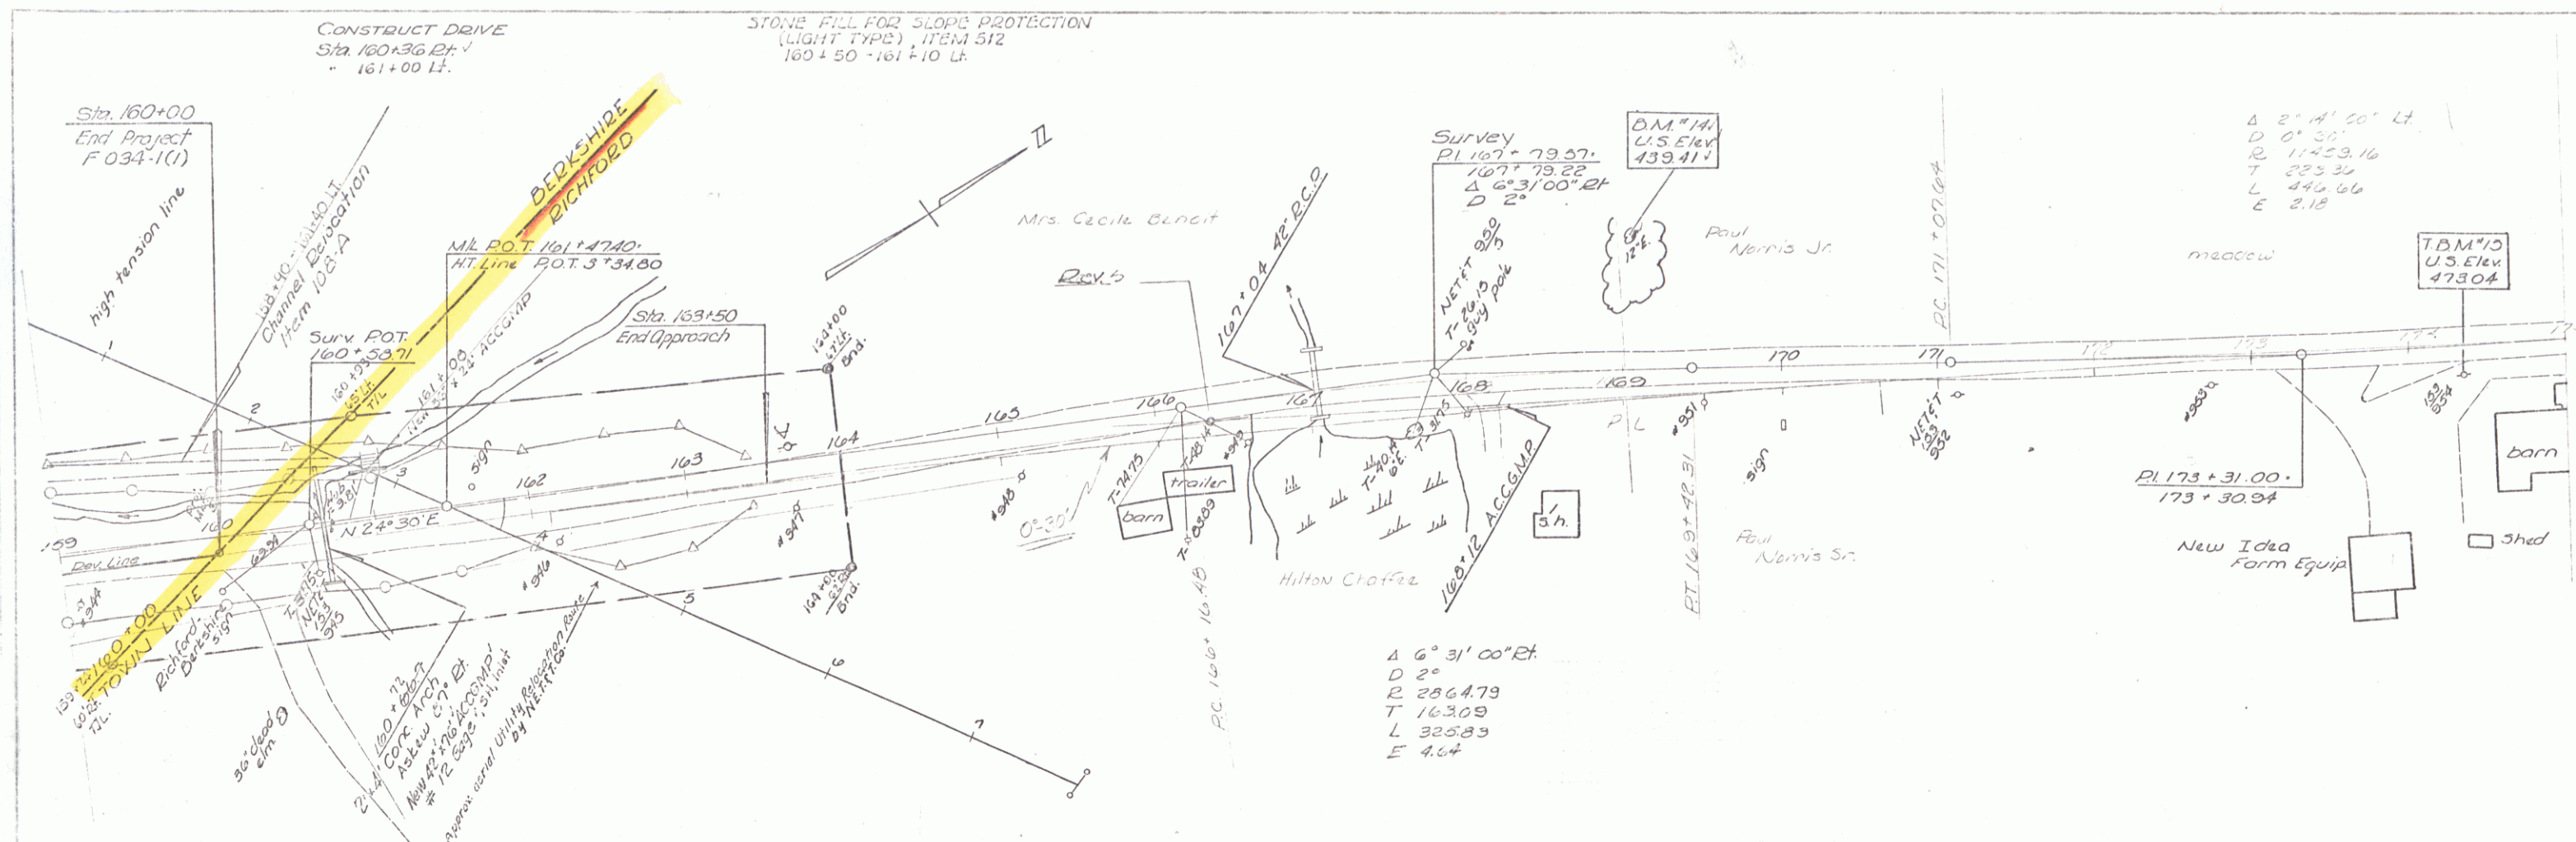

BEDSHIRE
F 034-1(1)

Sheet 29 of 132 Sheets

see # 30 of 90 F 134-L