
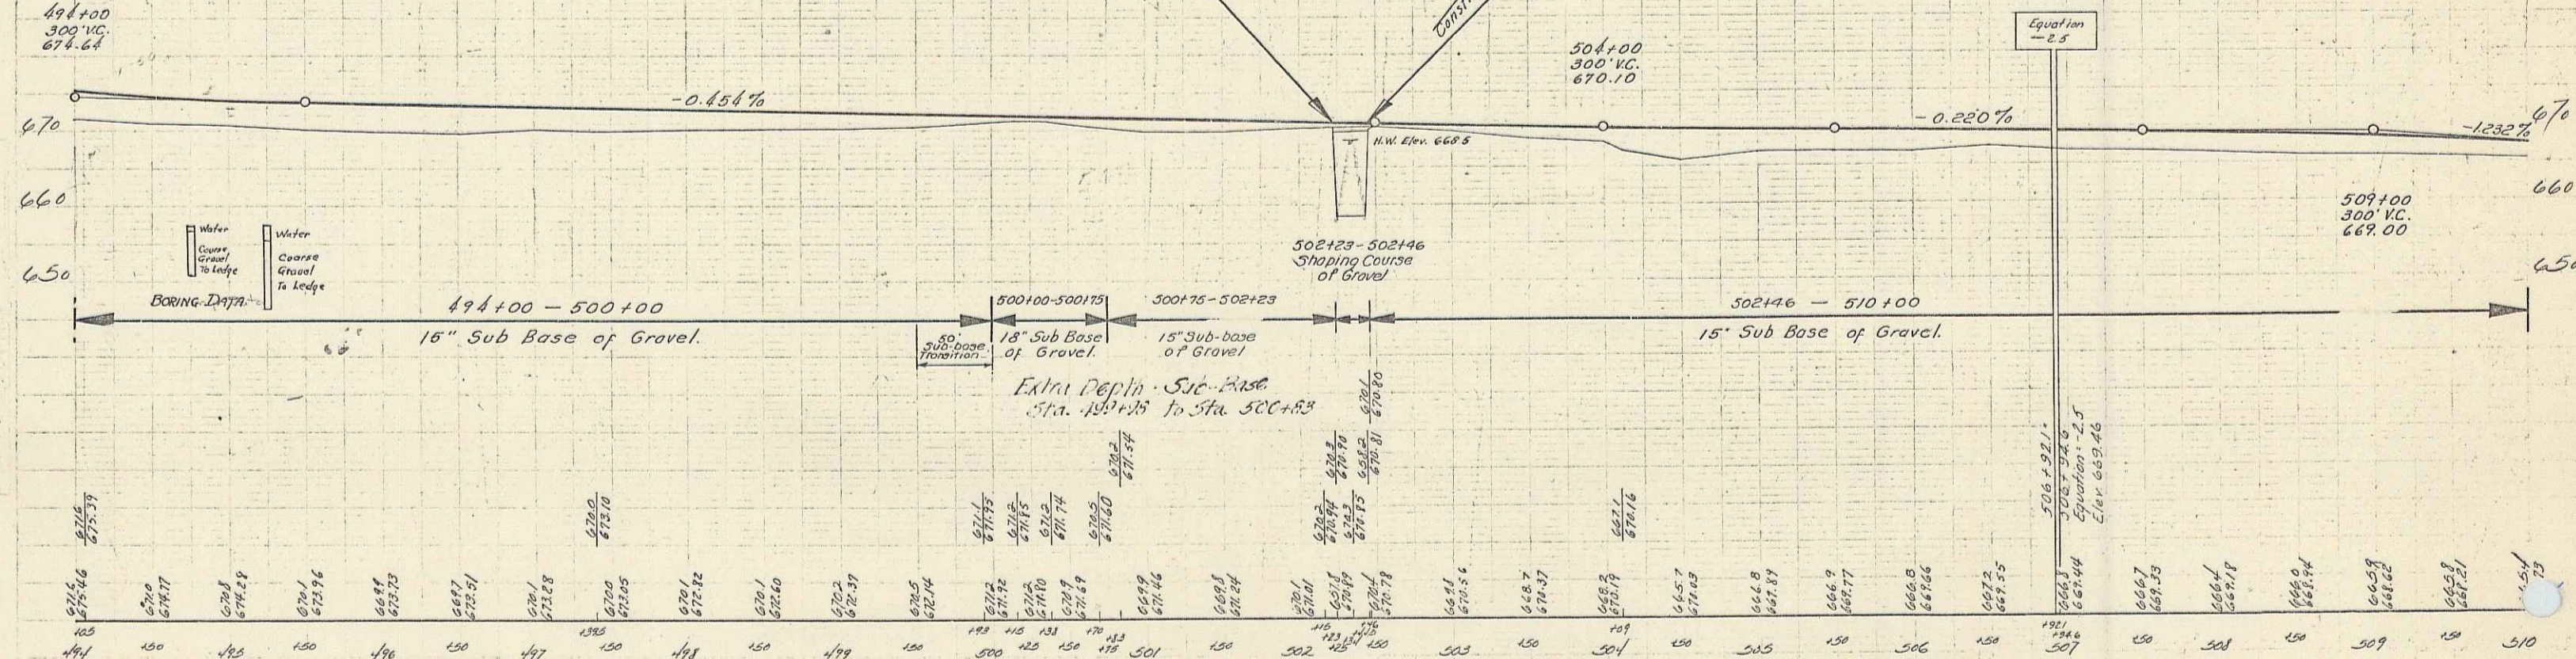


PARCEL INSTRUMENT DATE GRANTOR GRANTEE RECORDED REMARKS
 A.D.C. W.D.O.E 2-27-41 O.N. & LER GUILLETTE ST OF IT BOOK 241-5 PAGE 312-41

CONC. SLAB
 20'-0" CLEAR SPAN
 10'-0" CLEAR HEIGHT
 20'-0" ROADWAY
 25'-0" OVERHILL
 WATERWAY 200 SQ. FT.
 SHEETS 34,35,36 OF 169

64-10 1941 23 169

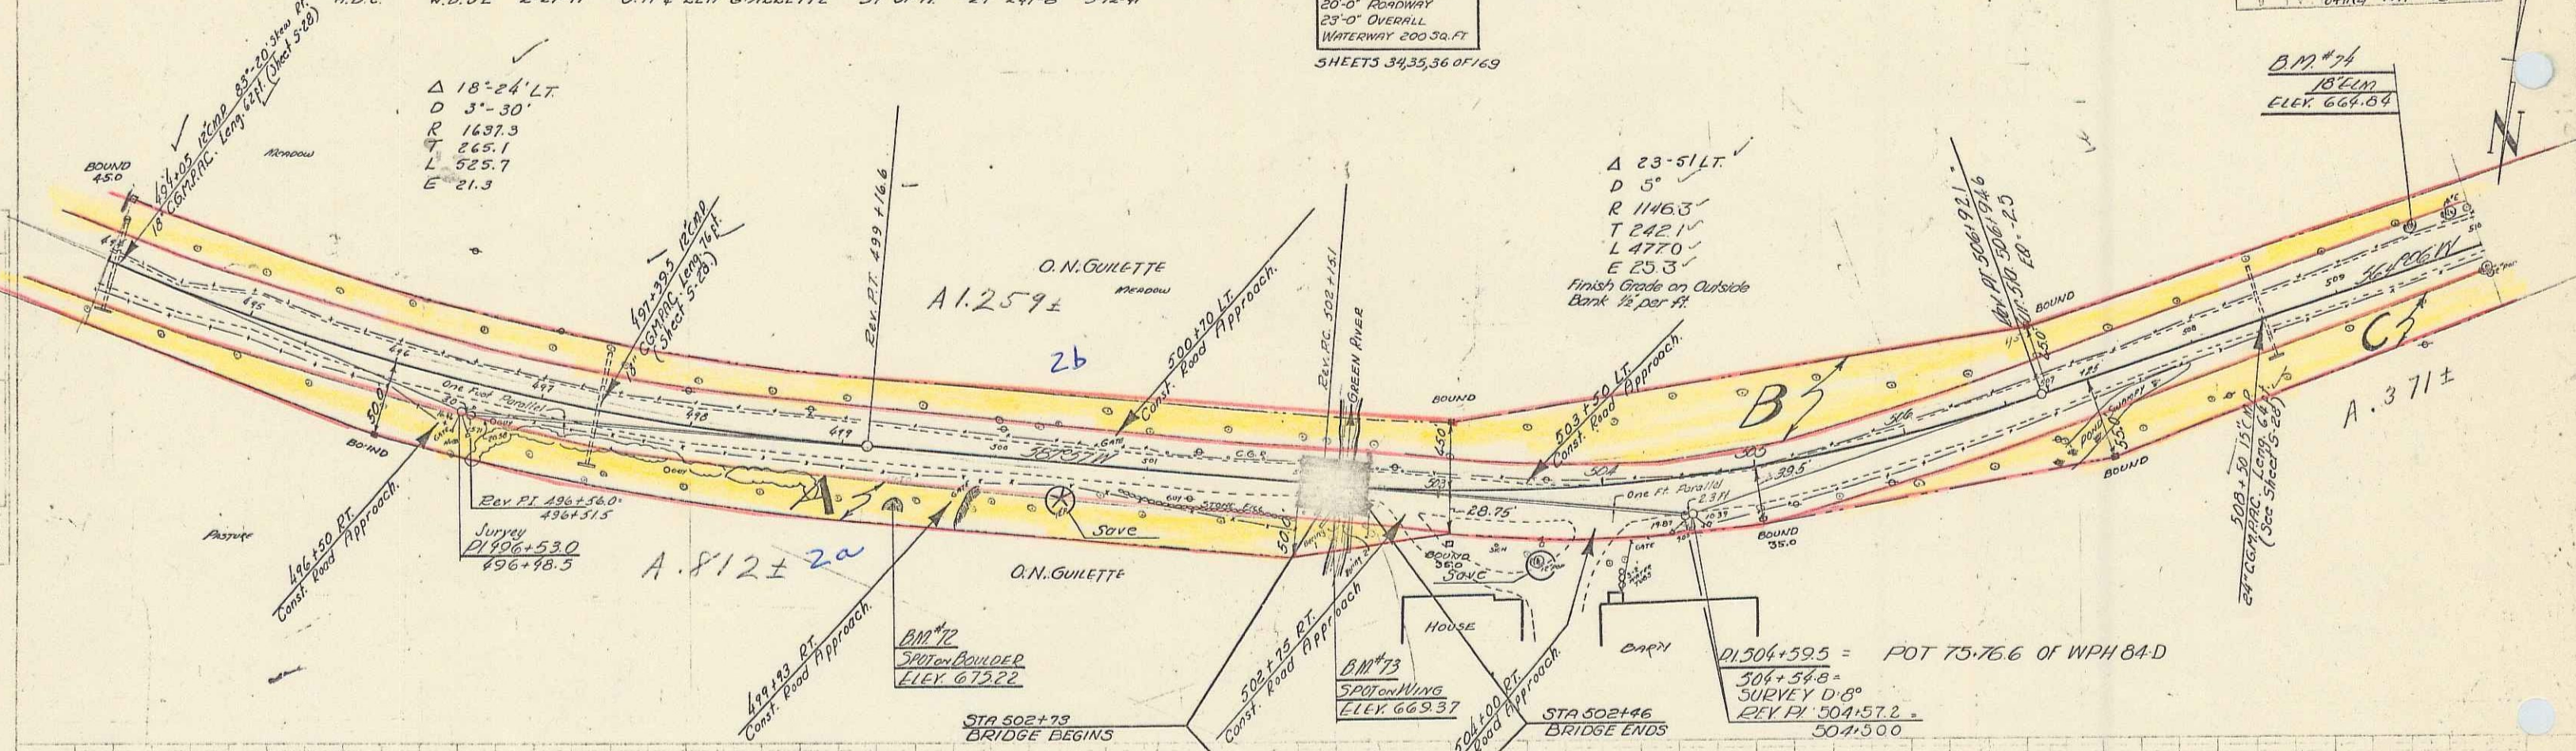

B.M. #72 Spot on Boulder 33' RT, Sta 489+39, Elev 675.22
 B.M. #73 Spot on Wing 10' L.R., Sta 502+23, Elev 668.37
 B.M. #74 S.I.R. 18' L.I.M. 23' LT, Sta 509+58, Elev 666.49

Series 64-10 1941 23 169