

INDEX OF SHEETS		
SHEET NO.	TITLE	PAGE
1	TYPICAL CROSS-SECTION OF IMPROVEMENT	GRADING, DRAINAGE & BASE WITH GUARD RAIL
2	PLAN AND PROFILE	5 DOUBLE TRACK CONT. OF REFINED TIR WITH
3	STANDARD STRUCTURE SHEET	5-30 GUARD RAIL
4	"	5-30A STD. UND. BOUNDARY MARKERS
5	"	5-40 BARRICADES SIGNS & LIGHTS
6	"	"
7-9	CROSS SECTION SHEETS	"

STANDARD STRUCTURE SHEETS APPROVED BY THE CHIEF ENGINEER
5-30 AUGUST 13, 1934

STATE OF VERMONT STATE HIGHWAY DEPARTMENT

PLAN AND PROFILE OF PROPOSED STATE HIGHWAY


FEDERAL AID PROJECT

TOWN OF WOLCOTT Pin # 000281
Rte. VT 15

HARDWICK - MORRISVILLE ROAD

BEGINNING AT A POINT ON ROUTE 15, 0.58 MI.
NORTH-WESTERLY FROM THE ST. JOHNSBURY &
LAKE CHAMPLAIN RAILROAD UNDERPASS AND
EXTENDING NORTH-WESTERLY 0.056 MILES.
LENGTH OF PROJECT, 257.0 FT. = 0.048 MI.

FED. ROAD DIST. NO.	STATE	FED. AID PROJ. NO.
9	VT.	0400281

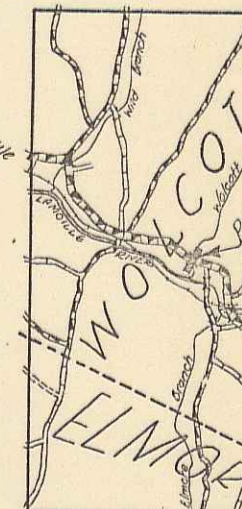


SCALE 1 INCH = 1 MILE

RECORD PLANS
By - G.A. Pierce

(To Be Returned To R.O.W. Division)

AP 4.12
RIGHT-OF-WAY DIVISION
TOWN FILE
PERPETUAL
of 4.15

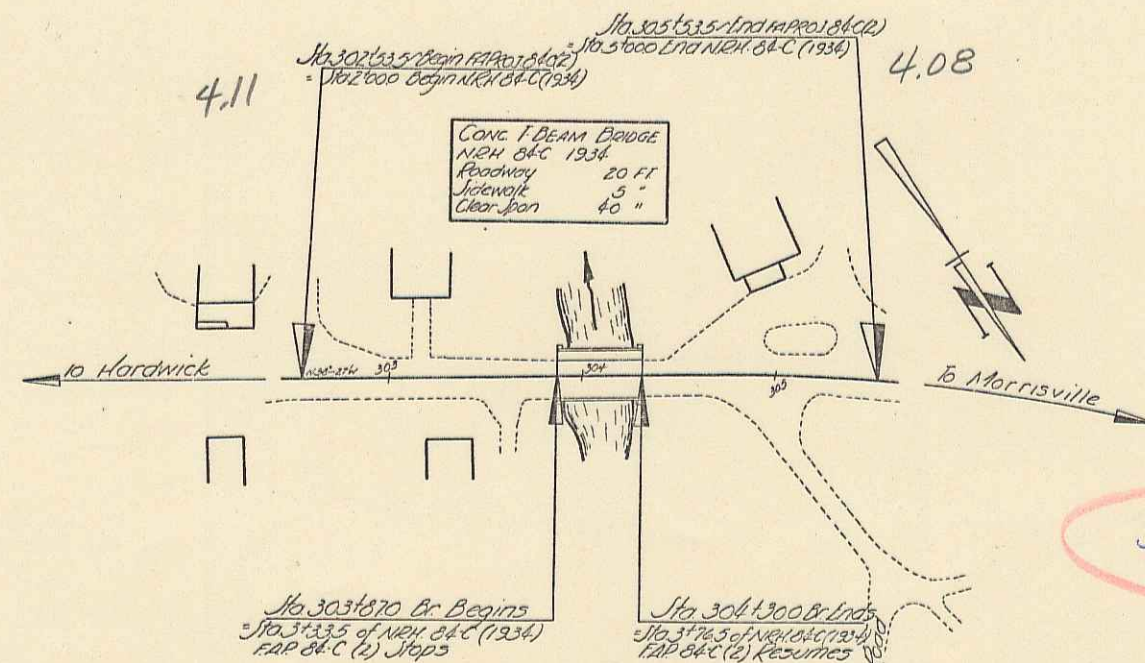

COUNTY LINE	
TOWN LINE	
FENCE LINE	
STONE WALL	
UNFENCED PROPERTY	
GUARD RAIL	
TRAVELED WAY	
RAILROAD	
RETAINING WALL	
CENTER LINE	
SURVEY LINE	
CULVERT	
DROP INLET	
TROLLEY POLE	
POWER POLE	
TELEPHONE POLE	
TREES	
HEDGE	

Record Plans
Wolcott - Sta. - FAP 84-C(1)
Contractor - Lambert & George
1944

GROUND ELEVATION	DATUM	LINE
GRADE ELEVATION	DATUM	LINE
CURVE DATA		
DEFLECTION ANGLE		Δ
DEGREE OF CURVE		D
RADIUS OF CURVE		R
TANGENT DISTANCE		T
LENGTH OF CURVE		L
EXTERNAL DISTANCE		E
POINT OF INTERSECTION		P. I.
POINT OF CURVE		P. C.
POINT OF TANGENT		P. T.
POINT ON TANGENT		P. O. T.

SCALES	
TITLE	1" = 50 FT.
TYPICAL	1" = 2 "
PLAN	1" = 50 "
HORIZONTAL	1" = 50 "
PROFILE VERTICAL	1" = 10 "
CROSS SECTIONS	1" = 5 "

Project No. FAP 84-C(2)

THESE PLANS ARE SUBJECT TO SUCH REVISIONS AS MAY BE
REQUIRED BY THE PUBLIC ROADS ADMINISTRATION OR THE COM-
MISSIONER OF HIGHWAYS.

CONSTRUCTION IS TO BE CARRIED ON IN ACCORDANCE WITH
THE PLANS AND THE STANDARD ROAD AND BRIDGE SPECIFICATIONS
OF 1936, AS APPROVED DECEMBER 28TH, 1936 BY THE PUBLIC
ROADS ADMINISTRATION, INCLUDING ALL SUBSEQUENT APPROVED
REVISIONS AND SUCH REVISED SPECIFICATIONS AND SPECIAL
PROVISIONS AS ARE SUBMITTED WITH THE PLANS.

APPROVED: *[Signature]* 1944
ROAD ENGINEER

APPROVED: *[Signature]* 1944
DISTRICT HIGHWAY COMMISSIONER

SERIES FAP No. 84-C(2)
SHEET 1 OF 1