

FAR 133-B


STATION	STATION	STATION	STATION	STATION
181.00	163.00	160.00	157.00	154.00

FAR 133-B


STATION	STATION	STATION	STATION	STATION
151.00	150.00	149.00	148.00	147.00

ROAD STATE ROAD SHEET TOTAL

YEAR	NO	SHEET
1936	11	15

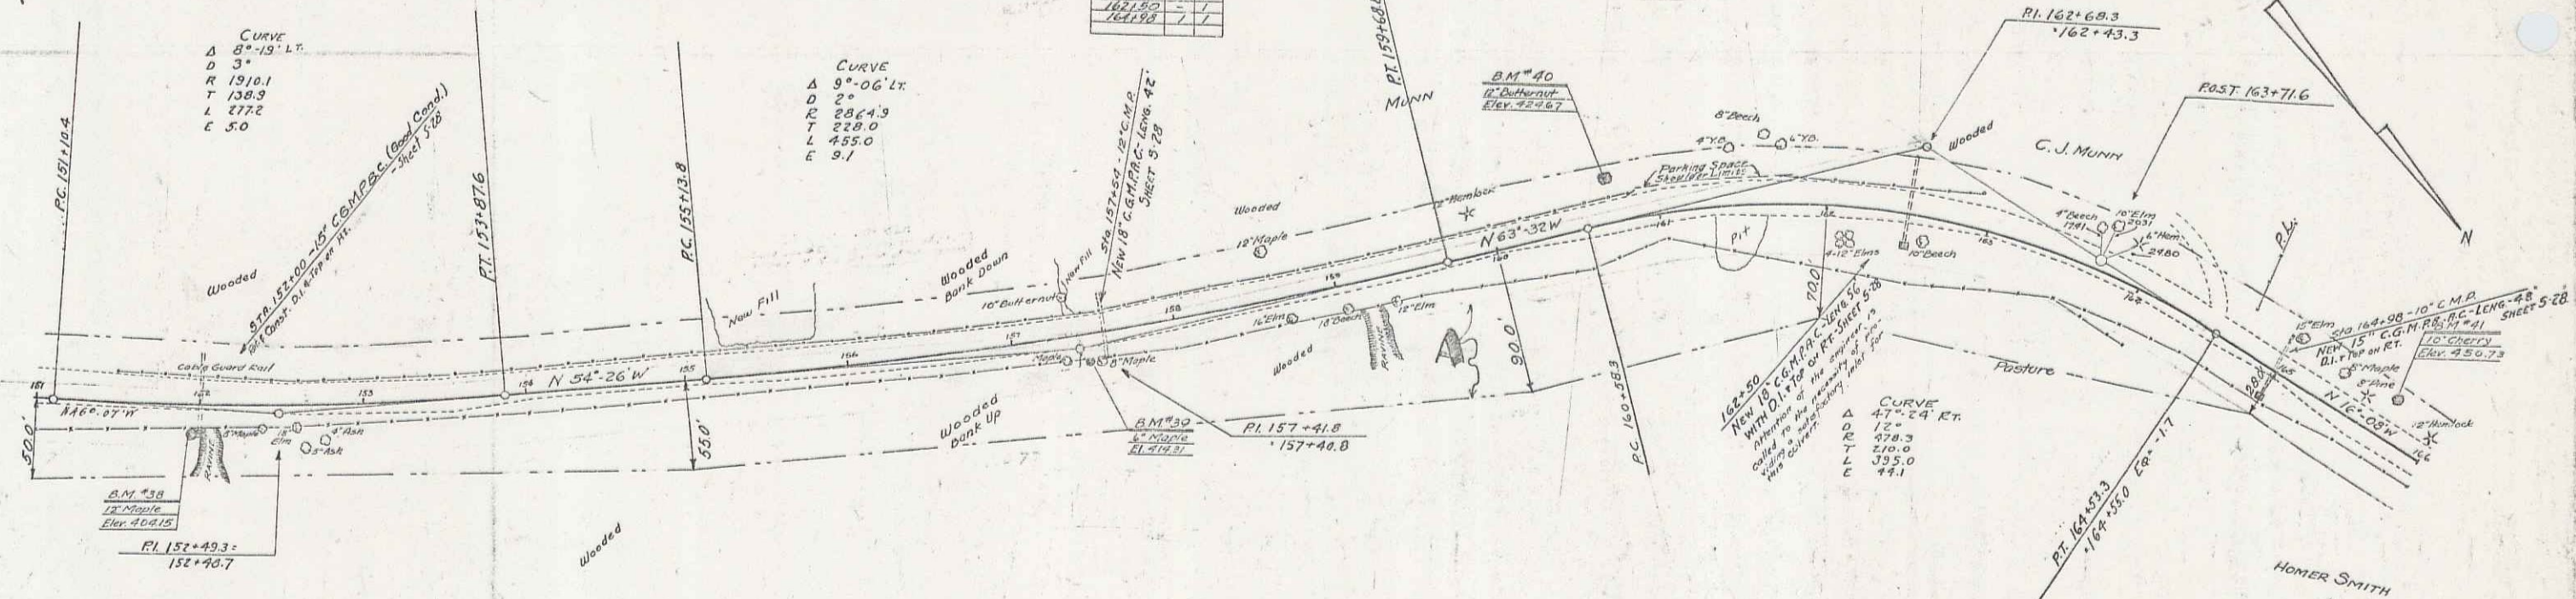

Parcel Kind of Date of Grantor Grantee Recorded Remarks
 A-B W.D. 12-14-24 Homer C. & Helen Smith 31 of 31 4-52 12-27-28

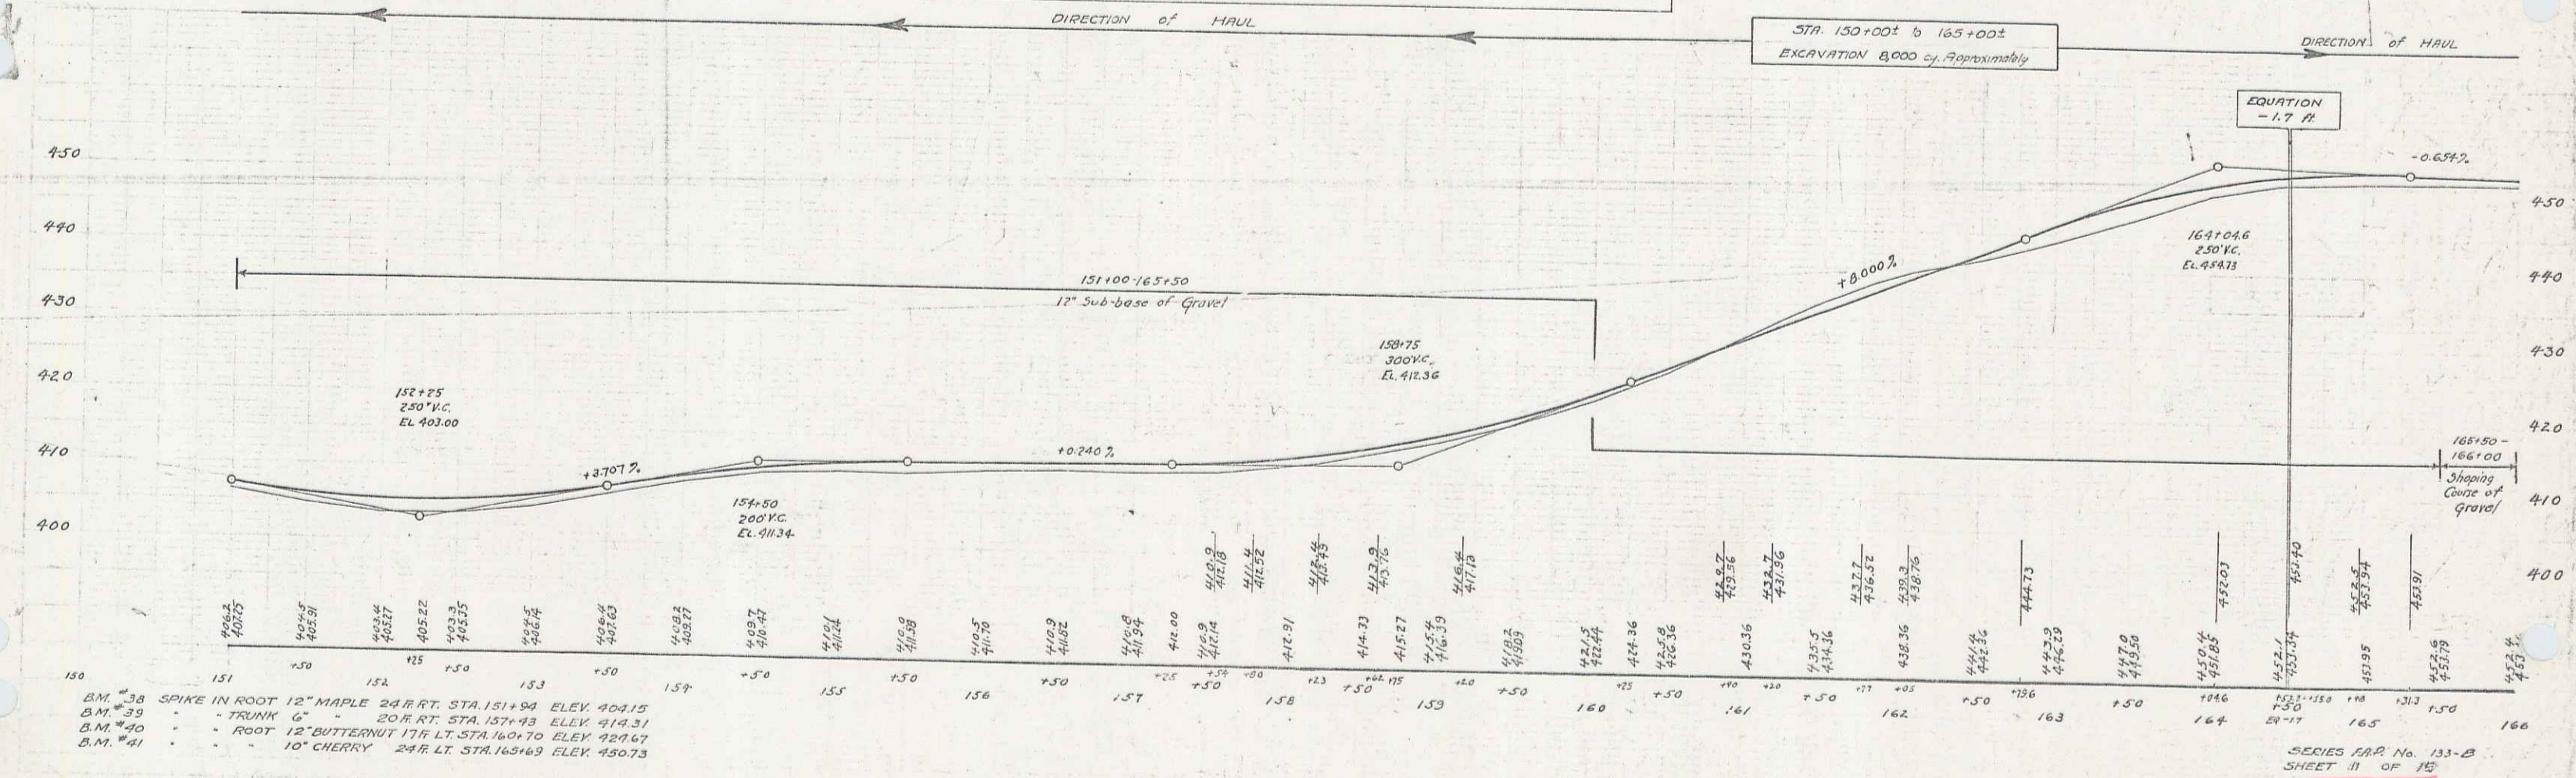

BM #38 SPIKE IN ROOT 12" MAPLE 24 RT. STA. 151+94 ELEV. 904.15
 BM #39 " " TRUNK " 20 RT. STA. 157+43 ELEV. 914.31
 BM #40 " " ROOT 12" BUTTERNUT 17 LT. STA. 160+70 ELEV. 929.67
 BM #41 " " 10" CHERRY 24 RT. STA. 163+69 ELEV. 950.73

SERIES FAR No. 133-B
 SHEET 11 OF 15