

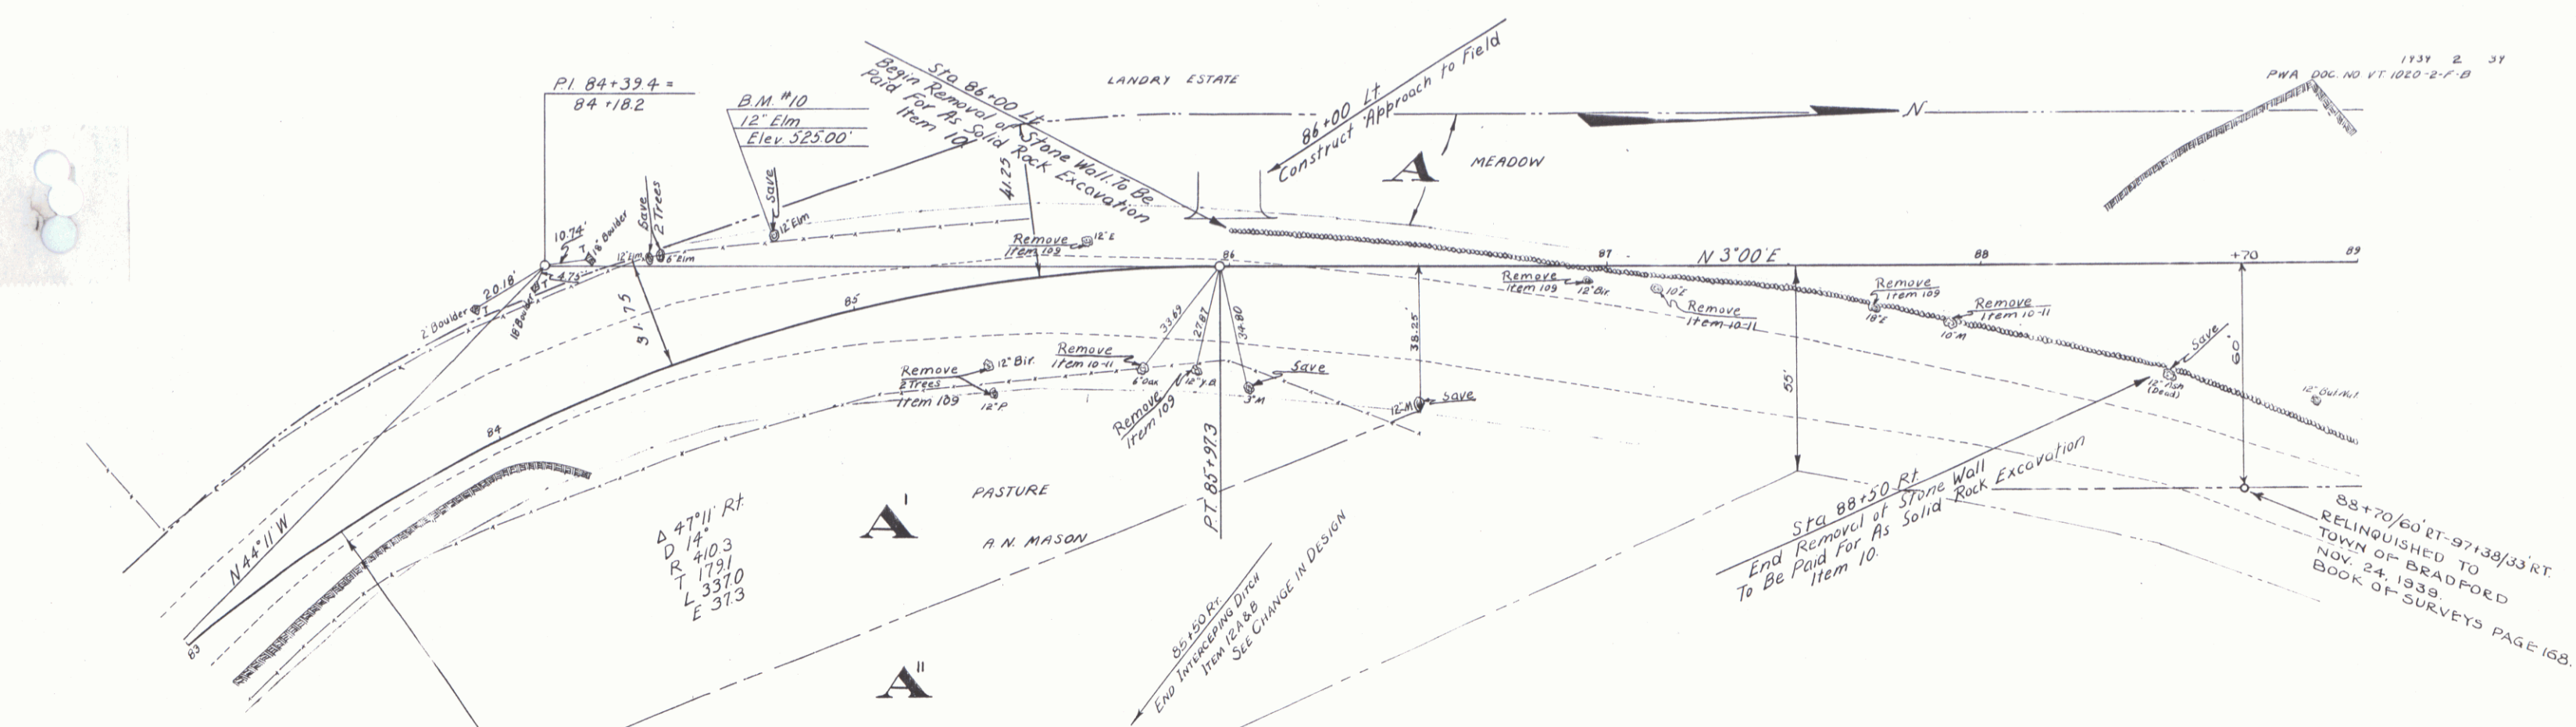


12/38 J.H. CASE

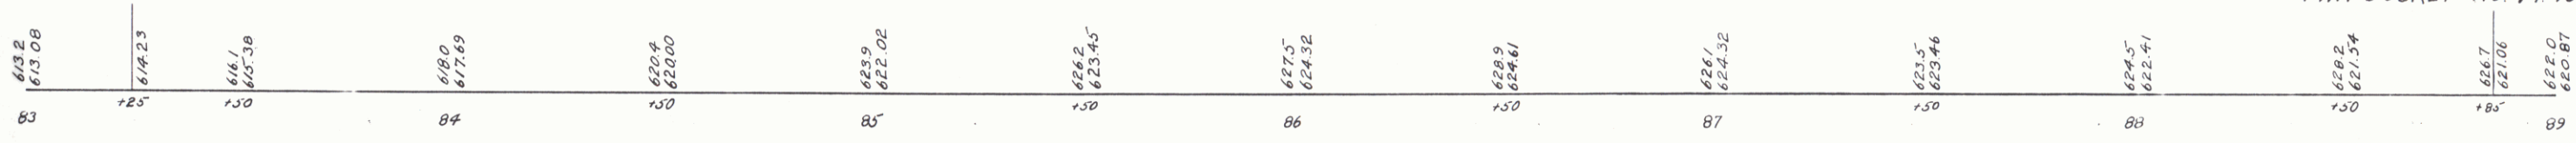

Parcel	Instrument	Date	Grantor	Grantee	Recorded	Remarks
A	N.D.	1-30-39	Lira D. Landry	Shafit	30	See also State 149-N
A	Art. Re.	1-26-39	Federal Land Bank	Shafit	30	See also State 149-N
A'	D.Q.C.	9-3-38	Arthur N. & Gertrude Mason	St. of Vt.	30	See also State 149-N
A''	D.Q.C.	3-3-39	Arthur N. & Gertrude Mason	St. of Vt.	30	See also State 149-N

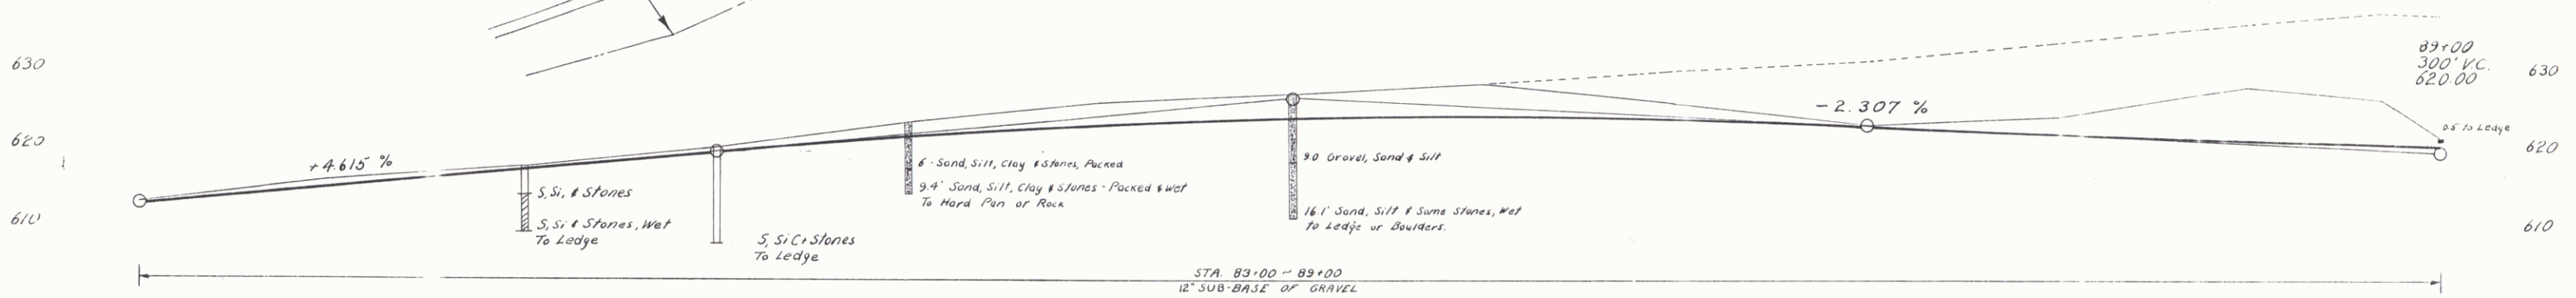

B.M. #10 Spike in Root of 12" Elm 23 Ft. Lt. of Sta. 84+85

BRADFORD
CRAFTS BRIDGE
ST. 149 M
PWA DOCKET NO. VT 1020-2-F-B