

INDEX OF SHEETS

SHEET NO.	1	TITLE PAGE
2	2	TYPICAL SECTIONS FOR SECOND CLASS ROADS, YEAR 312-A
3	3	BANKING AND WIDENING TABLES
4	4	QUANTITY SHEET, ITEMS
5	5	QUANTITY SHEET, DRAINAGE
6-9	6-9	EARTHWORK SHEETS
10-20	10-20	PLAN AND PROFILE SHEETS
21	21	DETAILS OF 5'x5' REINFORCED CONCRETE BOX EXTENSION, STA. 105+50.5
22	22	STEEL SCHEDULE
23	23	DETAILS OF CORRUGATED GALVANIZED METAL PLATE PIPE ARCH, STA. 153+55
24	24	CD CONSTRUCTION DETAILS, DRAINAGE AND MARKERS
25	25	CD-2 CONSTRUCTION DETAILS, TYPICAL GRADING
26	26	STANDARD STRUCTURE SHEET SC 21, DOWELING DETAILS
27	27	STANDARD STRUCTURE SHEET S-40, BARRICADES, SIGNS, & LIGHTS
28	28	STANDARD STRUCTURE SHEET S-45-45, PLANK GUARD RAIL
29	29	STANDARD STRUCTURE SHEET S-45-45, THREE CABLE GUARD RAIL
30	30	STANDARD STRUCTURE SHEET S-53-48, P.R.C.P. DROP INLET
31-75	31-75	CROSS SECTIONS
76-78	76-78	CHANNEL SECTIONS


STANDARD STRUCTURE SHEET APPROVED BY THE CHIEF ENGINEER, VERMONT STATE DEPARTMENT OF HIGHWAYS
S-40 JUNE 10, 1950

STATE OF VERMONT
DEPARTMENT OF HIGHWAYS


PROPOSED IMPROVEMENT

FOREST HIGHWAY
FEDERAL AID PROJECT
TOWN OF WINHALL
COUNTY OF BENNINGTON
VERMONT ROUTE # 30

BEGINNING AT A POINT 3163.0 FEET WEST OF THE JAMAICA-
WINHALL TOWN LINE IN THE HAMLET OF BONDVILLE AND
EXTENDING WESTERLY 12973.8 FT.
LENGTH OF PROJECT 12973.8 FT. = 2.457 MI.

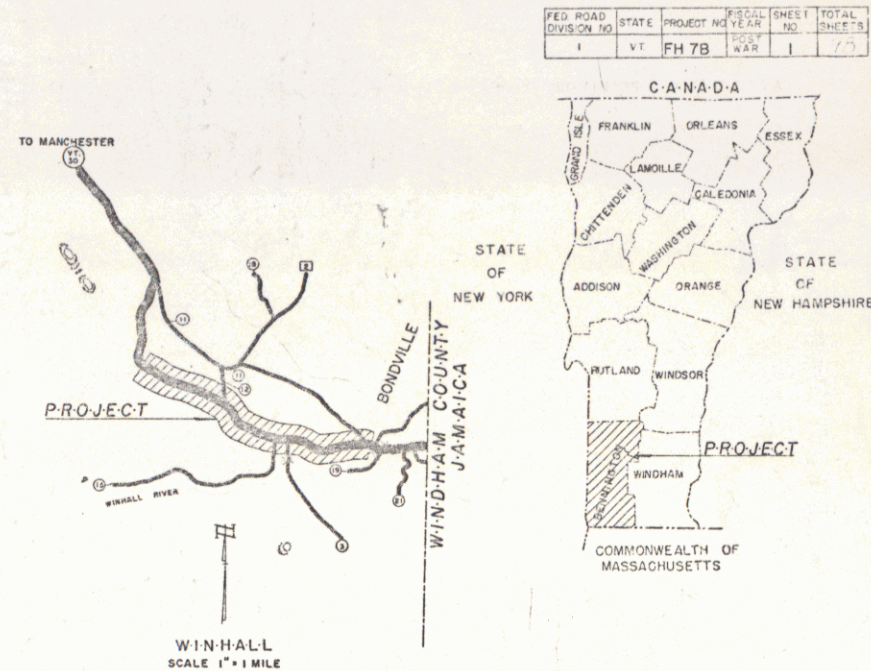

PROJECT NAME & NUMBER	TYPE PAVEMENT AREA
WINHALL FH 7B	DBL. TRACK REEDED Tar & Asphalt Seal
RECORD	PLANS 28 881 SY'S
Cement Lone Star	R.C.P. VT Conc Pipe Co. Windsor VT
Sand William E. Dailey Plant	ACCOMP. Berjar Metal Westminster VT
Stone "	C.S. ROIL American Steel & Wire Co.
Tar Koppers Products Co. Everett Mass	Gravel Rouch's P.A. Jamaica VT
Reinf. Steel VT Structural Steel Building Co. VT	
Contractor William E. Dailey	Contract Dated May 20 1955
Resident Engineer Wilbur Kallio	Construction Began May 30 1955
Inspector P.F. Karr	Construction Completed Oct. 12 1956
Record Plans P.F. Karr	Construction Resumed Oct. 12 1956

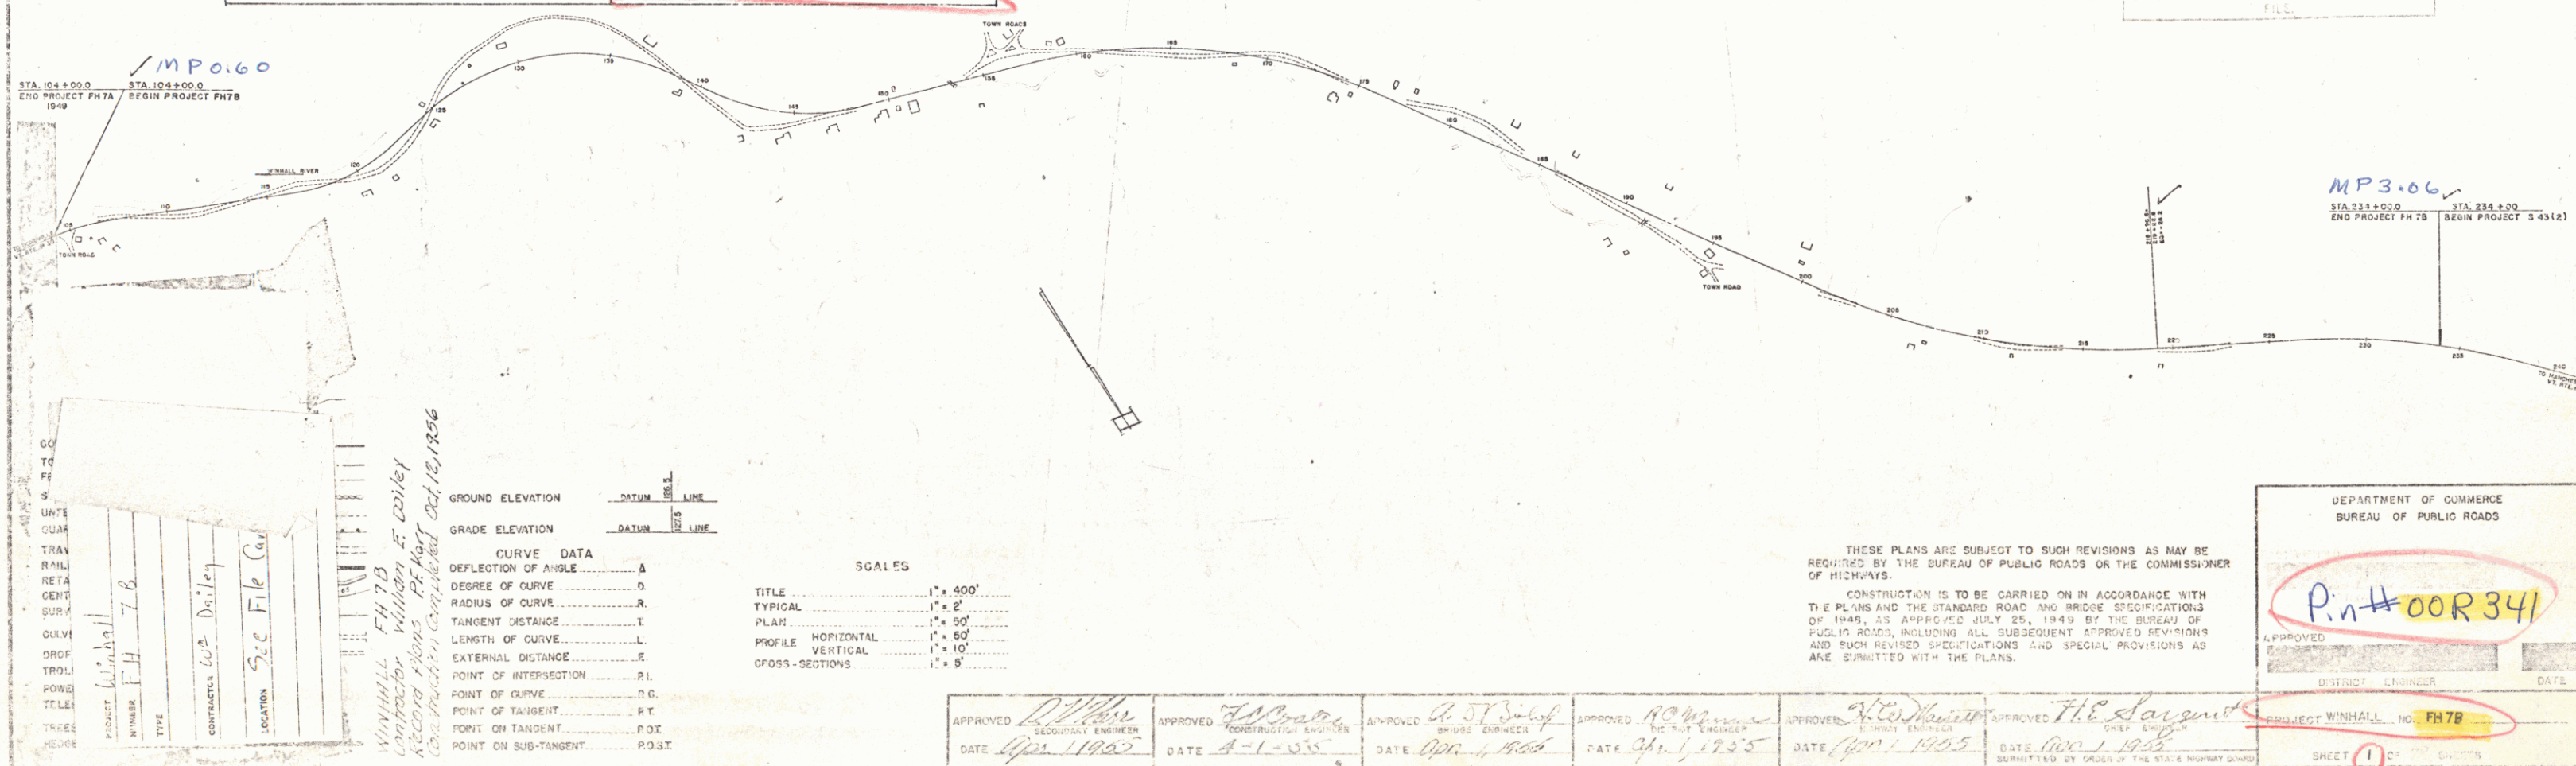

THESE PLANS ARE SUBJECT TO SUCH REVISIONS AS MAY BE
REQUIRED BY THE BUREAU OF PUBLIC ROADS OR THE COMMISSIONER
OF HIGHWAYS.

CONSTRUCTION IS TO BE CARRIED ON IN ACCORDANCE WITH
THE PLANS AND THE STANDARD ROAD AND BRIDGE SPECIFICATIONS
OF 1948, AS APPROVED JULY 25, 1949 BY THE BUREAU OF
PUBLIC ROADS, INCLUDING ALL SUBSEQUENT APPROVED REVISIONS
AND SUCH REVISED SPECIFICATIONS AND SPECIAL PROVISIONS AS
ARE SUBMITTED WITH THE PLANS.

DEPARTMENT OF COMMERCE
BUREAU OF PUBLIC ROADS


PROJECT WINHALL NO. FH 7B

SHEET 1 OF 3 DIVISION


APPROVED [Signature] DISTRICT ENGINEER DATE [Date]

STEARNS R. JENKINS

Pte 30

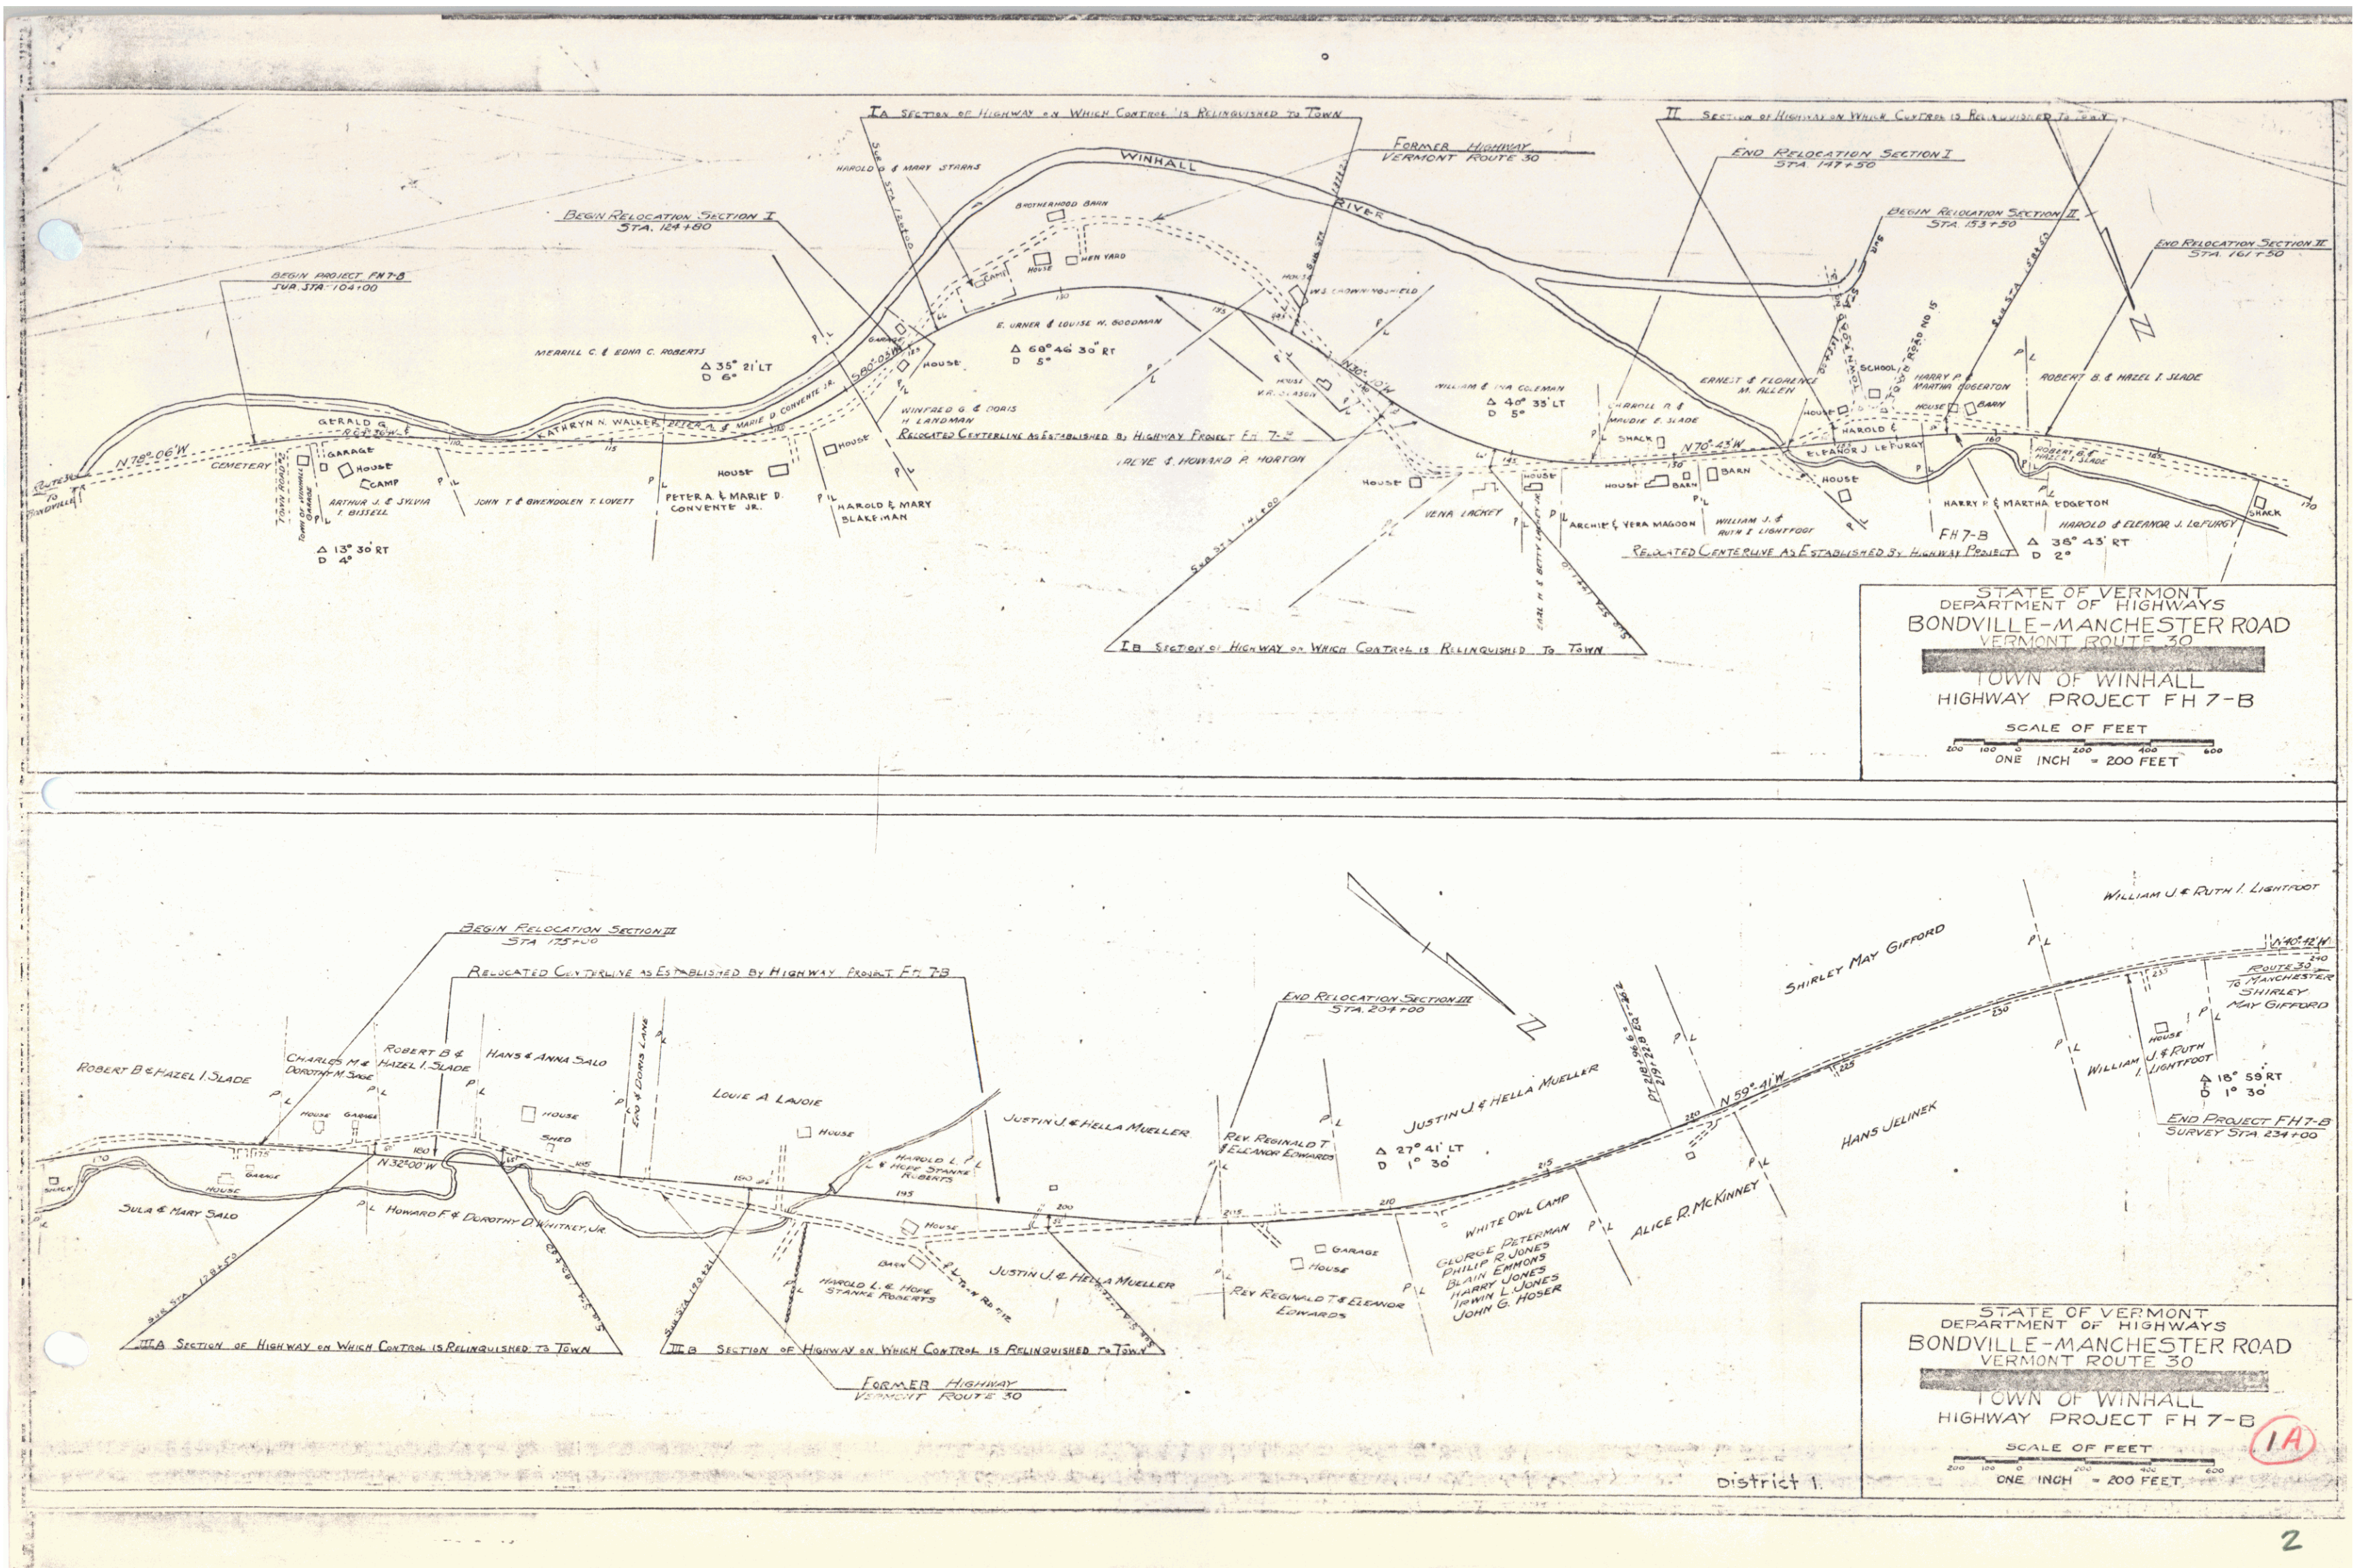

DATE	7/24
BY	W. J. MILLER
CHECKED	W. J. MILLER
DATE	7/24
BY	W. J. MILLER
CHECKED	W. J. MILLER


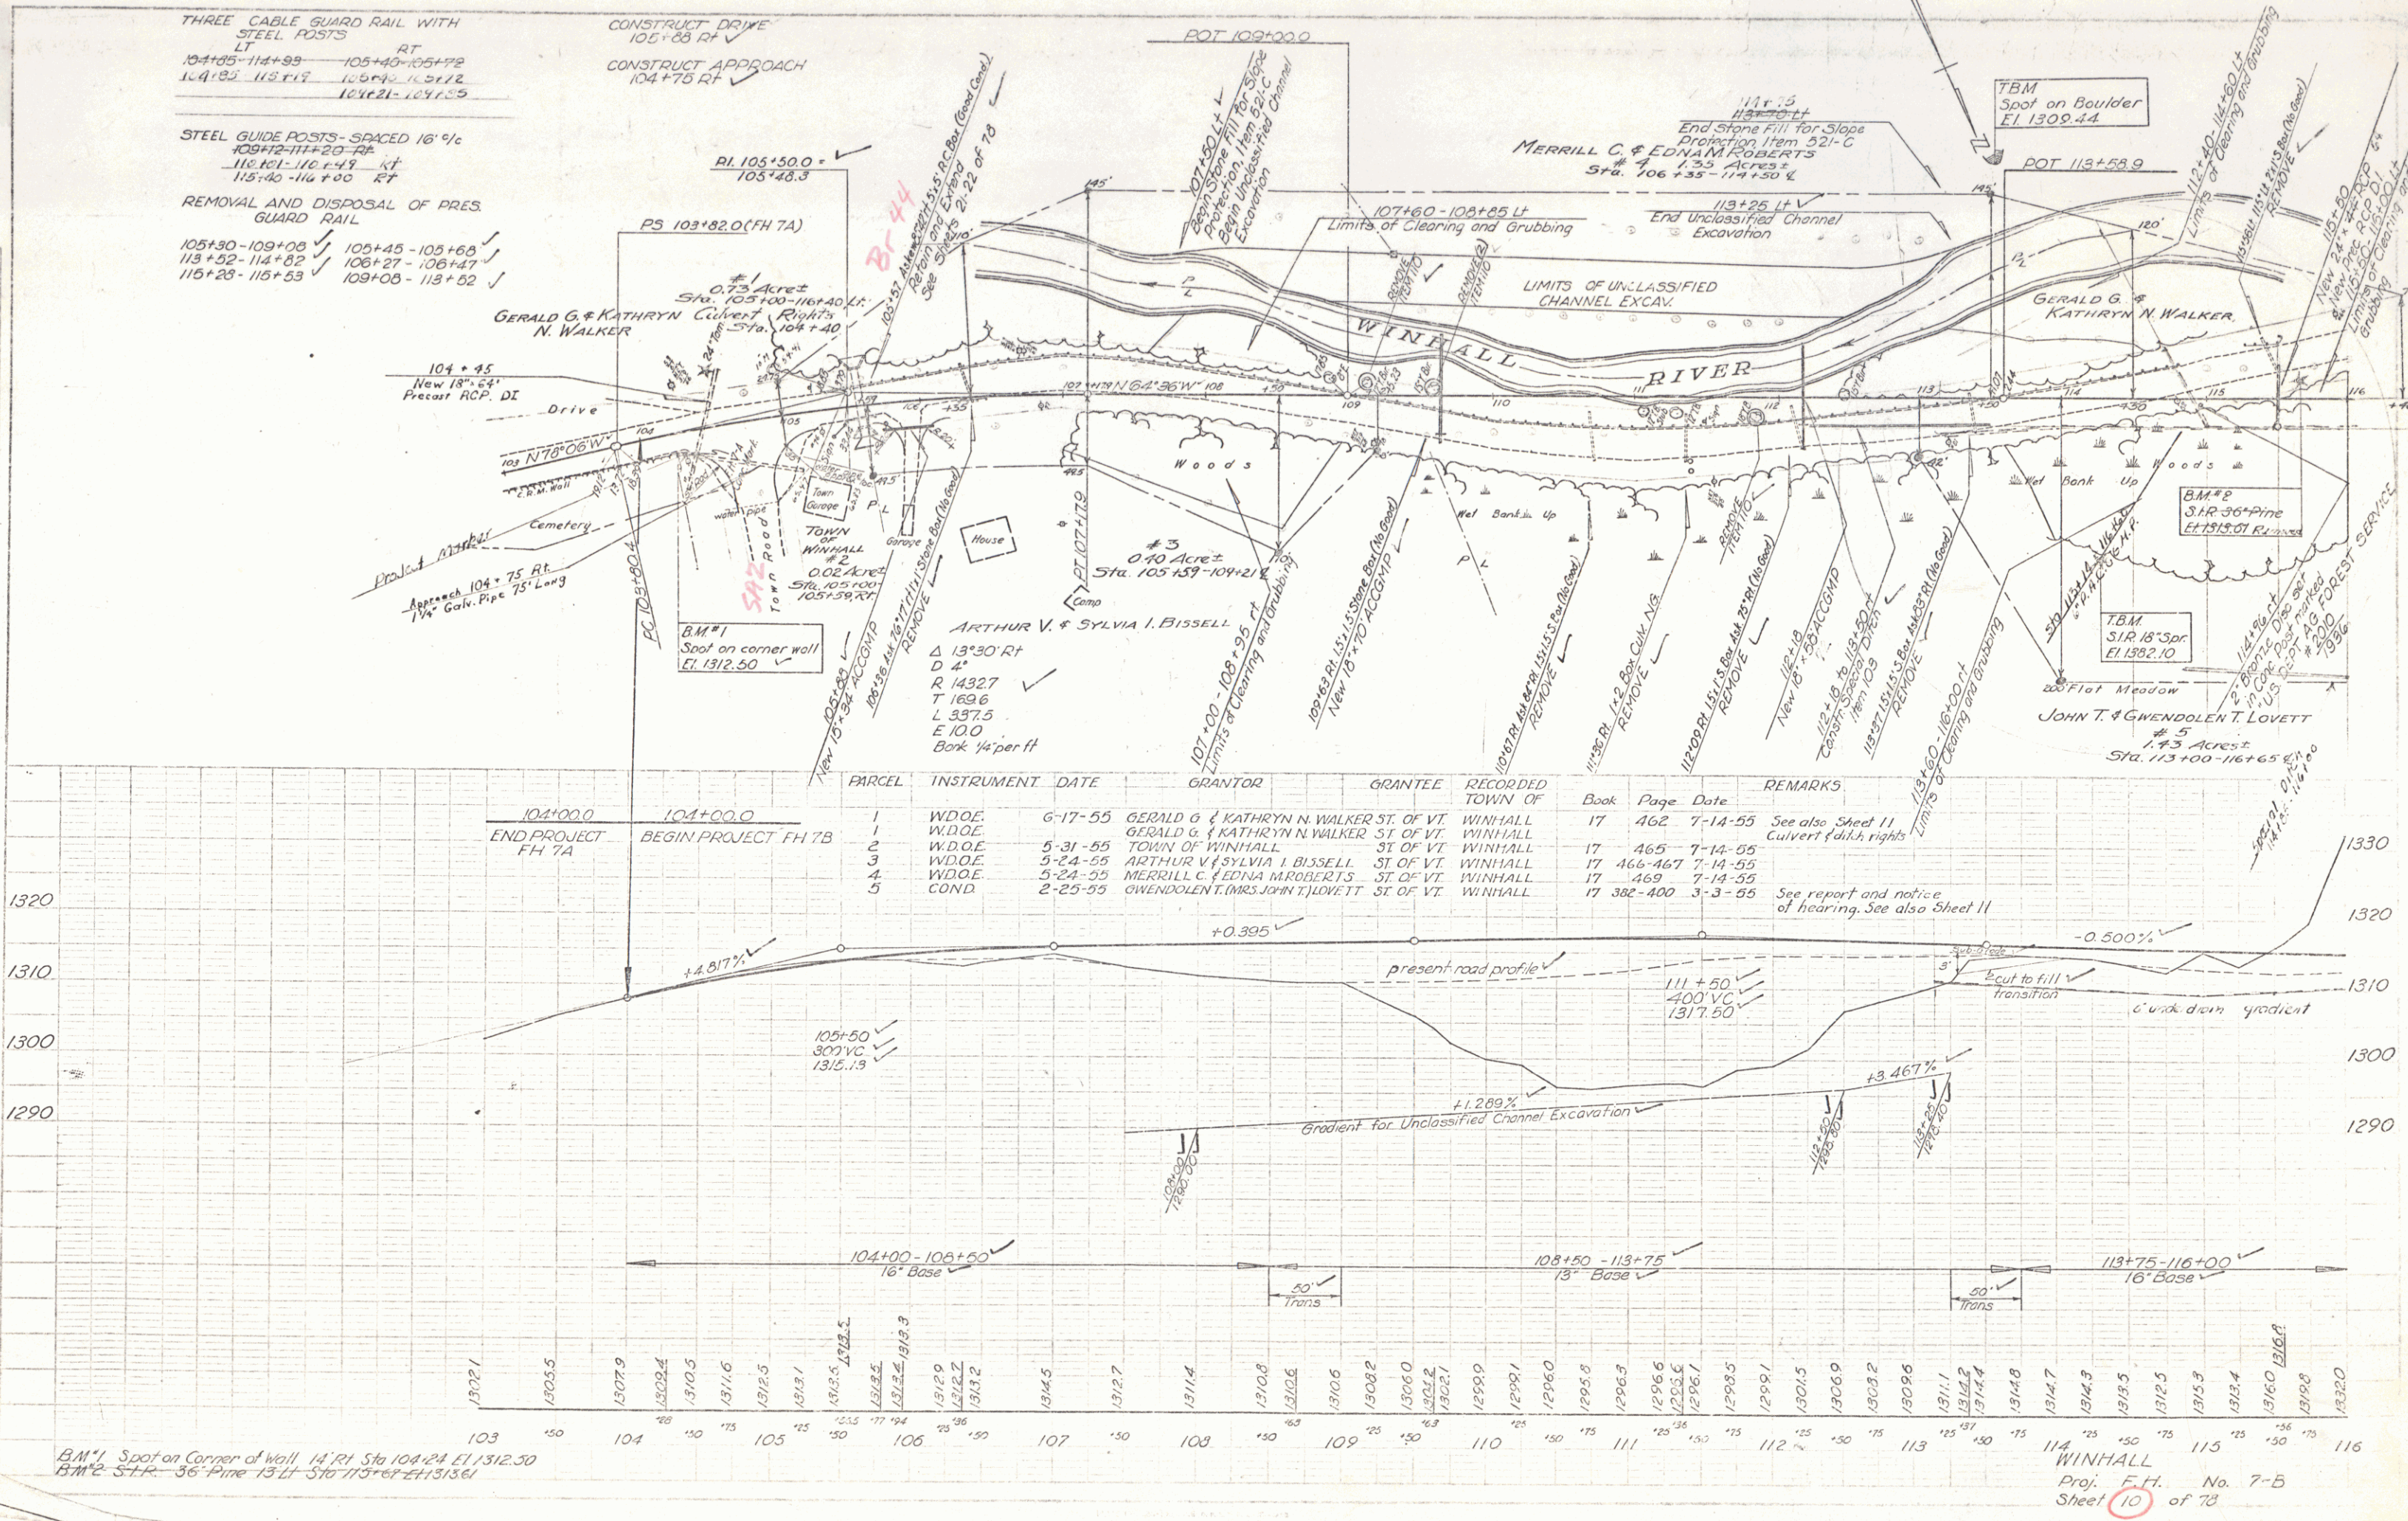


PLAN
 REVISION
 DATE
 BY
 CHECKED
 NO.


NOTE
 REVISION
 DATE
 BY
 CHECKED
 NO.

STEEL GUIDE POSTS SPACED 16' 0"
 LT 116+27-119+63 RT 117+60-121+72
 REMOVAL AND DISPOSAL OF PRESENT
 GUARD RAIL
 LT 116+80-119+25 RT 119+25-121+30

CONSTRUCT DRIVES
 120+45 RT
 121+32 RT

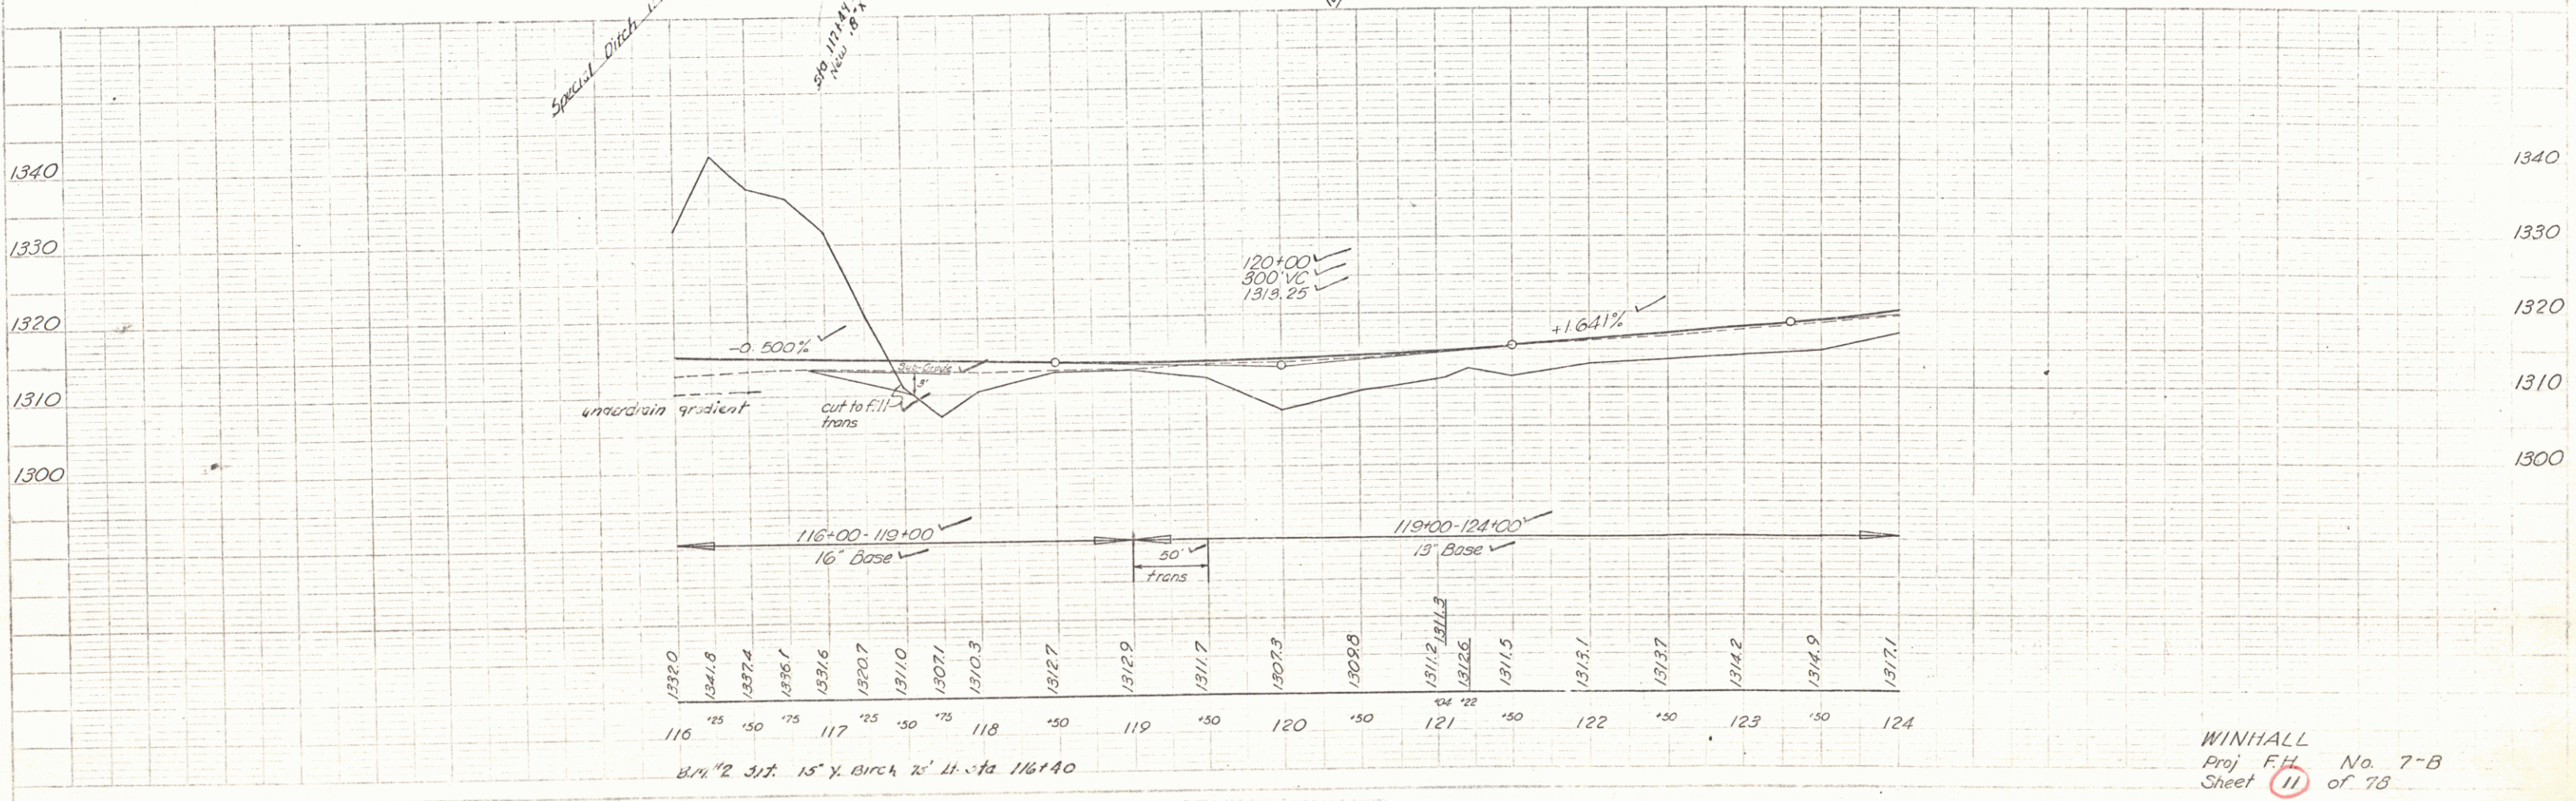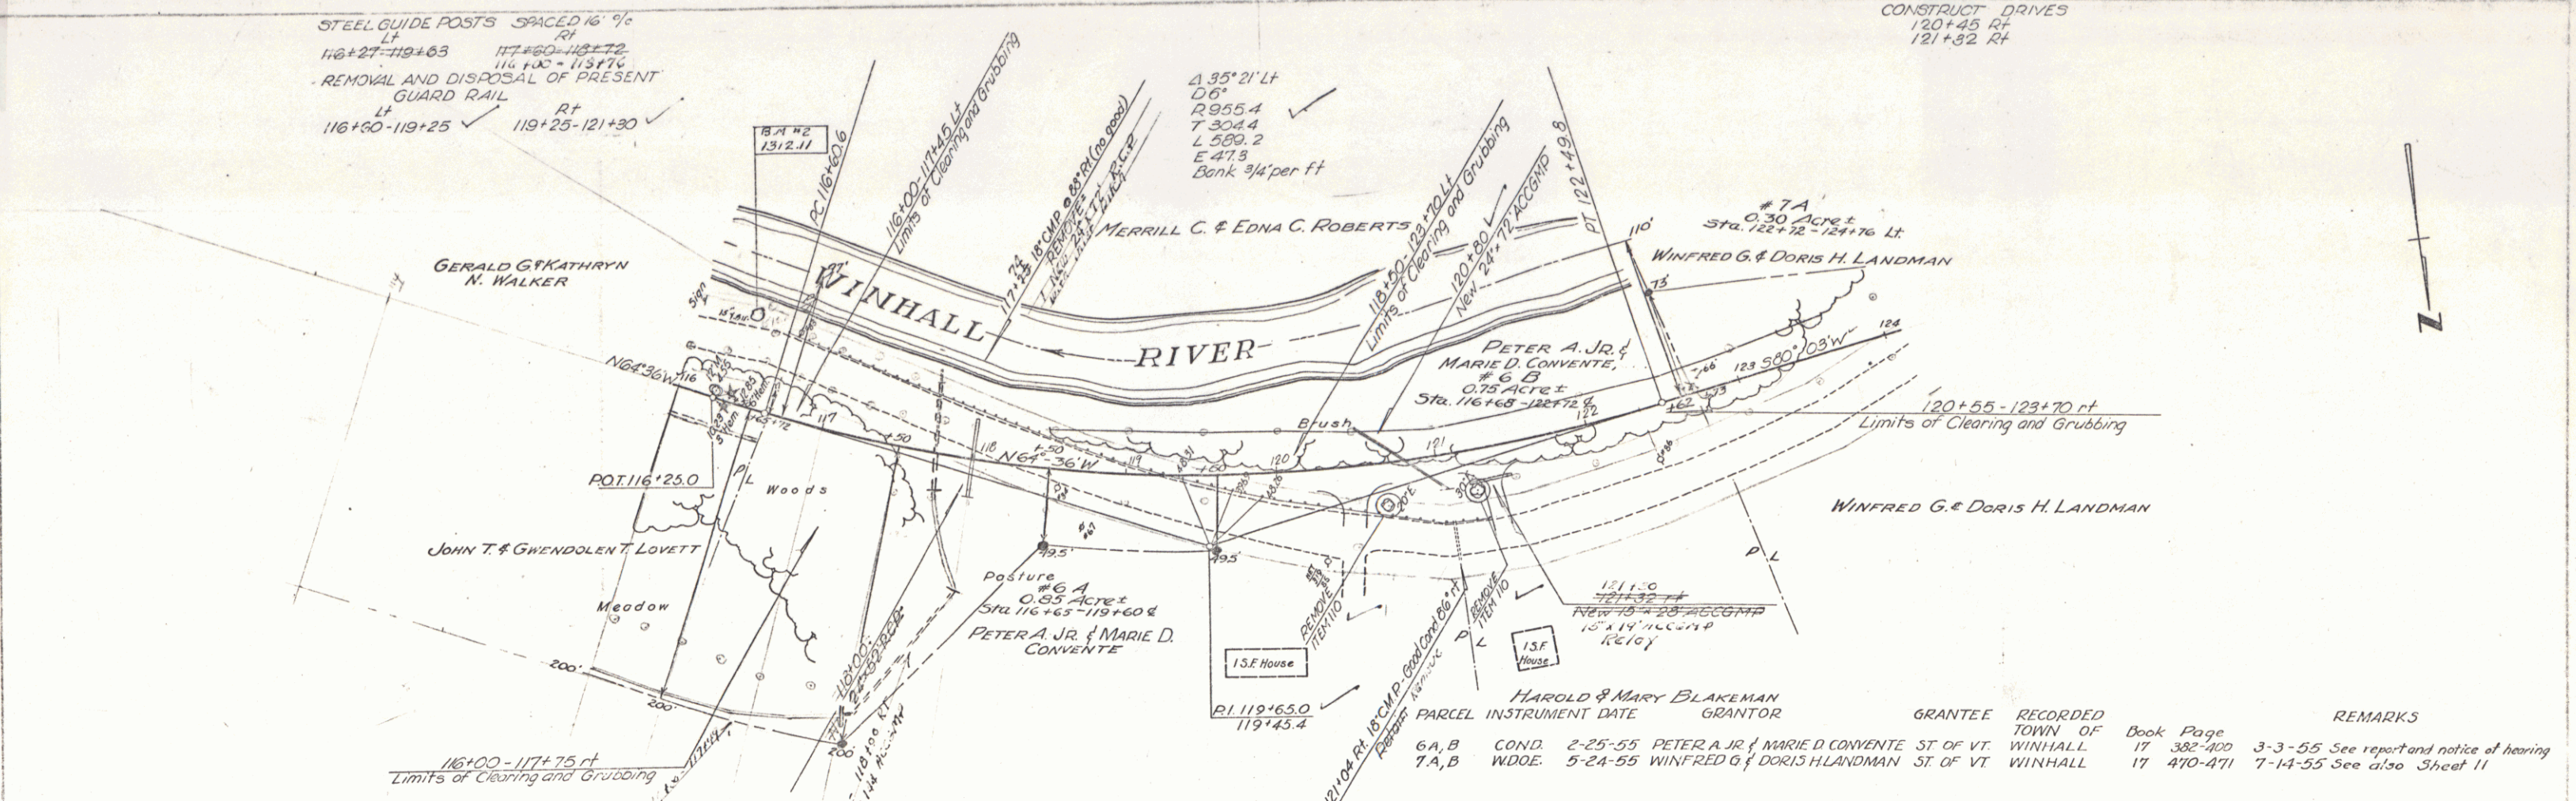


WINHALL
 Proj. F.H. No. 7-B
 Sheet 11 of 15


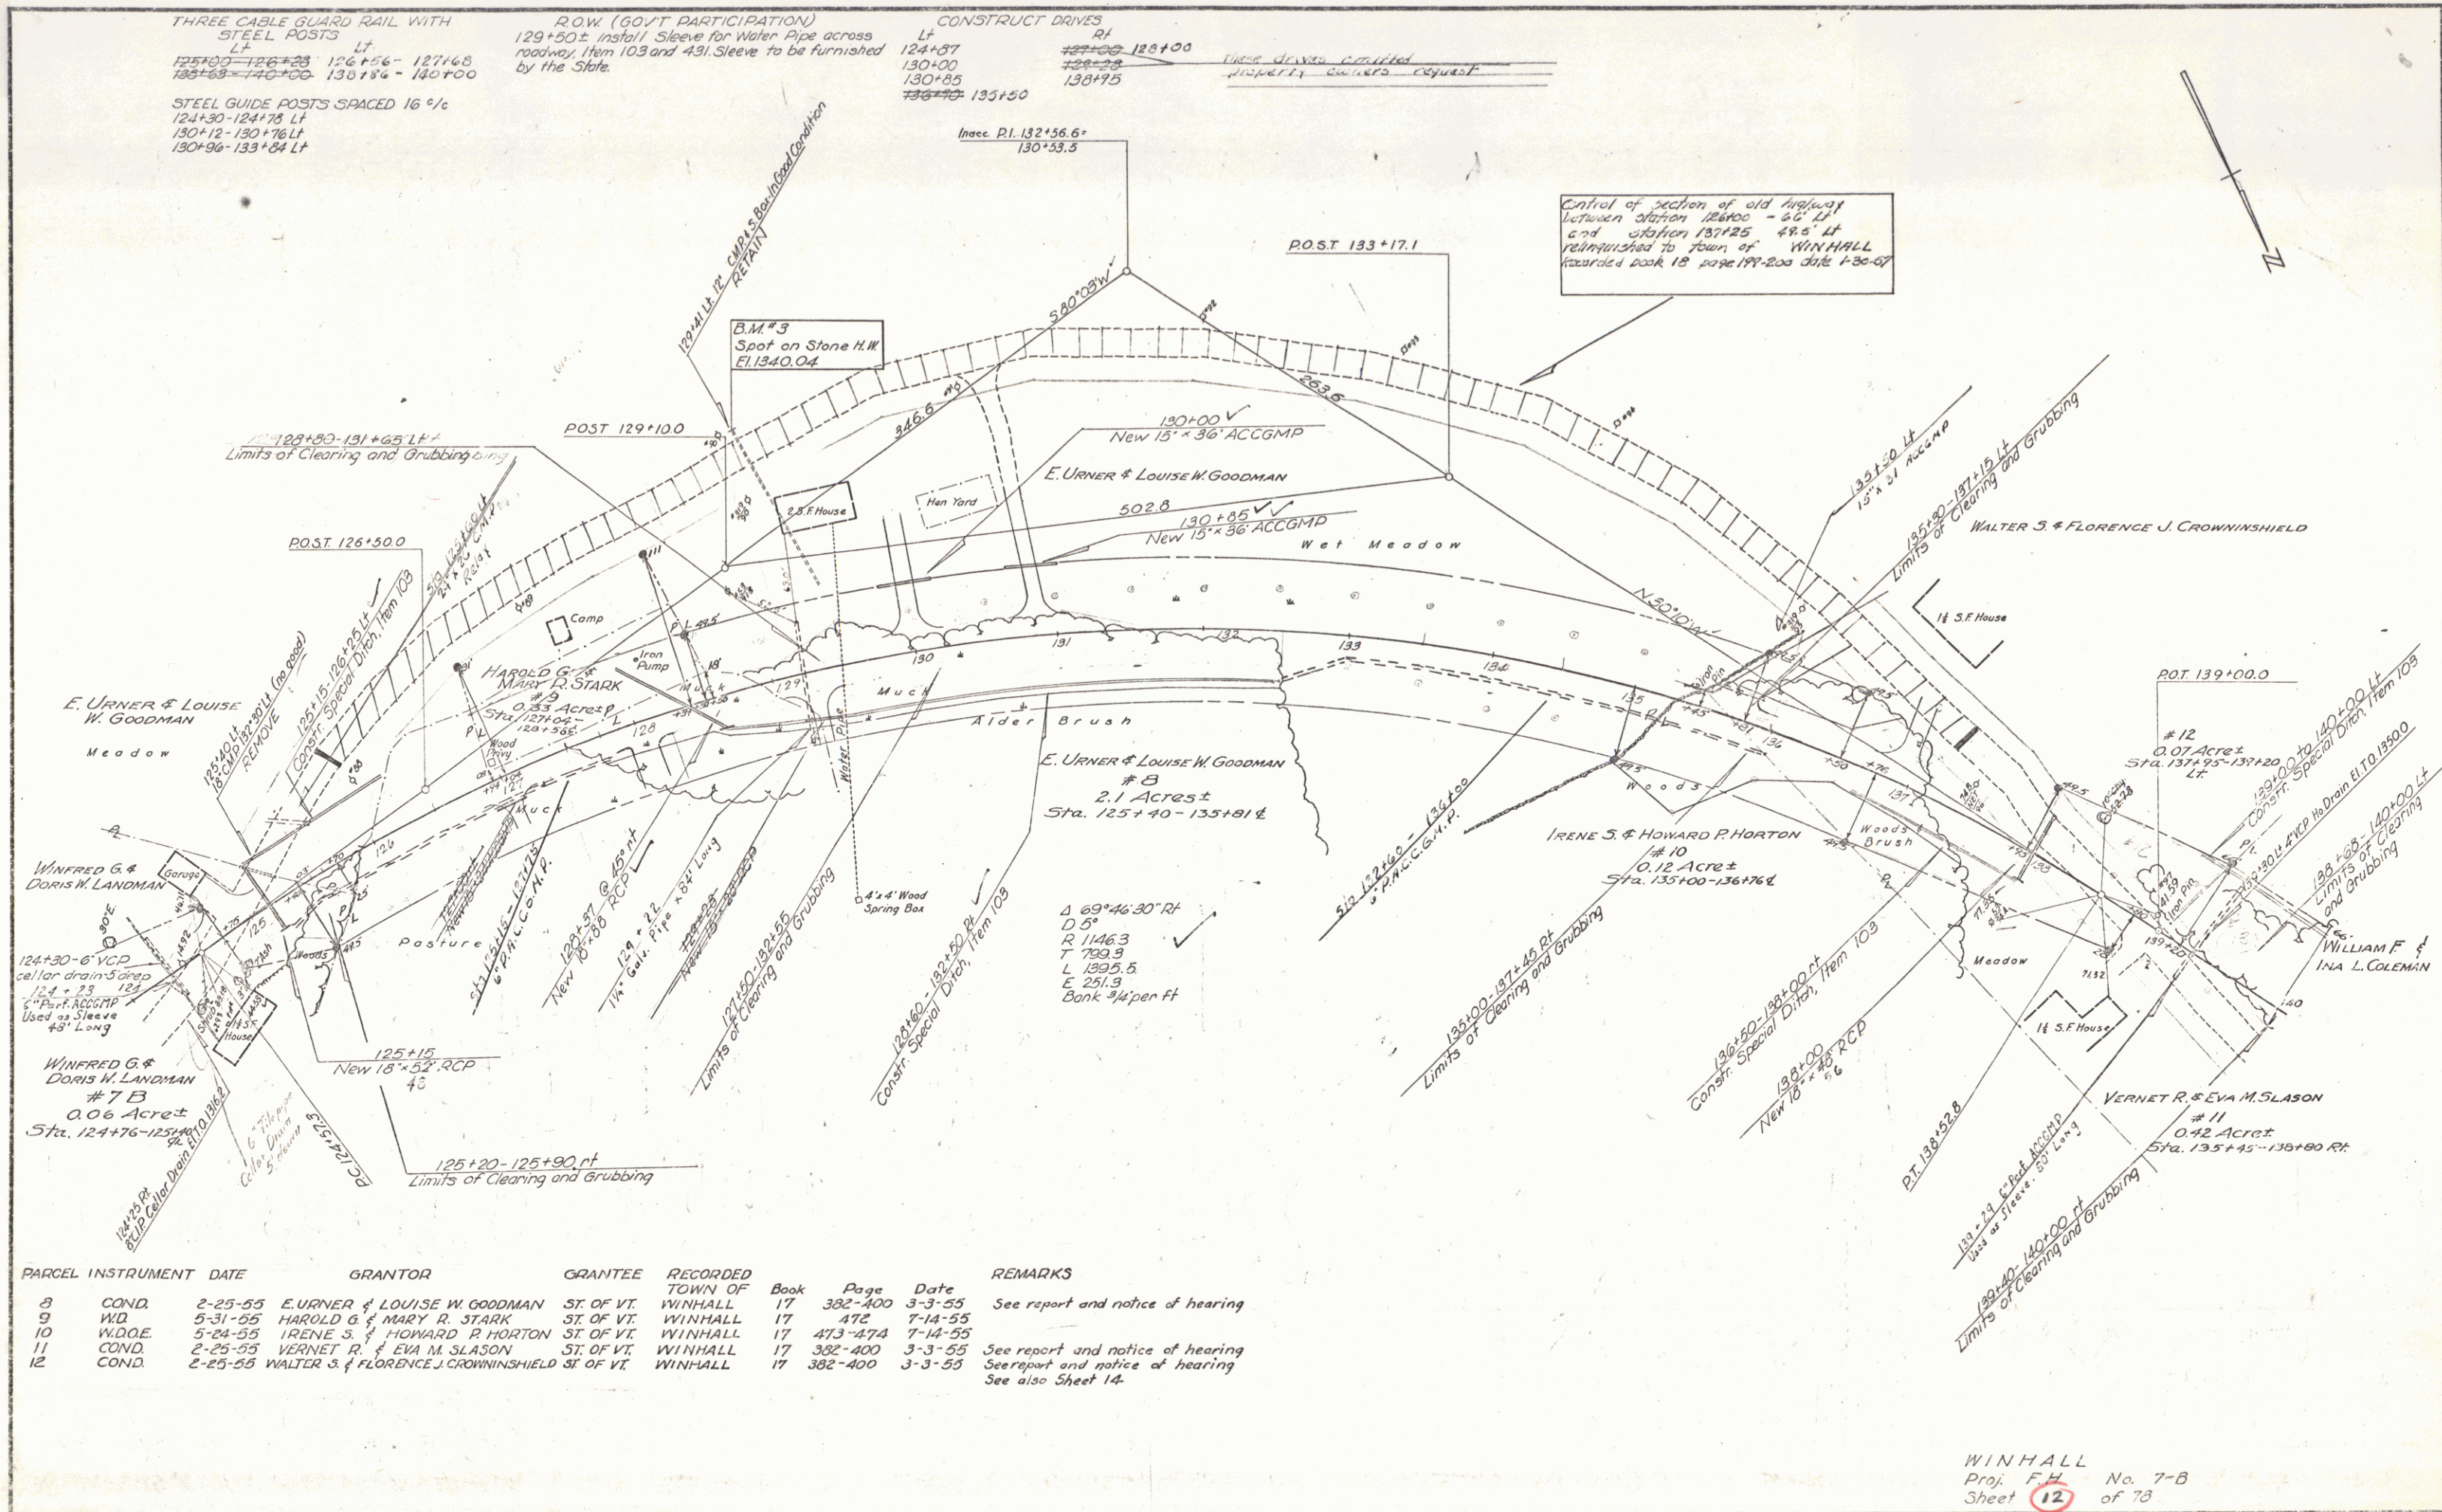


PARCEL	INSTRUMENT	DATE	GRANTOR	GRANTEE	RECORDED	BOOK	PAGE	DATE	REMARKS
8	COND.	2-25-55	E. URNER & LOUISE W. GOODMAN	ST. OF VT.	WINHALL	17	382-400	3-3-55	See report and notice of hearing
9	WD.	5-31-55	HAROLD G. & MARY R. STARK	ST. OF VT.	WINHALL	17	472	7-14-55	
10	W.D.O.E.	5-24-55	IRENE S. & HOWARD P. HORTON	ST. OF VT.	WINHALL	17	473-474	7-14-55	
11	COND.	2-25-55	VERNET R. & EVA M. SLASON	ST. OF VT.	WINHALL	17	382-400	3-3-55	See report and notice of hearing
12	COND.	2-25-55	WALTER S. & FLORENCE J. CROWNSHIELD	ST. OF VT.	WINHALL	17	382-400	3-3-55	See report and notice of hearing See also Sheet 14.

WINHALL
Proj. F.H. No. 7-B
Sheet 12 of 73

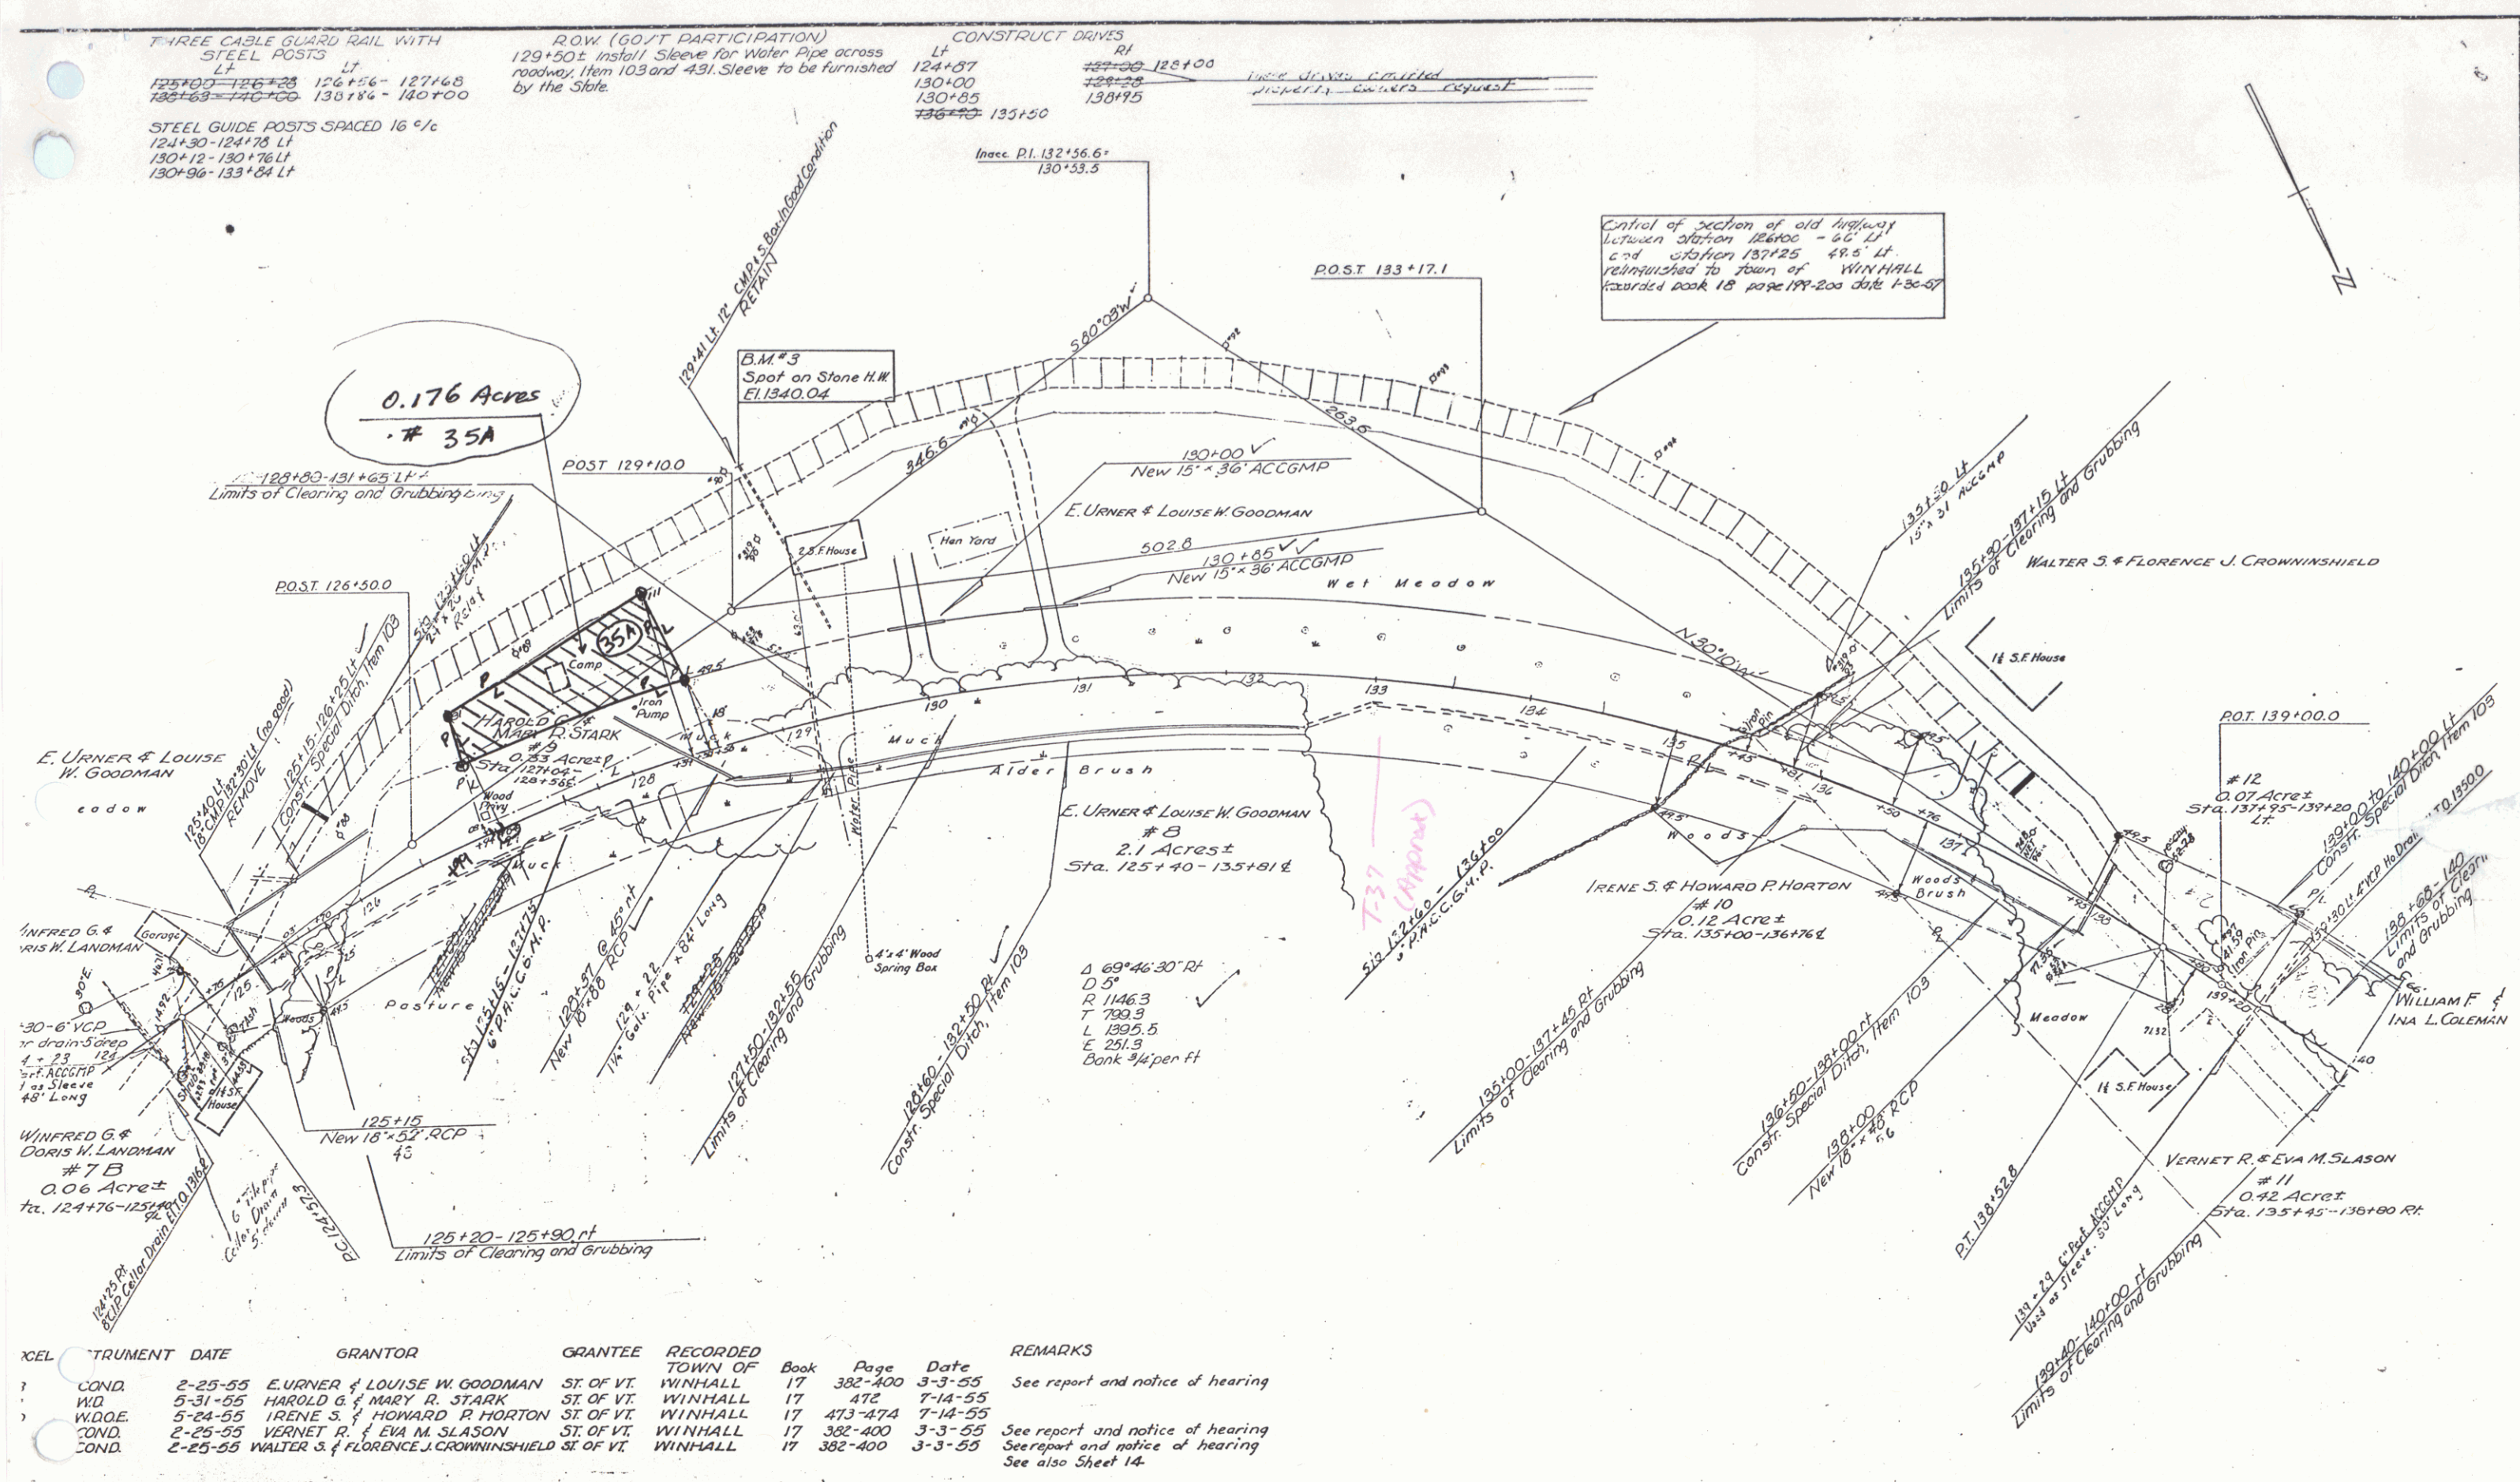

INSTRUMENT	DATE	GRANTOR	GRANTEE	RECORDED	BOOK	PAGE	DATE	REMARKS
COND.	2-25-55	E. URNER & LOUISE W. GOODMAN	ST. OF VT.	WINHALL	17	382-400	3-3-55	See report and notice of hearing
W.D.	5-31-55	HAROLD G. & MARY R. STARK	ST. OF VT.	WINHALL	17	476	7-14-55	
W.D.O.E.	5-24-55	IRENE S. & HOWARD R. HORTON	ST. OF VT.	WINHALL	17	473-474	7-14-55	
COND.	2-25-55	VERNET R. & EVA M. SLASON	ST. OF VT.	WINHALL	17	382-400	3-3-55	See report and notice of hearing
COND.	2-25-55	WALTER S. & FLORENCE J. CROWNSHIELD	ST. OF VT.	WINHALL	17	382-400	3-3-55	See report and notice of hearing

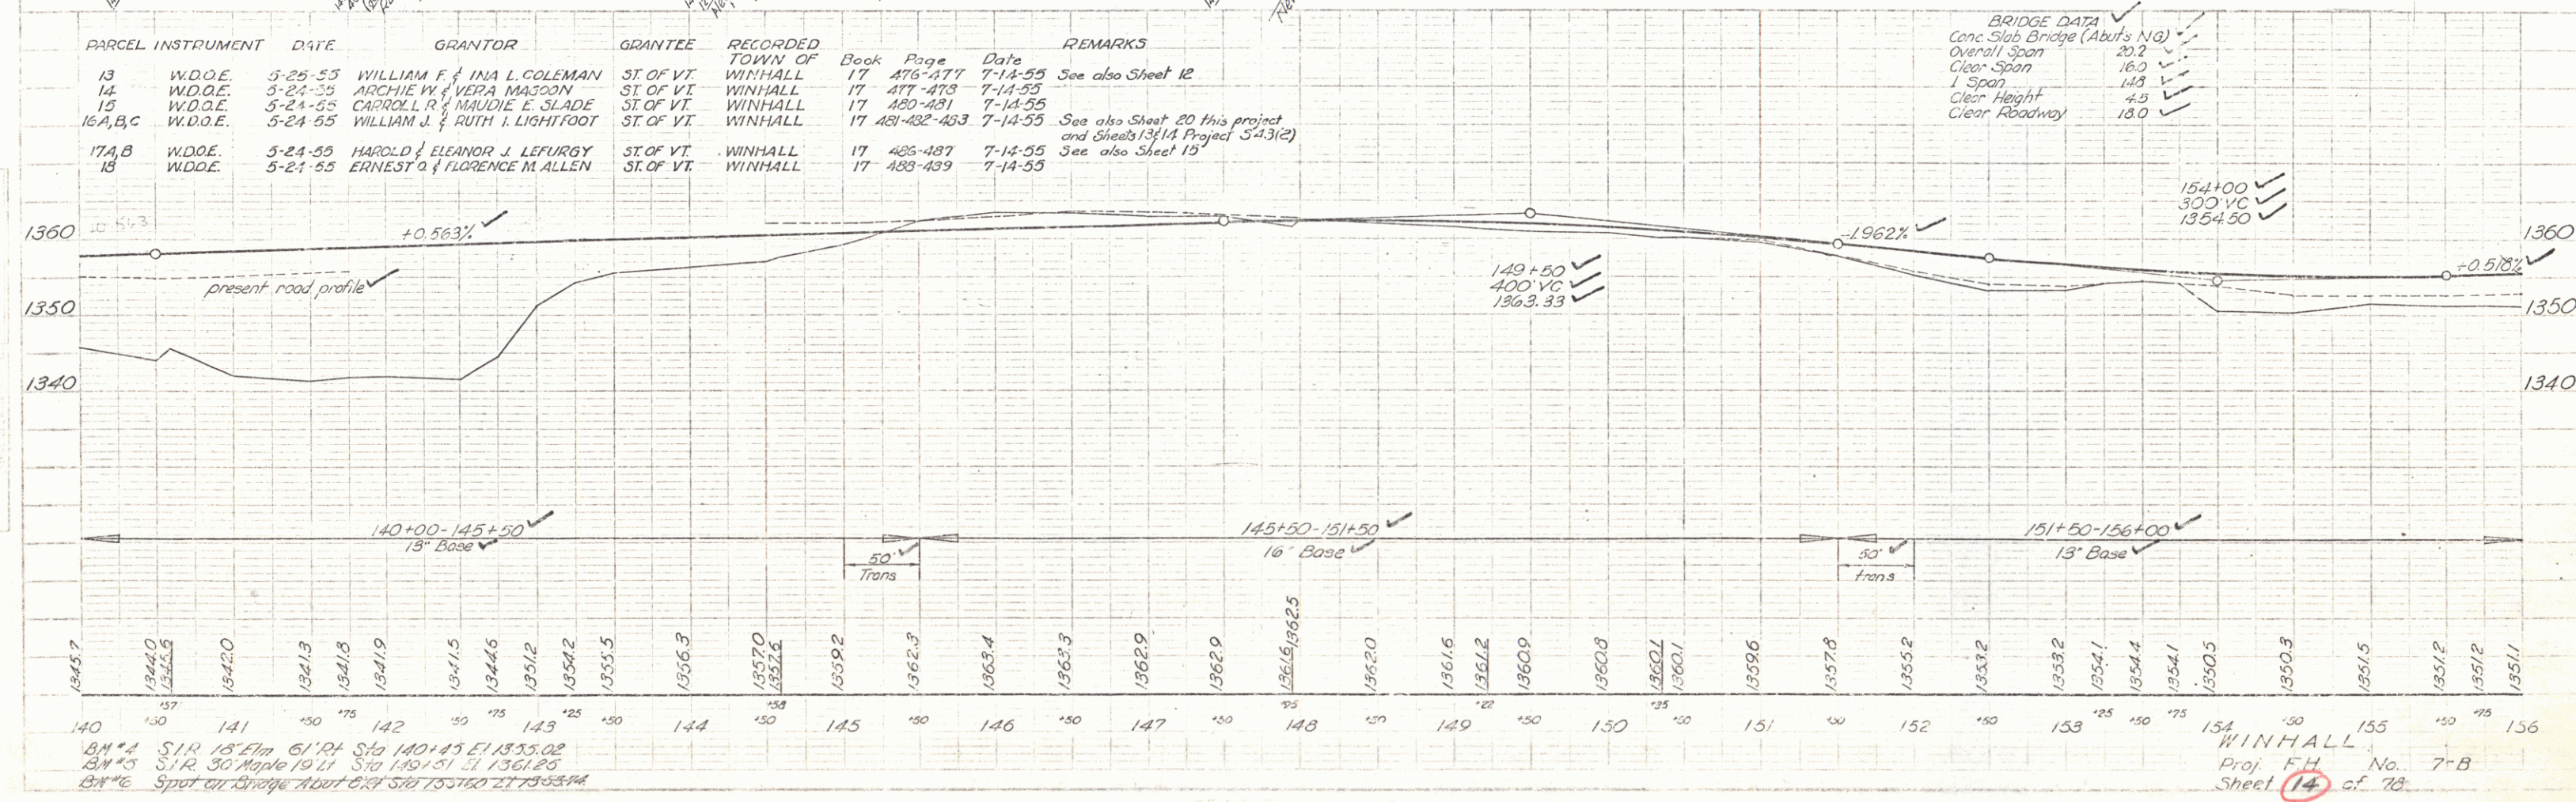
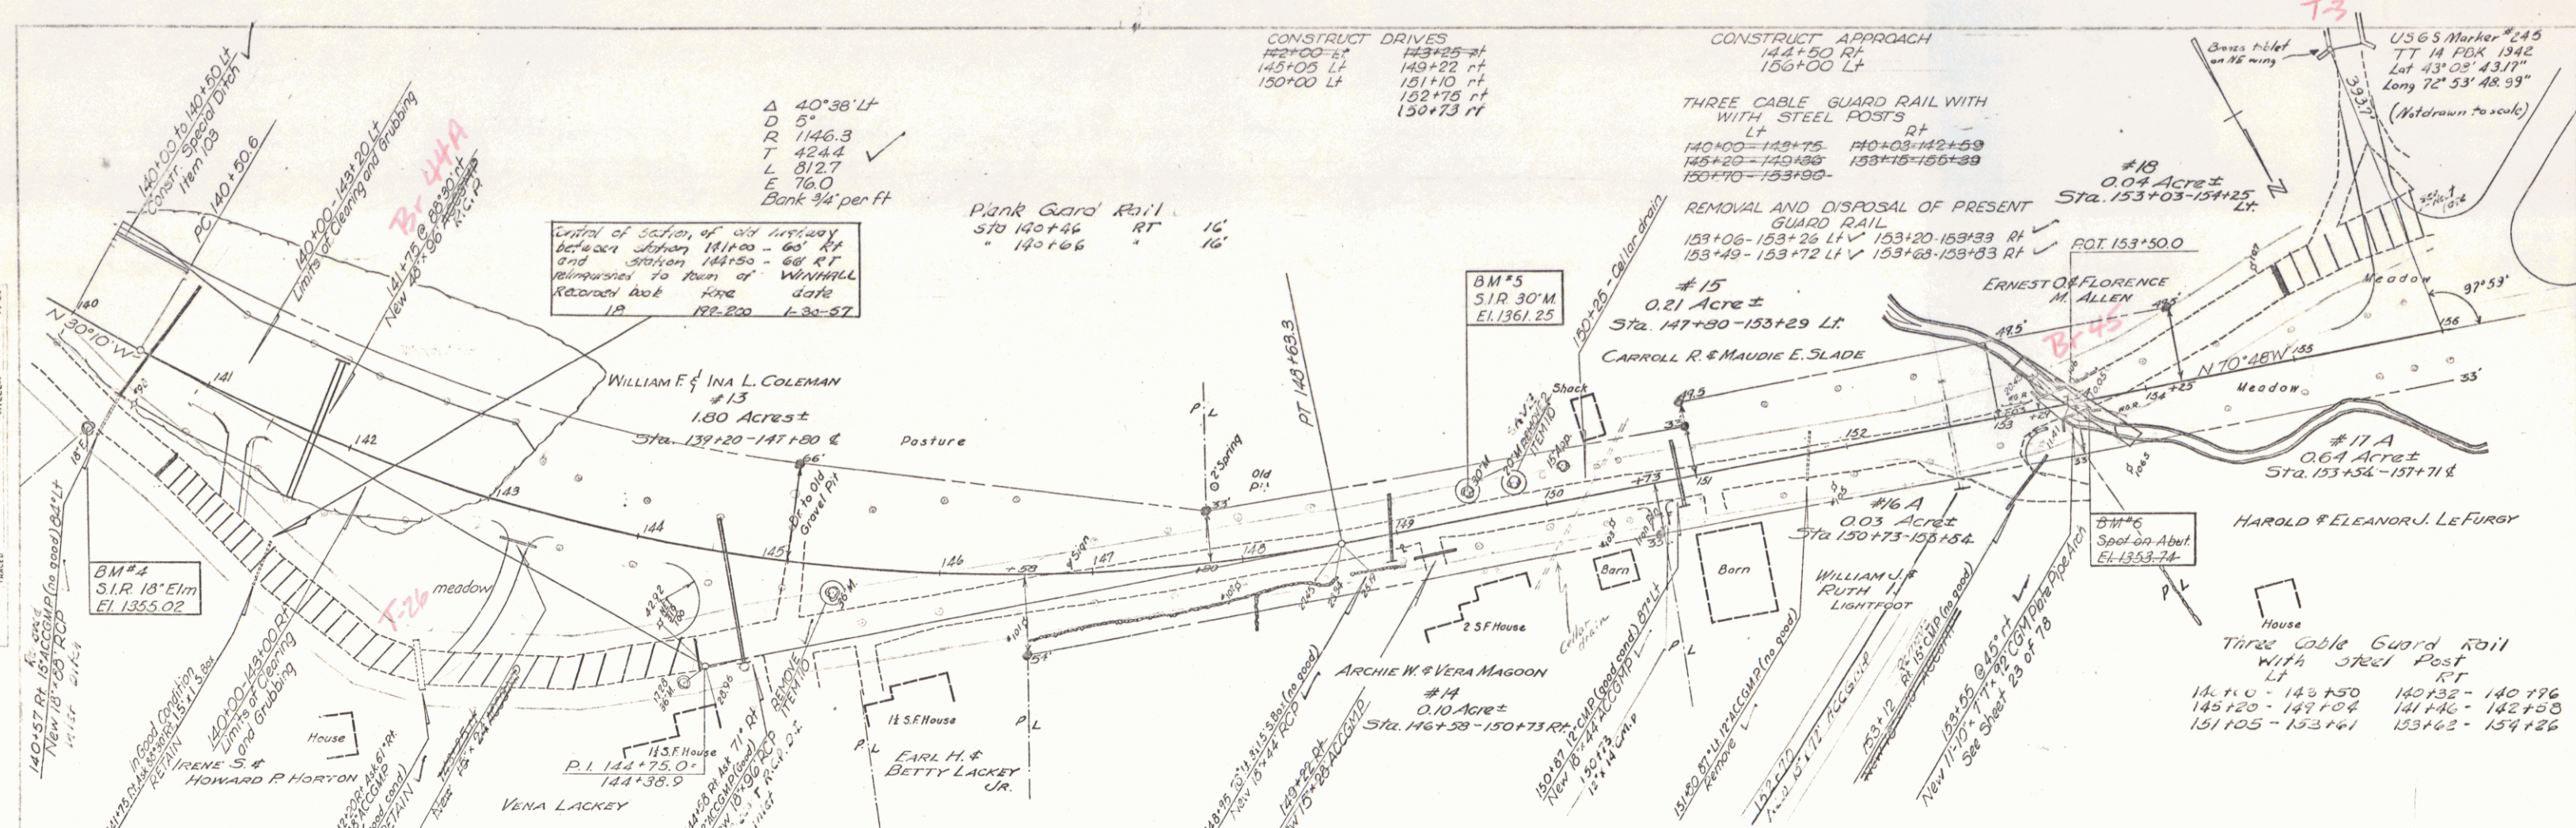


THREE CABLE GUARD RAIL WITH
STEEL POSTS
172+00-172+44 Rt

CONSTRUCT DRIVES
Rt
174+22 ✓ 173+30 Lt
174+65 ✓

STEEL GUIDE POSTS = 10' 4" -
176+18-176+19 Rt


PARCEL INSTRUMENT DATE	GRANTOR	GRANTEE	RECORDED	TOWN OF	Book	Page	Date	REMARKS
22 WDOE 5-24-55	CHARLES M & DOROTHY M SAGE	ST. OF VT.	WINHALL	17	495-499	7-14-55		

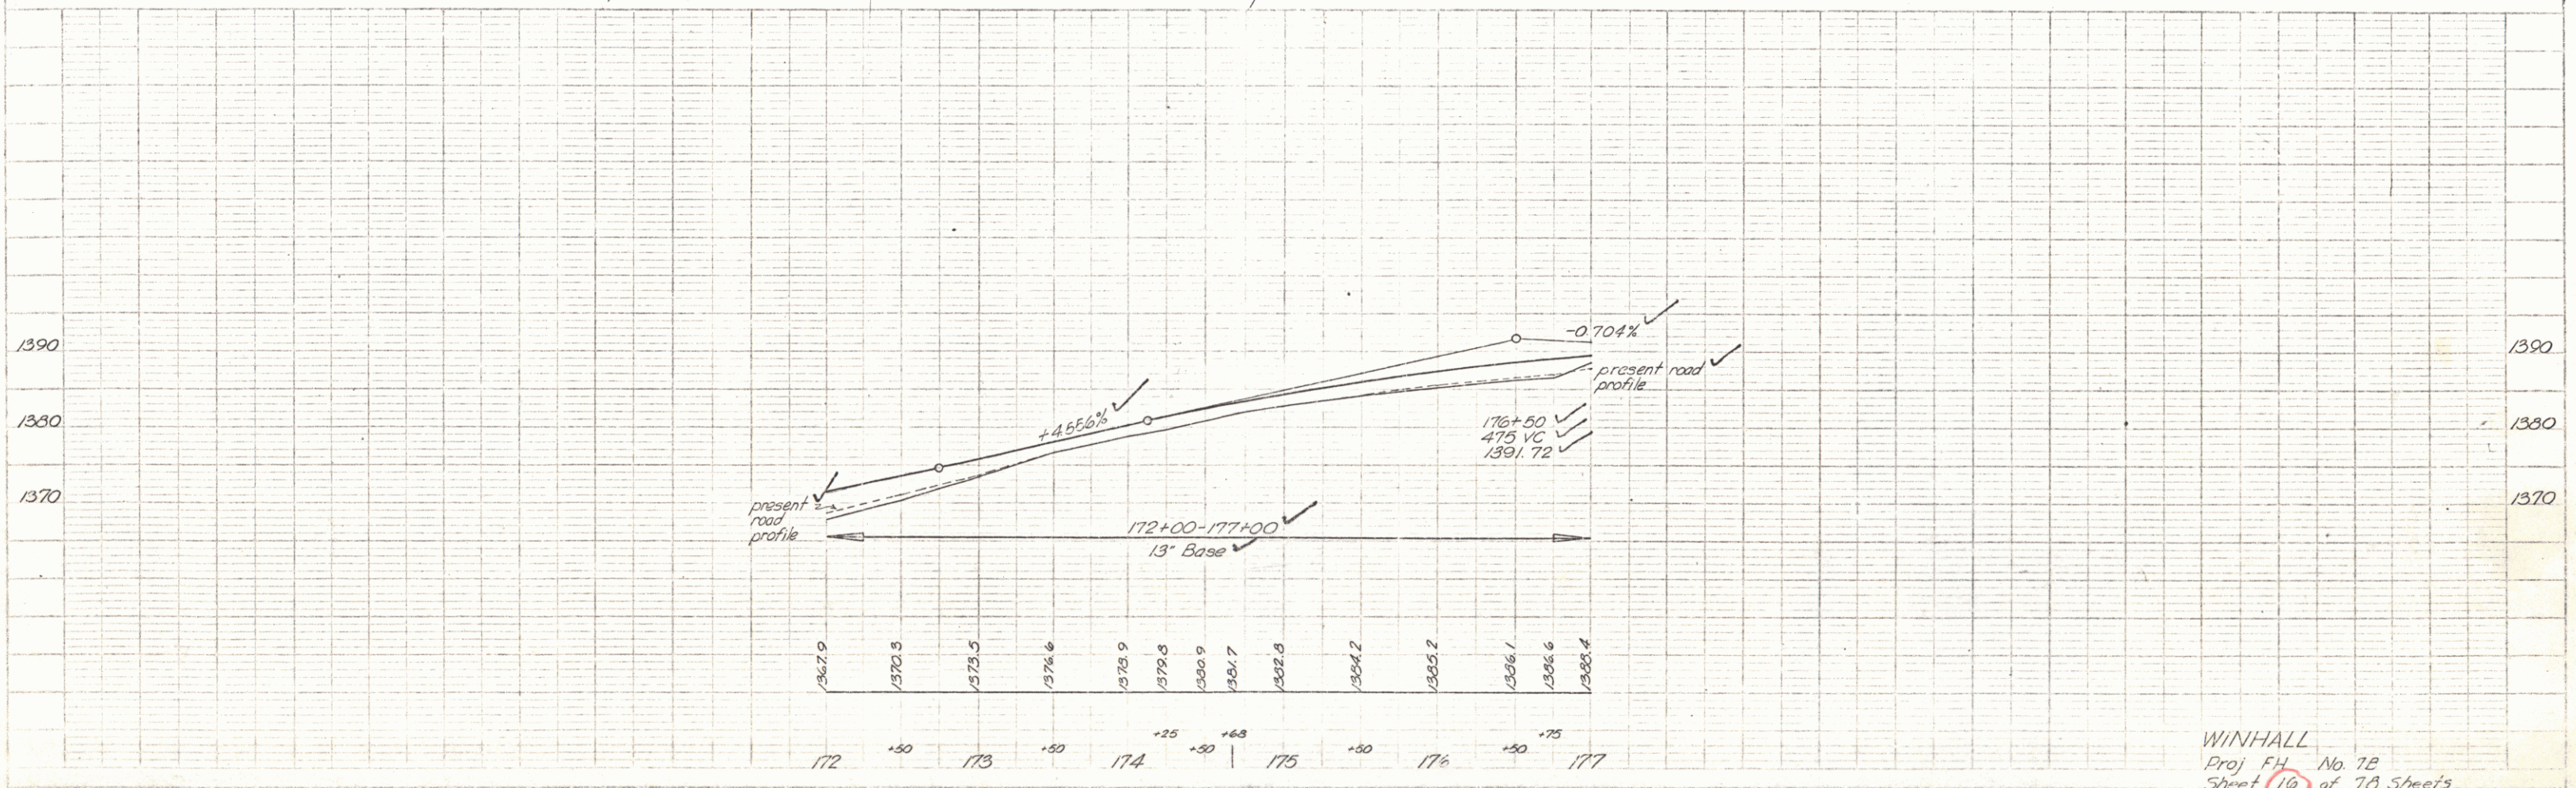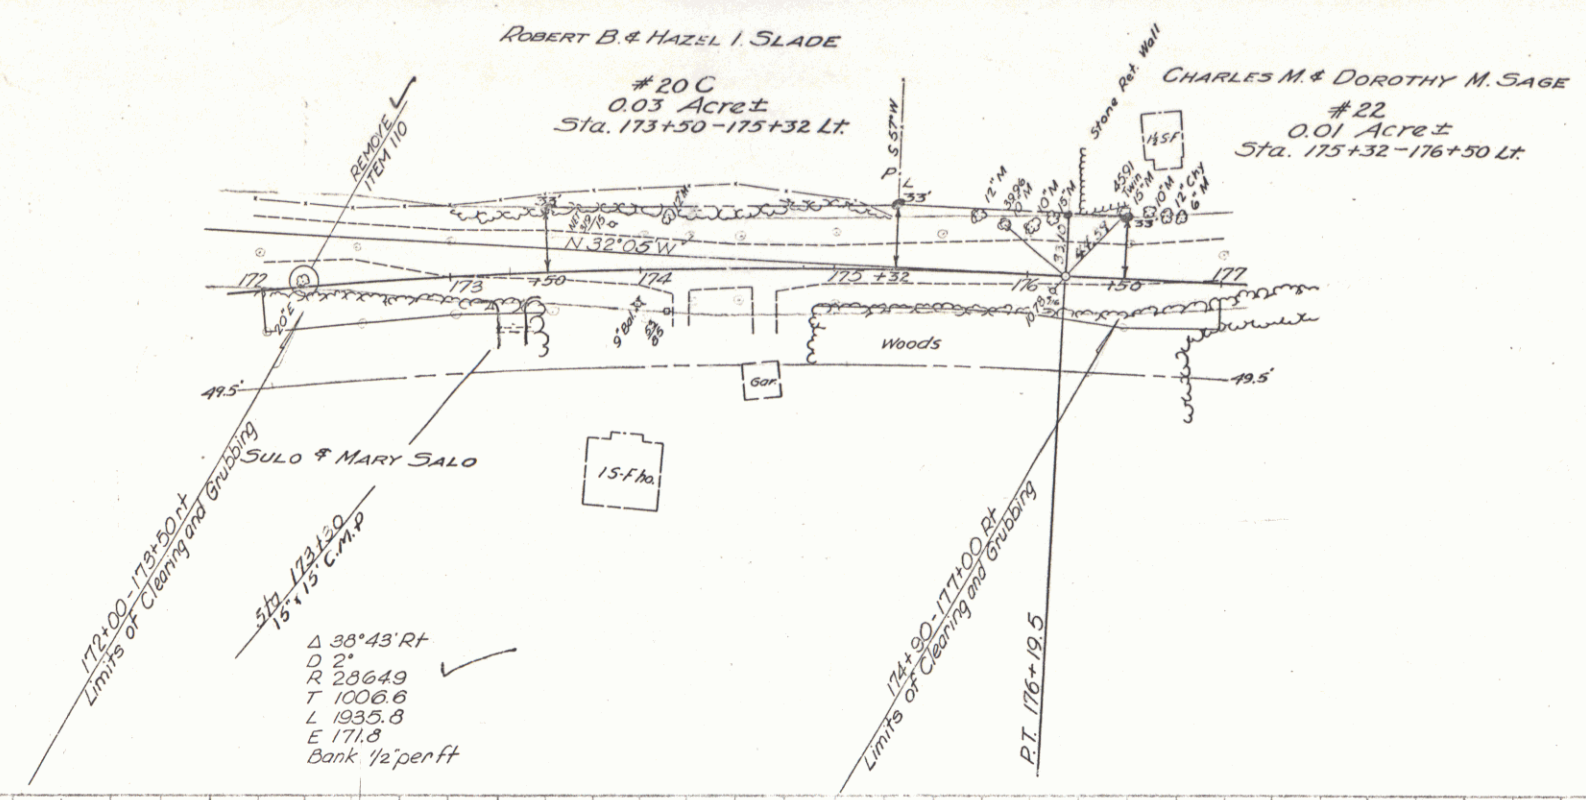


WINHALL
Proj FH No. 7B
Sheet 16 of 70 Sheets

9-54
J. Clark
12-54
M. Linsdon

12-54
Shumway
12-54
M. Linsdon


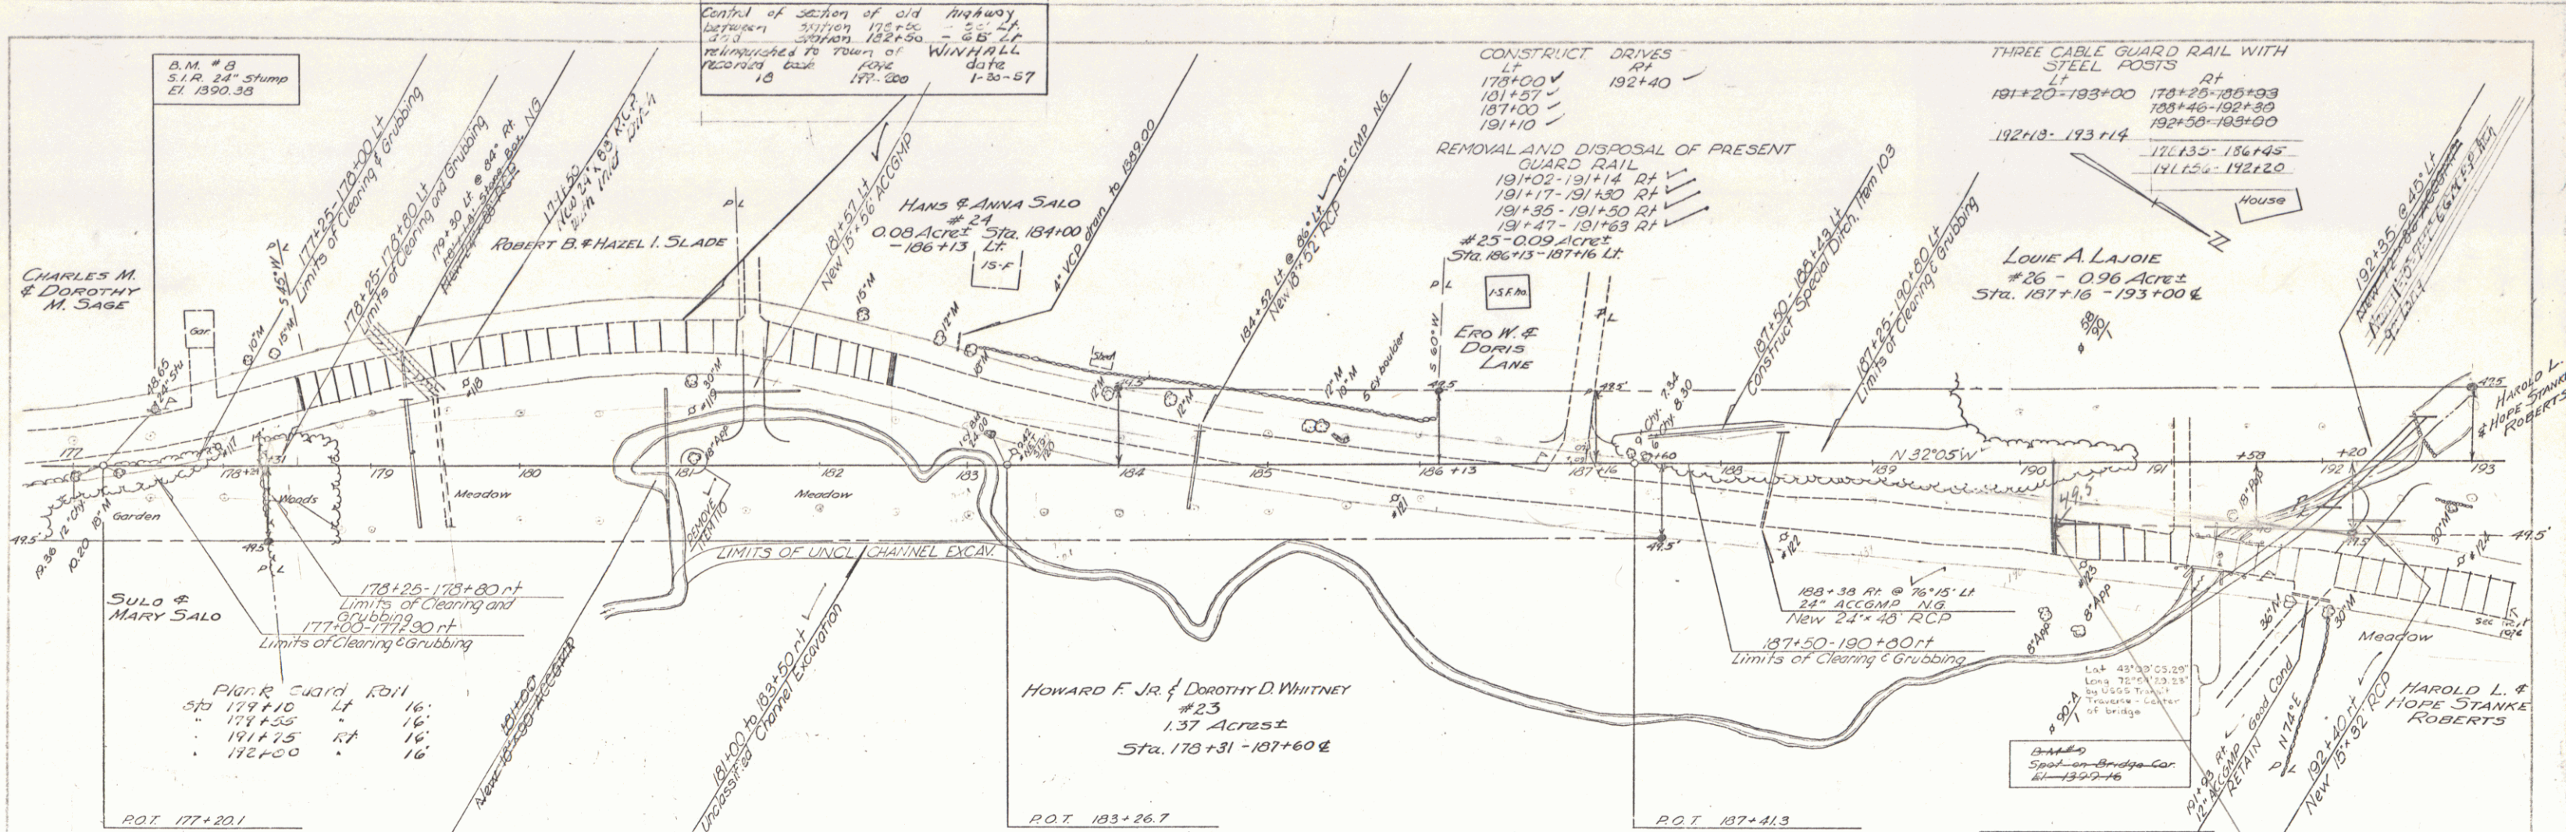


PARCEL	INSTRUMENT DATE	GRANTOR	GRANTEE	RECORDED	BOOK	PAGE	DATE	REMARKS
23	W.D.O.E.	5-24-55	HOWARD F. JR. & DOROTHY D. WHITNEY	ST. OF VT.	WINHALL	13	1-2	7-14-55
24	W.D.O.E.	5-24-55	HANS & ANNA SALO	ST. OF VT.	WINHALL	13	3-4	7-14-55
25	W.D.O.E.	6-16-55	ERO W. & DORIS LANE	ST. OF VT.	WINHALL	13	105 B	1-9-56
26	W.D.O.E.	5-24-55	LOUIE A. LAJOIE	ST. OF VT.	WINHALL	13	5-6	7-14-55 See also Sheet 13
27	W.D.O.E.	5-31-55	HAROLD L. & HOPE STANKE ROBERTS	ST. OF VT.	WINHALL	13	7-8	7-14-55 See also Sheet 13

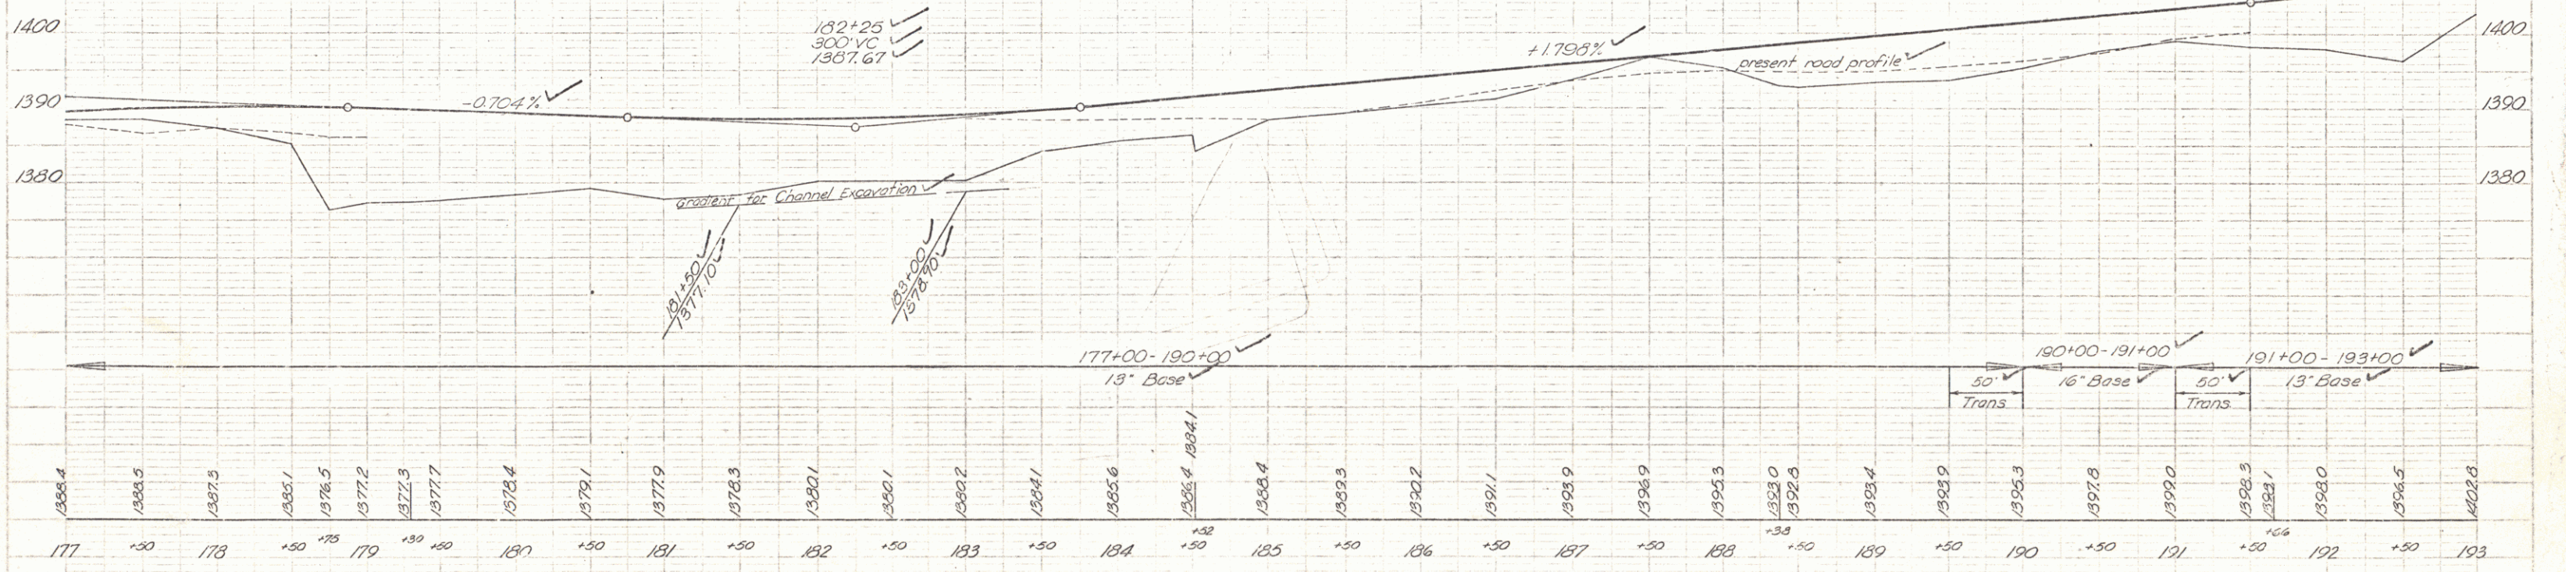

BM #8 S.I.R. 24" Stump Sta 177+53 37' Lt El 1390.33
B.M. #9 Spot-on Bridge Cor. Sta 191+13 72' Rt El 1392.16

WINHALL
Proj. FH No 78
Sheet 17 of 78 Sheets

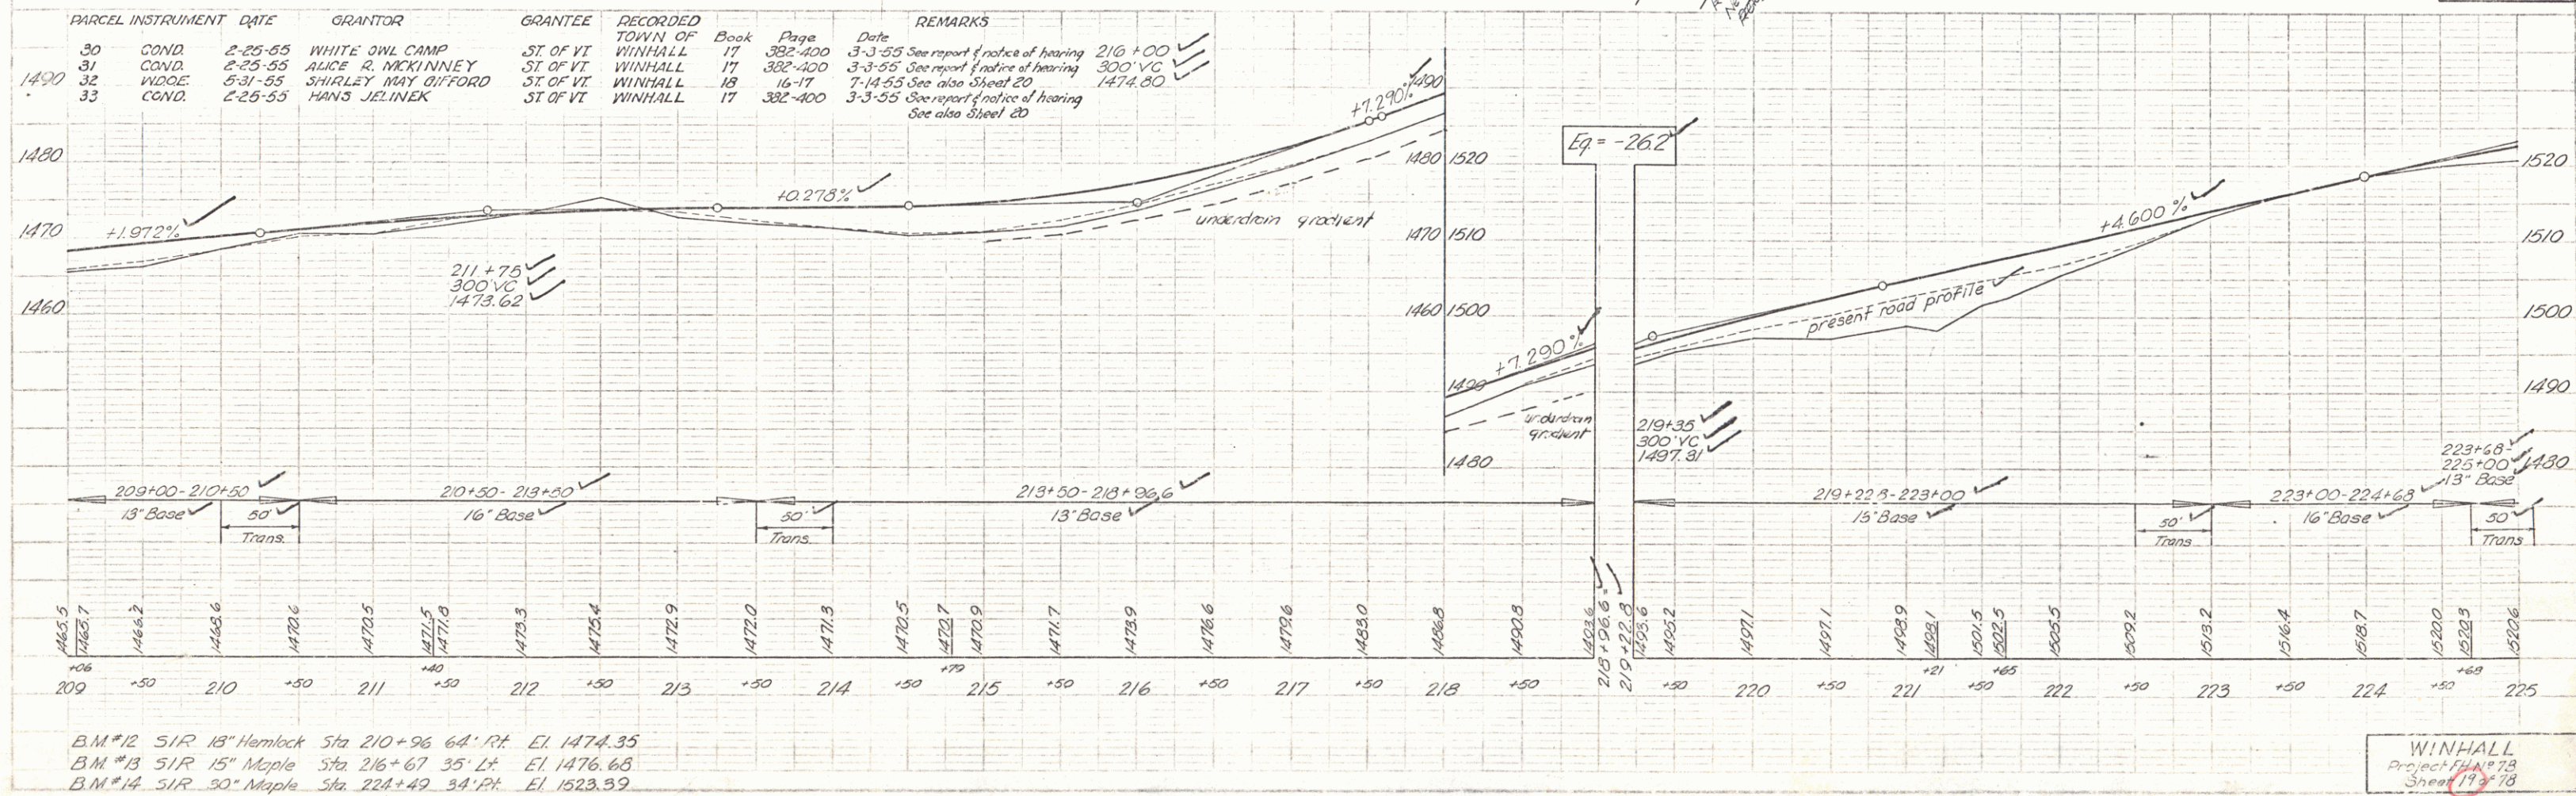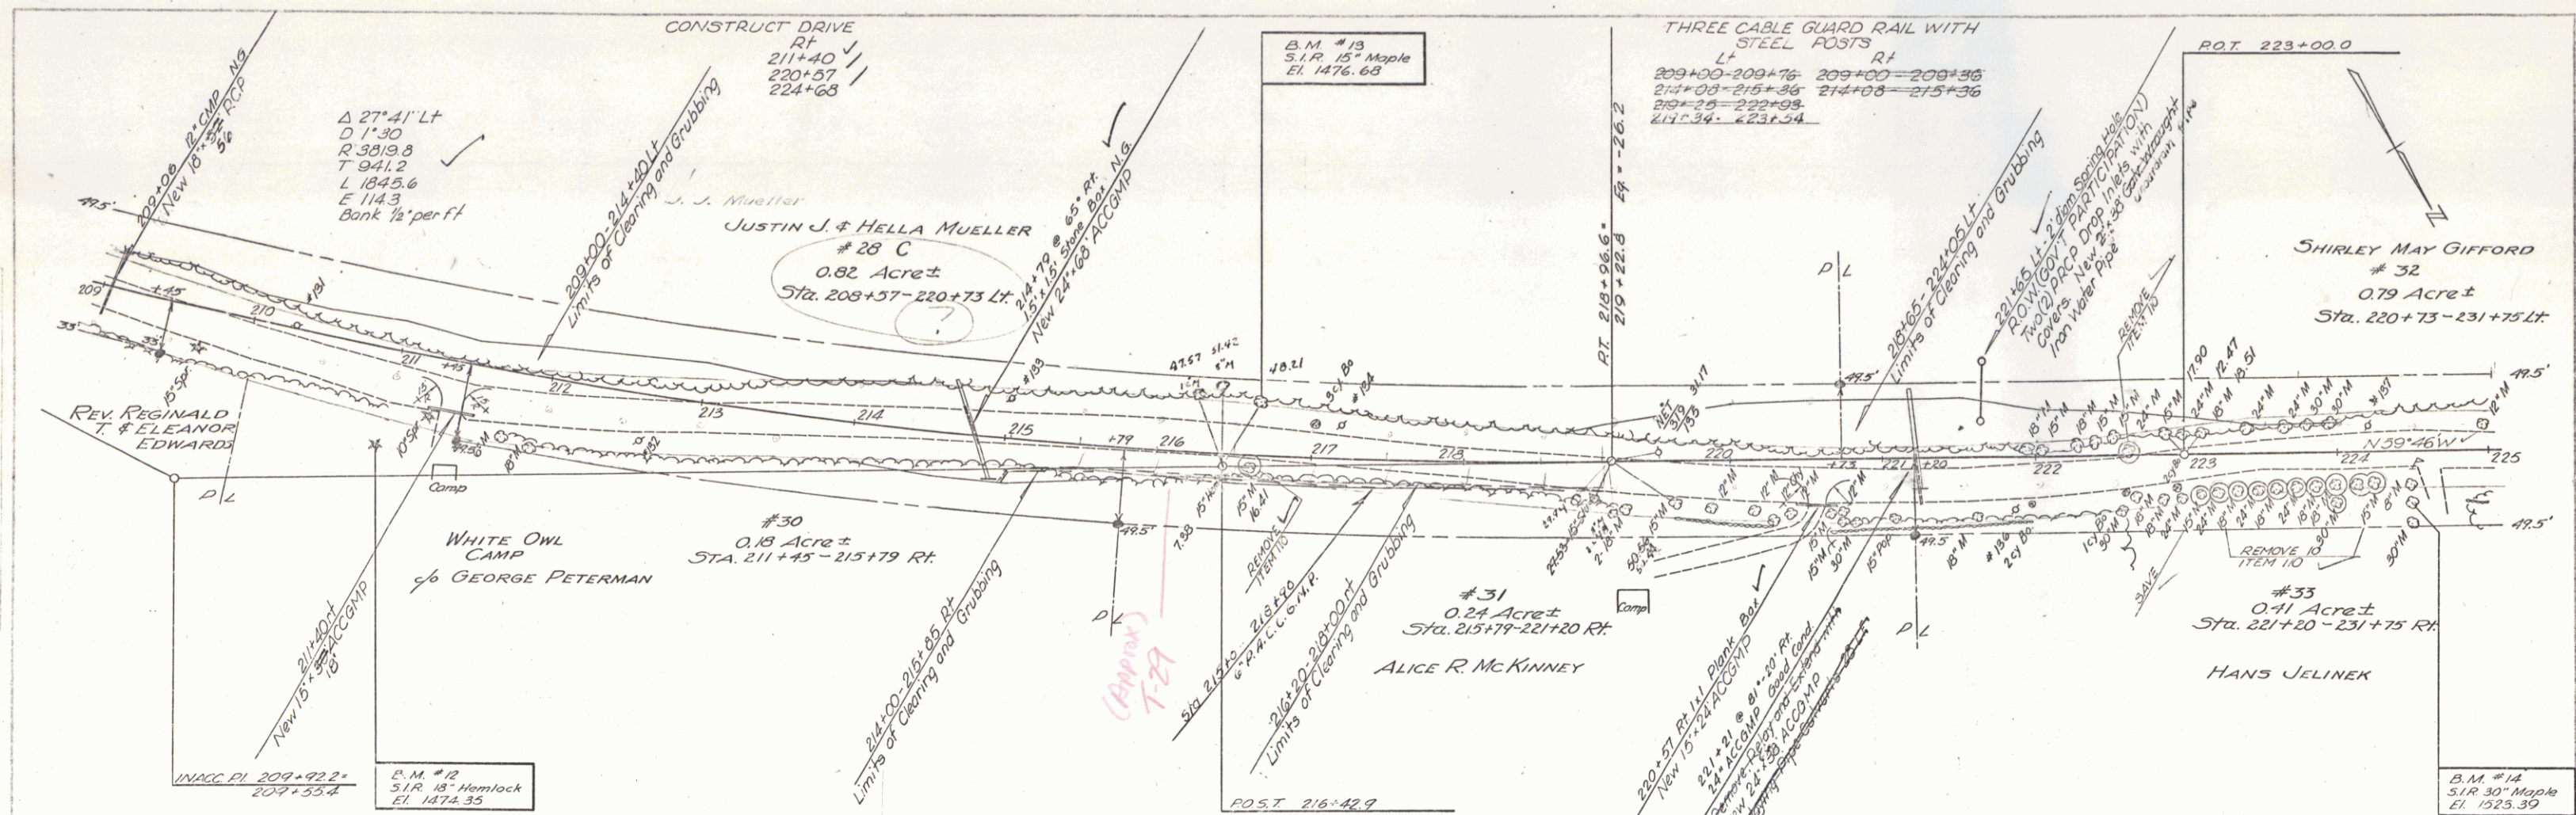

WINHALL
Project File #78
Sheet 19 of 78

