


Transit	Kind	Date	Master	Grantor	Book	Page	Date	Consideration
3	Q-D		L.H. Richardson	CVRR	24	398	12/24/09	2252
4	Q-D		Dayton Clark	CVRR	24	397	12/22/09	2005

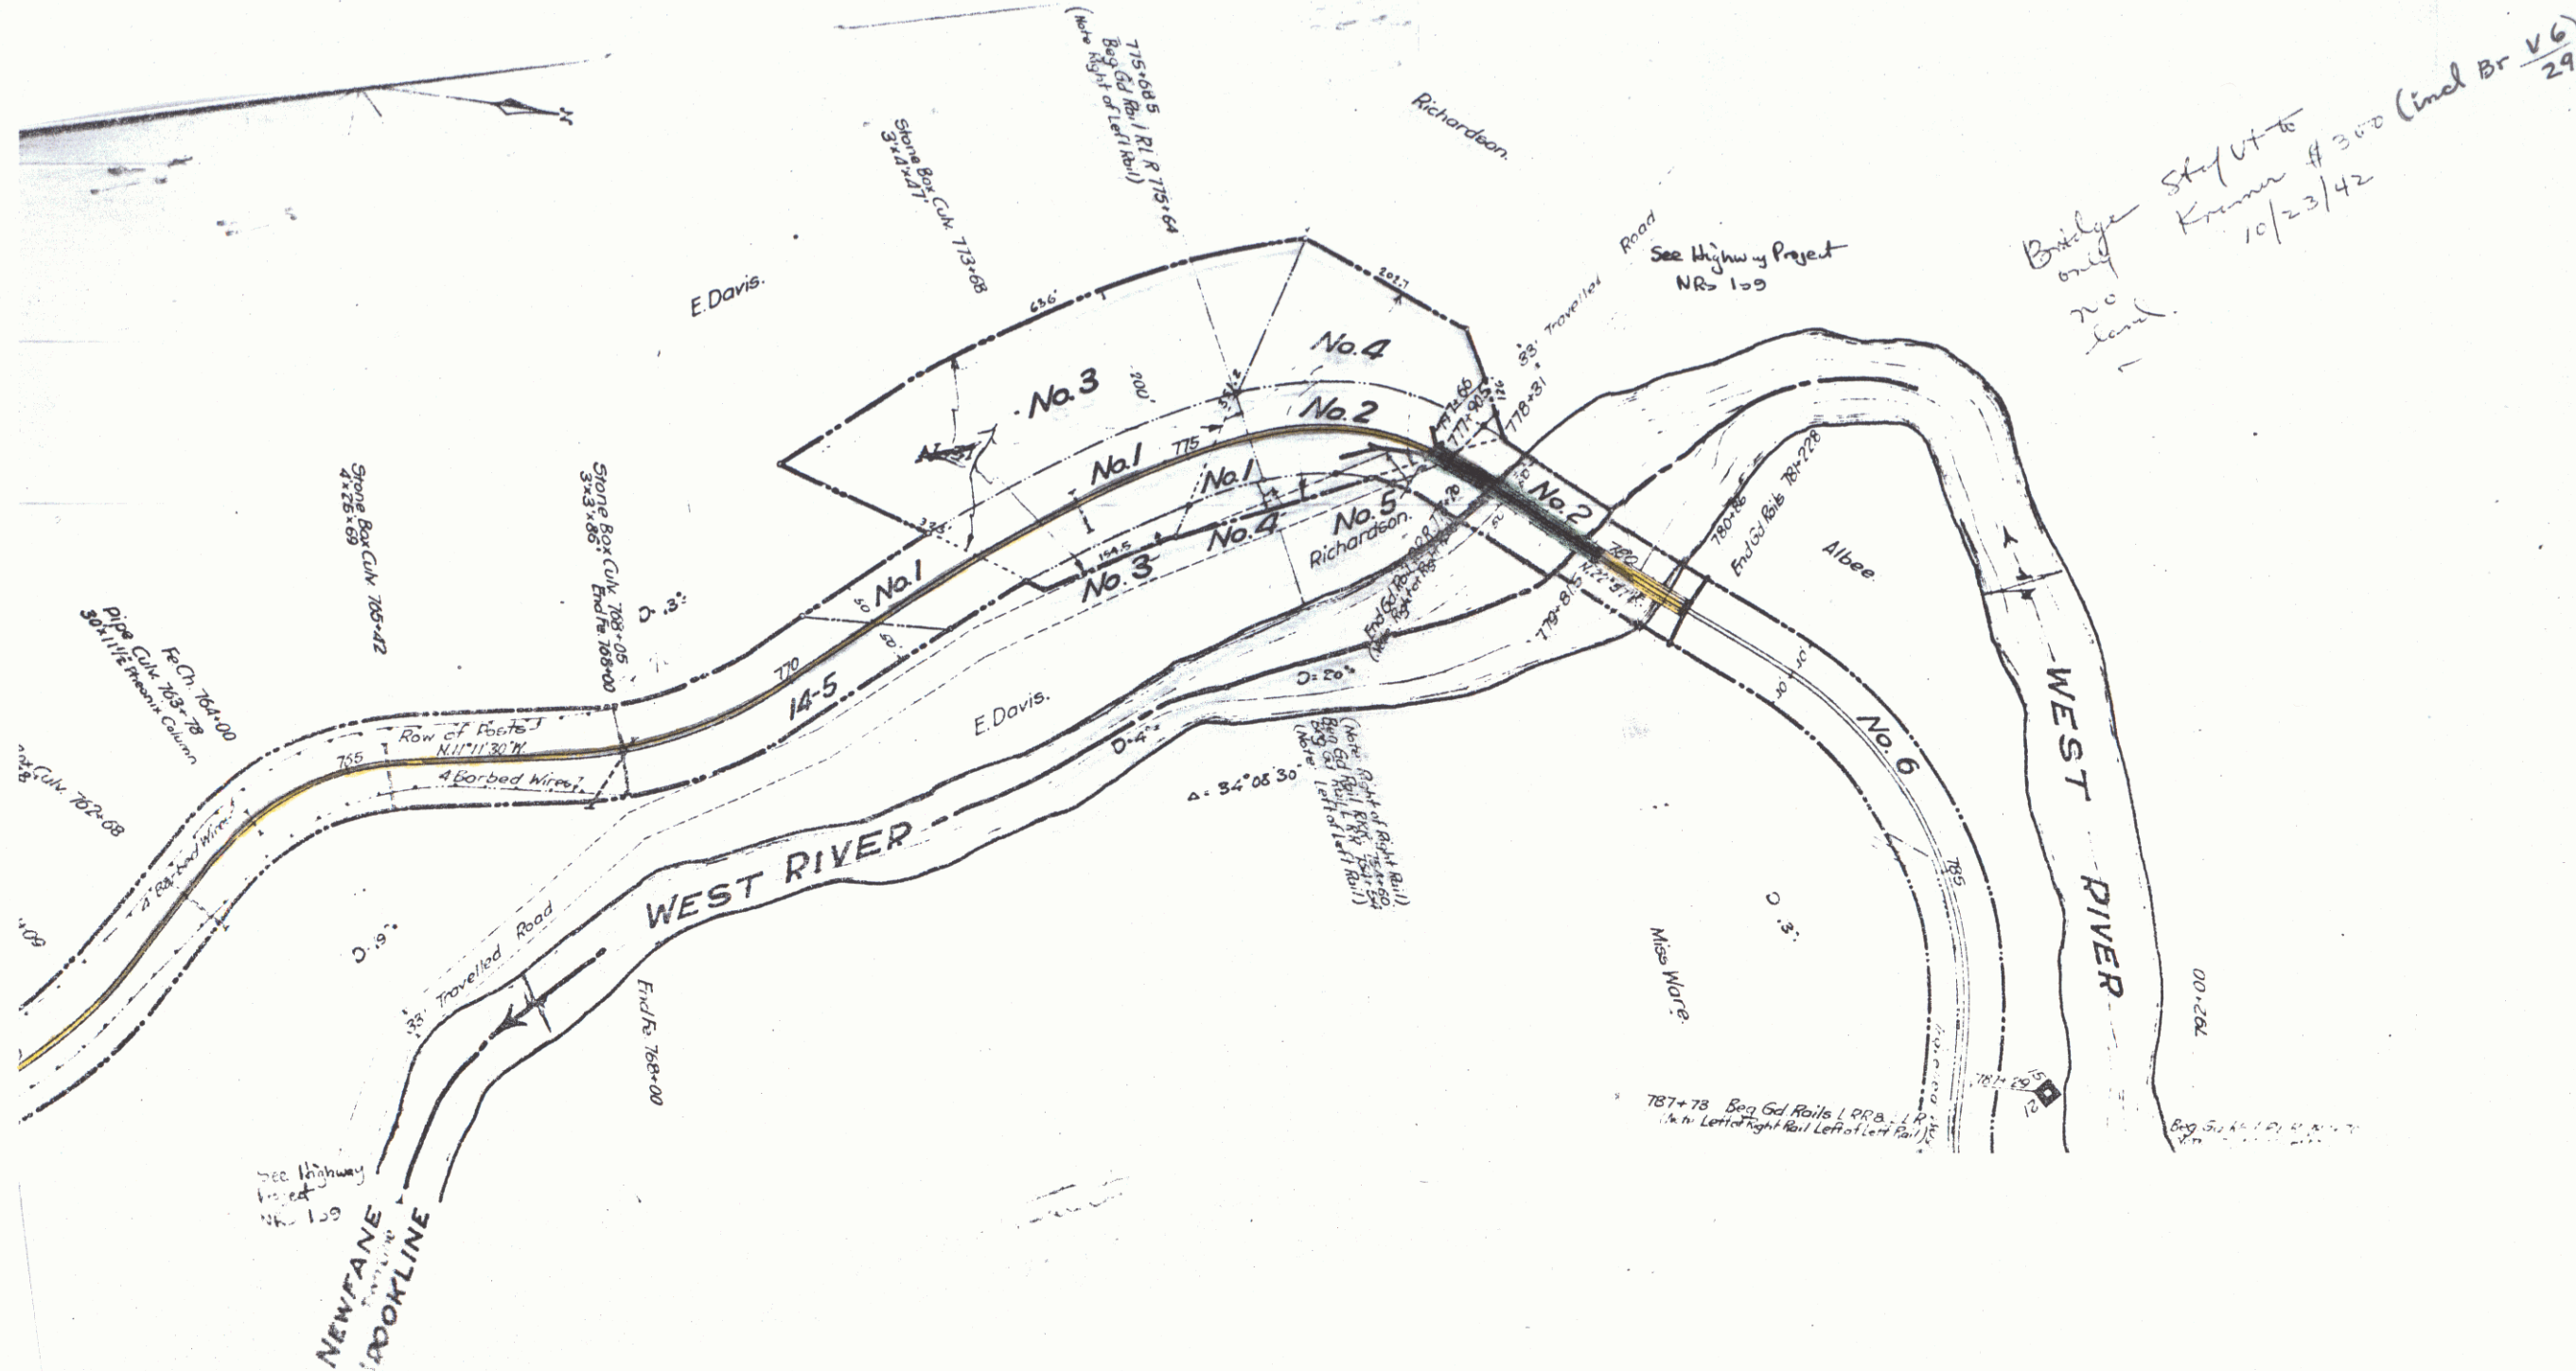

Bridge
 only
 no
 land.
 Stay Vt to
 Krumm #300 (incl Br V6)
 10/23/42

12A