



PLAN
 SCALE
 1" = 100'
 1" = 100'

CHISEL
 15.24
 5.24

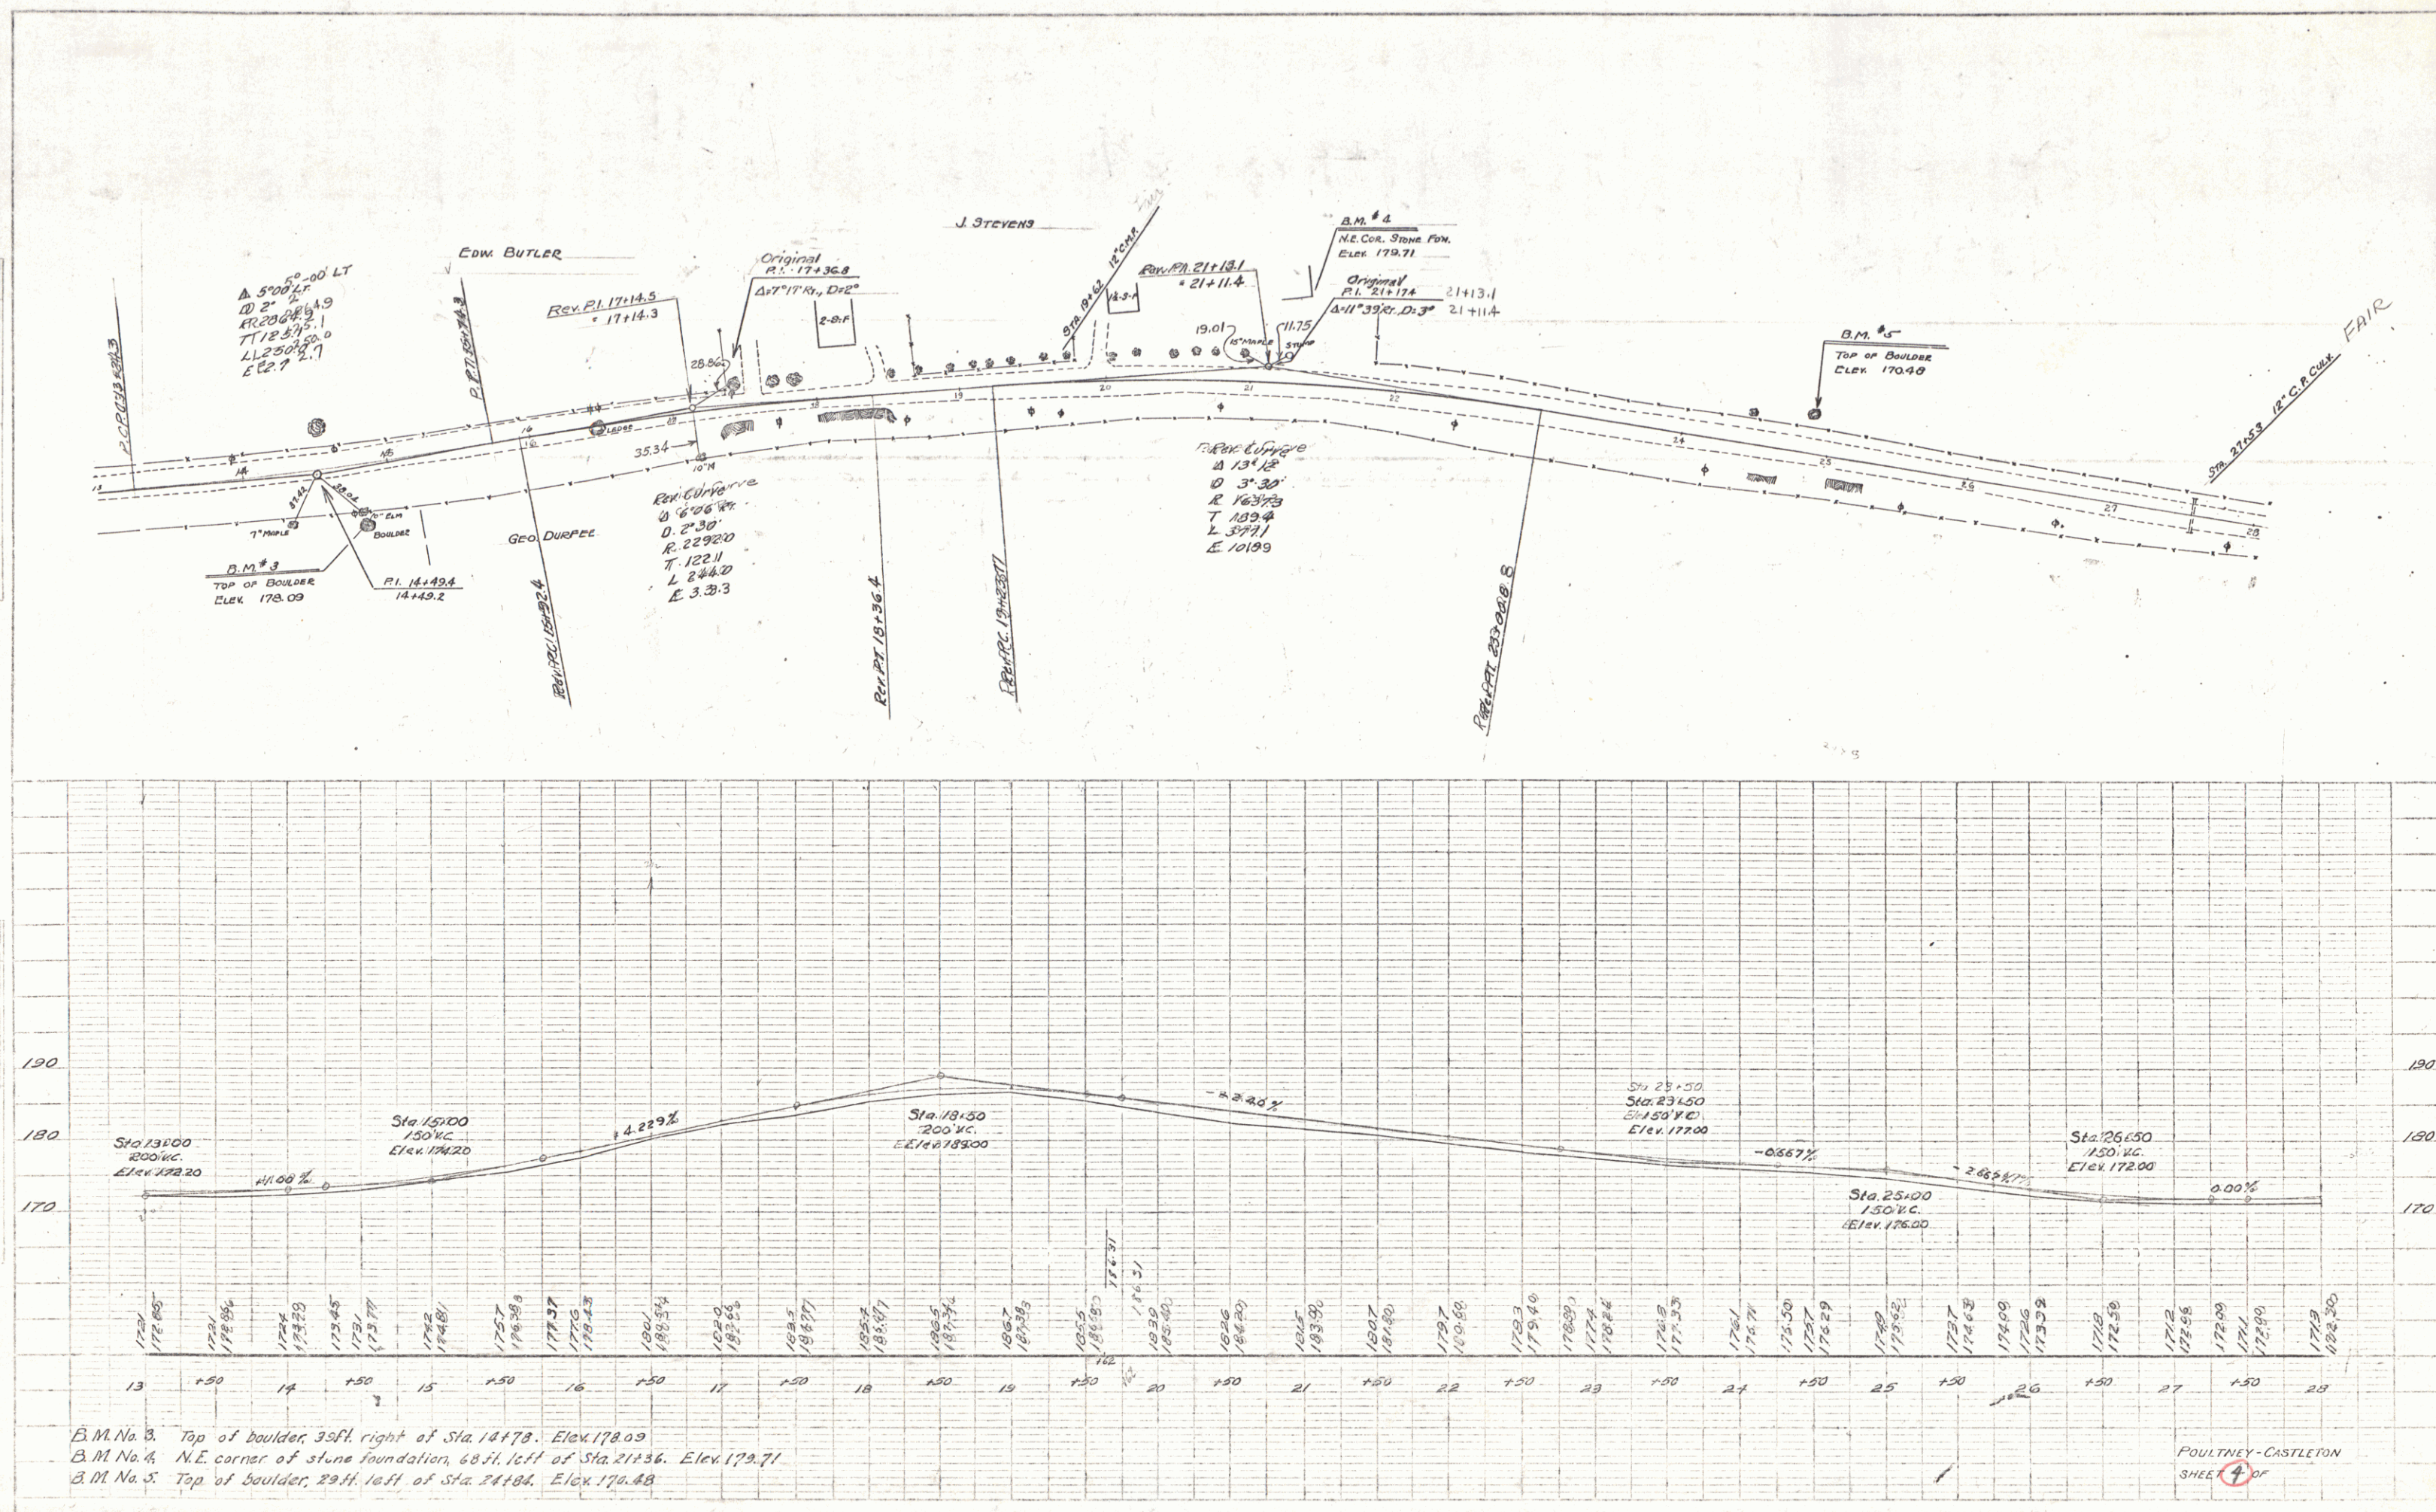


PLAN
 SCALE 1" = 100'
 NOTE: SHOW ALL ADJUSTMENTS
 DATE OF WAY CHECKED
 BY

PROFILE
 SCALE 1" = 10'
 DATE OF WAY CHECKED
 BY

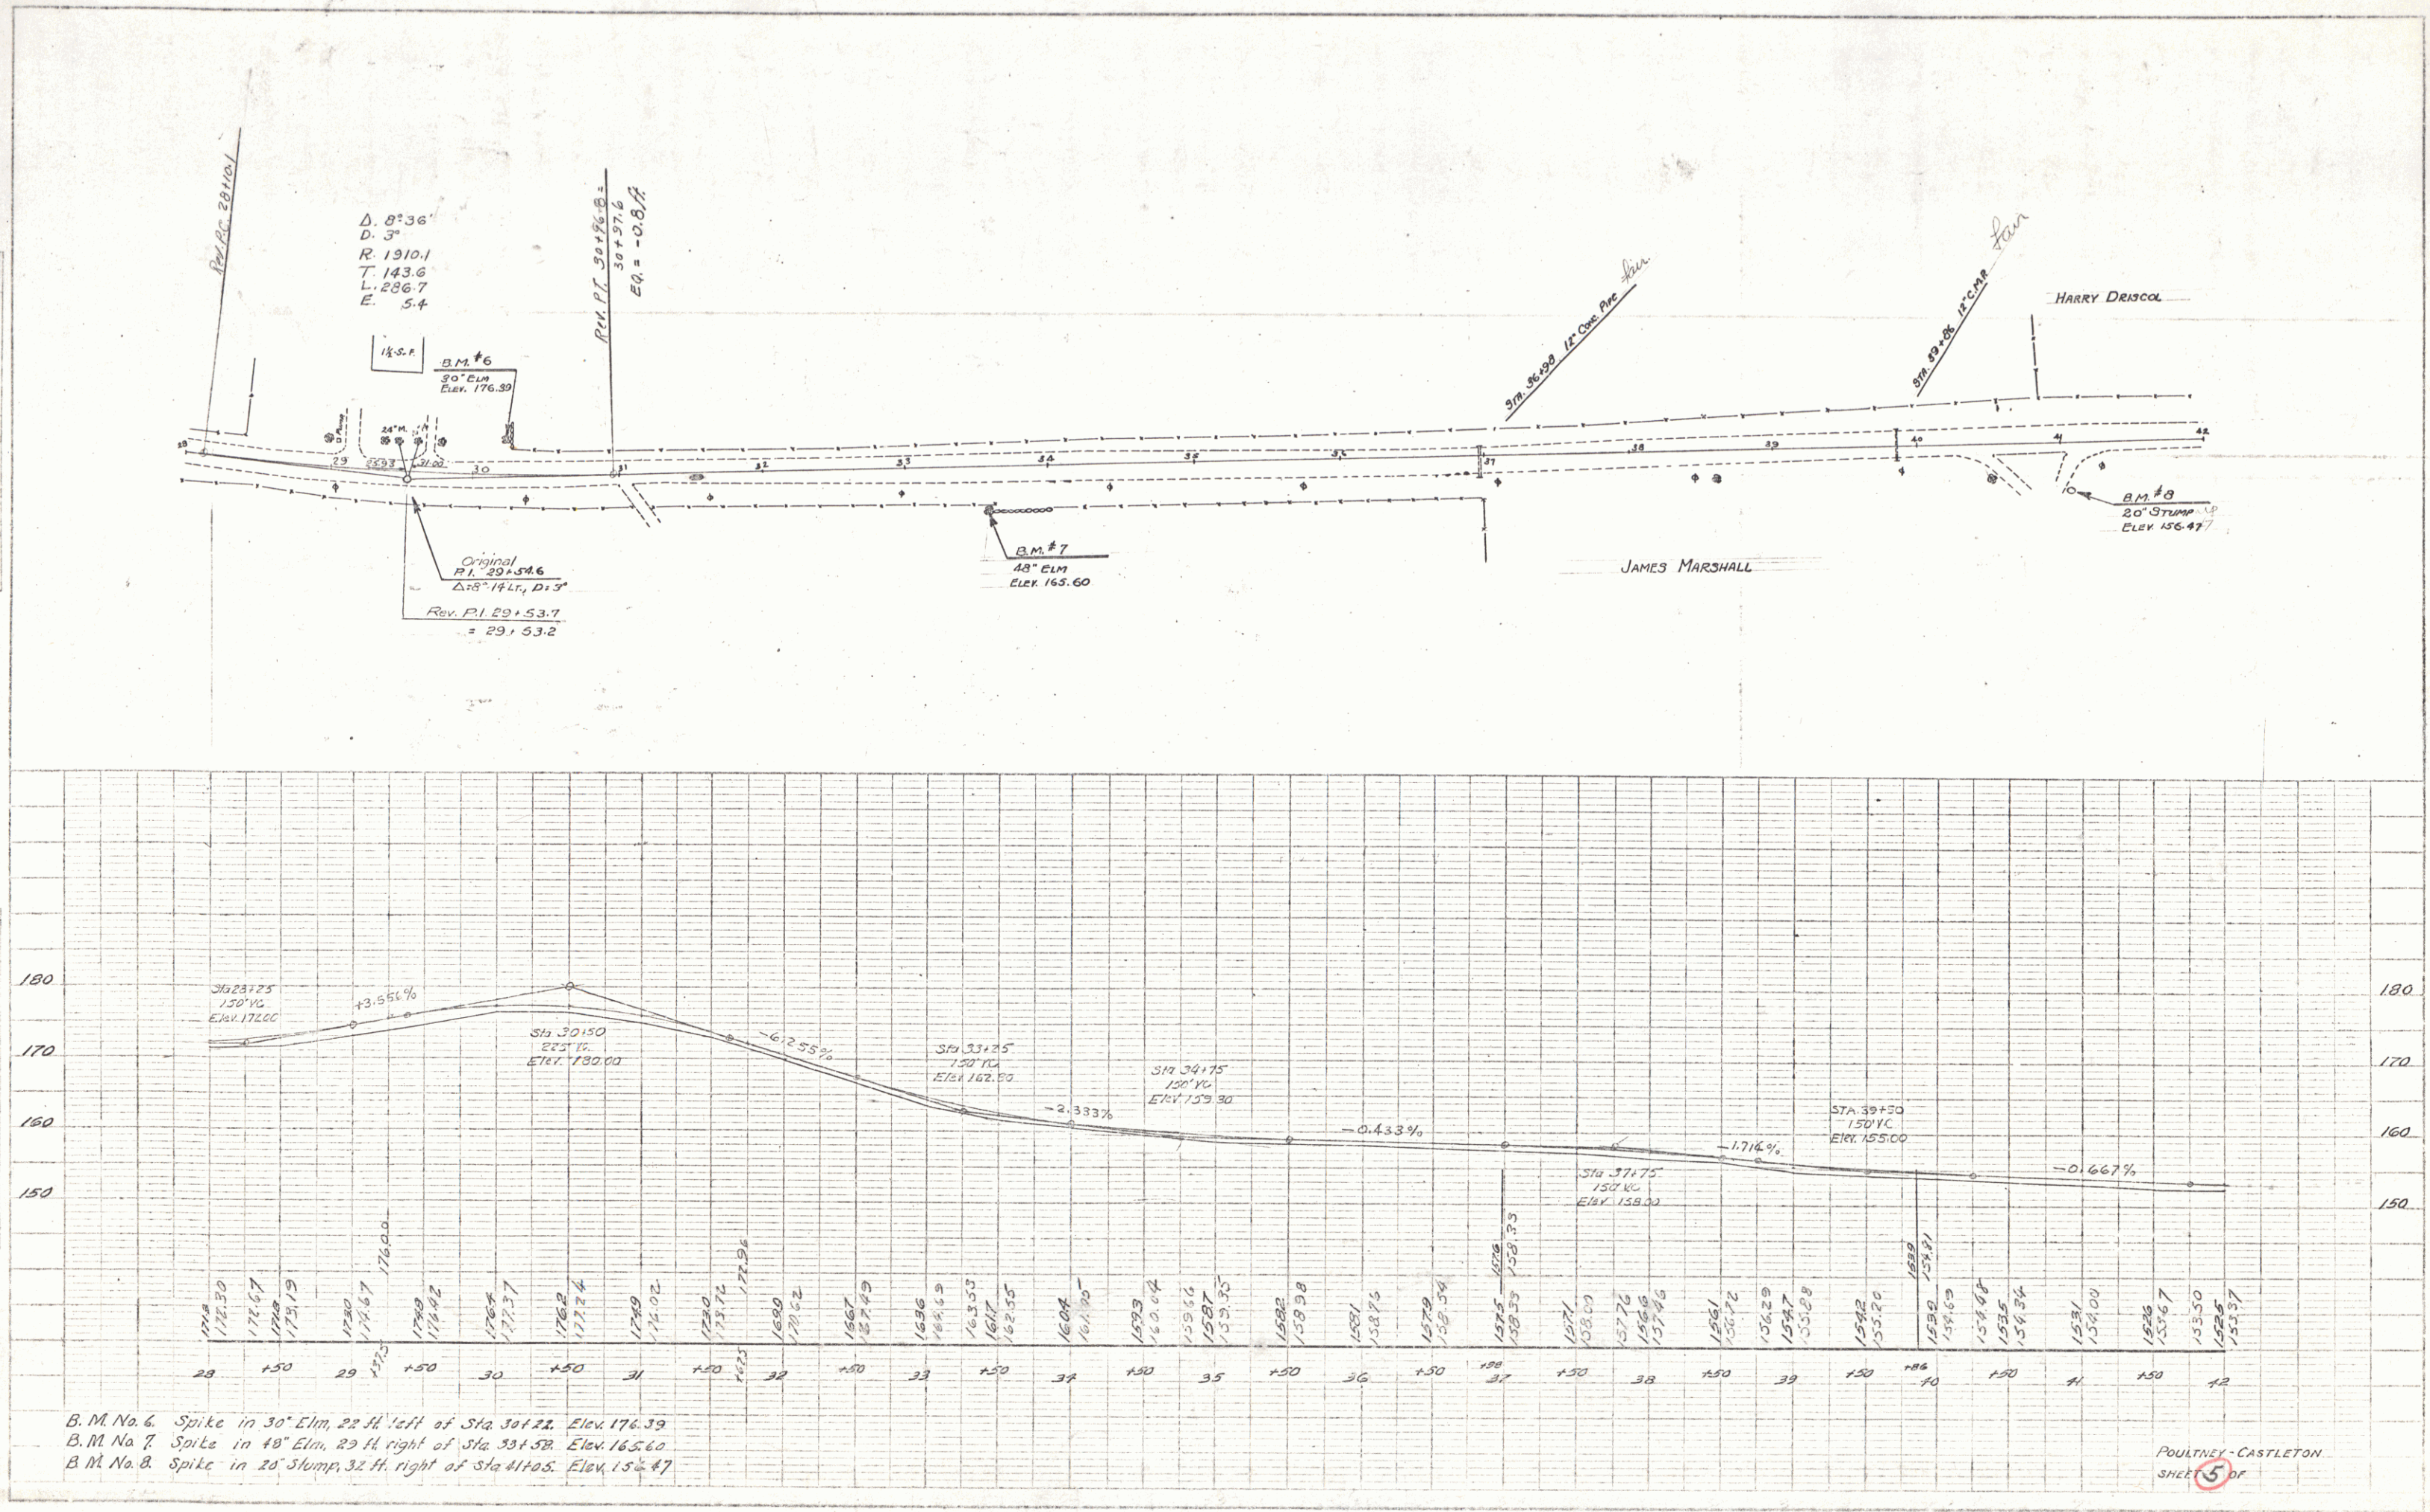


PLAN
 REVISIONS
 NO. 1
 DATE
 BY
 CHECKED
 DATE
 BY

PROFILE
 REVISIONS
 NO. 1
 DATE
 BY
 CHECKED
 DATE
 BY

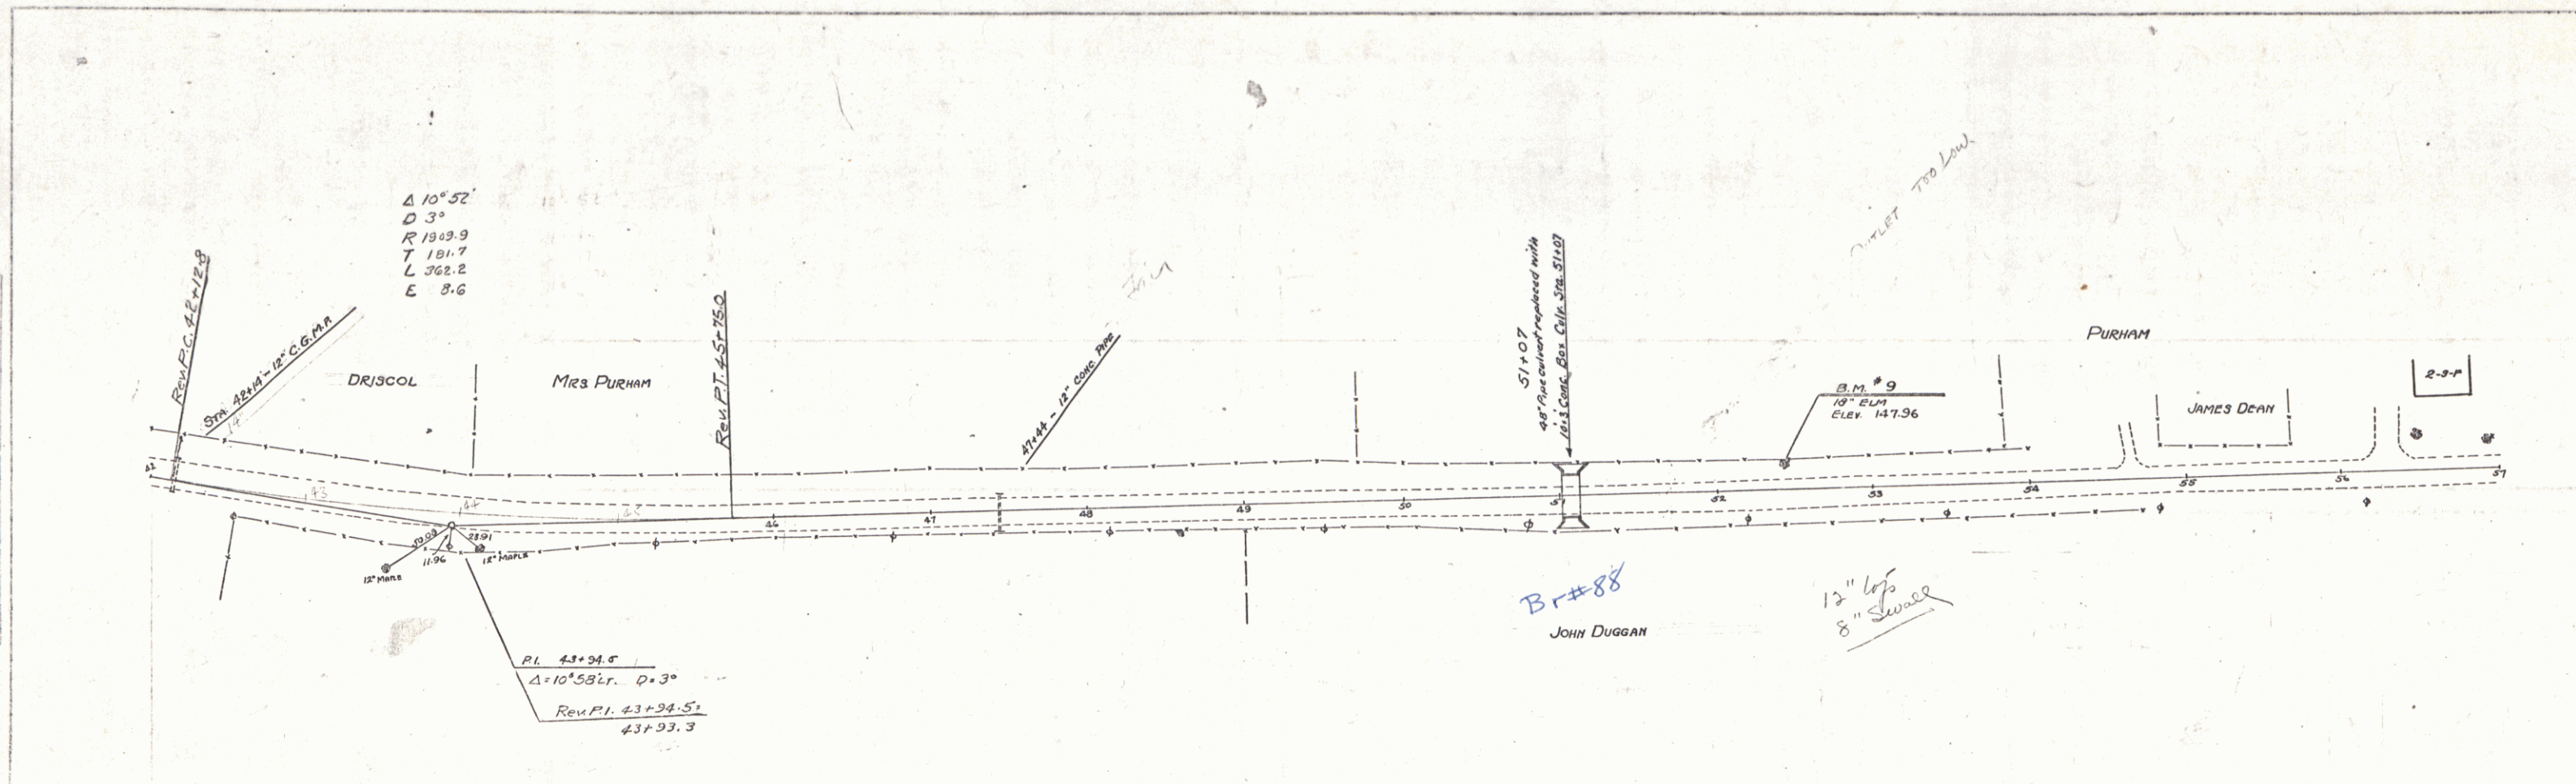

BRIDGE AT STA. 51+07

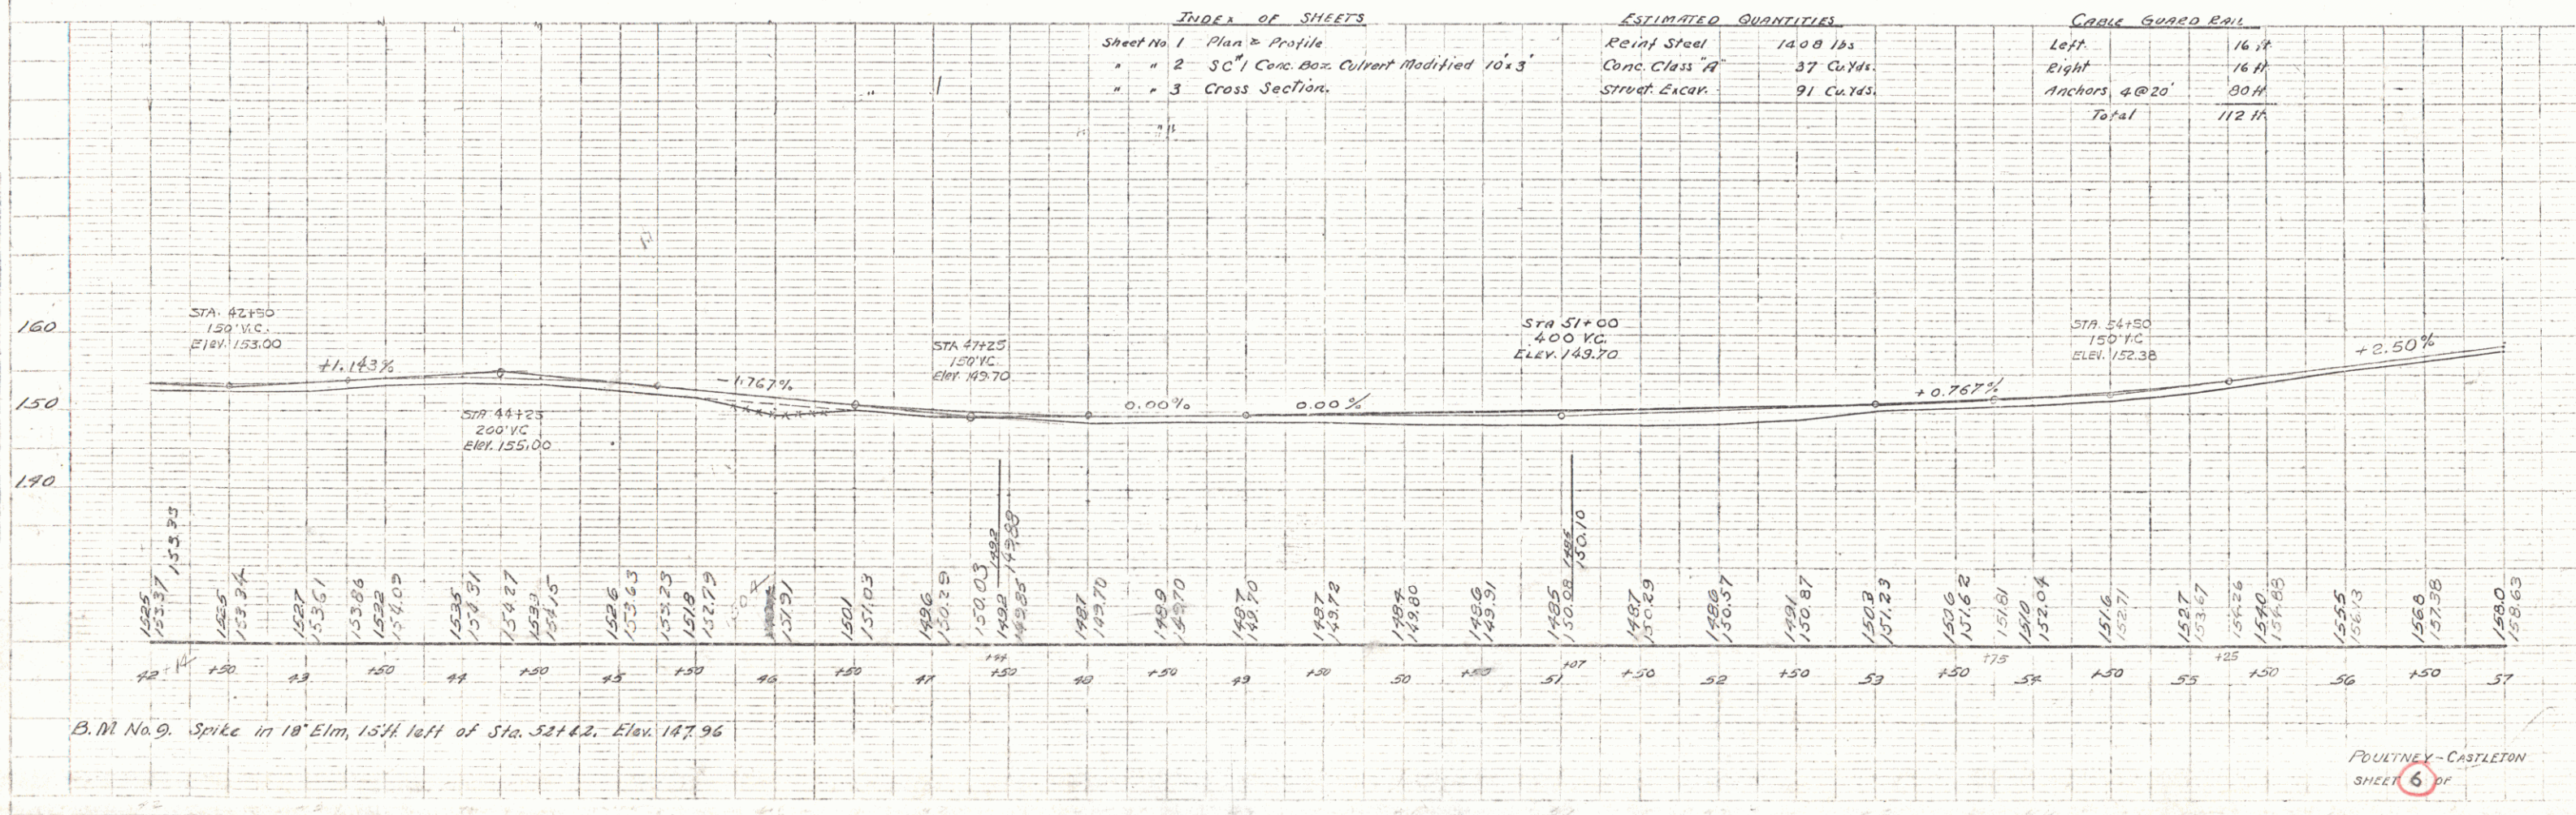

B.M. No. 9, Spike in 10' Elm, 15' left of Sta. 52+42, Elev. 147.96

INDEX OF SHEETS

Sheet No.	Description
1	Plan & Profile
2	SC 1 Conc. Box Culvert Modified 10' x 3'
3	Cross Section

ESTIMATED QUANTITIES

Item	Quantity
Reinf. Steel	1408 lbs.
Conc. Class "A"	37 Cu. Yds.
Struct. Excav.	91 Cu. Yds.


CABLE GUARD RAIL

Side	Length
Left	16 ft.
Right	16 ft.
Anchors 4 @ 20'	80 ft.
Total	112 ft.


POULTNEY - CASTLETON
SHEET 6 OF 6

PLAN	DATE	BY	CHECKED
1/27/24	1/27/24	1/27/24	1/27/24
1/27/24	1/27/24	1/27/24	1/27/24
1/27/24	1/27/24	1/27/24	1/27/24

PROFILE	DATE	BY	CHECKED
1/27/24	1/27/24	1/27/24	1/27/24
1/27/24	1/27/24	1/27/24	1/27/24
1/27/24	1/27/24	1/27/24	1/27/24

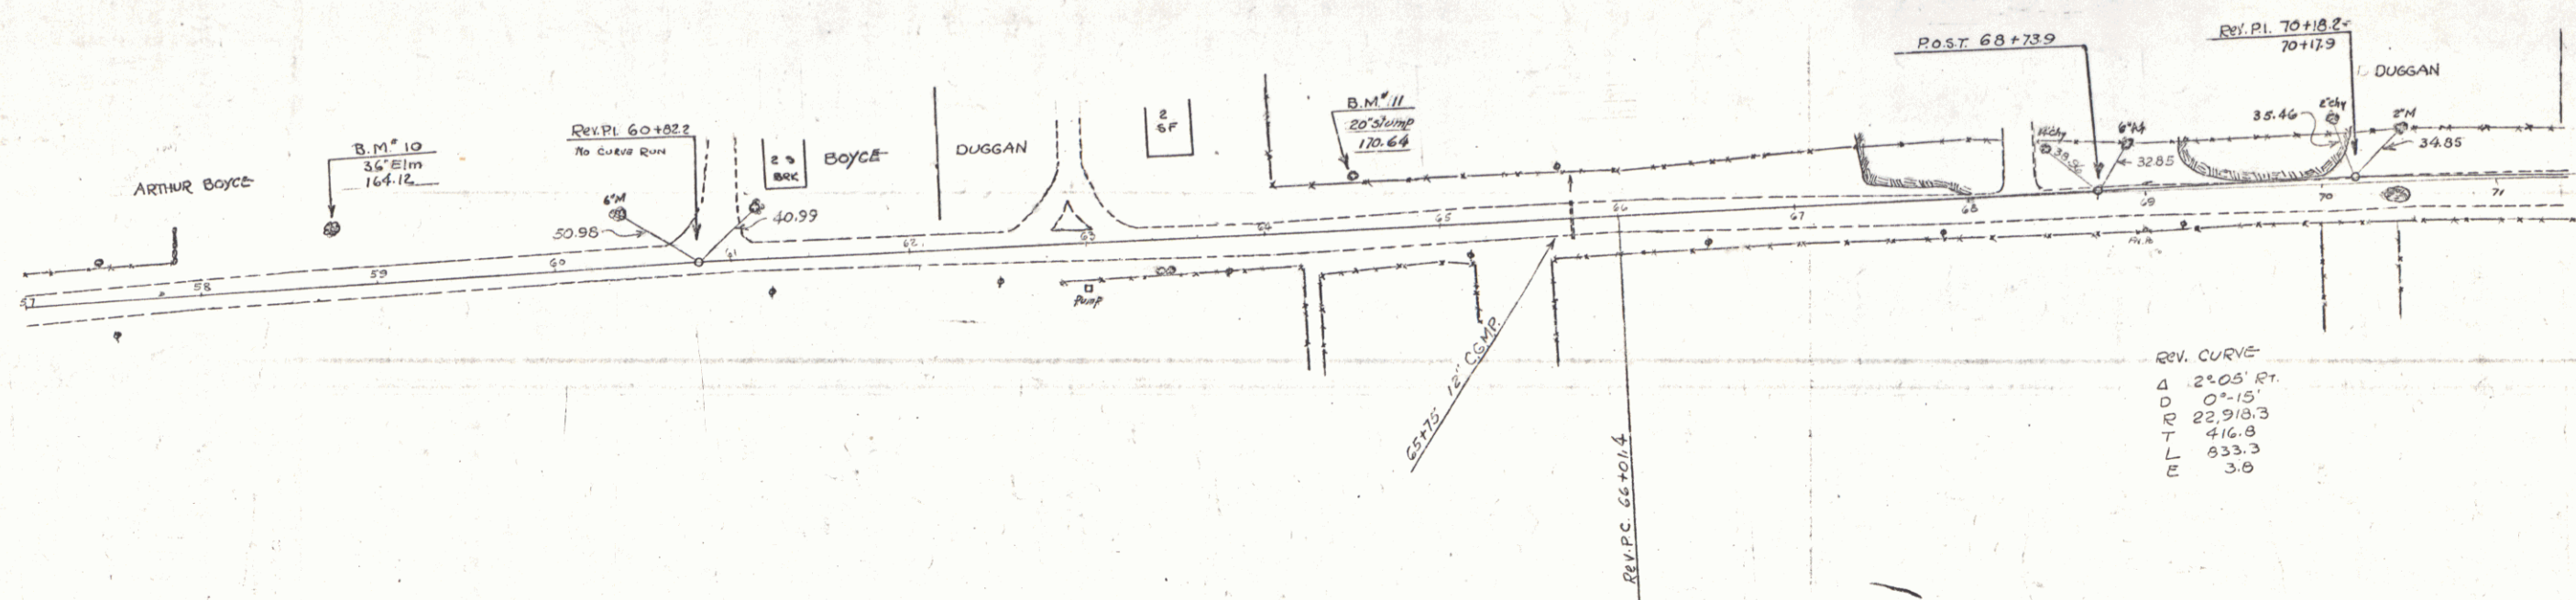

REV. CURVE	
Δ	2° 05' R.
D	0° 15'
R	22,918.3
L	416.8
E	833.3
	3.8

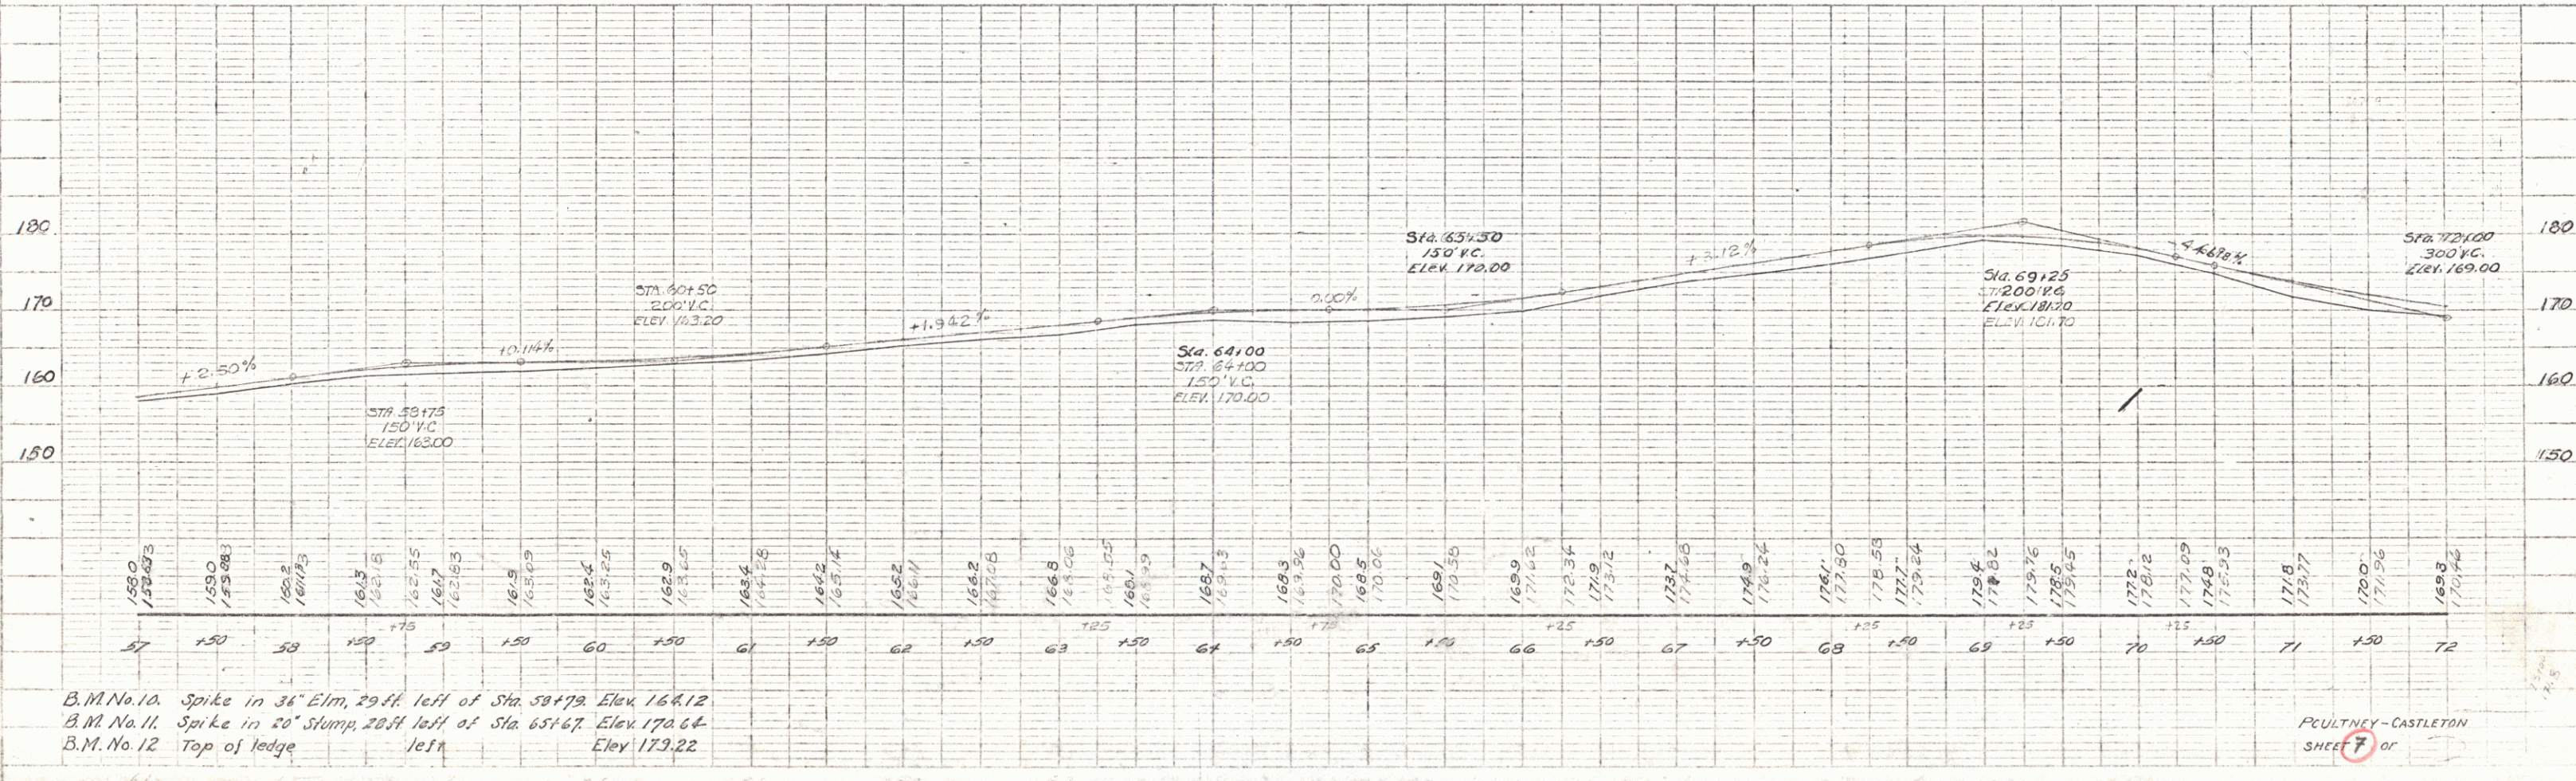

B.M. No. 10. Spike in 34 Elm, 29th left of Sta. 58+79. Elev. 164.12
 B.M. No. 11. Spike in 20 Slump, 20th left of Sta. 65+67. Elev. 170.64
 B.M. No. 12. Top of ledge left. Elev. 173.22

PCULTNEY-CASTLETON
 SHEET 7 OF

PLAN	SECTION	REVISION
1	1	1
2	2	2
3	3	3
4	4	4
5	5	5
6	6	6
7	7	7
8	8	8
9	9	9
10	10	10

SECTION	REVISION
1	1
2	2
3	3
4	4
5	5
6	6
7	7
8	8
9	9
10	10


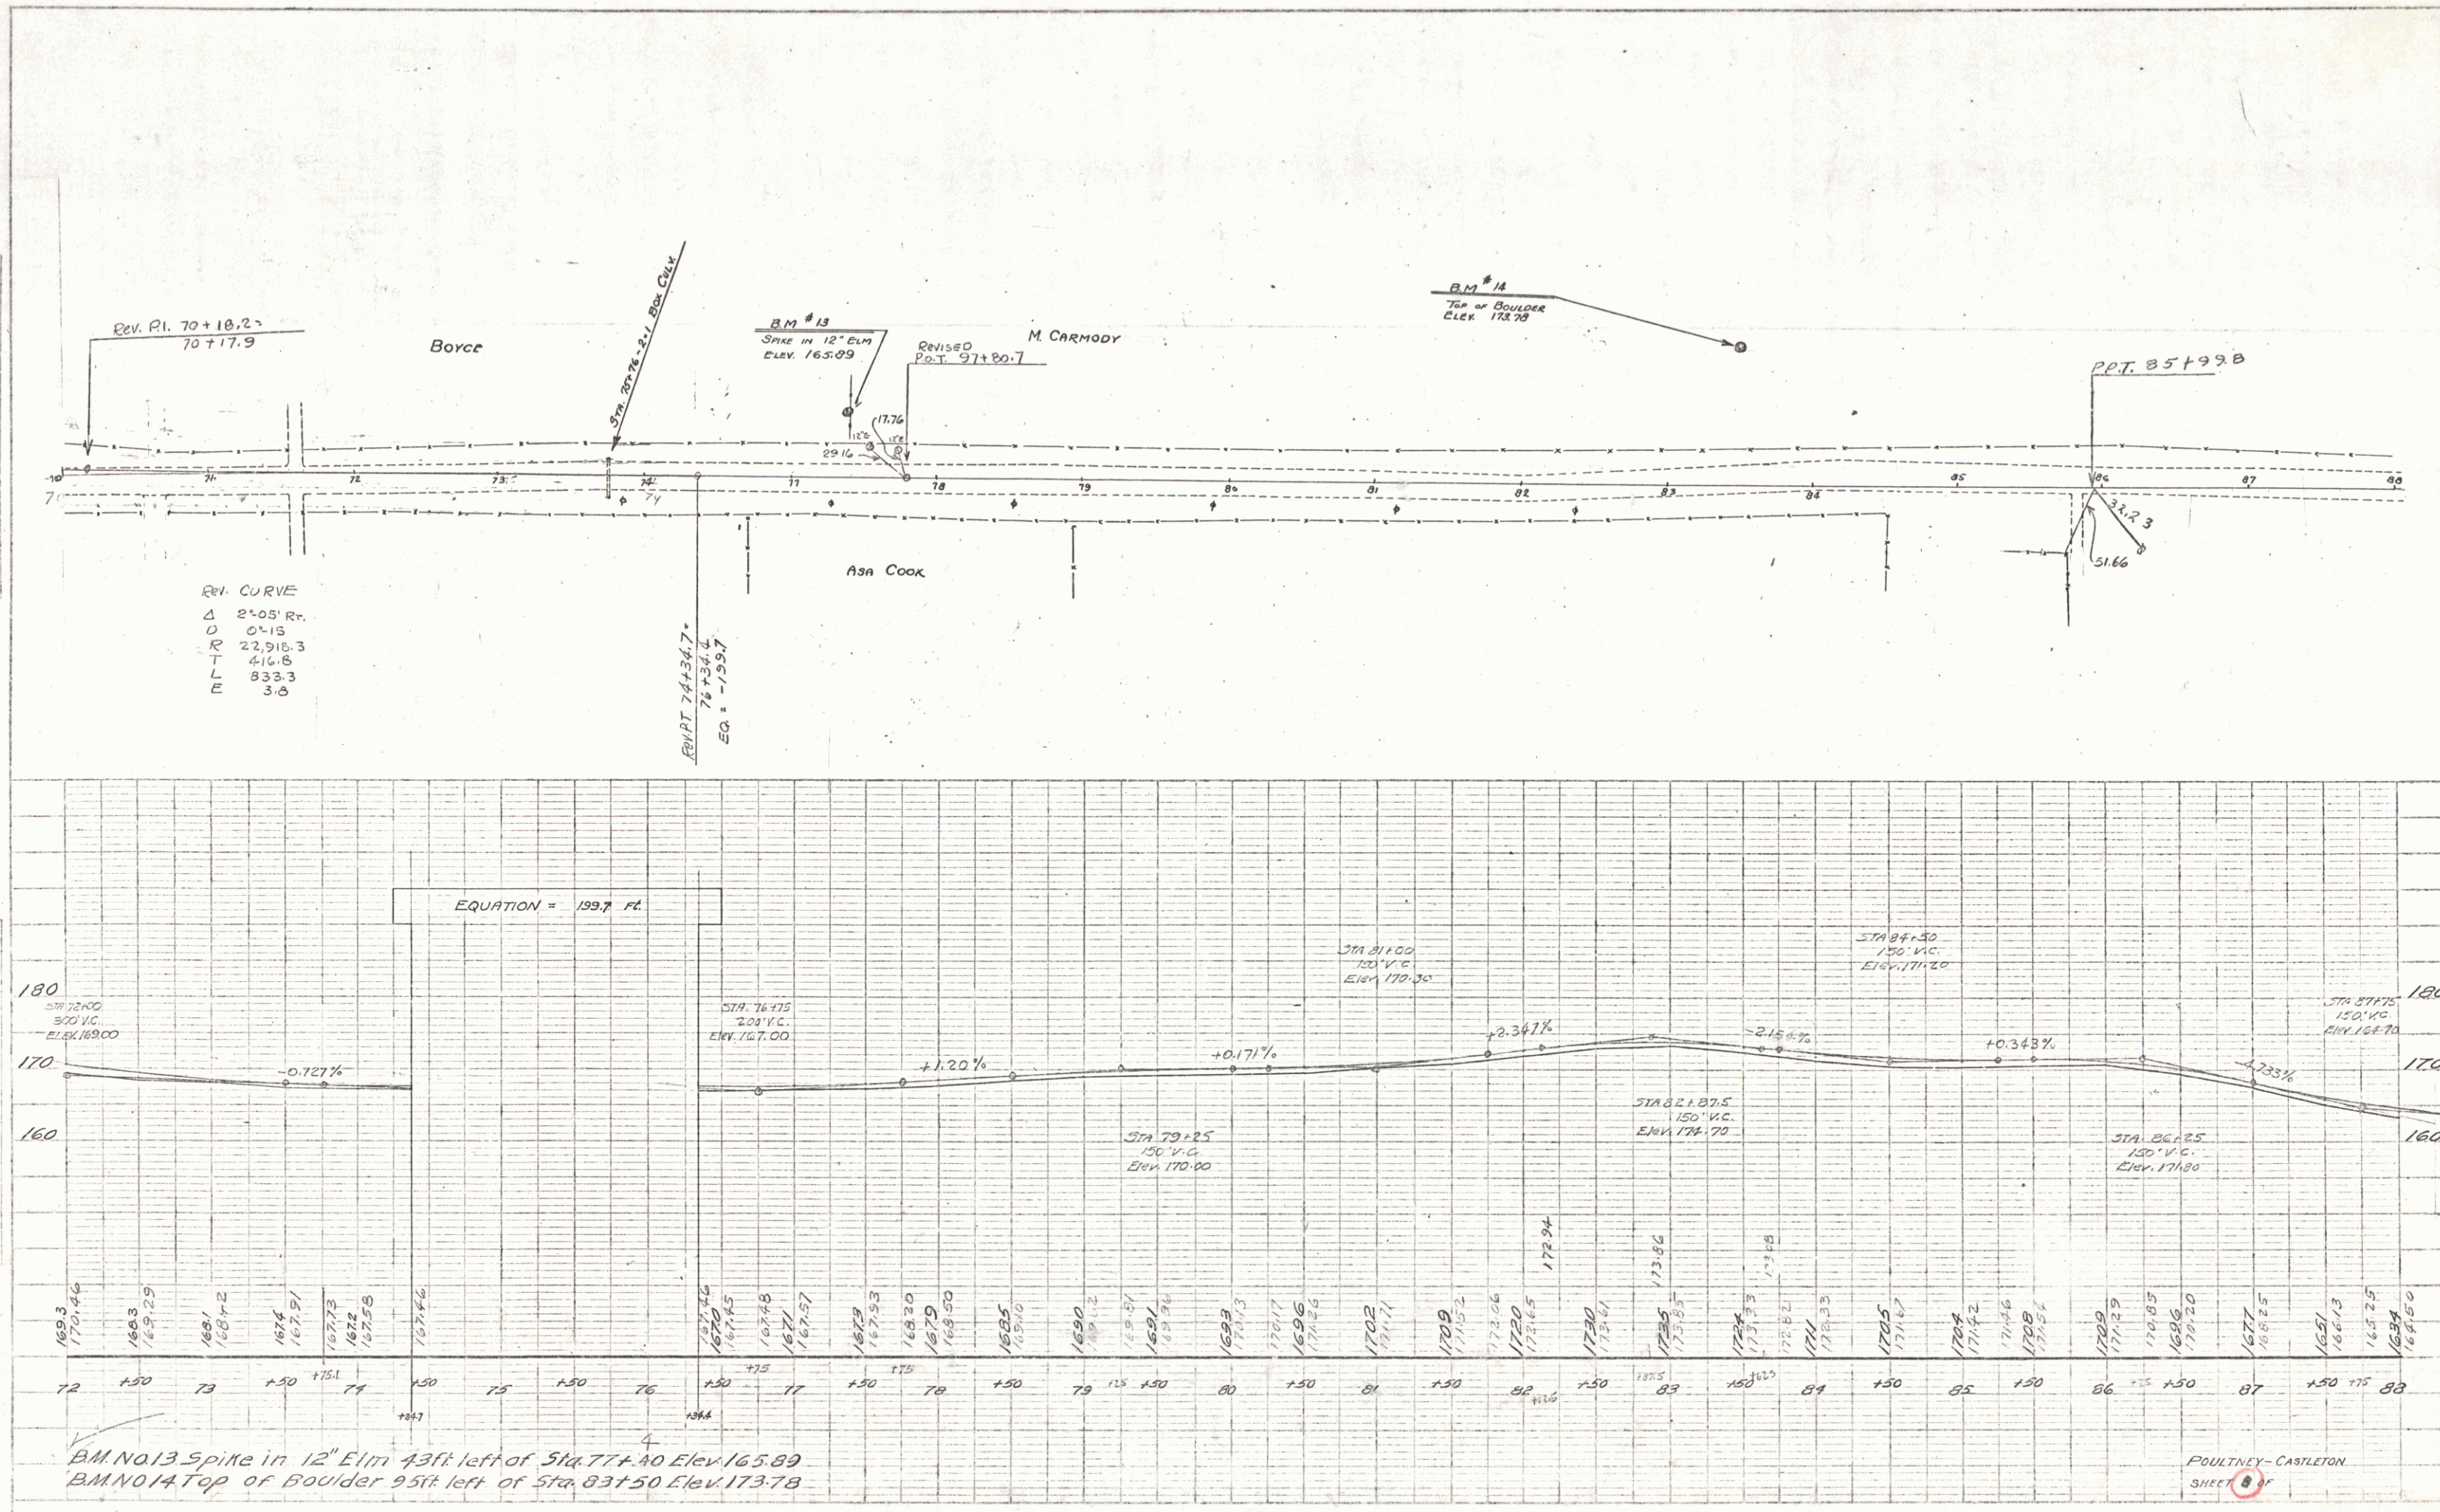


PLATE 10 FOUR-PROFILE WITH A AND B VIEWS
SCALE 1" = 100' HORIZ. 1" = 10' VERT.


PLAN	NOTES
DATE	NO. OF SHEETS
BY	DATE
CHECKED	BY
APPROVED	DATE

5000'	150'
1000'	300'
1500'	450'
2000'	600'
2500'	750'
3000'	900'
3500'	1050'
4000'	1200'
4500'	1350'
5000'	1500'

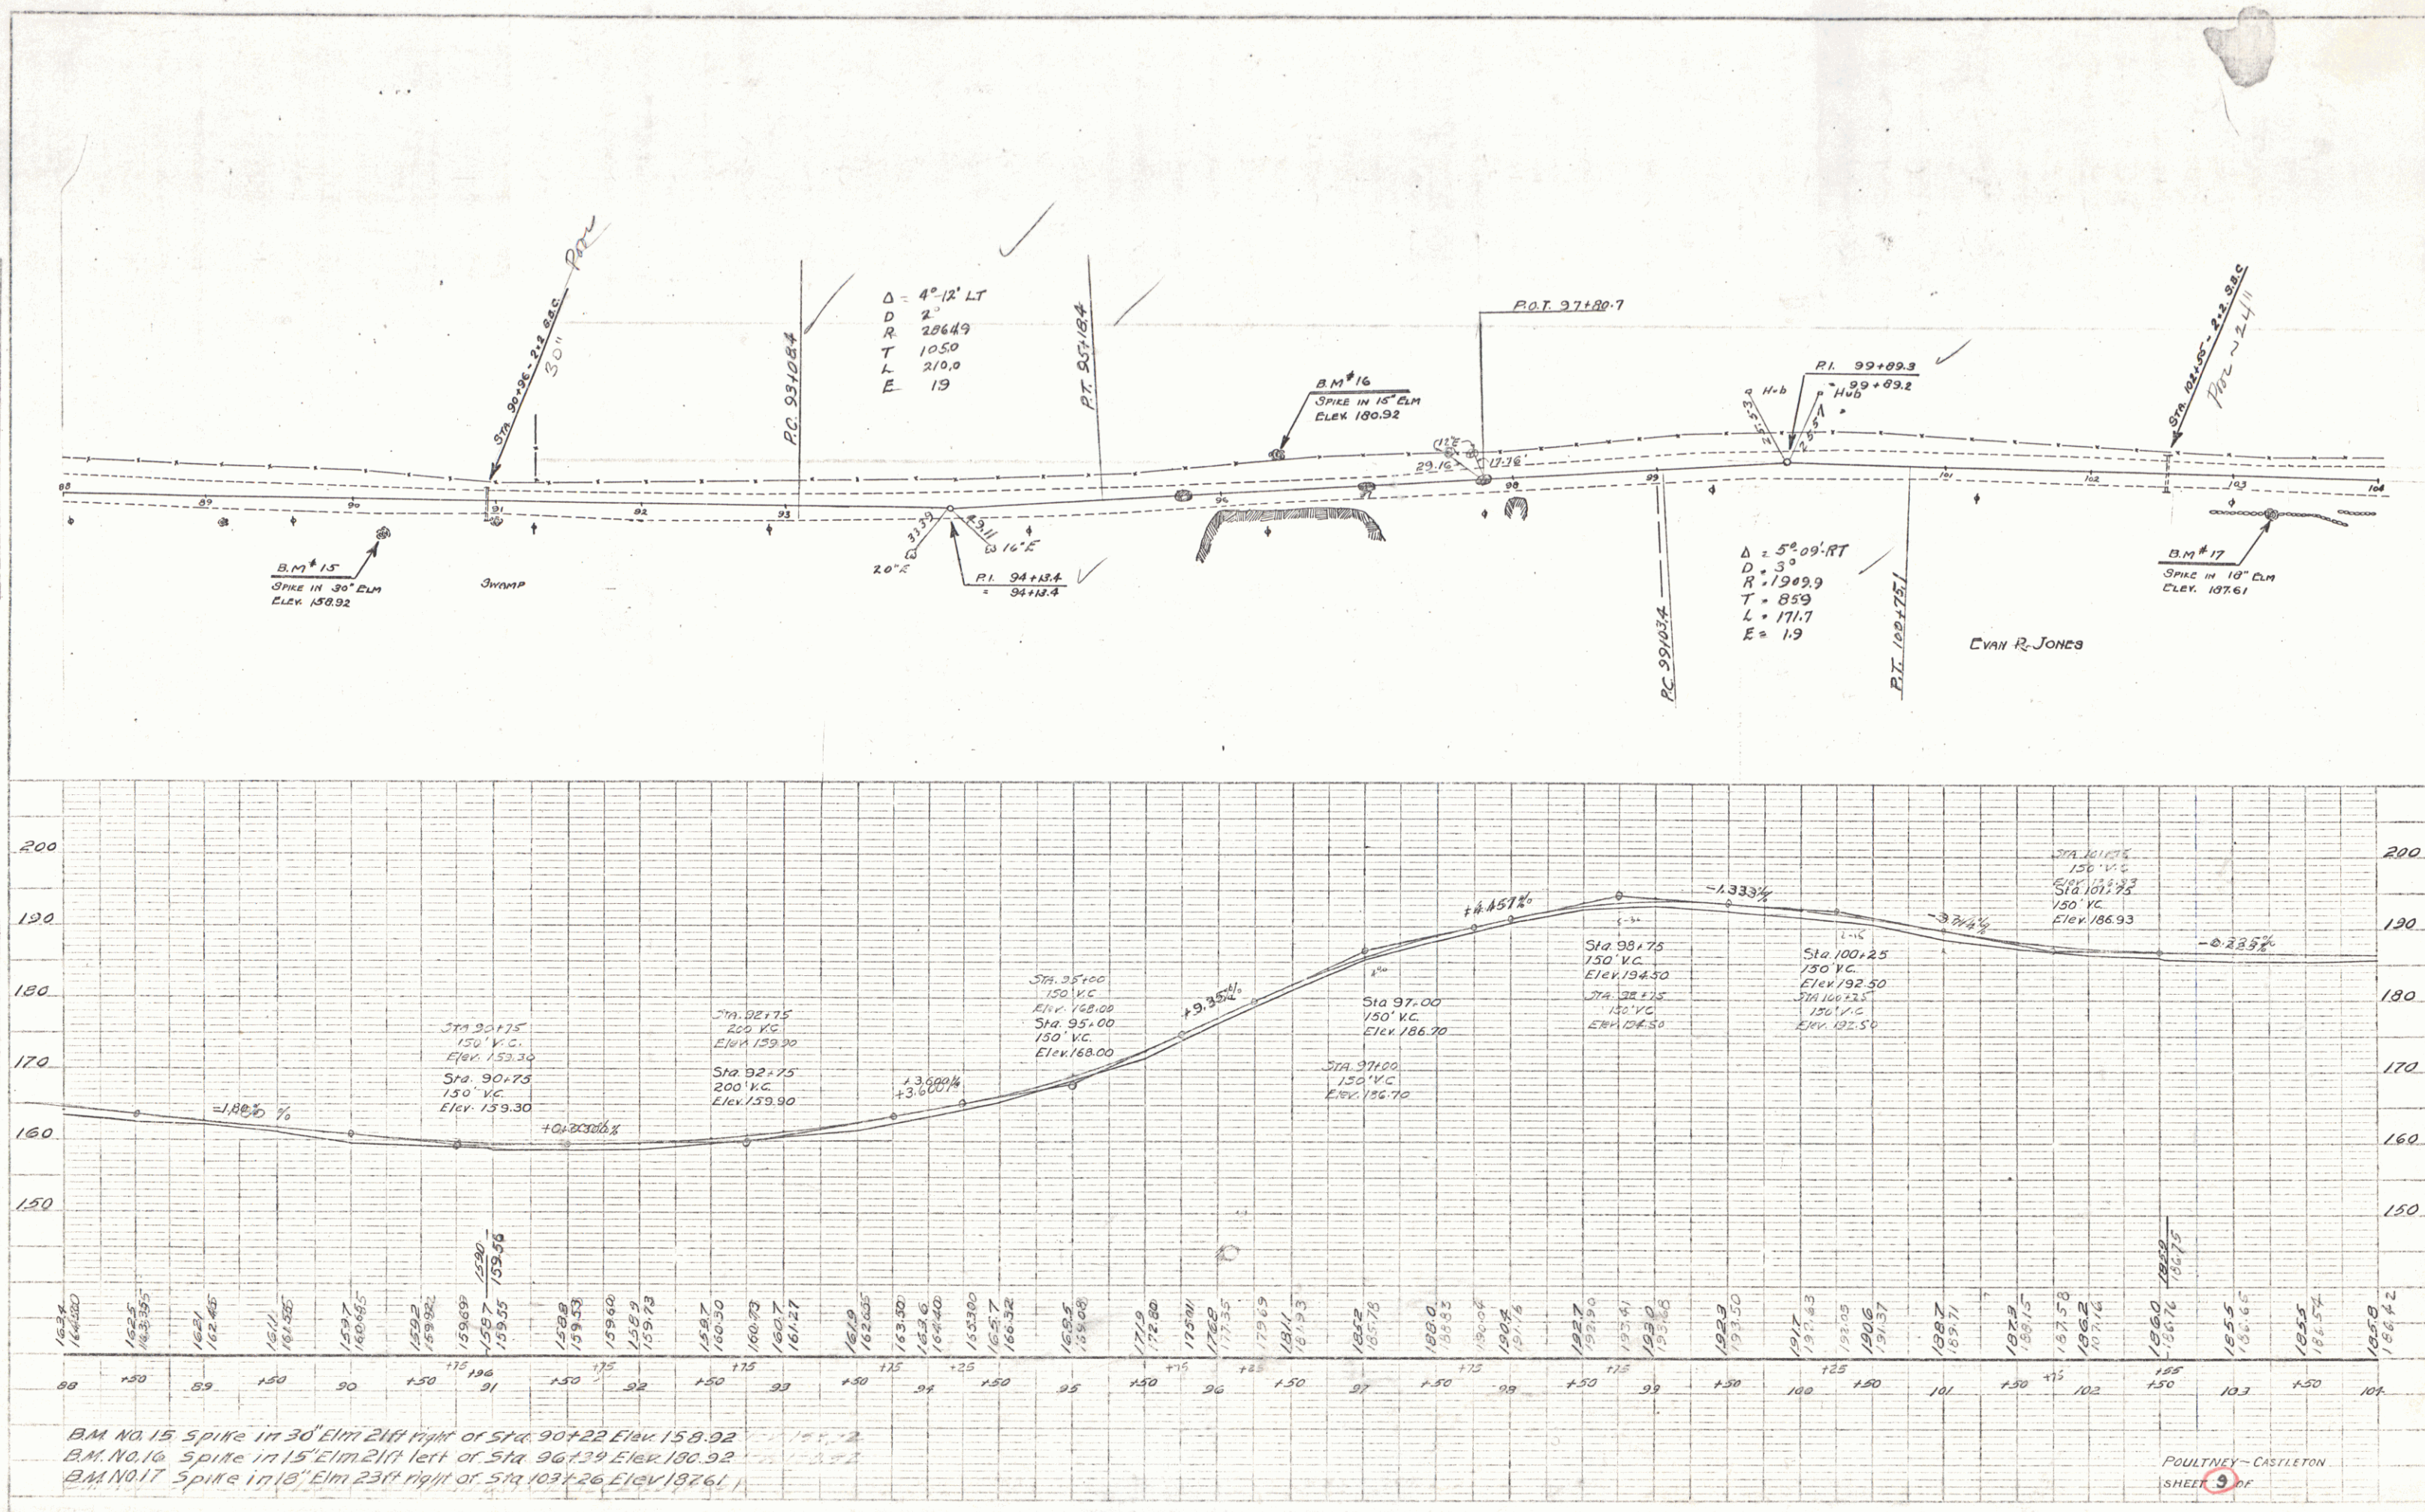


PLAN	1-33
DATE	1-33
BY	W. H. HALL
CHECKED	W. H. HALL
APPROVED	W. H. HALL
REVISIONS	
1	1-33
2	1-33
PROFILE	1-33
DATE	1-33
BY	W. H. HALL
CHECKED	W. H. HALL
APPROVED	W. H. HALL
REVISIONS	
1	1-33
2	1-33
3	1-33
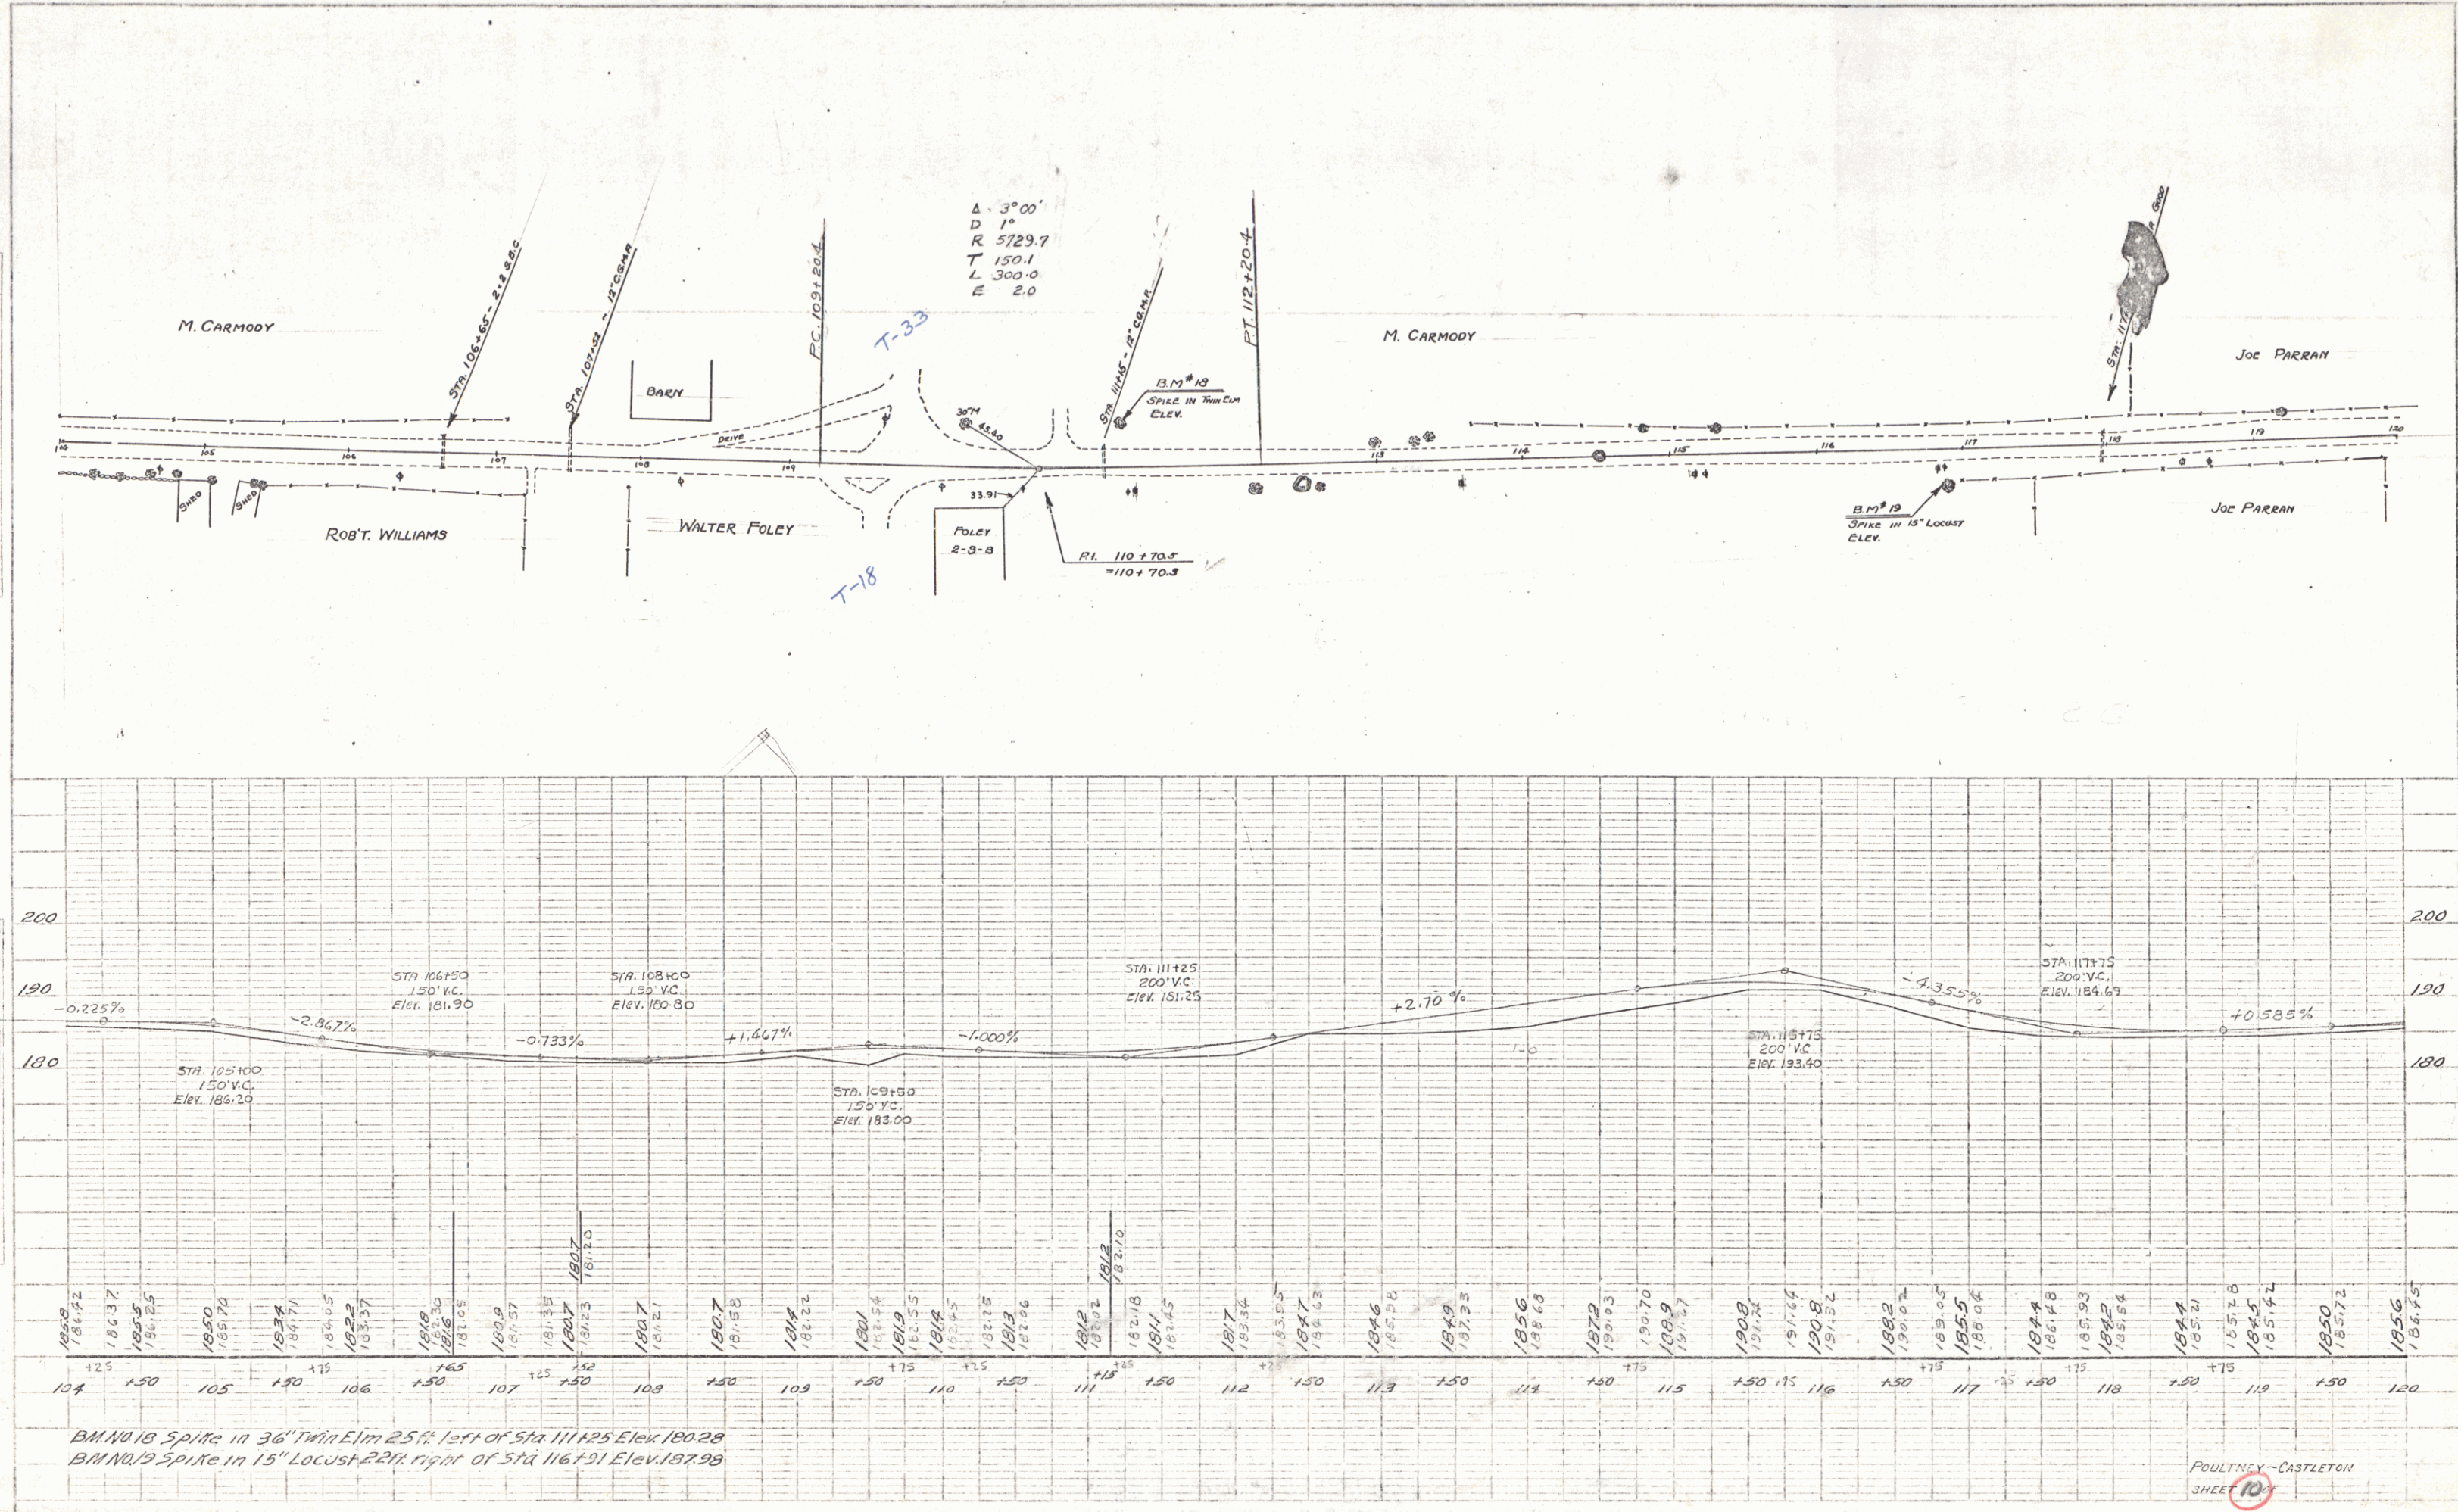


POULTNEY-CASTLETON
SHEET 10

PLAN	SECTION
DATE 1904	DATE 1904
BY J.M. McINERY	BY J.M. McINERY
CHECKED BY	CHECKED BY
APPROVED BY	APPROVED BY

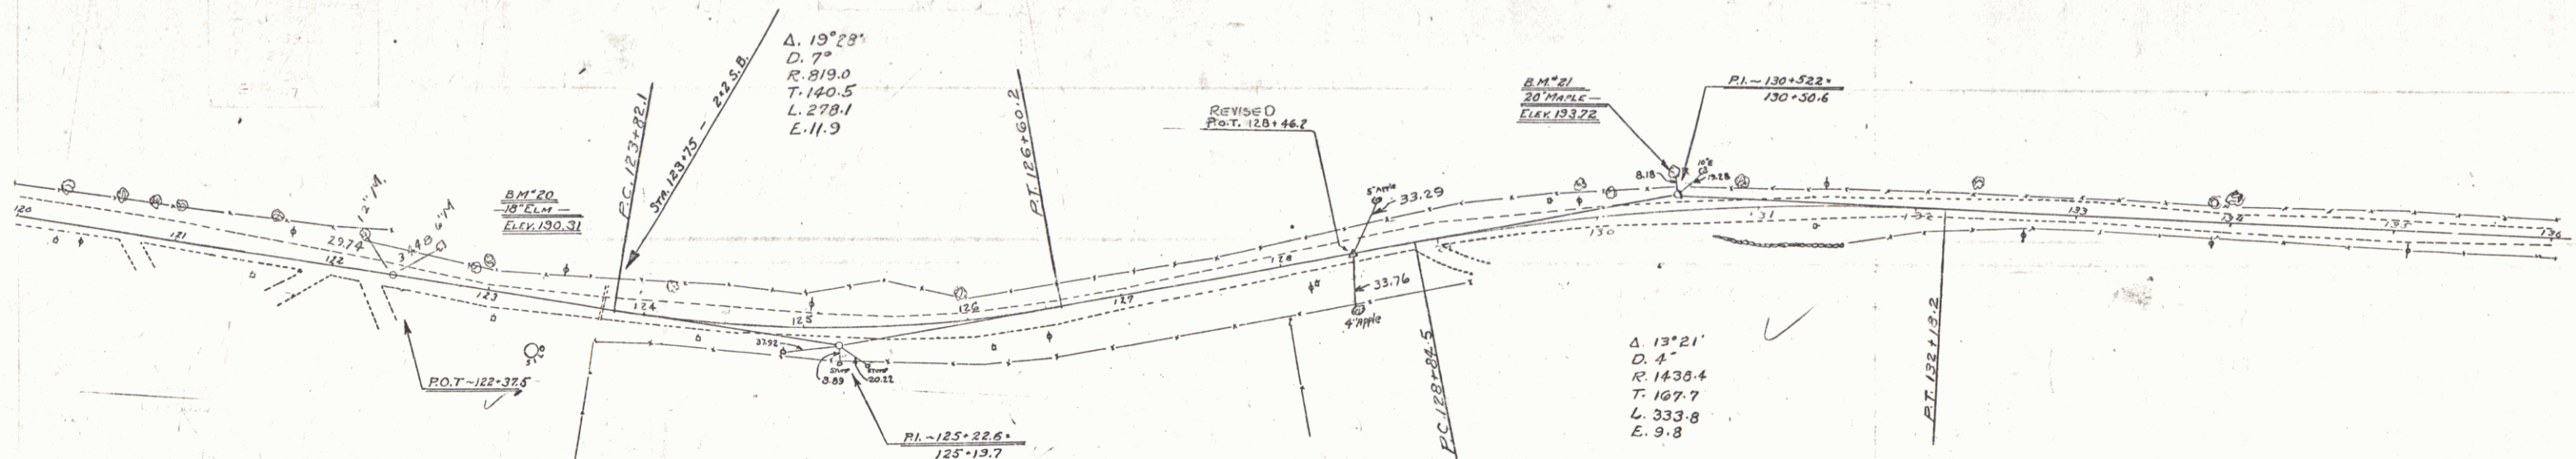

J.M. McINERY

SECTION	PLAN
DATE 1904	DATE 1904
BY J.M. McINERY	BY J.M. McINERY
CHECKED BY	CHECKED BY
APPROVED BY	APPROVED BY

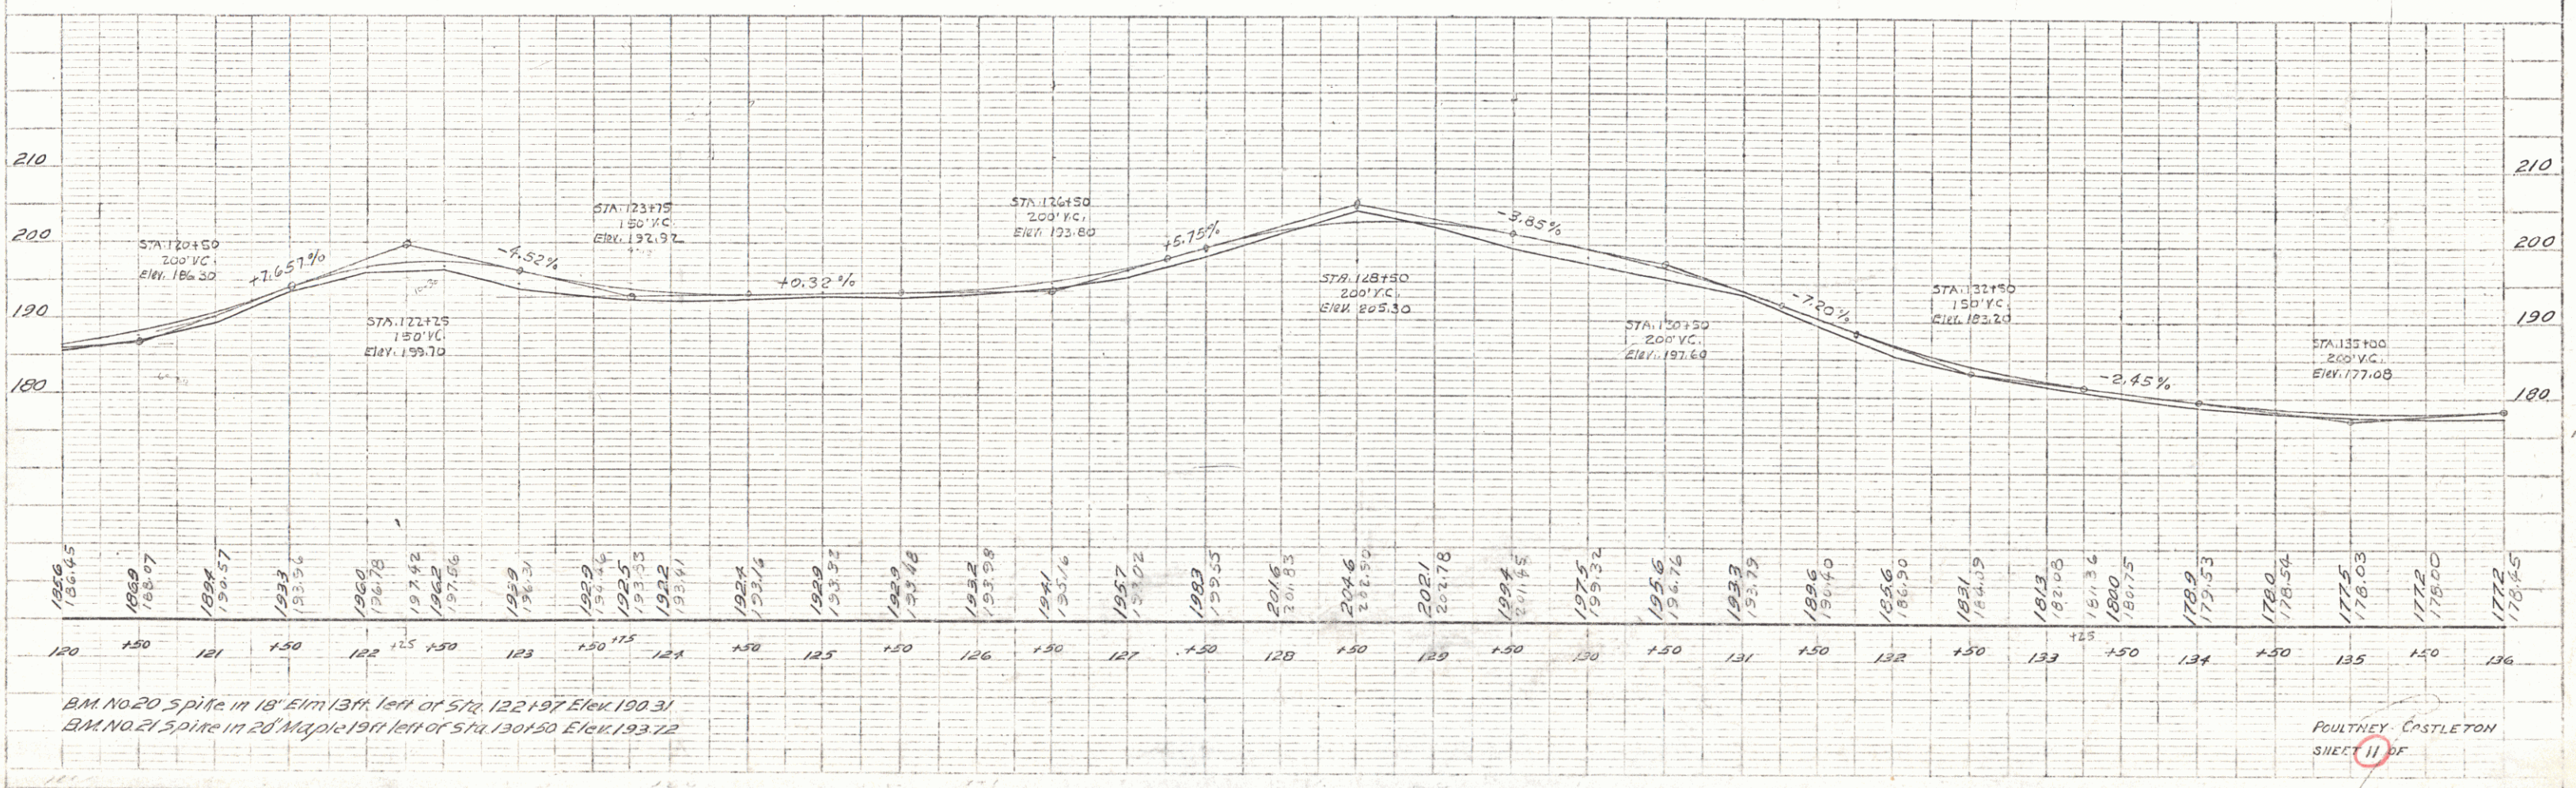



BM No. 20 Spire in 18' Elm 13ft. left of Sta. 122+97 Elev. 190.31
 BM No. 21 Spire in 20' Maple 19ft. left of Sta. 130+50 Elev. 193.22

POULTNEY CASTLETON
 SHEET 11 OF

PLAN	DATE	BY
NOTE	DATE	BY
REVISION	DATE	BY
REVISION	DATE	BY
REVISION	DATE	BY

STATION	136	137	138	139	140	141	142	143	144	145	146	147	148	149	150	151	152																																																																																																																																																																																																																																																																																																																																																																																																																																																																																																																																																																																																																																																																																																																																																																																																																																																																																																																																																																																																																																																																																																																																																																																		
ELEVATION	176.45	177.4	179.47	179.79	179.97	180.56	180.64	180.72	181.12	181.52	181.94	182.31	182.53	183.1	183.67	184.90	185.92	186.45	187.04	187.7	188.52	189.7	190.67	191.90	192.2	193.16	194.0	195.41	196.0	197.33	198.14	198.6	199.3	200.17	200.95	201.7	203.17	204.57	205.59	206.32	207.37	208.54	209.7	210.9	212.1	1542.9	1544.1</

REINFORCED CONCRETE PIPE			CULVERTS REQUIRED		
STA.	DIAM.	LENG.	CONC. A	CONC. C	STEEL
156+52	30"	32'	3.2 cy.	—	58 *
159+13	15"	36'	—	2.3 cy.	33 *
162+63	15"	40'	—	2.3 cy.	33 *

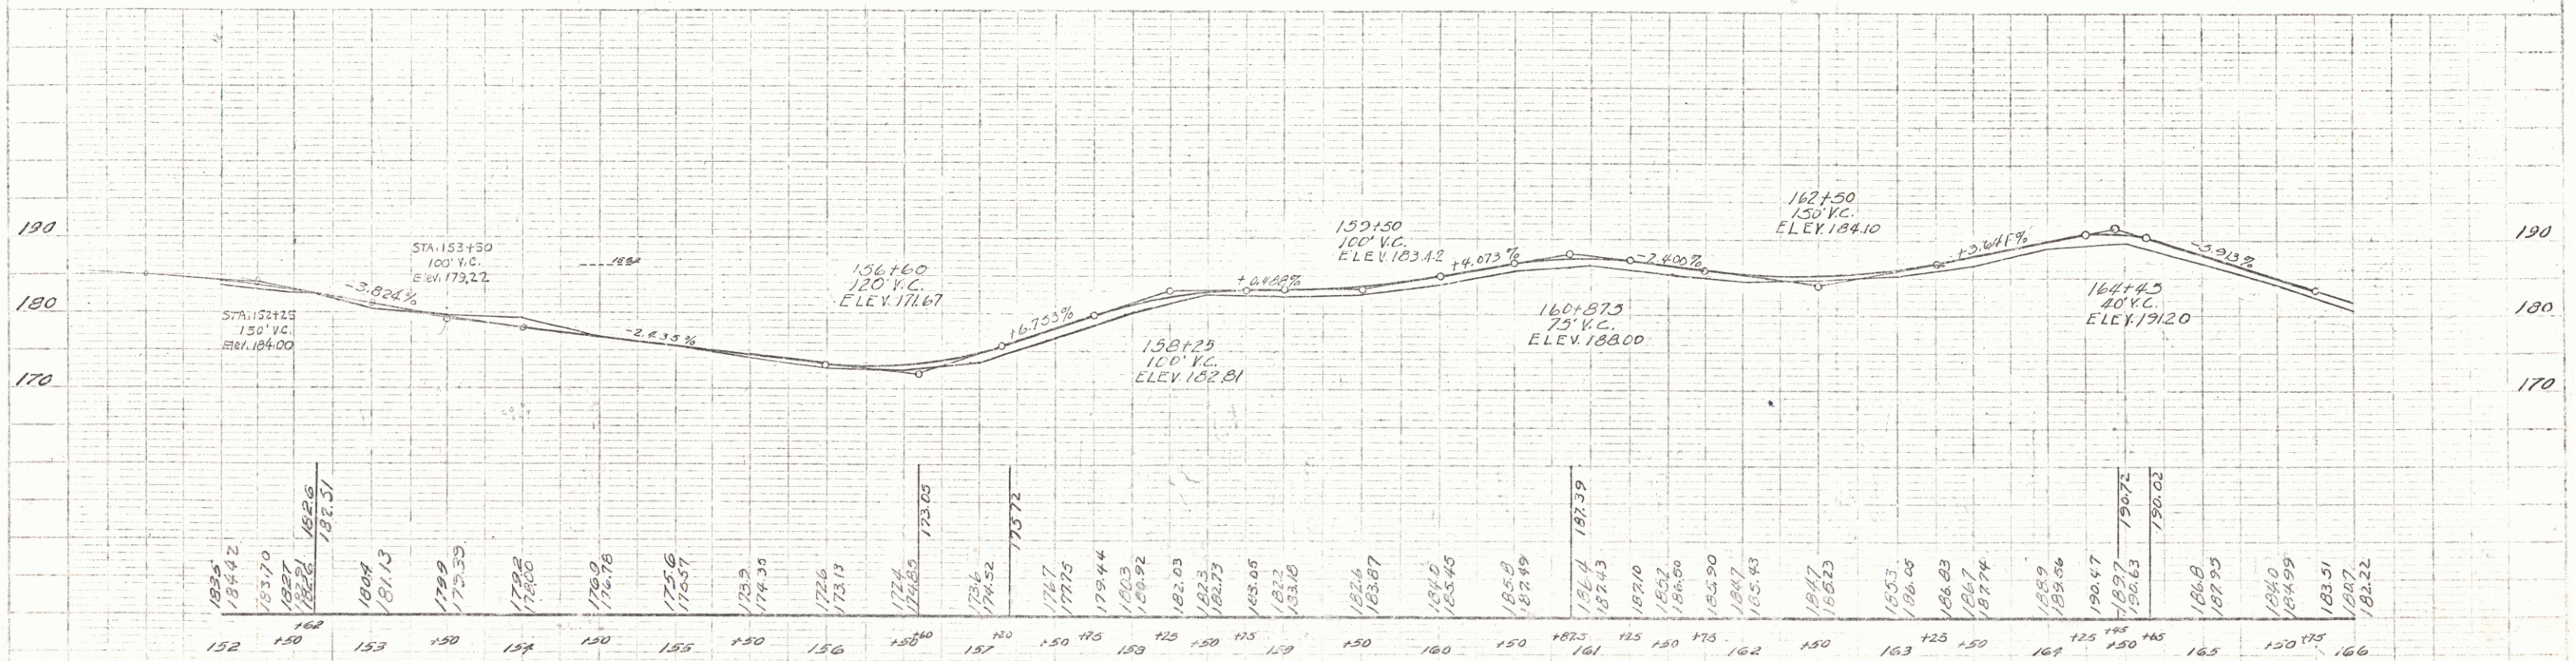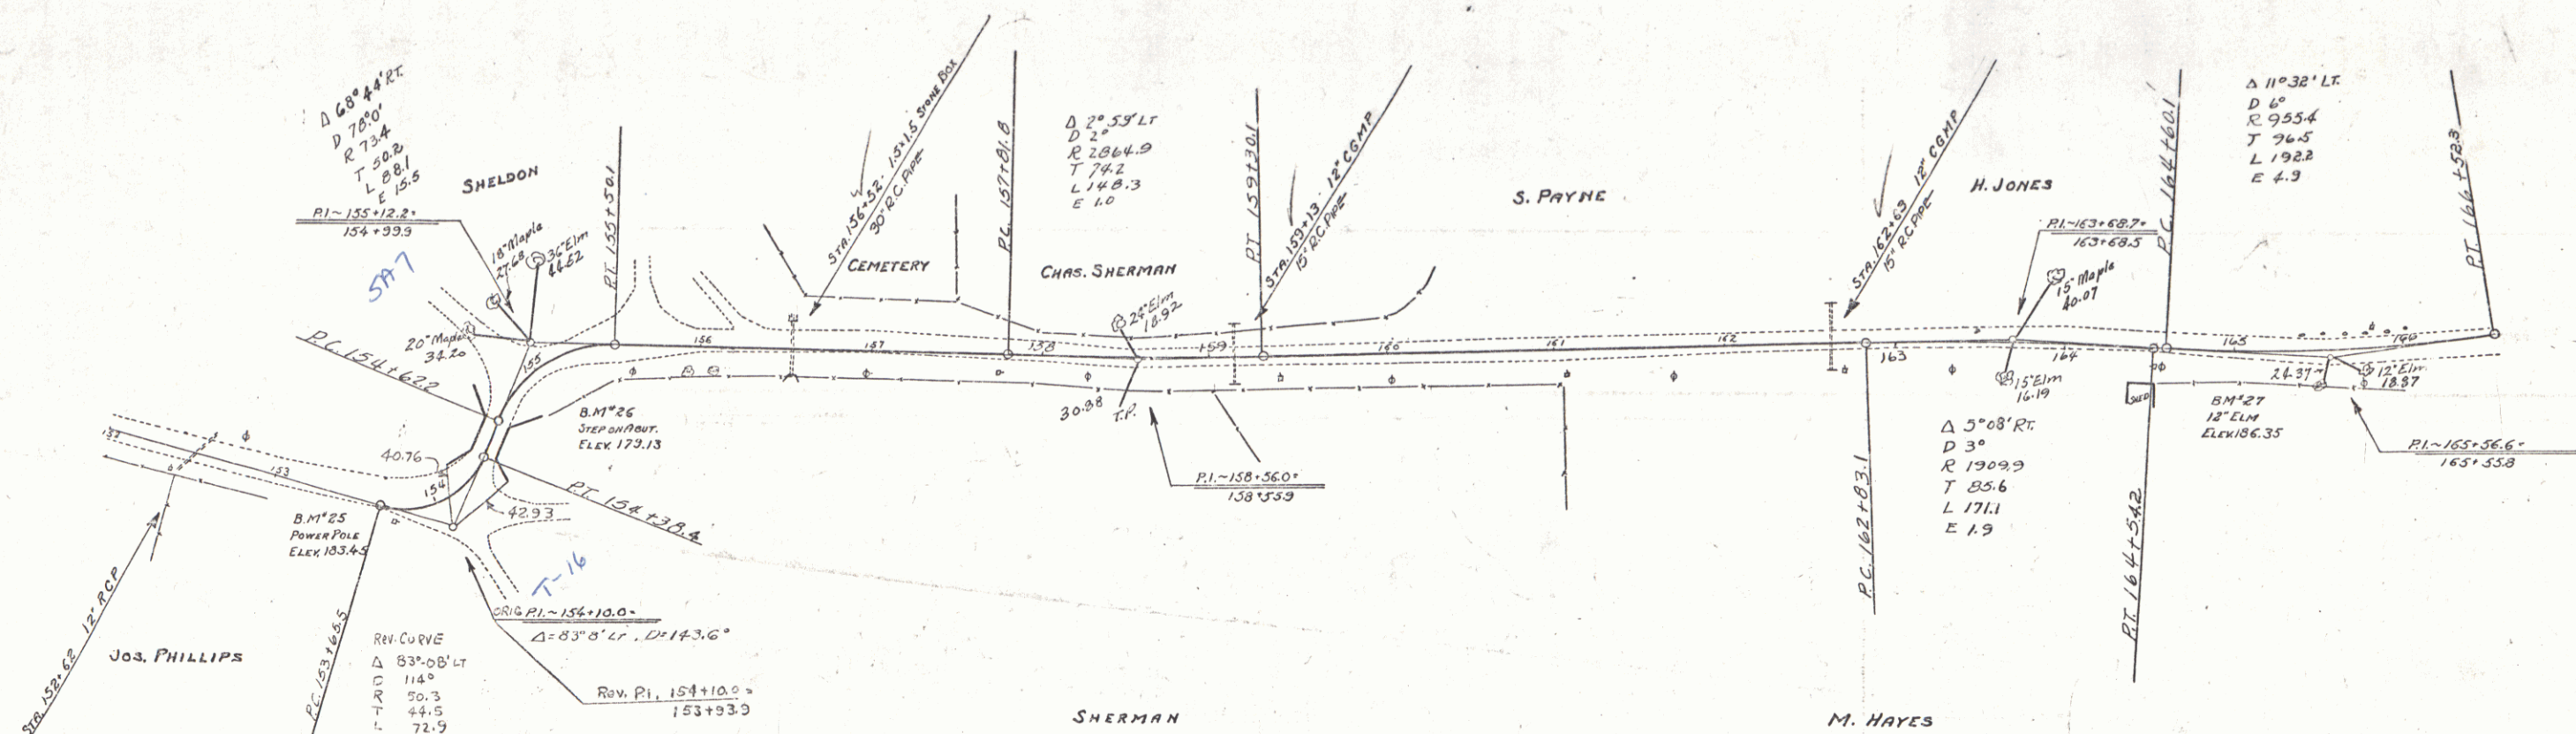

BM No. 25 Spike in 18" Power Pole 6 ft right of Sta 153+75 Elev 183.45
BM No. 26 Lower Step NW corner Nribment Under Pass 21 ft right of Sta 155+25 Elev 179.13
BM No. 27 Spike in 12" Elm 19 ft right of Sta 165+50 Elev 186.35


POULTNEY-CASTLETON
SHEET 13 OF

WOOD GUARD RAIL REQUIRED
CULV. STA. 174+27
LT. 24'
RT. 24'

REINF. CONCRETE PIPE CULVERTS REQUIRED
STA. DIAM. LENG. CONC. A CONC. C STEEL
174+27 15" 36' 23 CY 33"

PLAN	SECTION	DATE
DESIGNED BY	CHIEF ENGINEER	
CHECKED BY	ENGINEER	
NOTED BY	ENGINEER	
APPROVED BY	ENGINEER	



SECTION	DATE
DESIGNED BY	
CHECKED BY	
NOTED BY	
APPROVED BY	

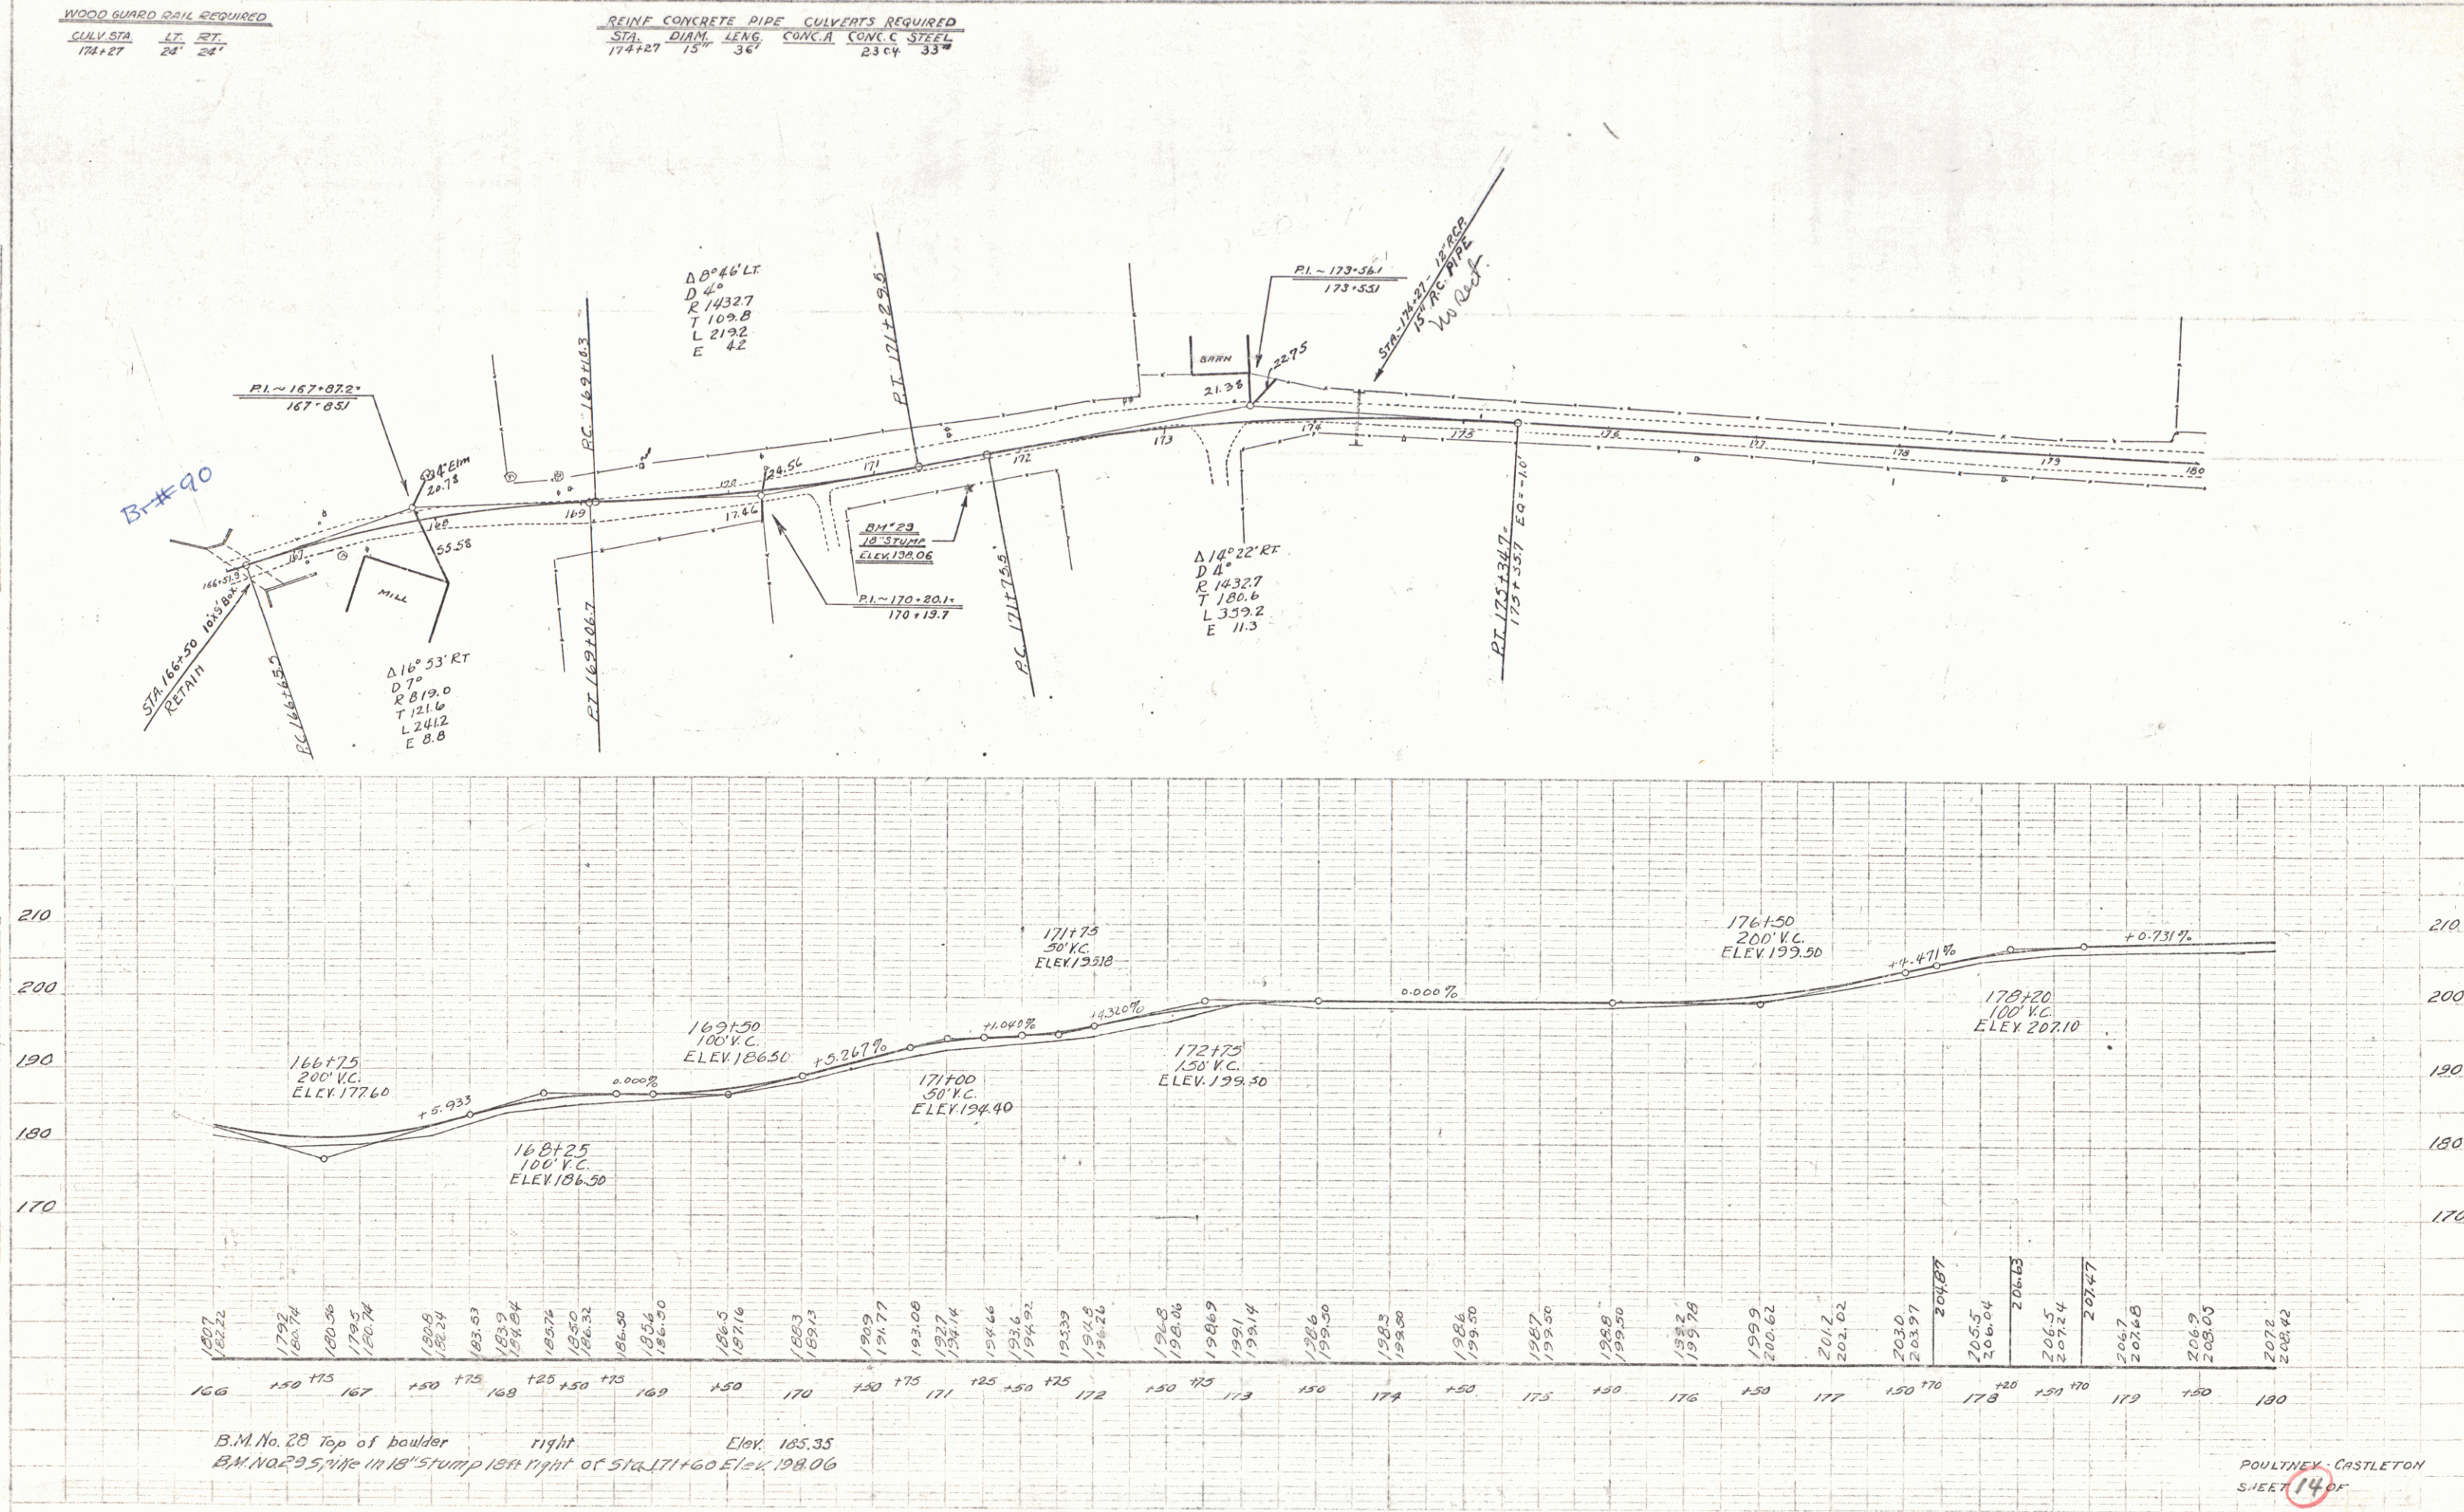

POULTNEY CASTLETON
SHEET 14 OF 12

WOOD GUARD RAIL REQUIRED		
CULV. STA.	LT.	RT.
130+00	24'	24'
133+50	24'	24'

REIN. CONCRETE PIPE CULVERTS REQUIRED				
STA.	DIAM.	LENG.	CONC. A.	CONC. C. STEEL
130+00	15"	36'	2.3 CY	33#
133+50	15"	36'	2.3 CY	33#

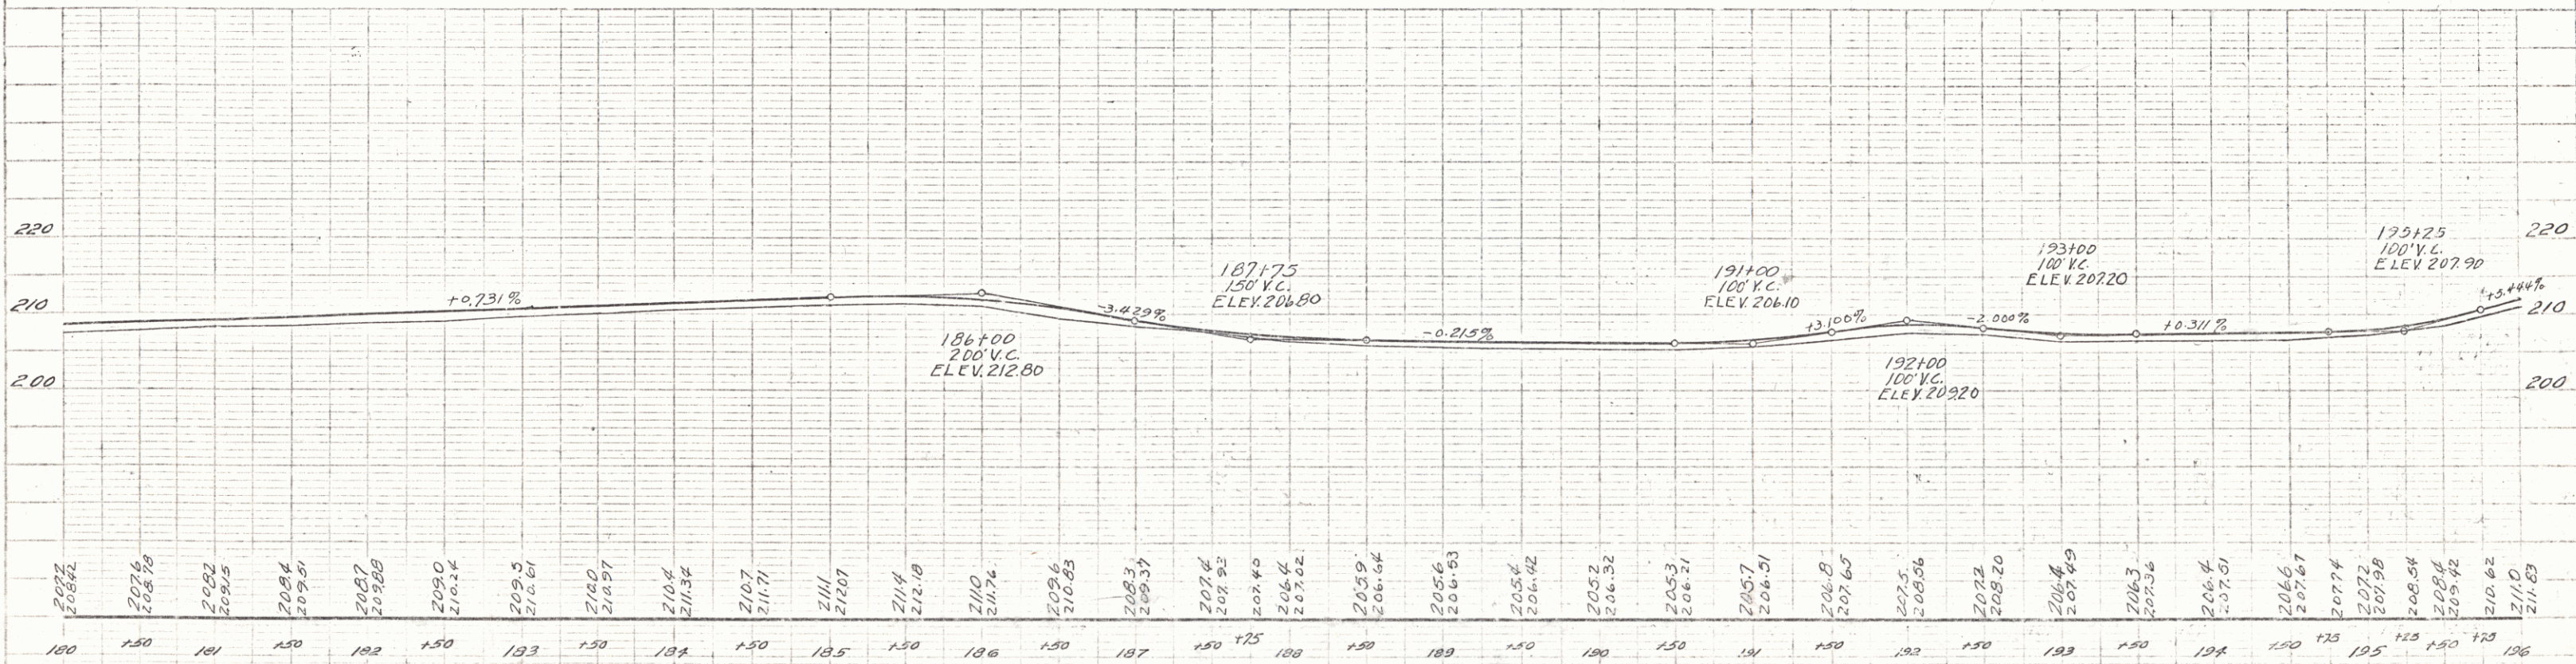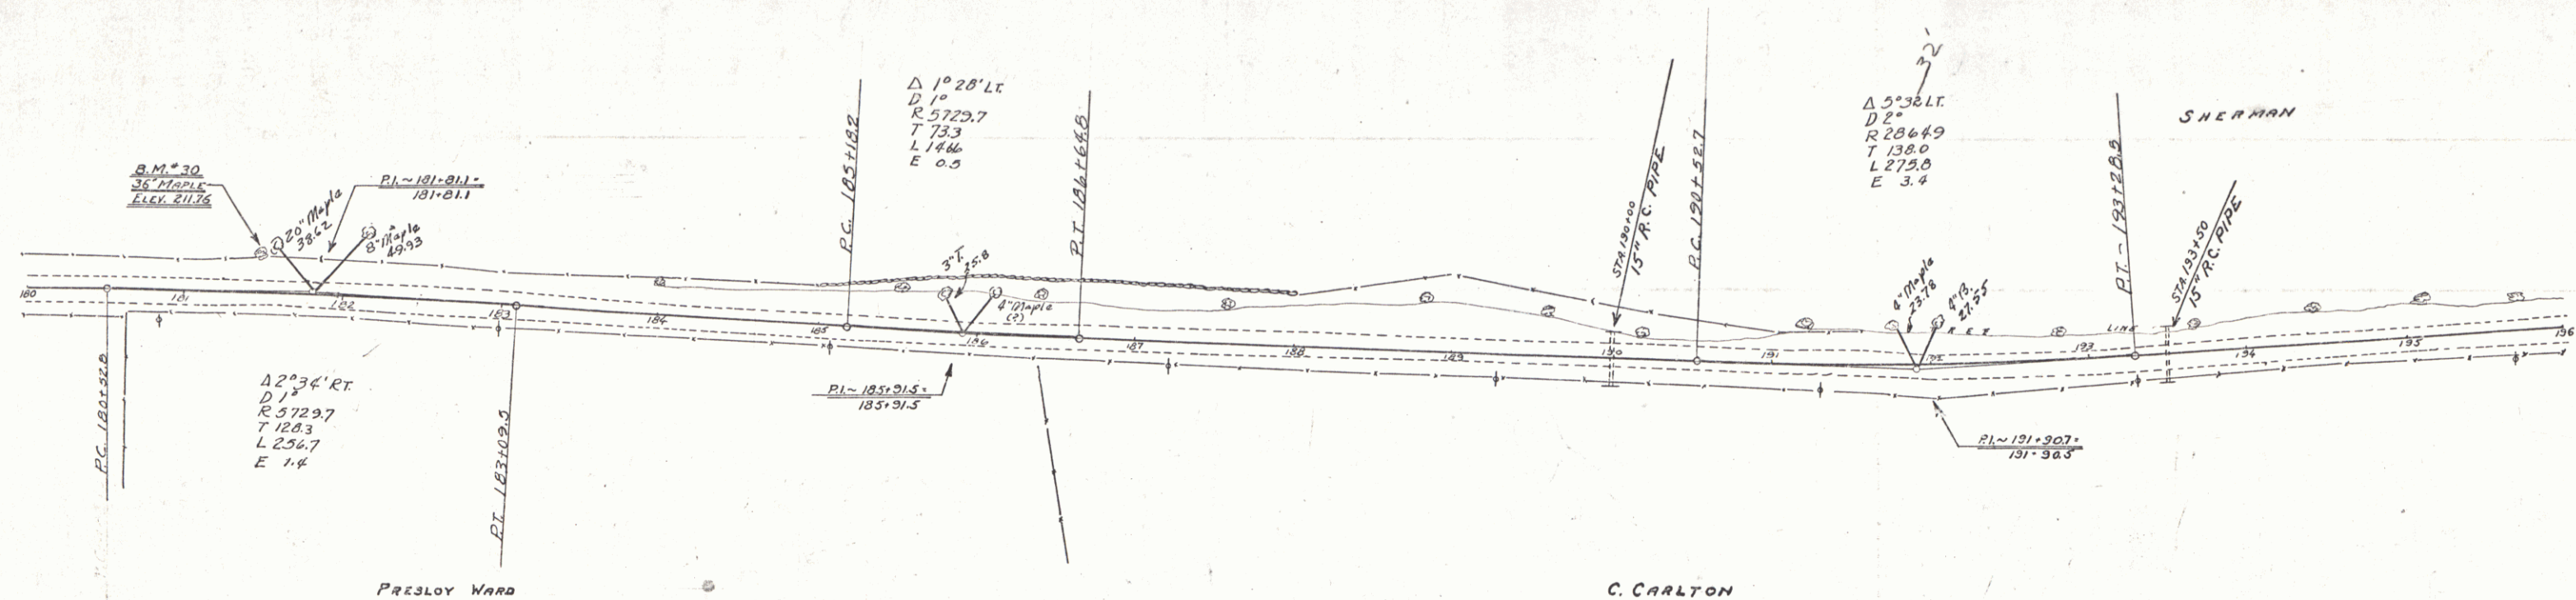

B.M. No. 30 Spike in 36" Maple 22' left Sta 181.48 Elev. 211.76
 B.M. No. 31 Spike in 20" Swamp right Elev. 208.00


POULTNEY CASTLETON
 SHEET 15 OF

WOODWARD RAIL REQUIRED
CULV. STA. 198+00 24' 24'

REFINE CONCRETE PIPE CULVERTS REQUIRED
STA. 198+00 15' 36' 2.304 33'

PLAN	DATE	BY	CHECKED
NOTE BOOK	10/27/01	W.D.	
NO.			


CHARGE	10/27/01
NO.	

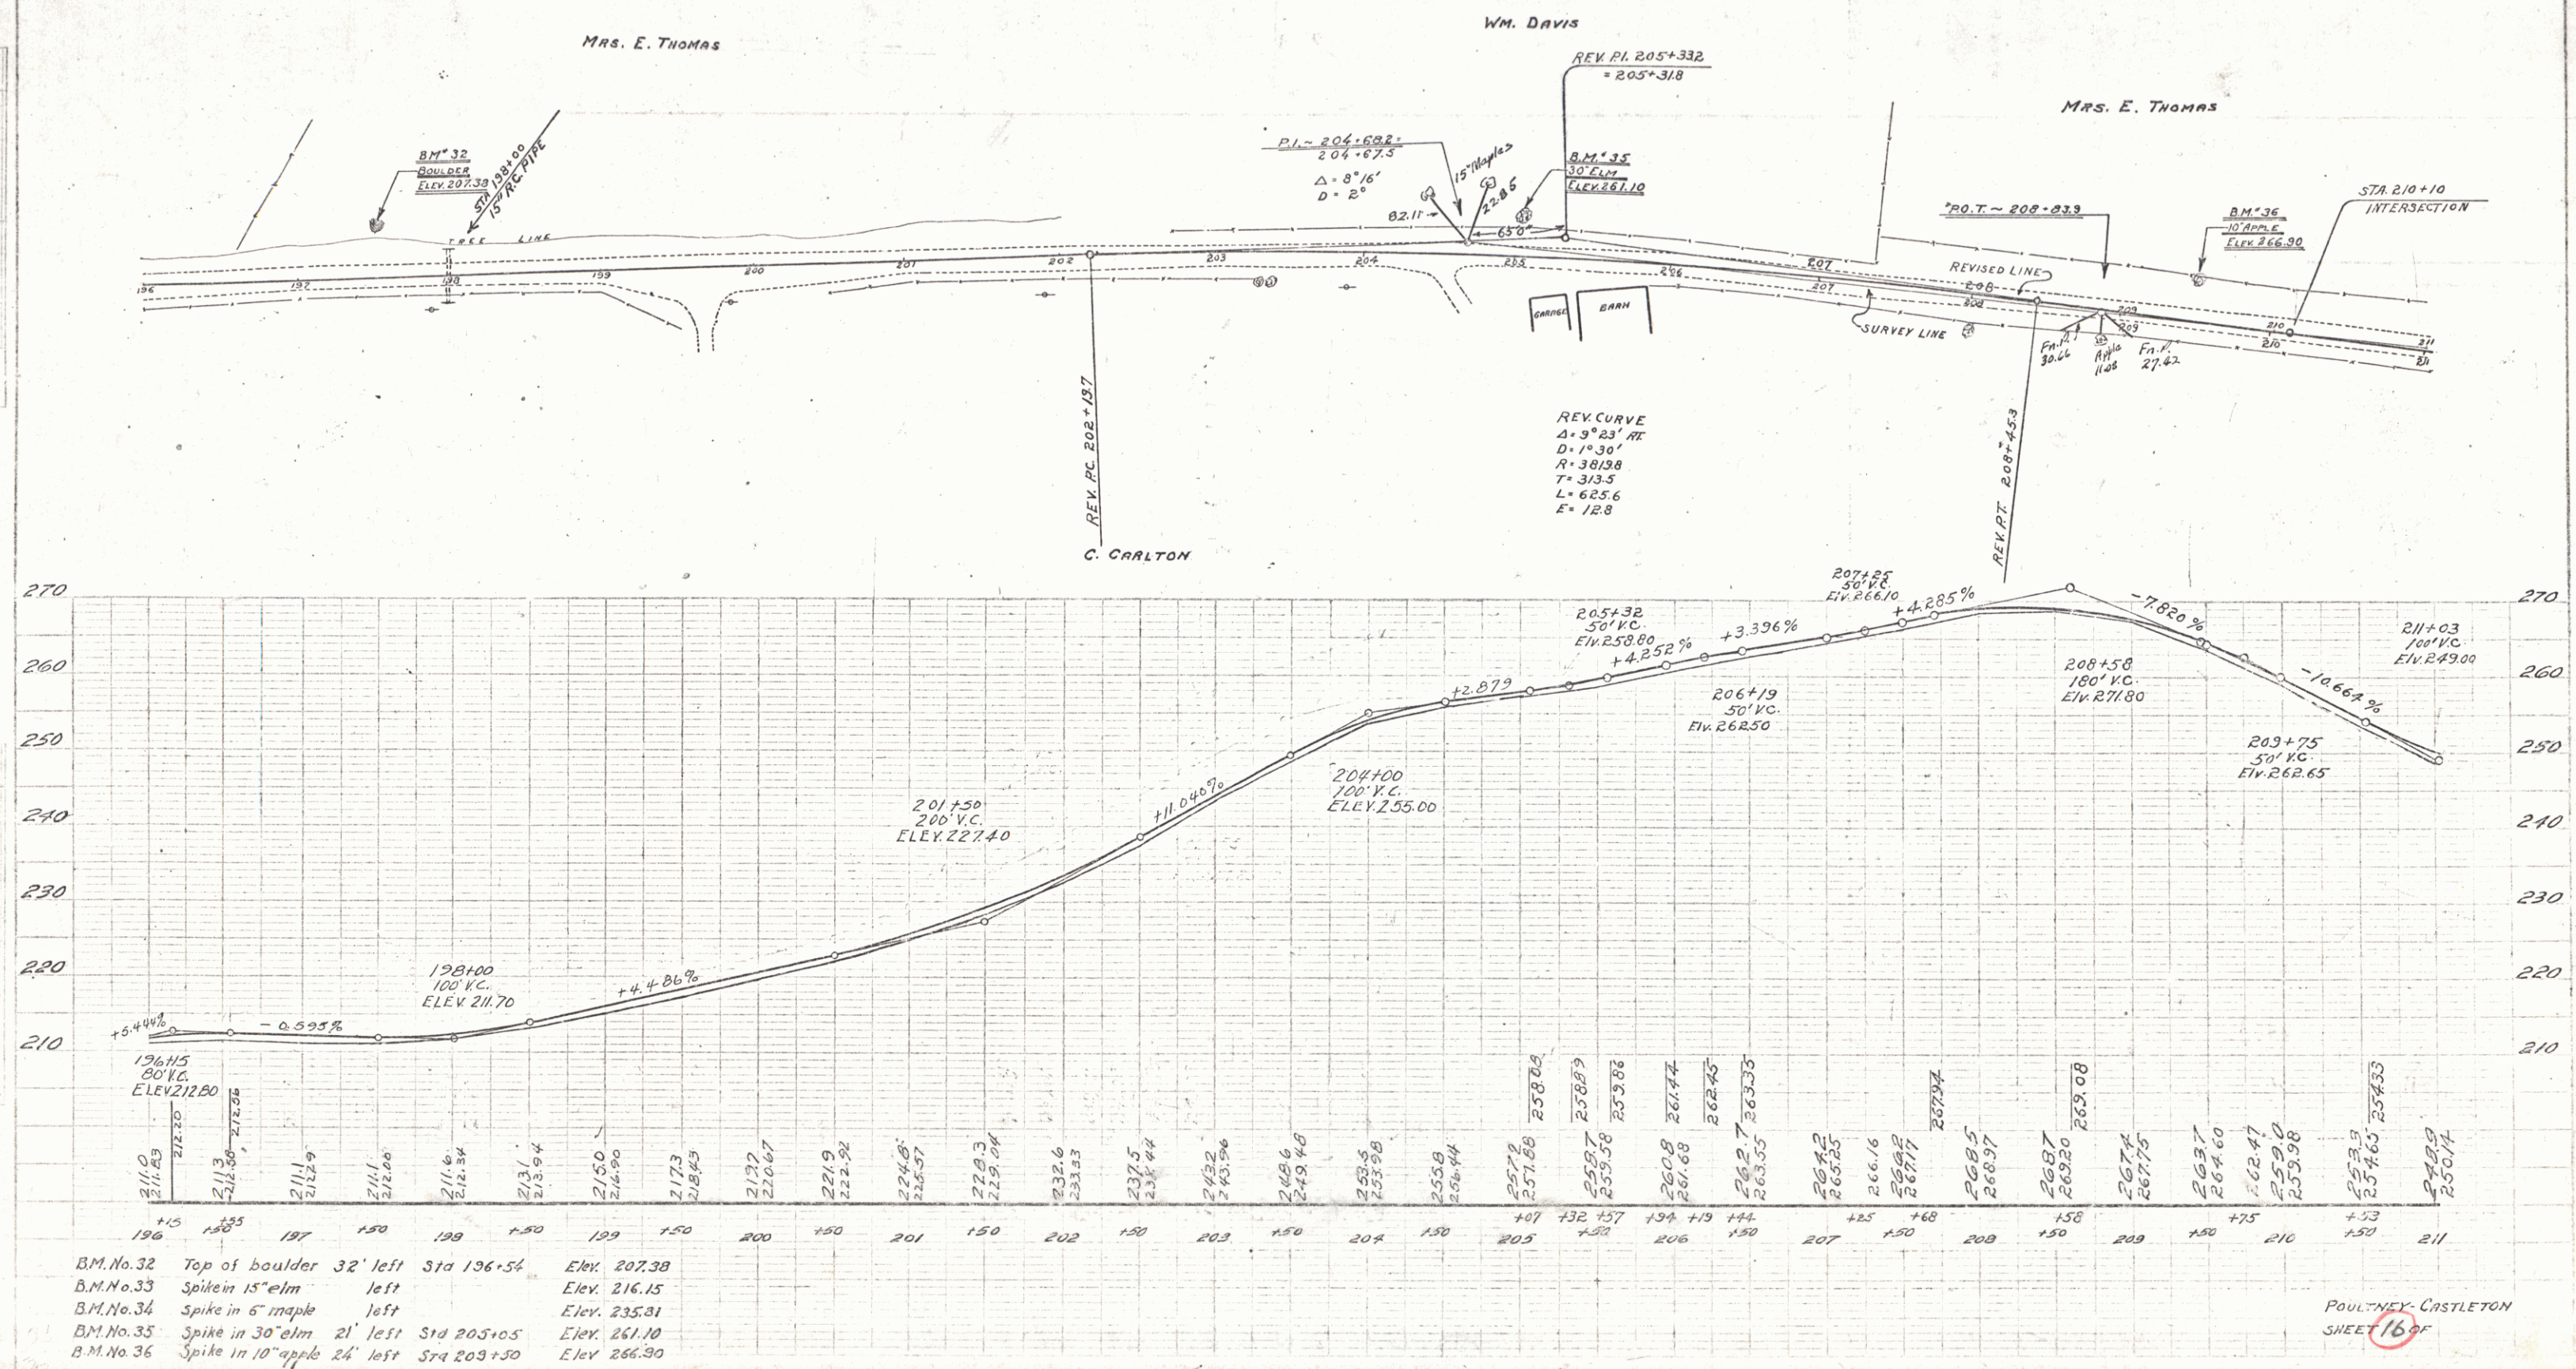

POULTNEY-CARLETON
SHEET 16 OF 17

WOOD GUARD RAIL REQUIRED			
CULV. STA.	LT.	RT.	
211+79	24'	24'	
217+71	24'	24'	

REIN. CONCRETE PIPE CULVERTS REQUIRED				
STA.	DIAM.	LEN.	CONC. A.	CORR. C. STEEL
211+79	18"	44'	18 cy	54#
217+71	24"	32'	24 cy	54#

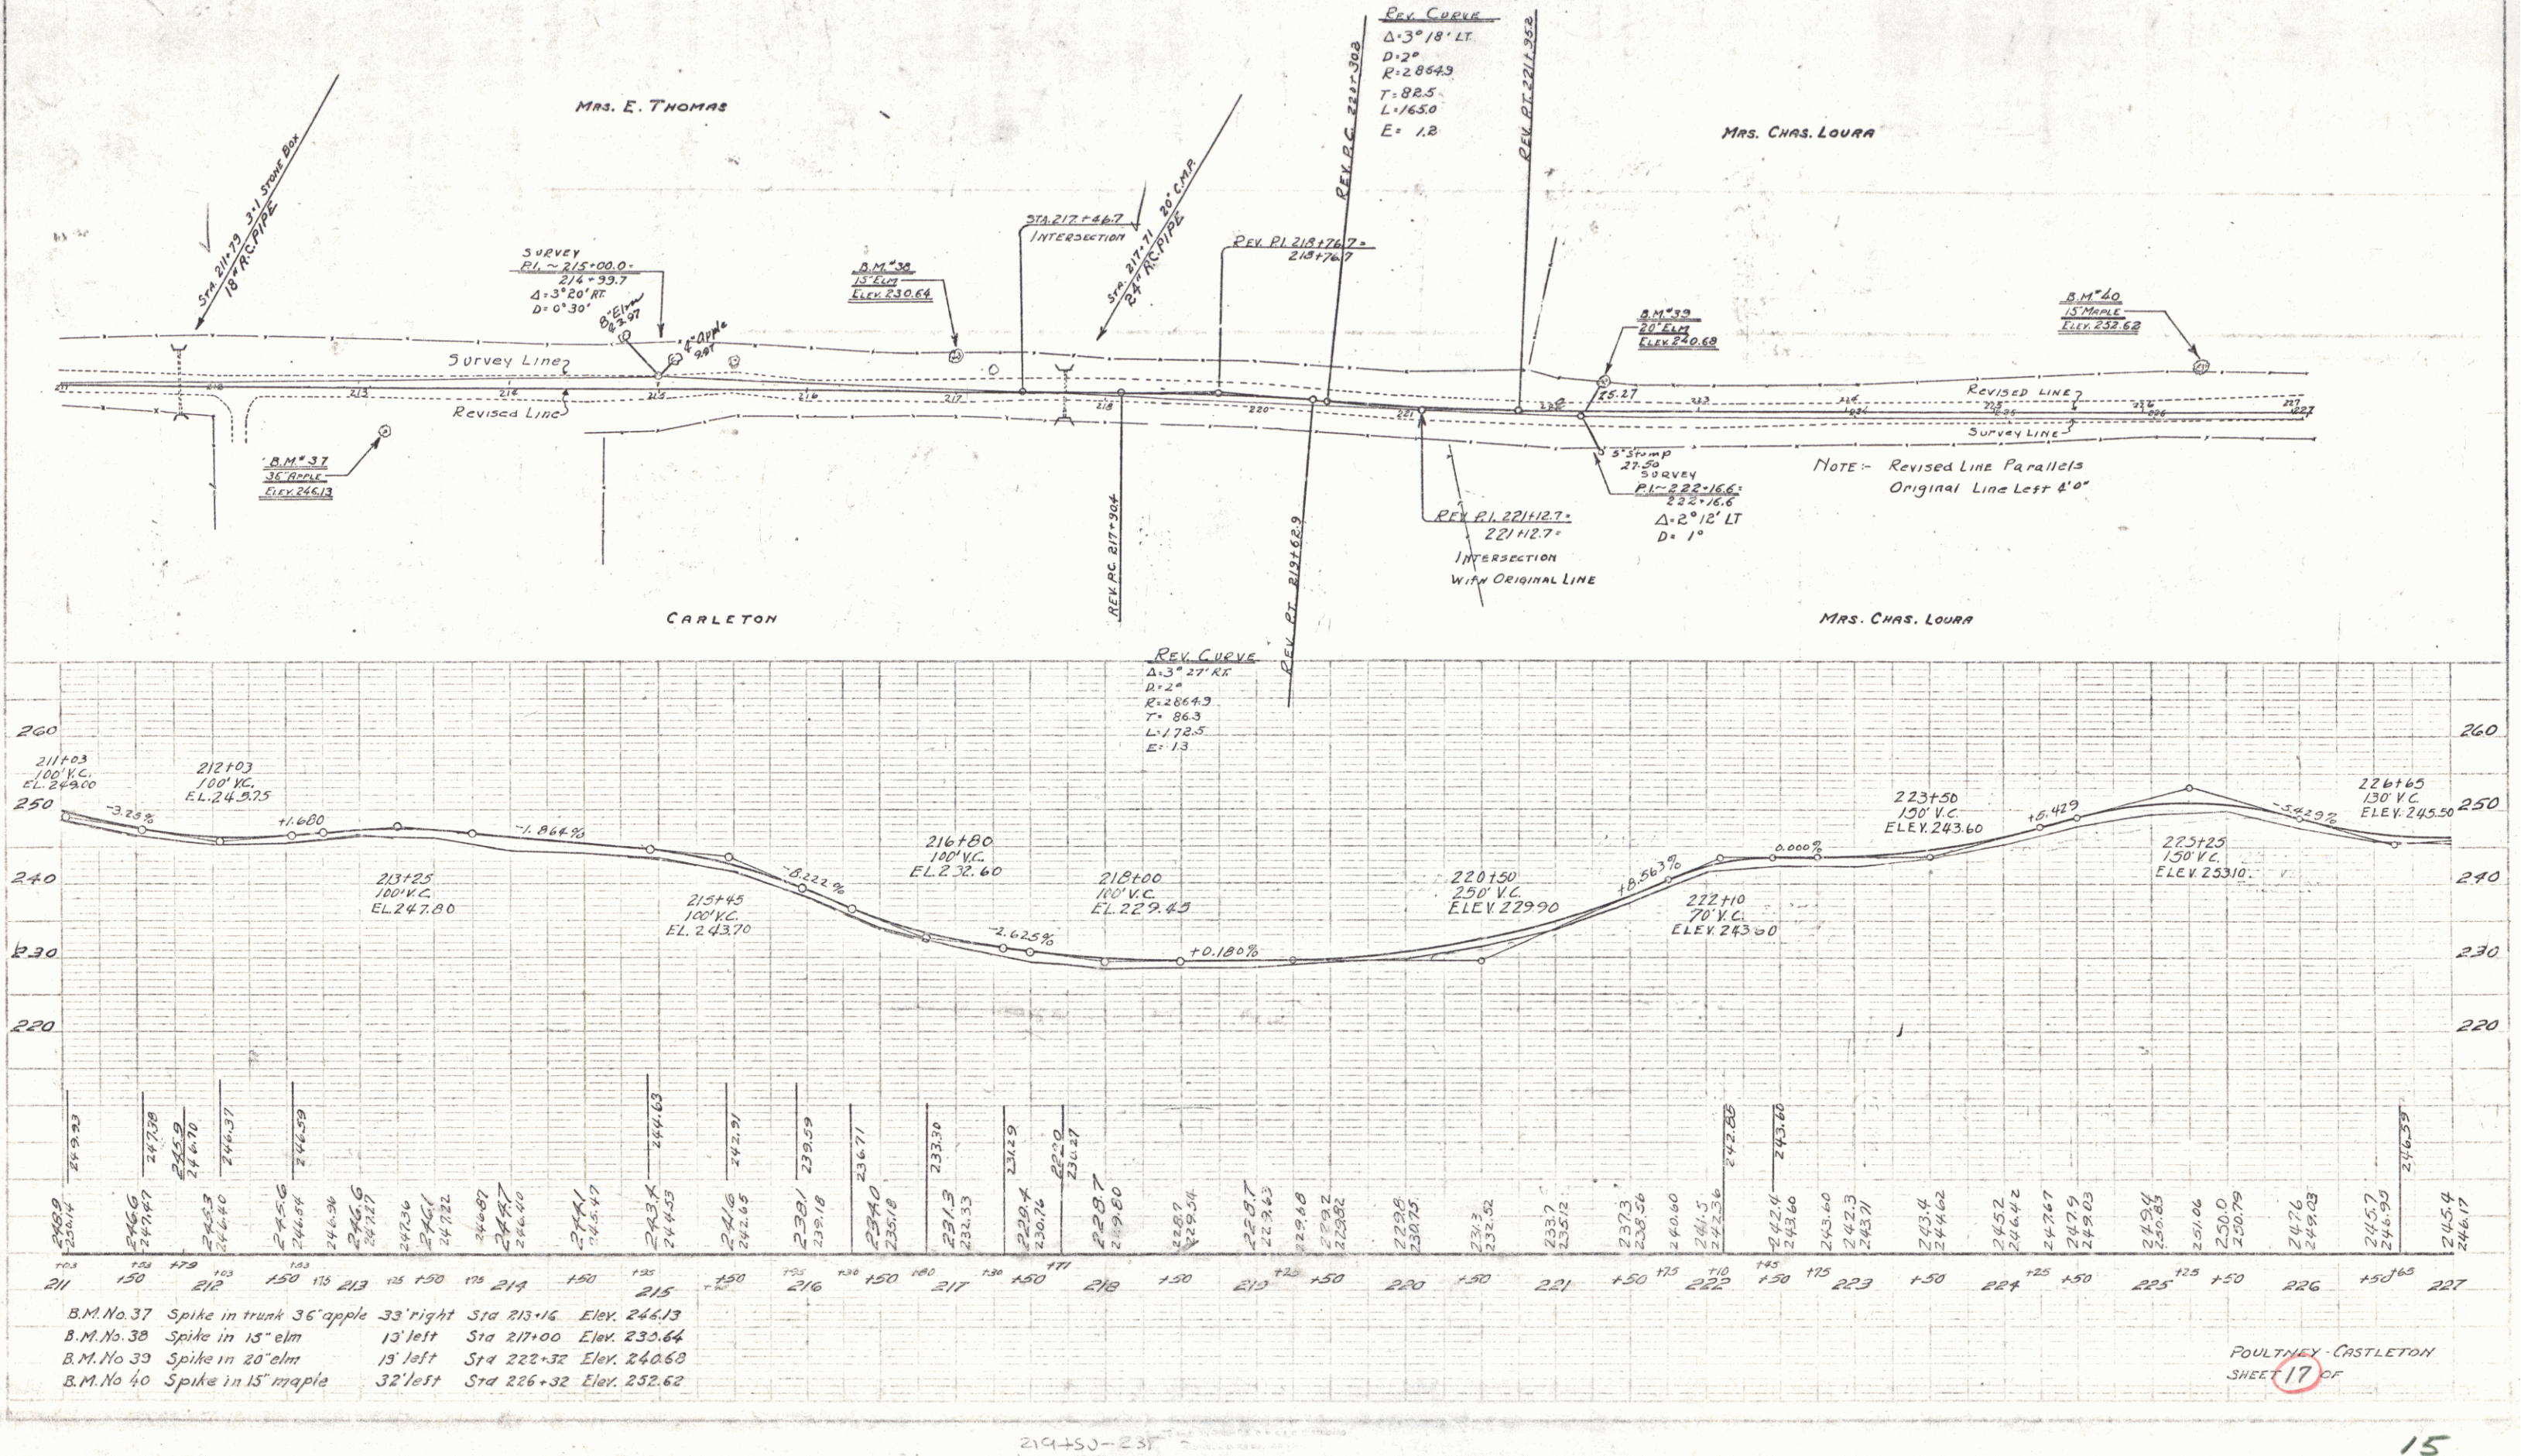



POULTNEY - CASTLETON
SHEET 17 OF

WOODWARD RAIL REQUIRED
 CULV. STA. 227+50
 24' 24'

REIN. CONCRETE PIPE CULVERTS REQUIRED
 STA. DIAM. LENG. CONC. CONCL. STEEL
 227+50 15" 36' 2304 33"

PLAN
 SHEET NO. 13
 DATE 10/1/23
 BY J. H. BROWN
 CHECKED BY J. H. BROWN
 TITLE SHEET NO. 13

SECTION
 SHEET NO. 13
 DATE 10/1/23
 BY J. H. BROWN
 CHECKED BY J. H. BROWN
 TITLE SHEET NO. 13

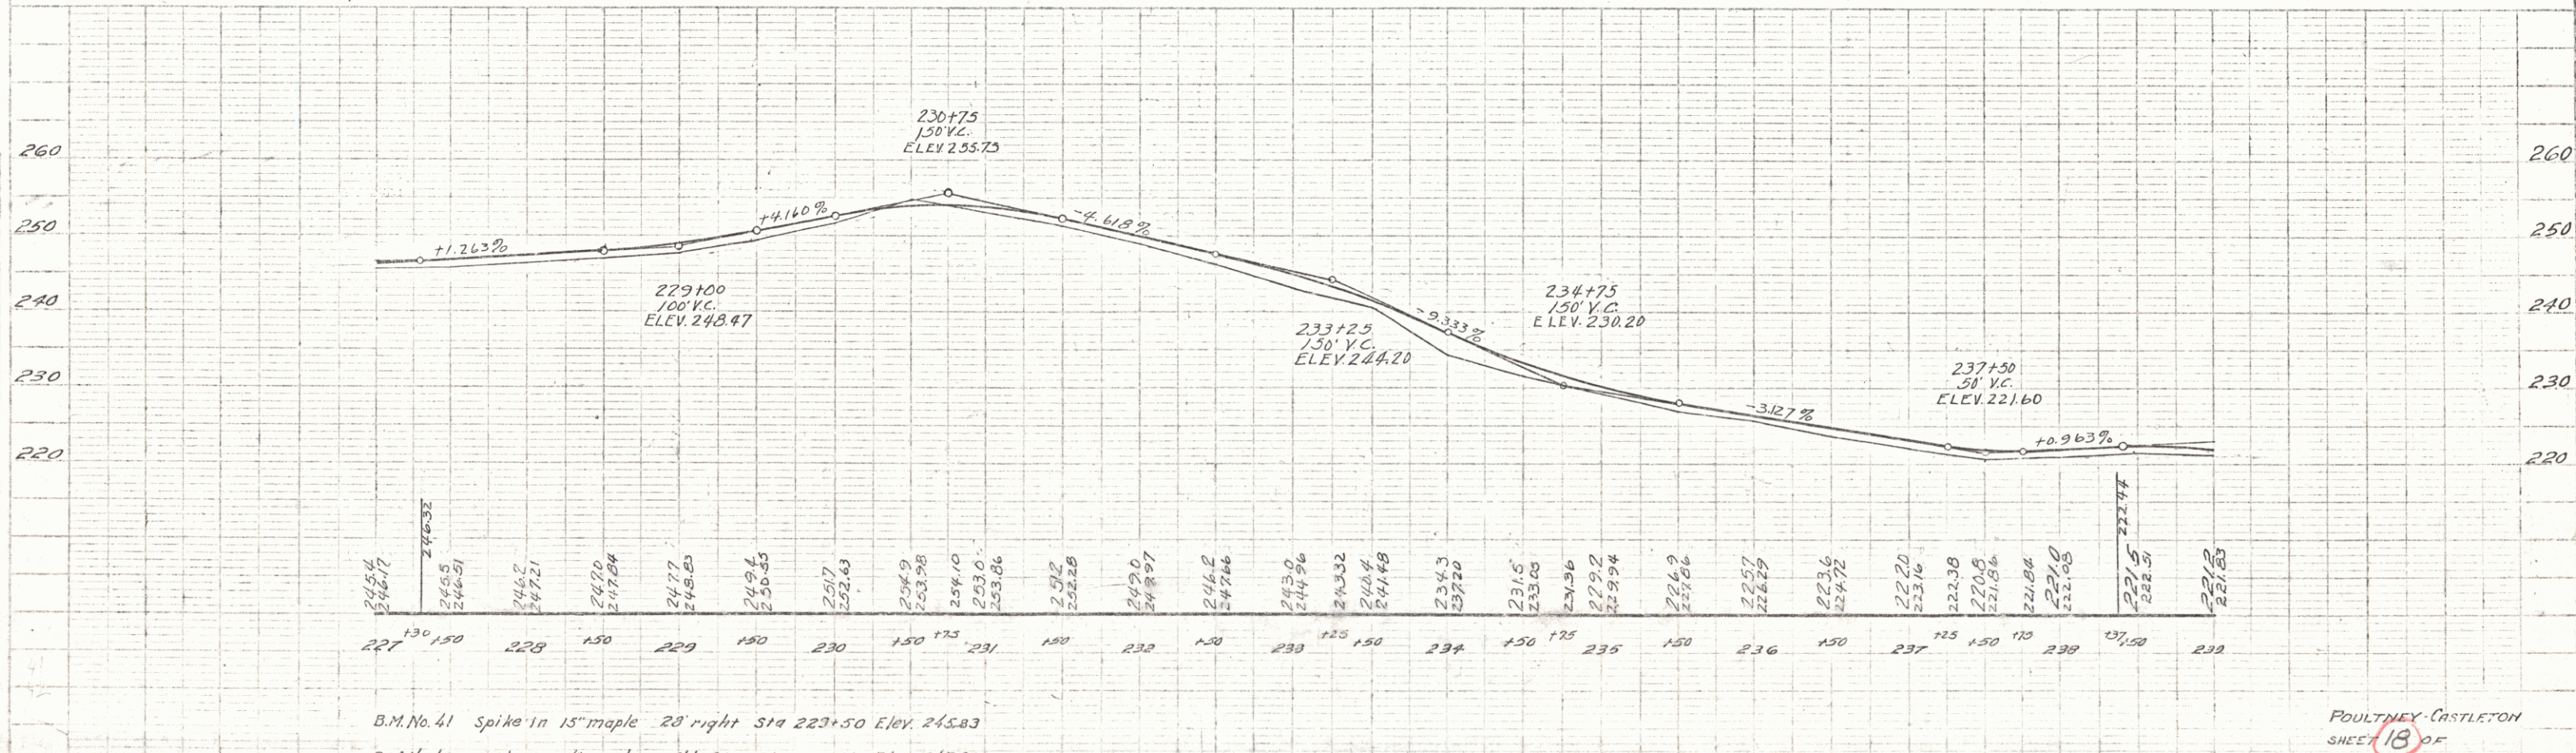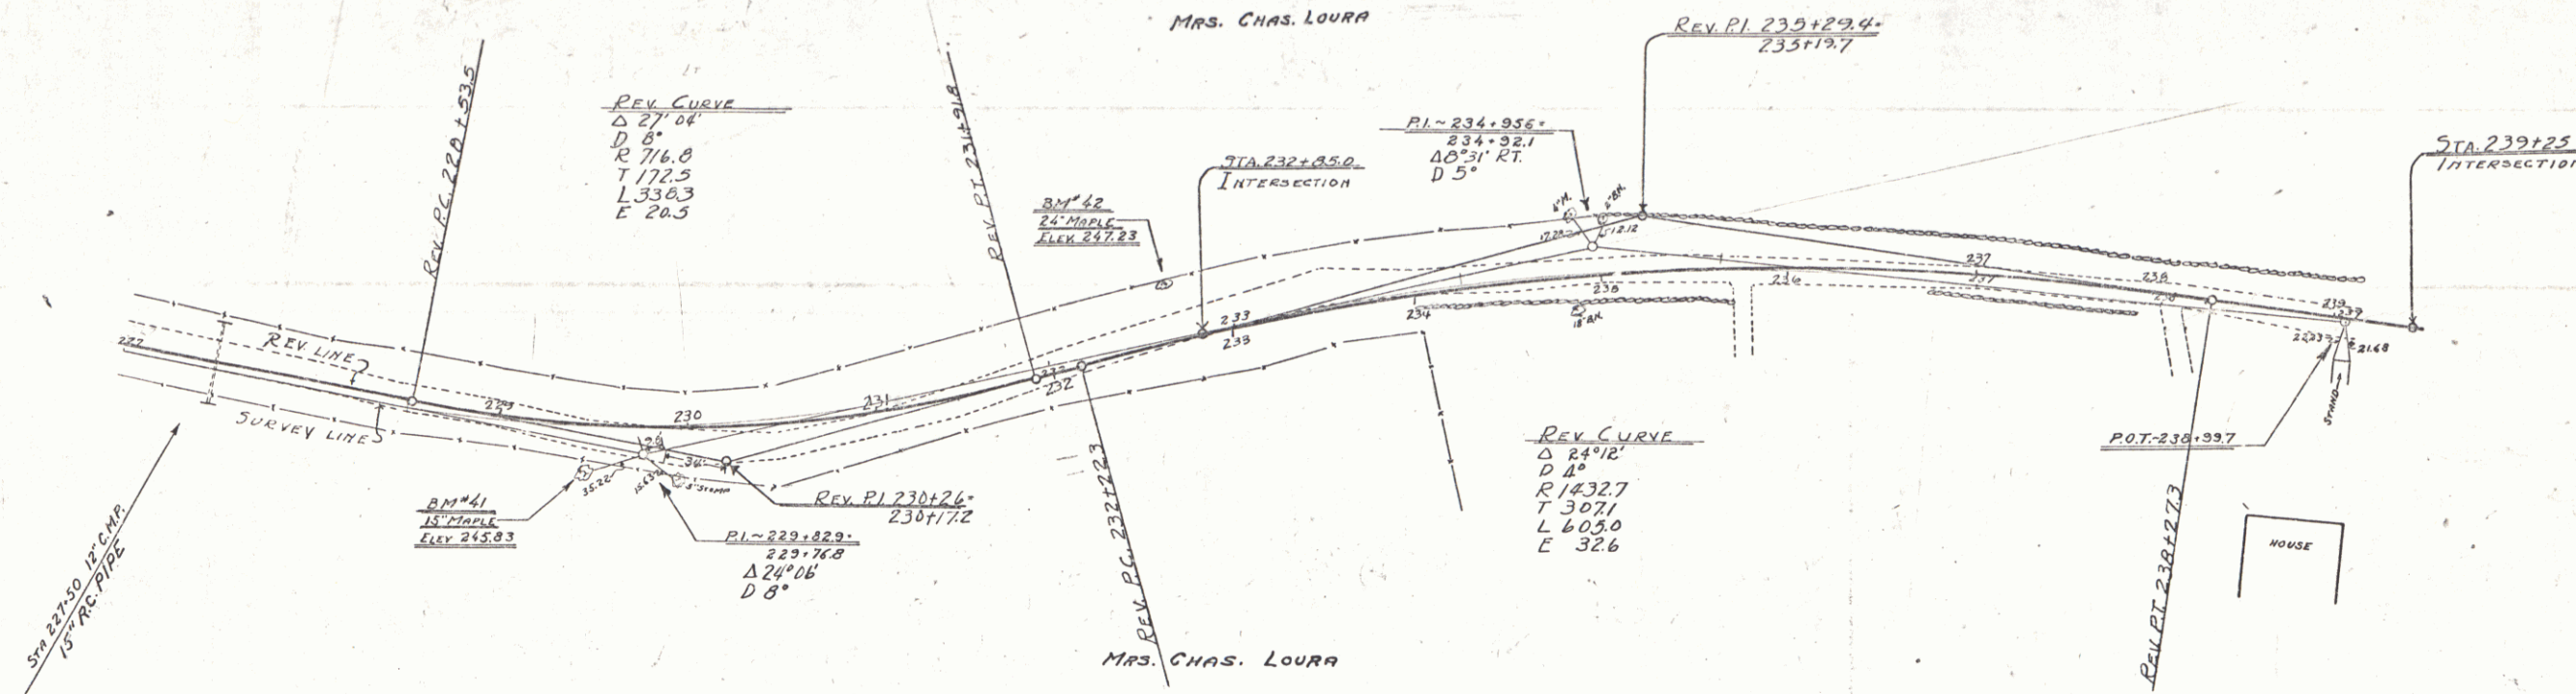

B.M. No. 41 Spike in 15' maple 20' right Sta 229+50 Elev. 245.83
 B.M. No. 42 Spike in 24' maple 26' left Sta 232+71 Elev. 247.23

POULTNEY CASTLETON
 SHEET 13 OF 16



Woodward Rail Required

Culu Sta.	Left	Right
258+24	24'	24'
266+65	24'	24'

New Pine Cong. Pipe Culv. Required

Sta.	Dia.	Length	Conc. C	Steel
258+24	15"	36'	3 cy	33"
266+65	15"	44'	3 cy	33"


FILE NO.	STATE	FILE NO.	STATE	FILE NO.	STATE	FILE NO.	STATE
9	VT.						

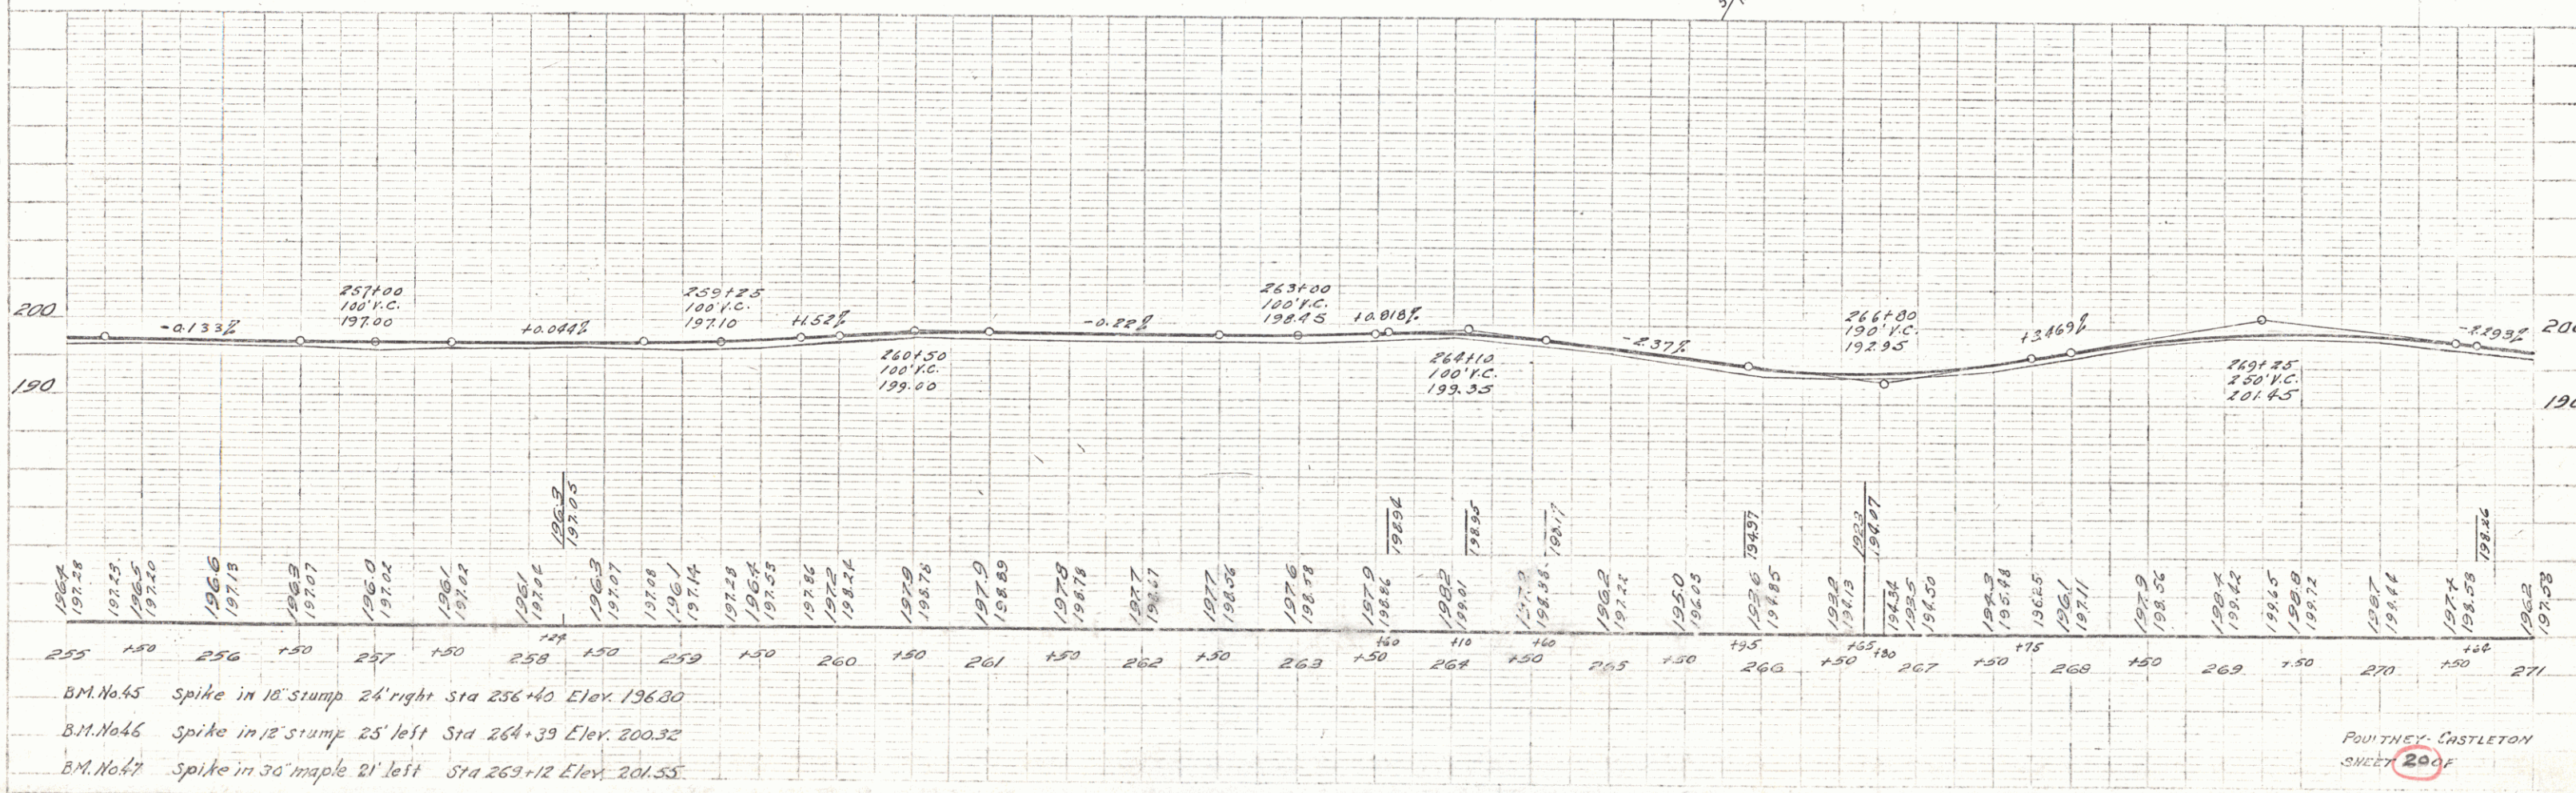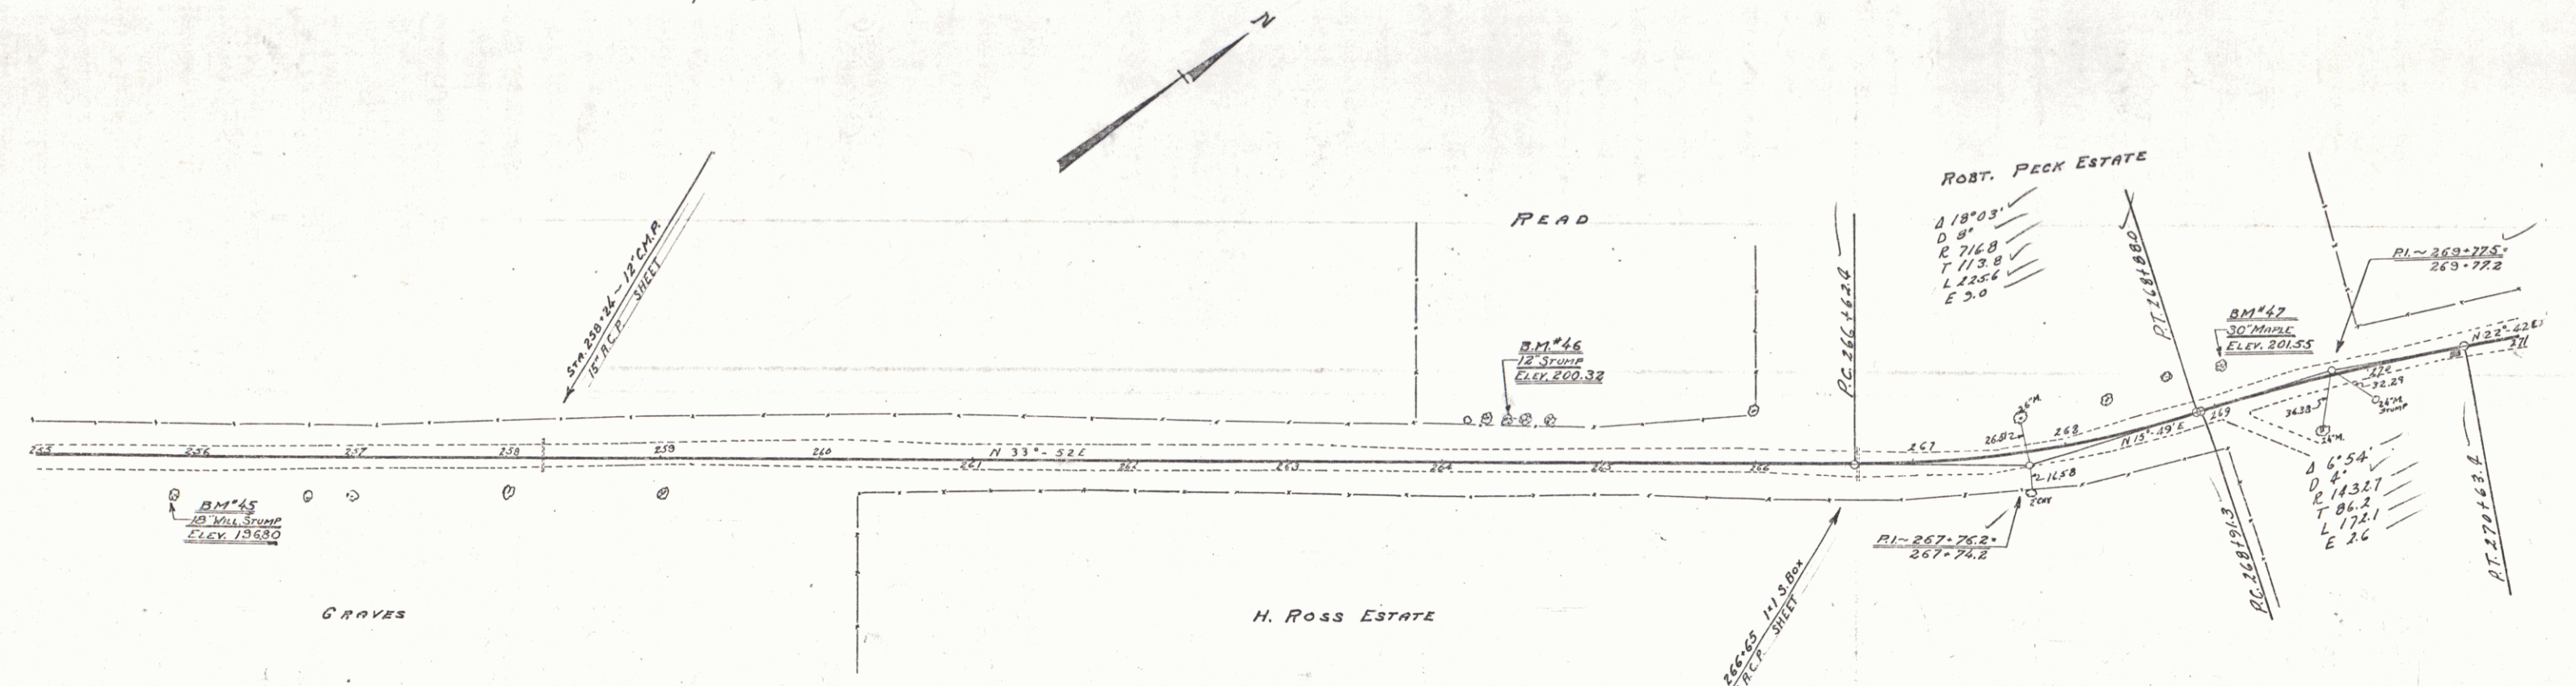

B.M. No. 45 Spike in 10' stump 24' right Sta 256+40 Elev. 196.80
 B.M. No. 46 Spike in 12' stump 25' left Sta 264+39 Elev. 200.32
 B.M. No. 47 Spike in 30' maple 21' left Sta 269+12 Elev. 201.55

POUTNEY CASTLETON
SHEET 200

RD NO.	STATE	FILE NO.	FISCAL YEAR	SHEET NO.	TOTAL SHEETS
9	VT.				

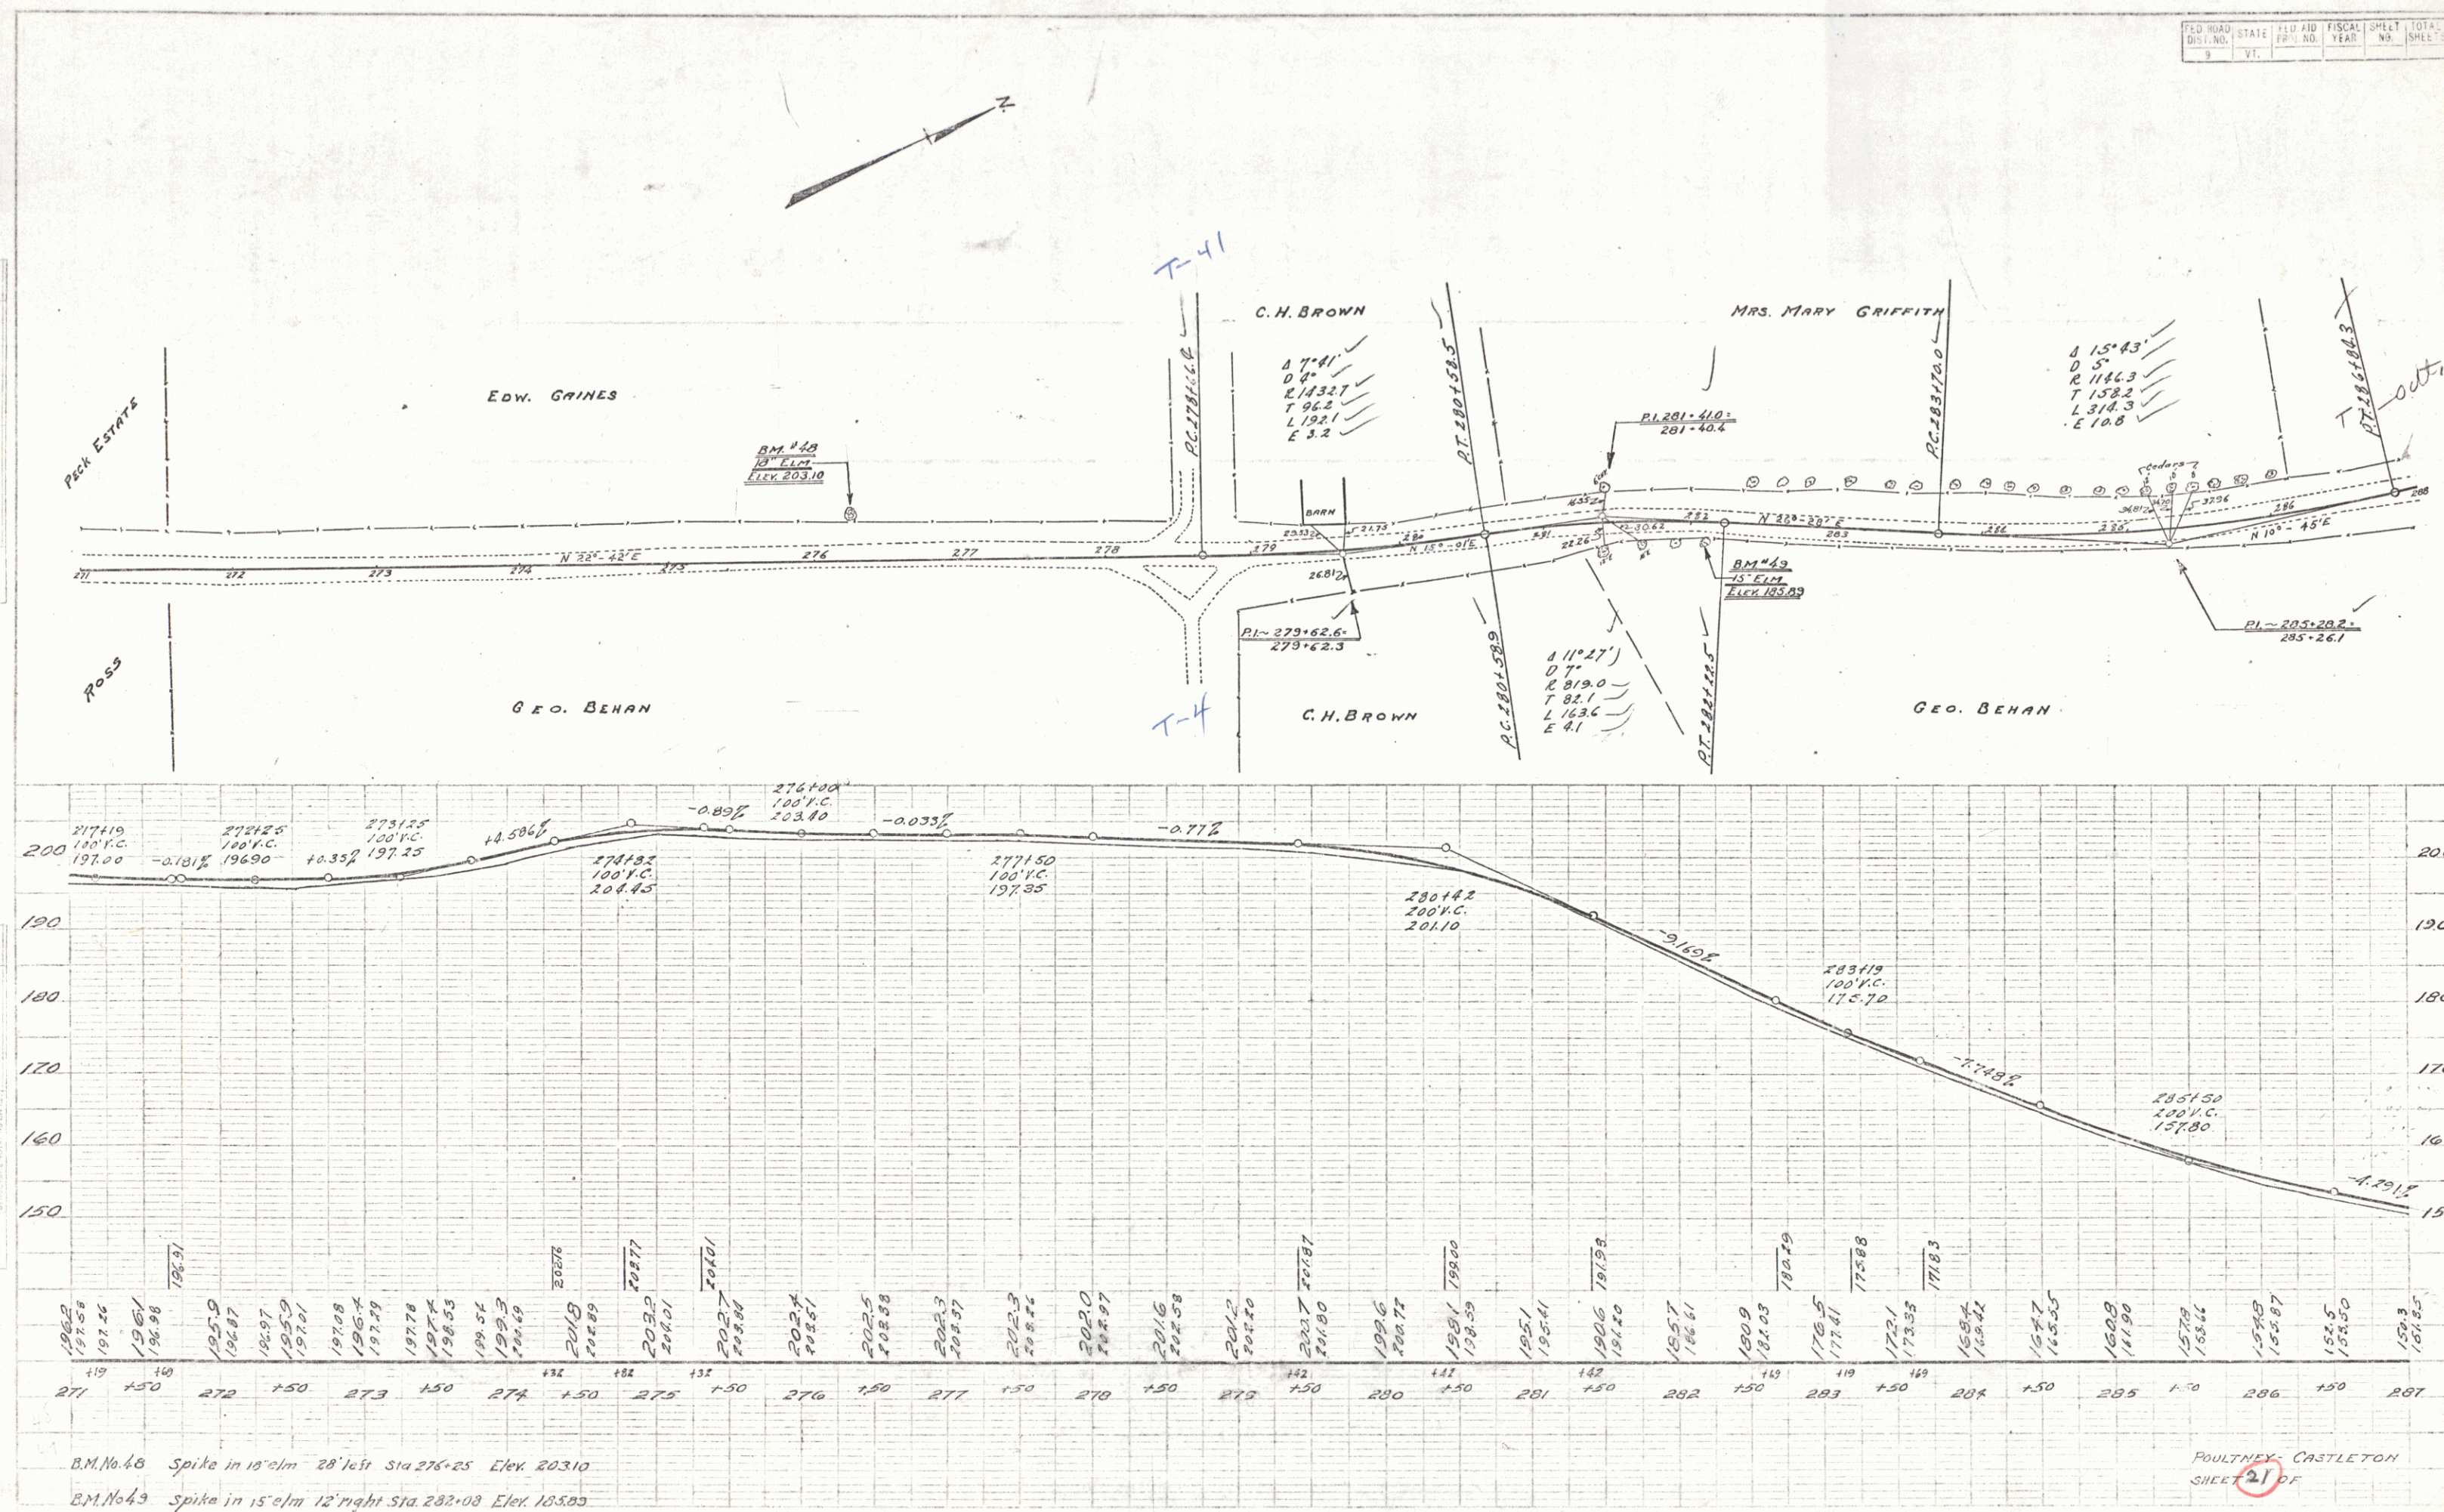

POULTNEY, CASTLETON
SHEET 21 OF

FED. ROAD DIST. NO.	STATE	F.D. NO.	FISCAL YEAR	SHEET NO.	TOTAL SHEETS
9	Vt.			22	25



179-60
2.223
145-17
78-37
15-21


FRED REYNOLDS

GEO. BEHAN

HARRY LOOMIS

PLAN	DATE	BY	CHECKED
NOTE BOOK			
REVISIONS			

0
Slope
143.35

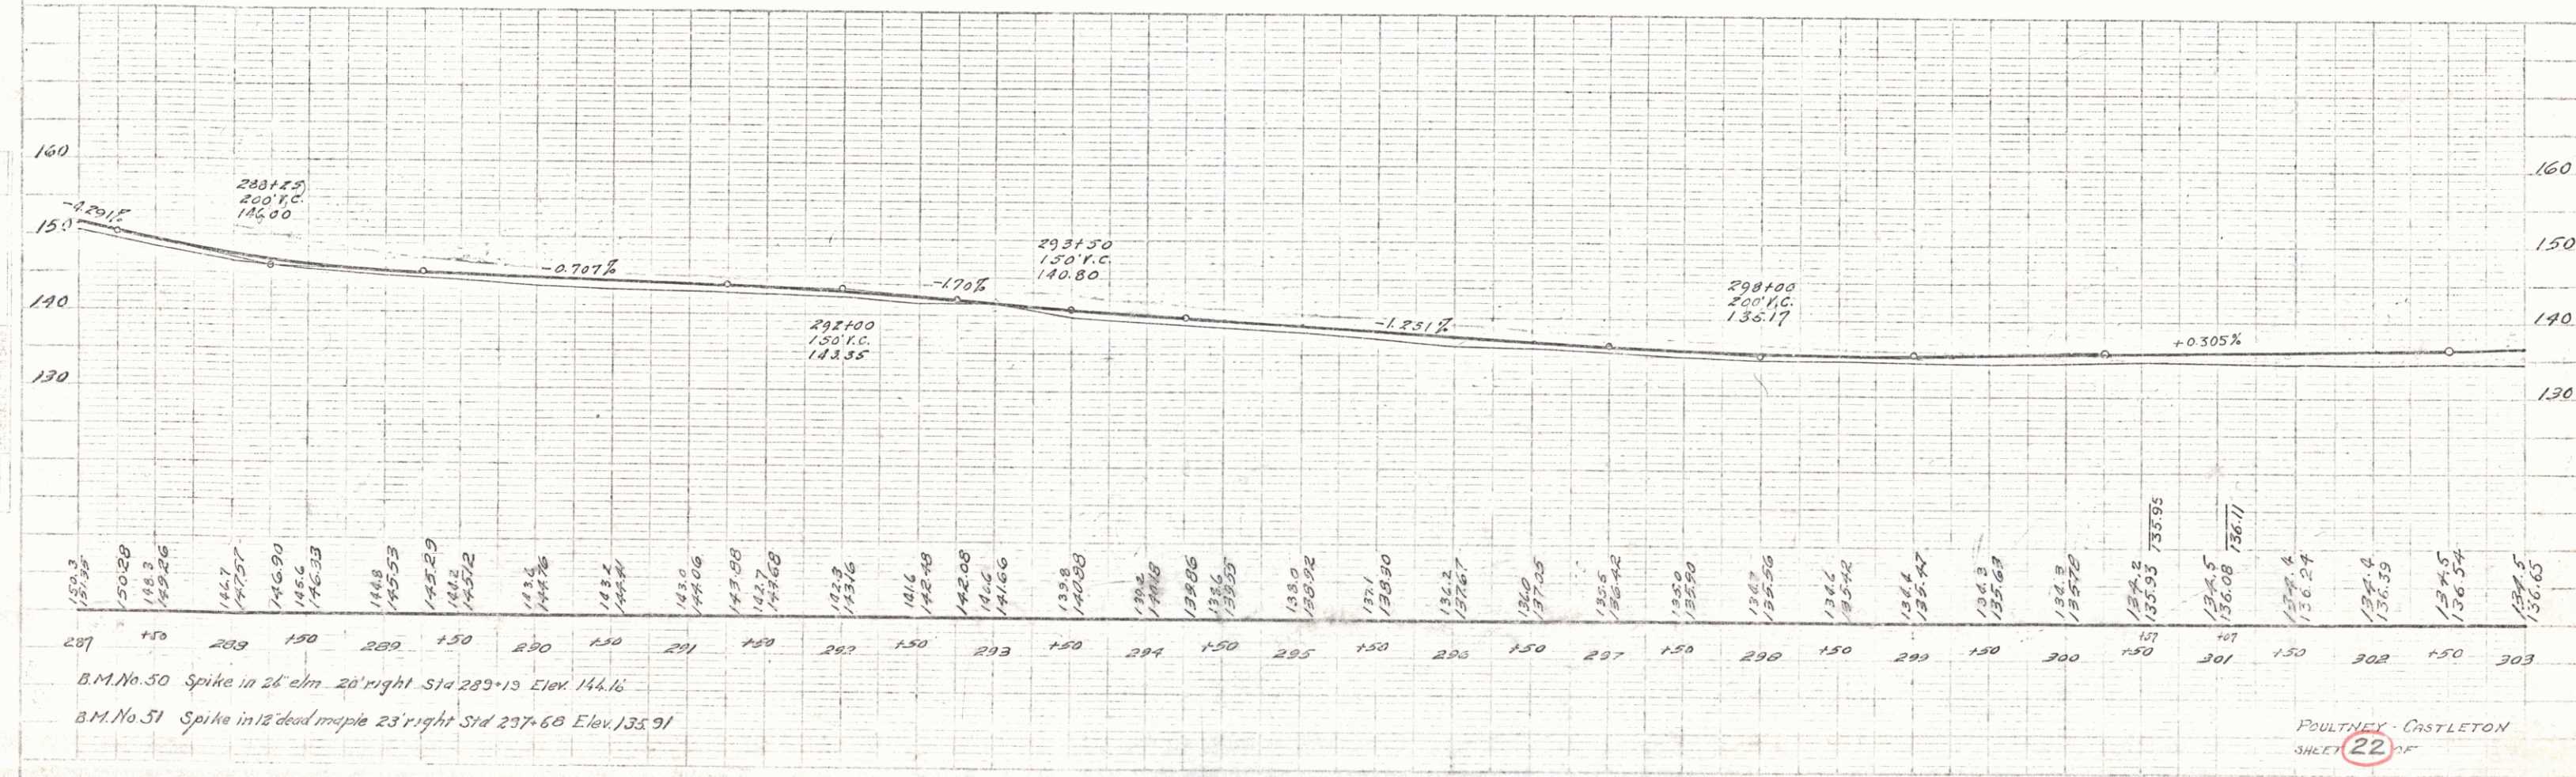

B.M. No. 30 Spike in 26 elm 20' right Sta 289+13 Elev 144.16
B.M. No. 51 Spike in 12 dead maple 23' right Sta 297+60 Elev 135.91

POULTNEY - CASTLETON
SHEET 22 OF 25

CABLE GUARD RAIL REQUIRED

Culv Sta.	Left	Right
301+38	48'	48'
Constant	10'	10'
TOTAL	88'	88'


NEW REIN. CONC. BOX CULV. REQUIRED



Sta.	Size	Conc. A	Steel	Struct. Etc.
301+38	10'x4'	46 cu.	3660 lb.	5000

FED. ROAD DIST. NO.	STATE	FED. AID PROJ. NO.	LOCAL PROJ. NO.	SHEET NO.	TOTAL SHEETS
9	VT.			23	24

PLAN
NOTES
1. ALL WORK SHALL BE DONE IN ACCORDANCE WITH THE LATEST EDITIONS OF THE STANDARD SPECIFICATIONS FOR HIGHWAY CONSTRUCTION, AS ADOPTED BY THE BOARD OF SUPERVISORS OF THE STATE OF VERMONT.

CHAS. E. BROWN
5/2/23

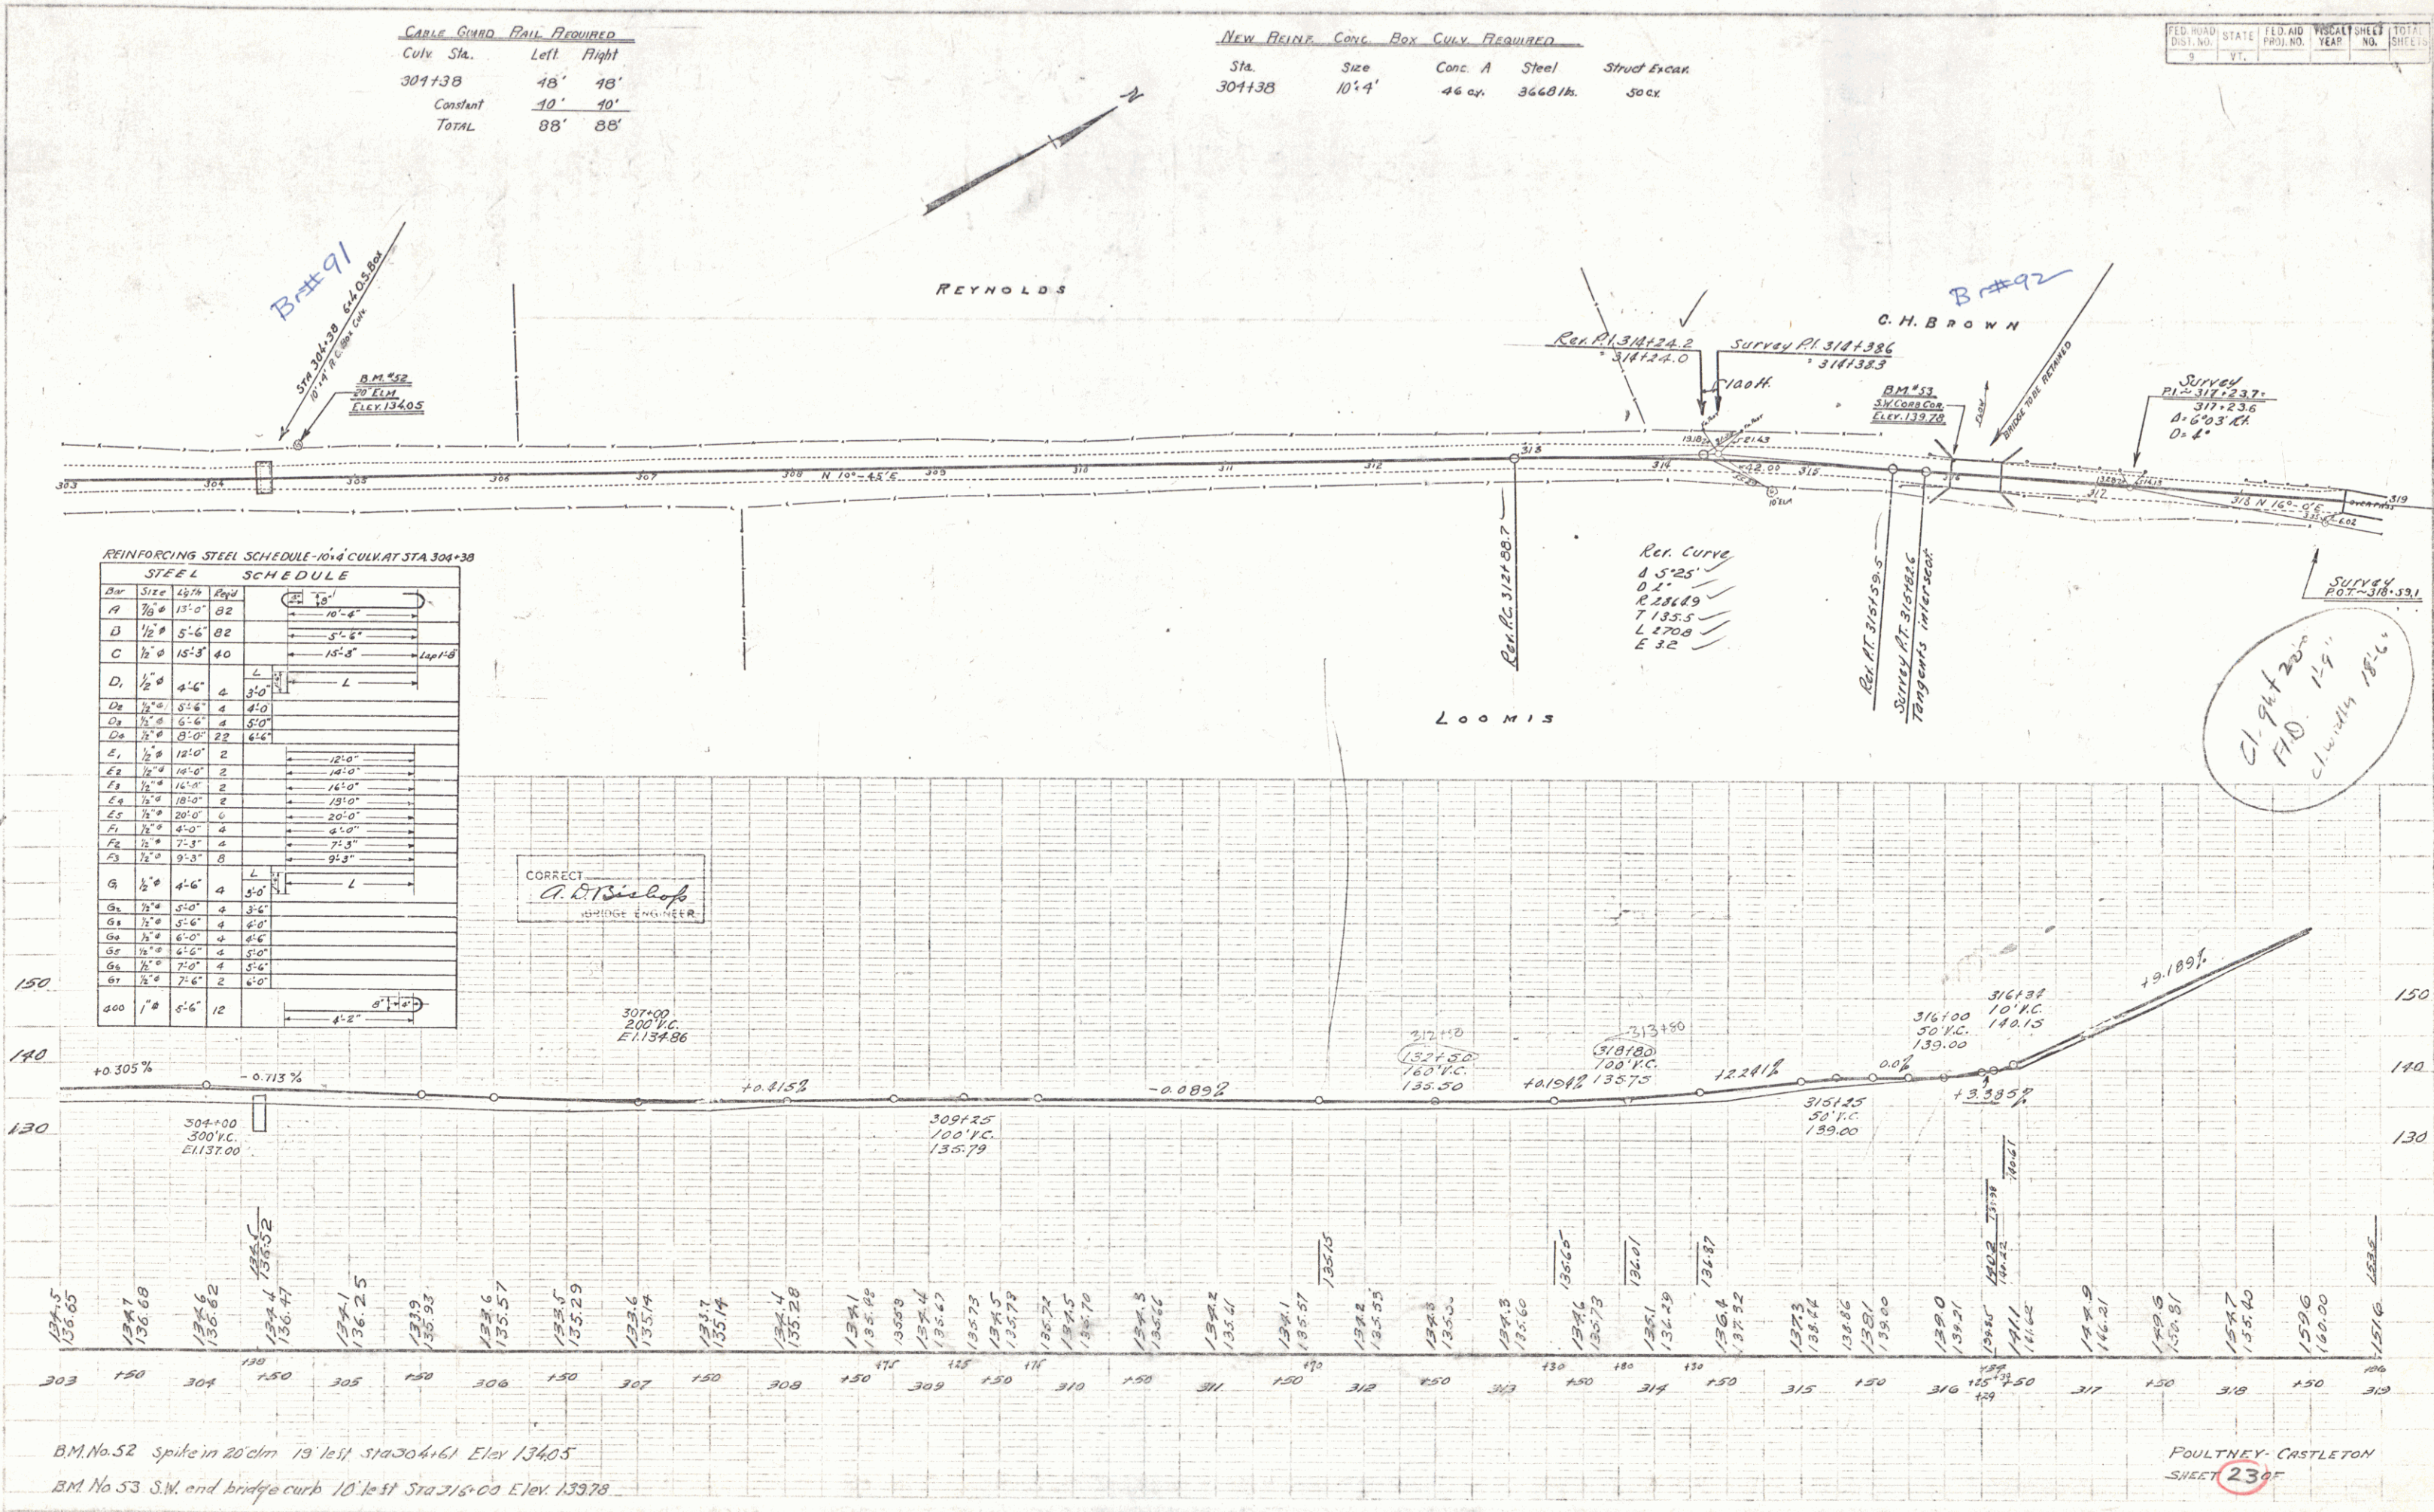

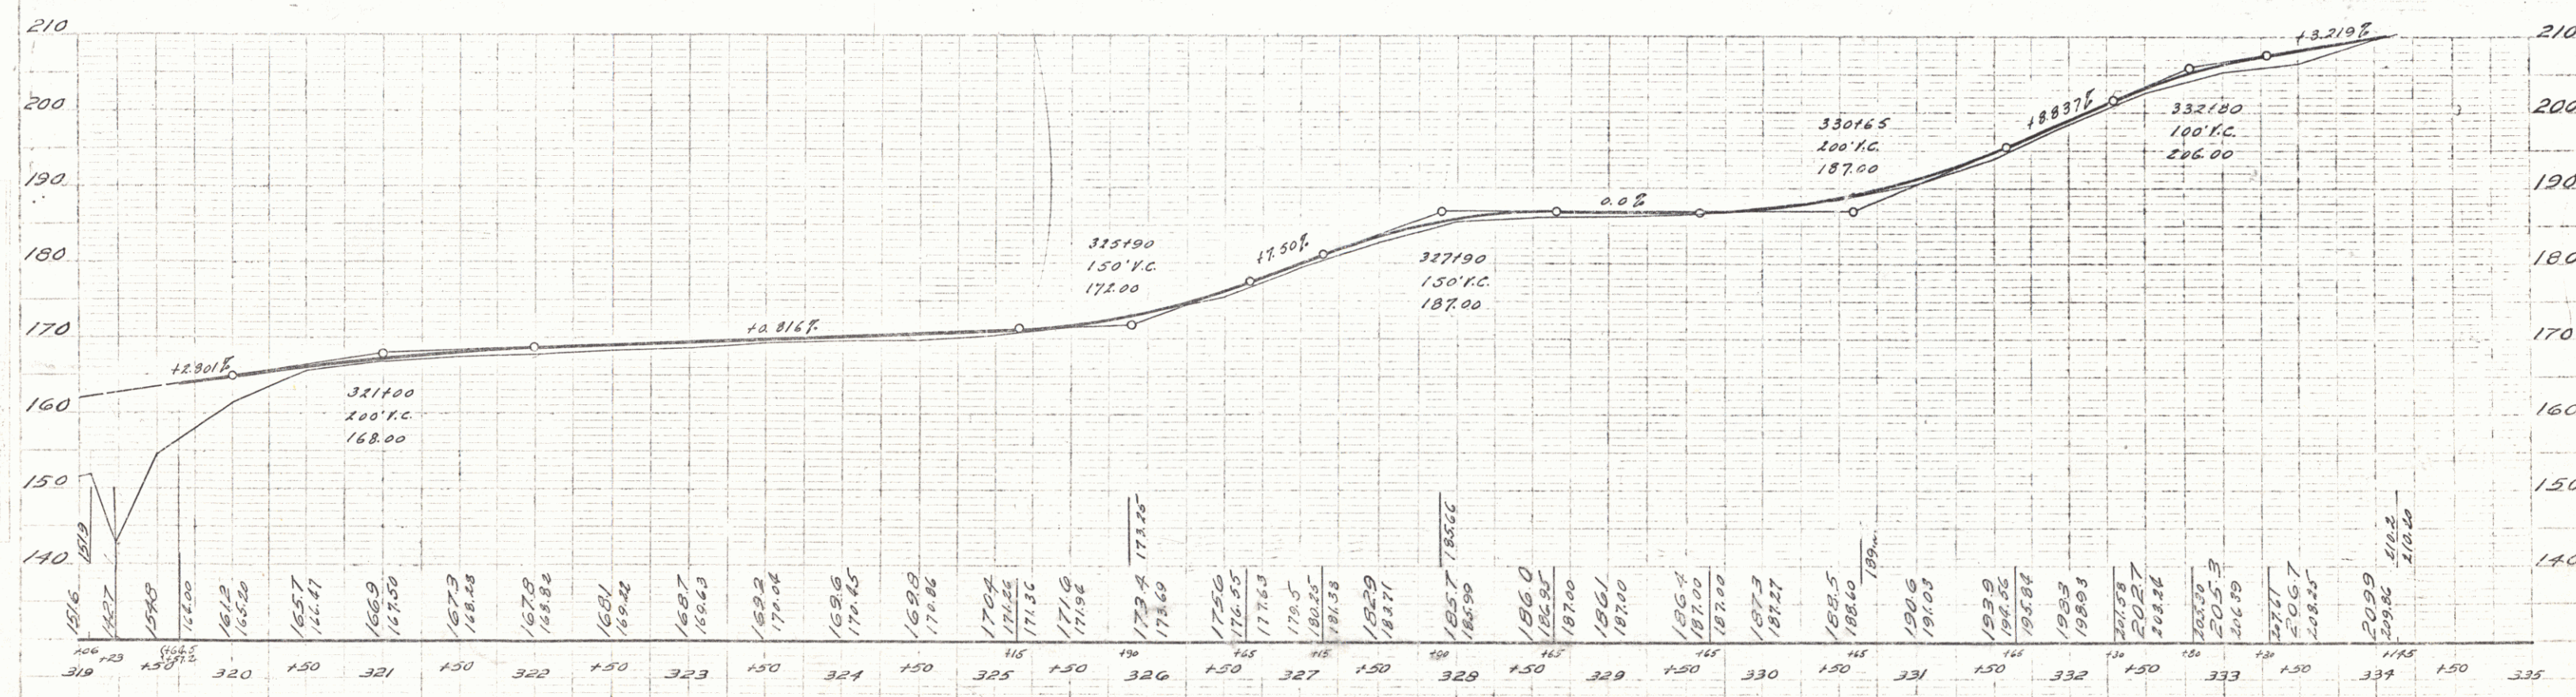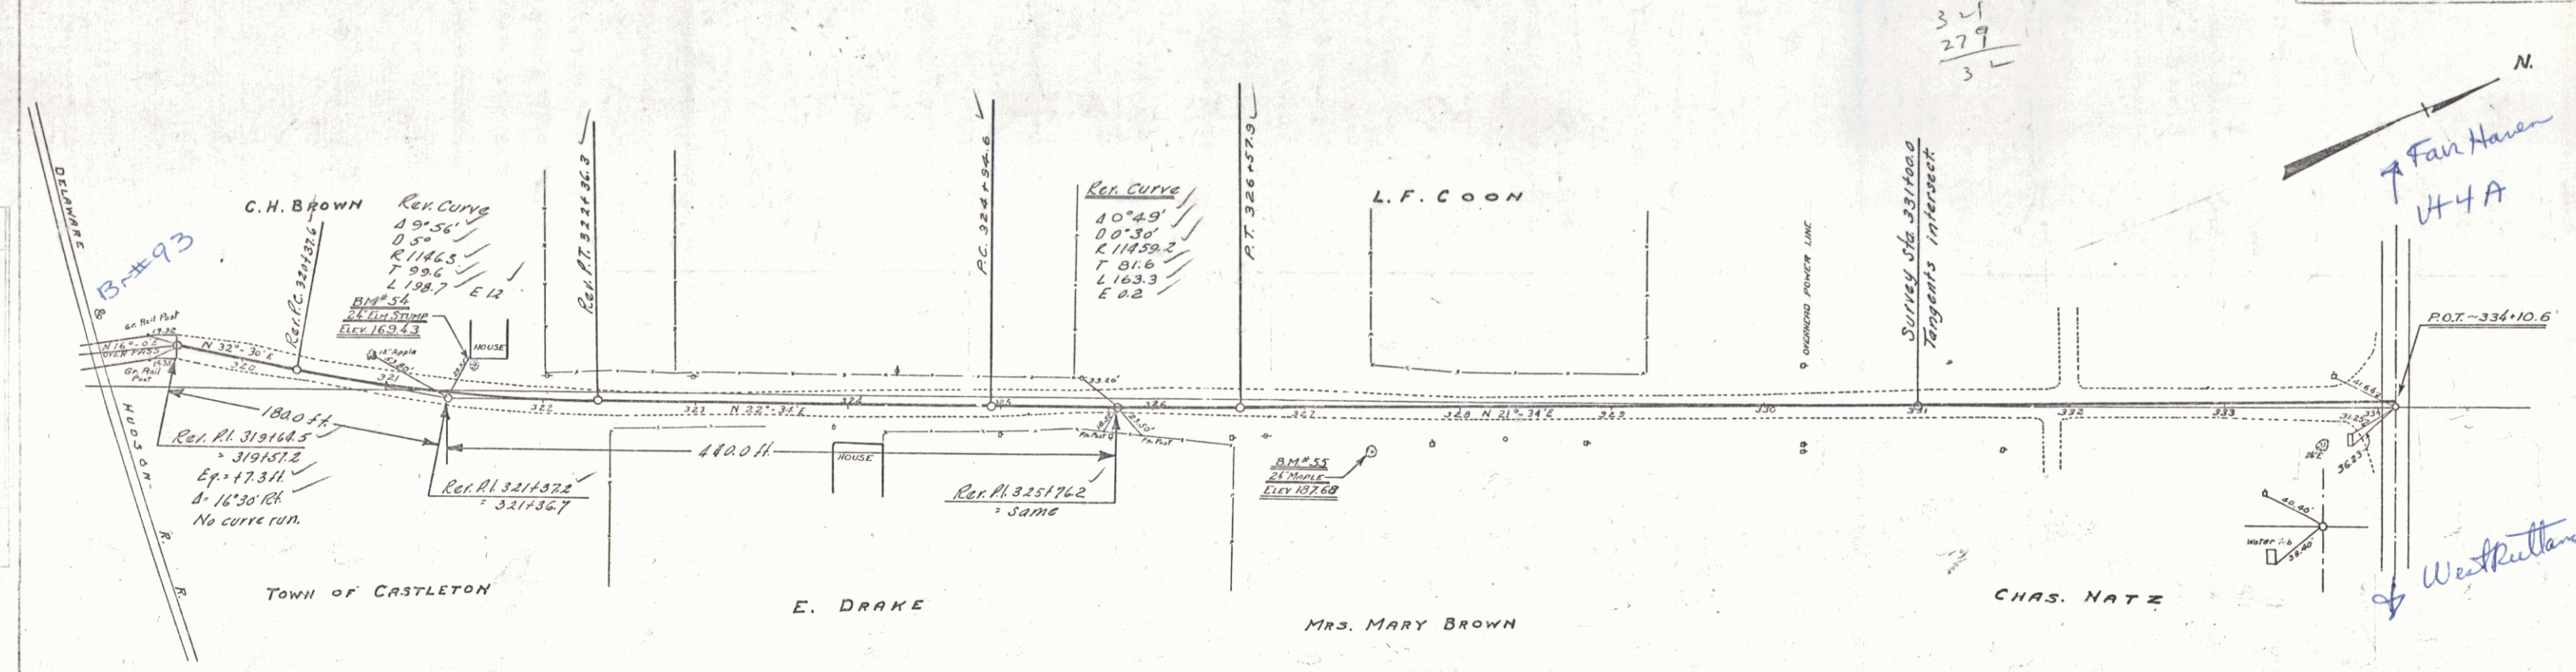

B.M. No. 54 Spike in 24' elm stump 13' left Sta 321+58 Elev 169.43
 B.M. No. 55 Spike in 24' maple 32' right Sta 327+43 Elev 187.68
 B.M. No. 56 SW. Cor. Gulf Gas Pump foundation Elev. 209.63 B.M. No. 16 Castleton-Fair Haven Road