

INDEX OF SHEETS

SHEET NUMBER	TITLE PAGE
1	TYPICAL CROSS SECTION OF IMPROVEMENT
2	(DOUBLE TACK COAT OF BITUMINOUS MATERIAL WITH PEA STONE AND STONE GRITS SEAL)
3	(PRIME COAT OF REFINED TAR AND DOUBLE SEAL COAT OF CUTBACK ASPHALT, ITEM 315)
4	QUANTITY SHEET (ITEM & DRAINAGE)
5	EARTHWORK SHEET
6	DETAILS OF 15'-10" X 9'-10" CMPPA AT STA. 19+65
7	CHANNEL SECTIONS
8	RS 56-1
9	RS 56-3
10	RS 56-4
11	RS 56-6
12	RS 56-10
13	RS 56-12
14	PLAN & PROFILE
15	CROSS SECTIONS

PROJECT NAME & NUMBER	TYPE	PAVEMENT AREA
CASTLETON - DS-0161(1)	3" CRUSHED GRAVEL PLANT MIXED DOUBLE TACK COAT OF BITUMINOUS MATERIAL WITH PEA STONE AND STONE GRITS SEAL, PRIME COAT OF REFINED TAR, AND DOUBLE SEAL COAT OF CUTBACK ASPHALT	3195 s.y.

RECORD PLANS	MATERIALS
SUBBASE OF GRAVEL - GREER PIT - POULTNEY, VERMONT. CRUSHED GRAVEL (PLANT MIXED) - VT. MARBLE CO. - FLORENCE, VERMONT. CUTBACK ASPHALT - SUGCONY - E. PROVIDENCE, RHODE ISLAND. REFINED TAR - KOPPER PRODUCTS CO. - EVERETT, MASS. ACCG. METAL PIPE - NORTH EASTERN CULVERT CO. - WESTMINSTER, VT. RIPRAP - NORTHROP STATE QUARRY - CASTLETON, VT. TWO CABLE GUARD RAIL - BETHLEHEM STEEL CO. (SPARROWS PT. MD.) WOOD GUIDE POSTS - S.T. GRISWOLD CO. - ESSEX JUNCTION, VERMONT. CONTRACTOR - EARLE & MERRY RESIDENT ENGINEER - ROBERT ARONSON RECORD PLANS - A.G. SPIDLE	CONTRACT NO. 10 - NOVEMBER 20, 1958 CONTRACT STARTED - DECEMBER 8, 1958 CONTRACT COMPLETED - JULY 10, 1959 CONTRACT ACCEPTED - JULY 10, 1959



STATE OF VERMONT DEPARTMENT OF HIGHWAYS

PROPOSED IMPROVEMENT

TOWN OF CASTLETON COUNTY OF RUTLAND VERMONT ROUTE # 30 POULTNEY-MIDDLEBURY ROAD

BEGINNING AT A POINT APPROXIMATELY 3.5 MILES NORTHERLY OF THE
INTERSECTION OF VERMONT ROUTE # 30 AND U.S. ROUTE # 4
IN THE HAMLET OF CASTLETON CORNERS AND EXTENDING
NORTHERLY 0.227 MILES.

LENGTH OF PROJECT 1198.0' FEET = 0.227 MILES

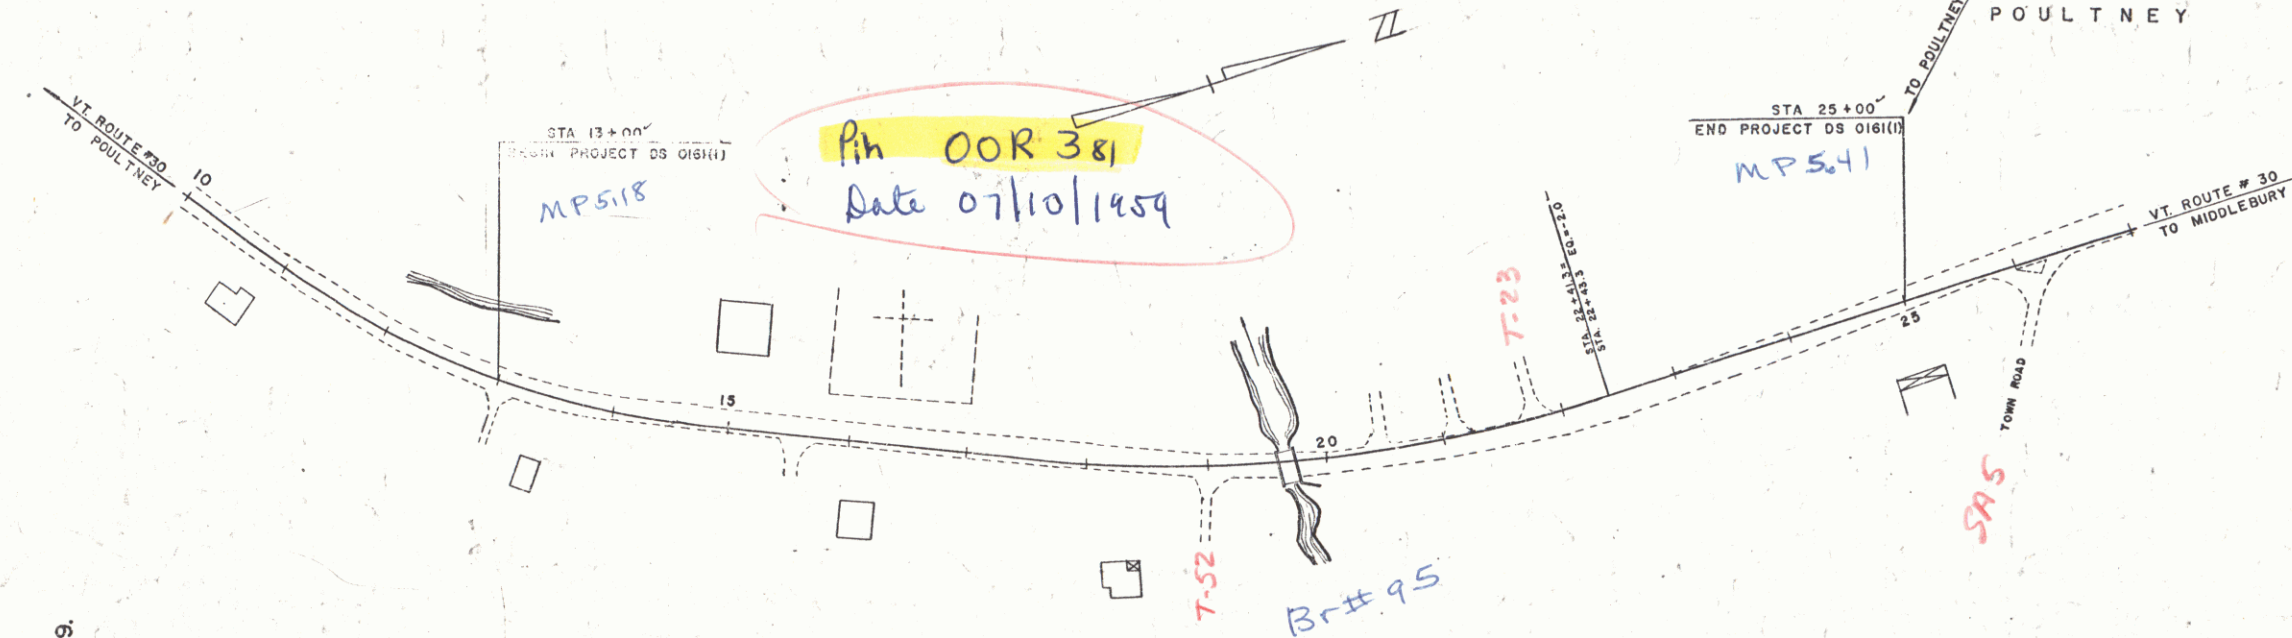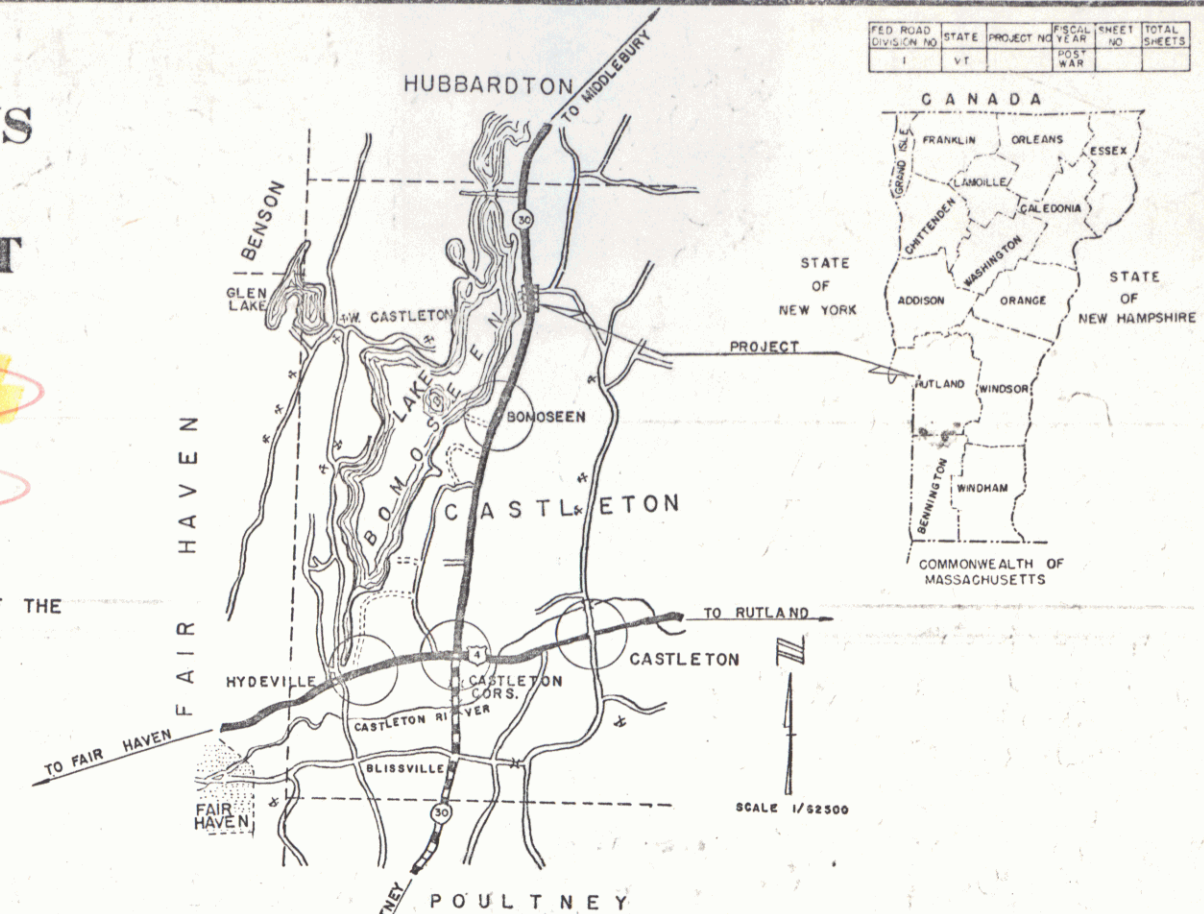

COUNTY	CASTLETON
TOWN	CASTLETON
SECTION	SECTION 0227
DATE	1958
PROJECT	PROJECT DS-0161(1)
CONTRACTOR	EARLE & MERRY INC.
RESIDENT ENGINEER	ROBERT ARONSON
RECORD PLANS	A.G. SPIDLE
DATE	1959
PROJECT	PROJECT DS-0161(1)
CONTRACTOR	EARLE & MERRY INC.
RESIDENT ENGINEER	ROBERT ARONSON
RECORD PLANS	A.G. SPIDLE
DATE	1959

CASTLETON - DS-0161(1)
COUNTY OF RUTLAND
TOWN OF CASTLETON
SECTION 0227
PROJECT DS-0161(1)
COMPLETED - JULY 10, 1959.

GROUND ELEVATION	DATUM	LINE
DEFLECTION OF ANGLE	D	
DEGREE OF CURVE	D	
RADIUS OF CURVE	R	
TANGENT DISTANCE	T	
LENGTH OF CURVE	L	
EXTERNAL DISTANCE	E	
POINT OF INTERSECTION	P.I.	
POINT OF CURVE	P.C.	
POINT OF TANGENT	P.T.	
POINT ON TANGENT	P.O.T.	
POINT ON SUB-TANGENT	P.O.S.T.	

SCALES	TITLE
1" = 80'	TITLE
1" = 2'	TYPICAL
1" = 50'	PLAN
1" = 50'	PROFILE HORIZONTAL
1" = 10'	PROFILE VERTICAL
1" = 50'	CROSS SECTIONS


APPROVED	DATE	APPROVED	DATE	APPROVED	DATE	APPROVED	DATE	APPROVED	DATE	APPROVED	DATE
Secondary Engineer	Aug 18 1958	Construction Engineer	Aug 18 1958	Bridge Engineer	Aug 18 1958	District Engineer	7/23/58	Highway Engineer	Aug 18 1958	Chief Engineer	Aug 18 1958

NOTE: ANY FURTHER INFORMATION CONCERNING
FINAL QUANTITIES, AMOUNTS OR OTHER DATA
RELATIVE TO THIS PROJECT MAY BE OBTAINED
EITHER THE FIELD BOOKS OR THE ESTIMATE
FILE.

DEPARTMENT OF COMMERCE BUREAU OF PUBLIC ROADS	
APPROVED	DATE
DISTRICT ENGINEER	
PROJECT DS NO 0161(1)	
SHEET 1 OF 20 SHEETS	


PLAN
DATE
BY
CHECKED
DATE
BY

PLAN
DATE
BY
CHECKED
DATE
BY

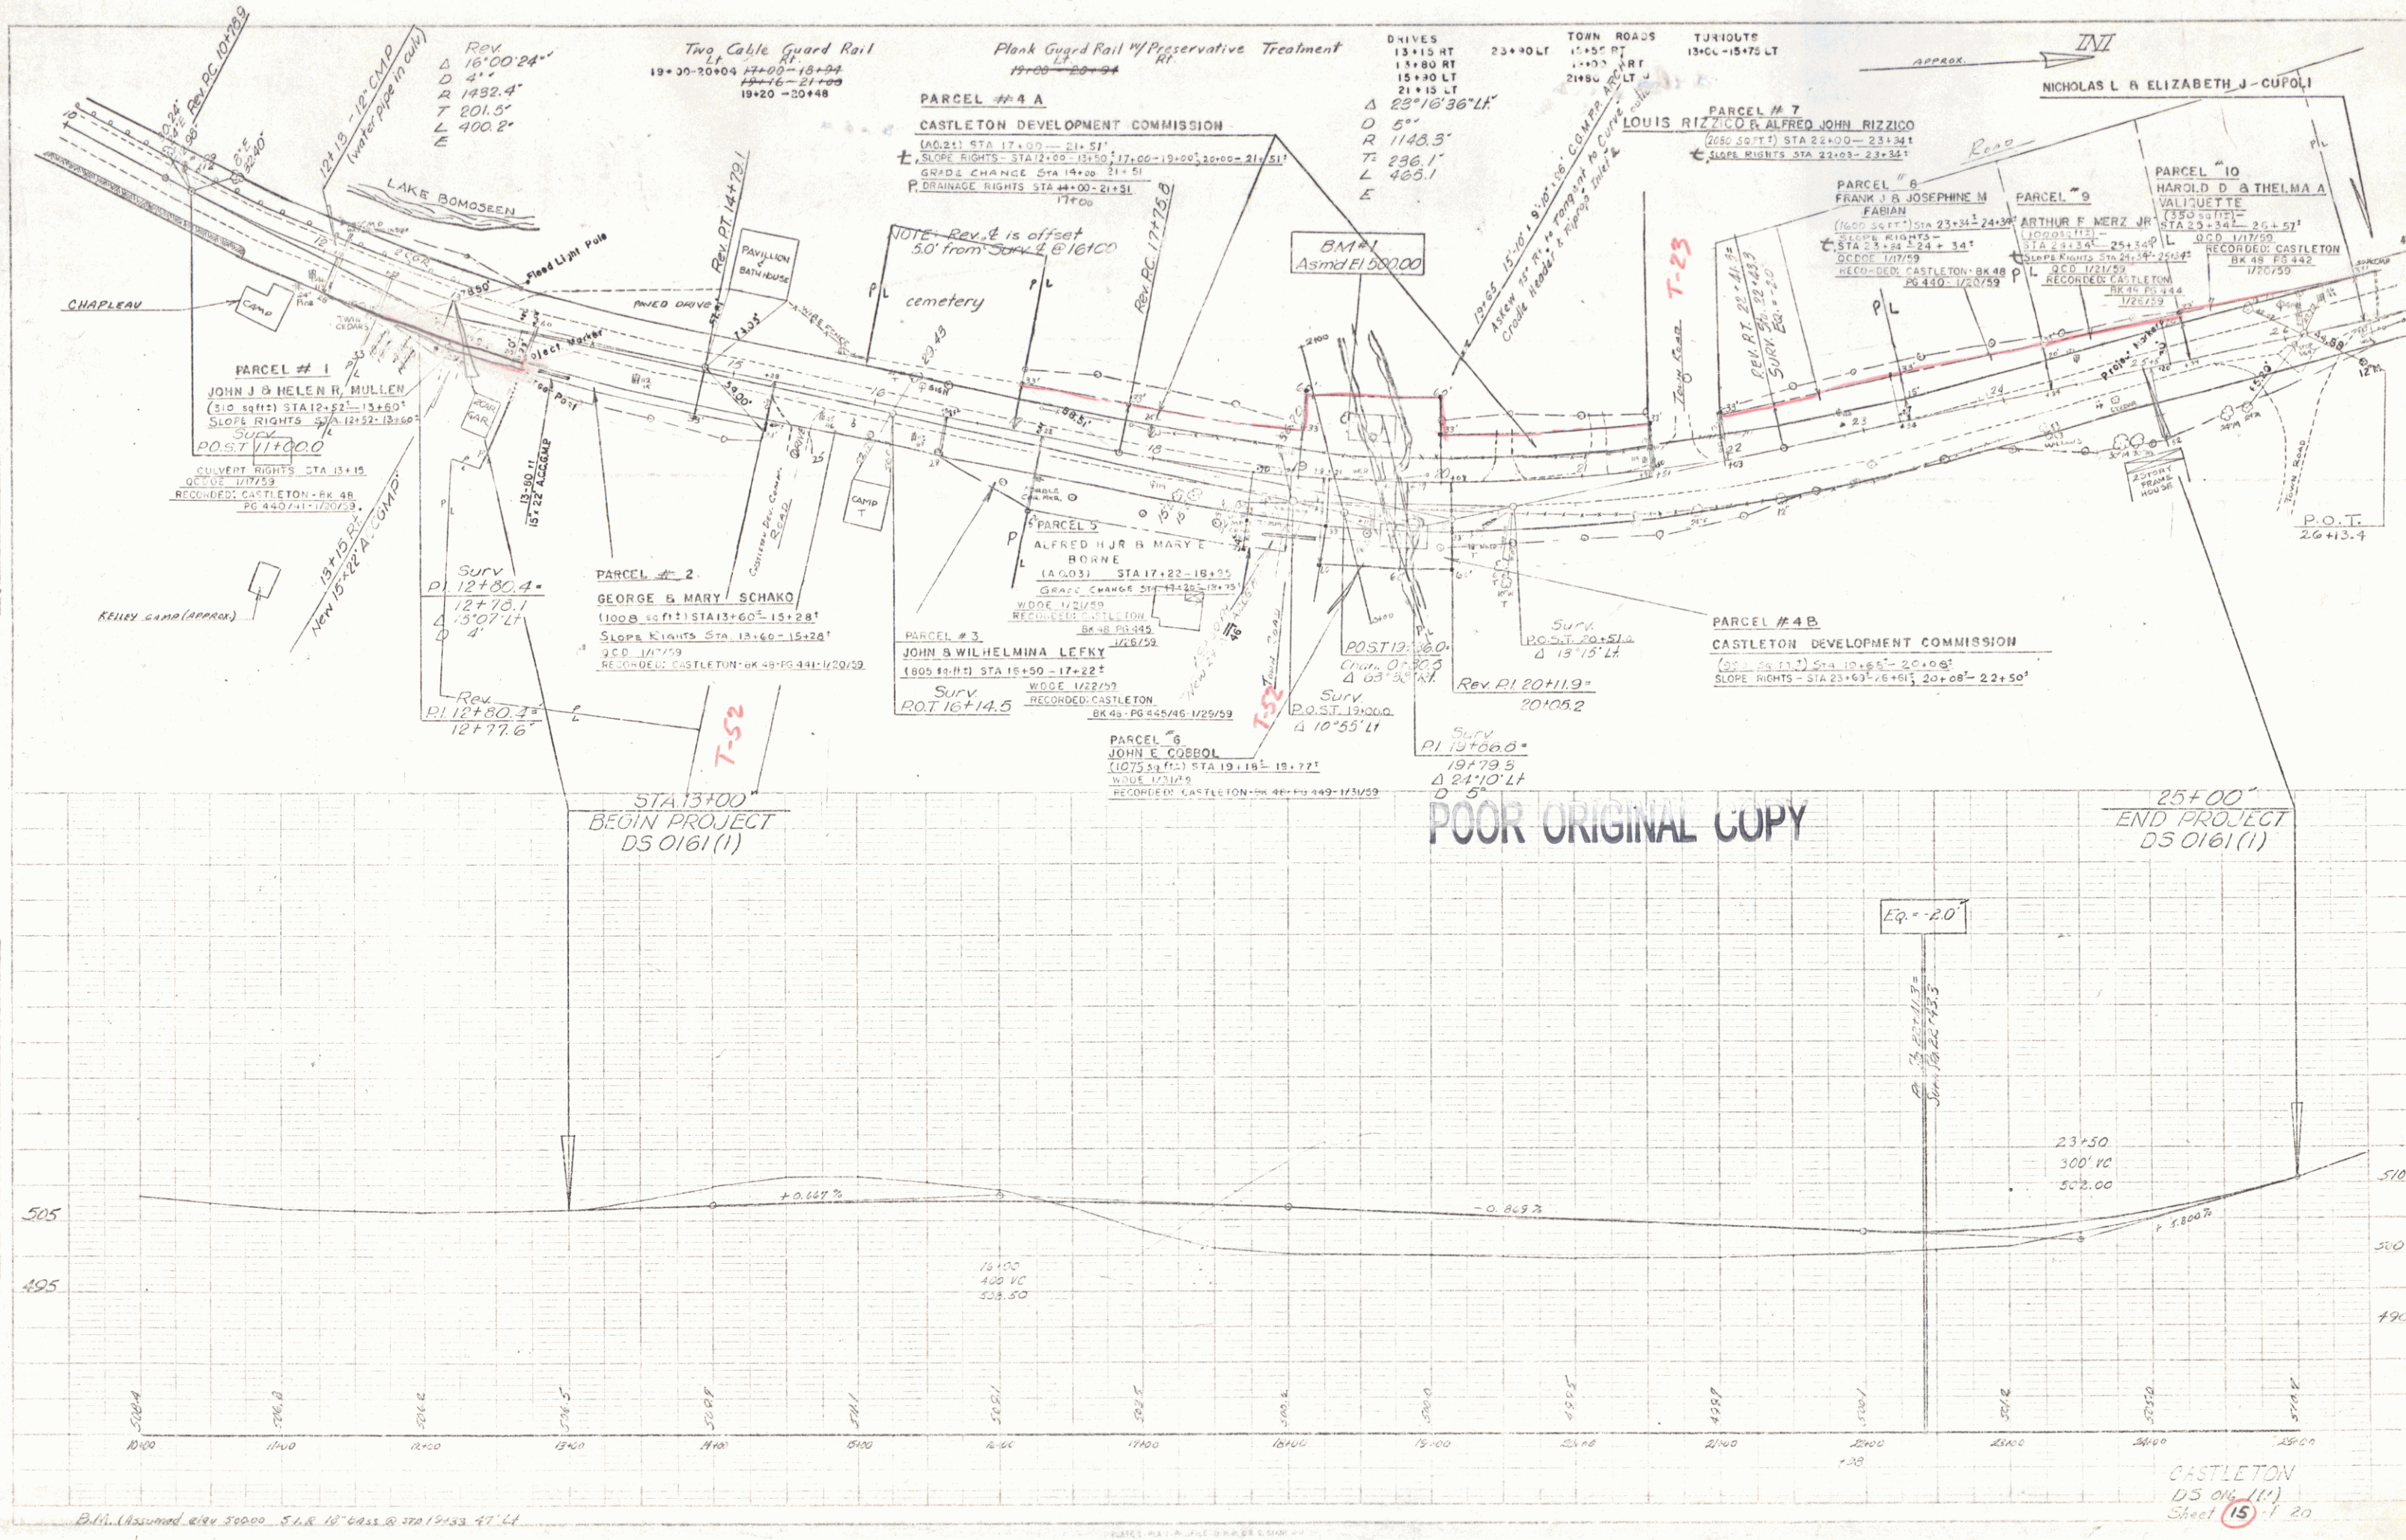

PLAN	DATE	6-28
BY	NAME	ABH
CHECKED	NAME	
DATE	DATE	
NO.	NO.	

PLAN	DATE	6-28
BY	NAME	ABH
CHECKED	NAME	
DATE	DATE	
NO.	NO.	

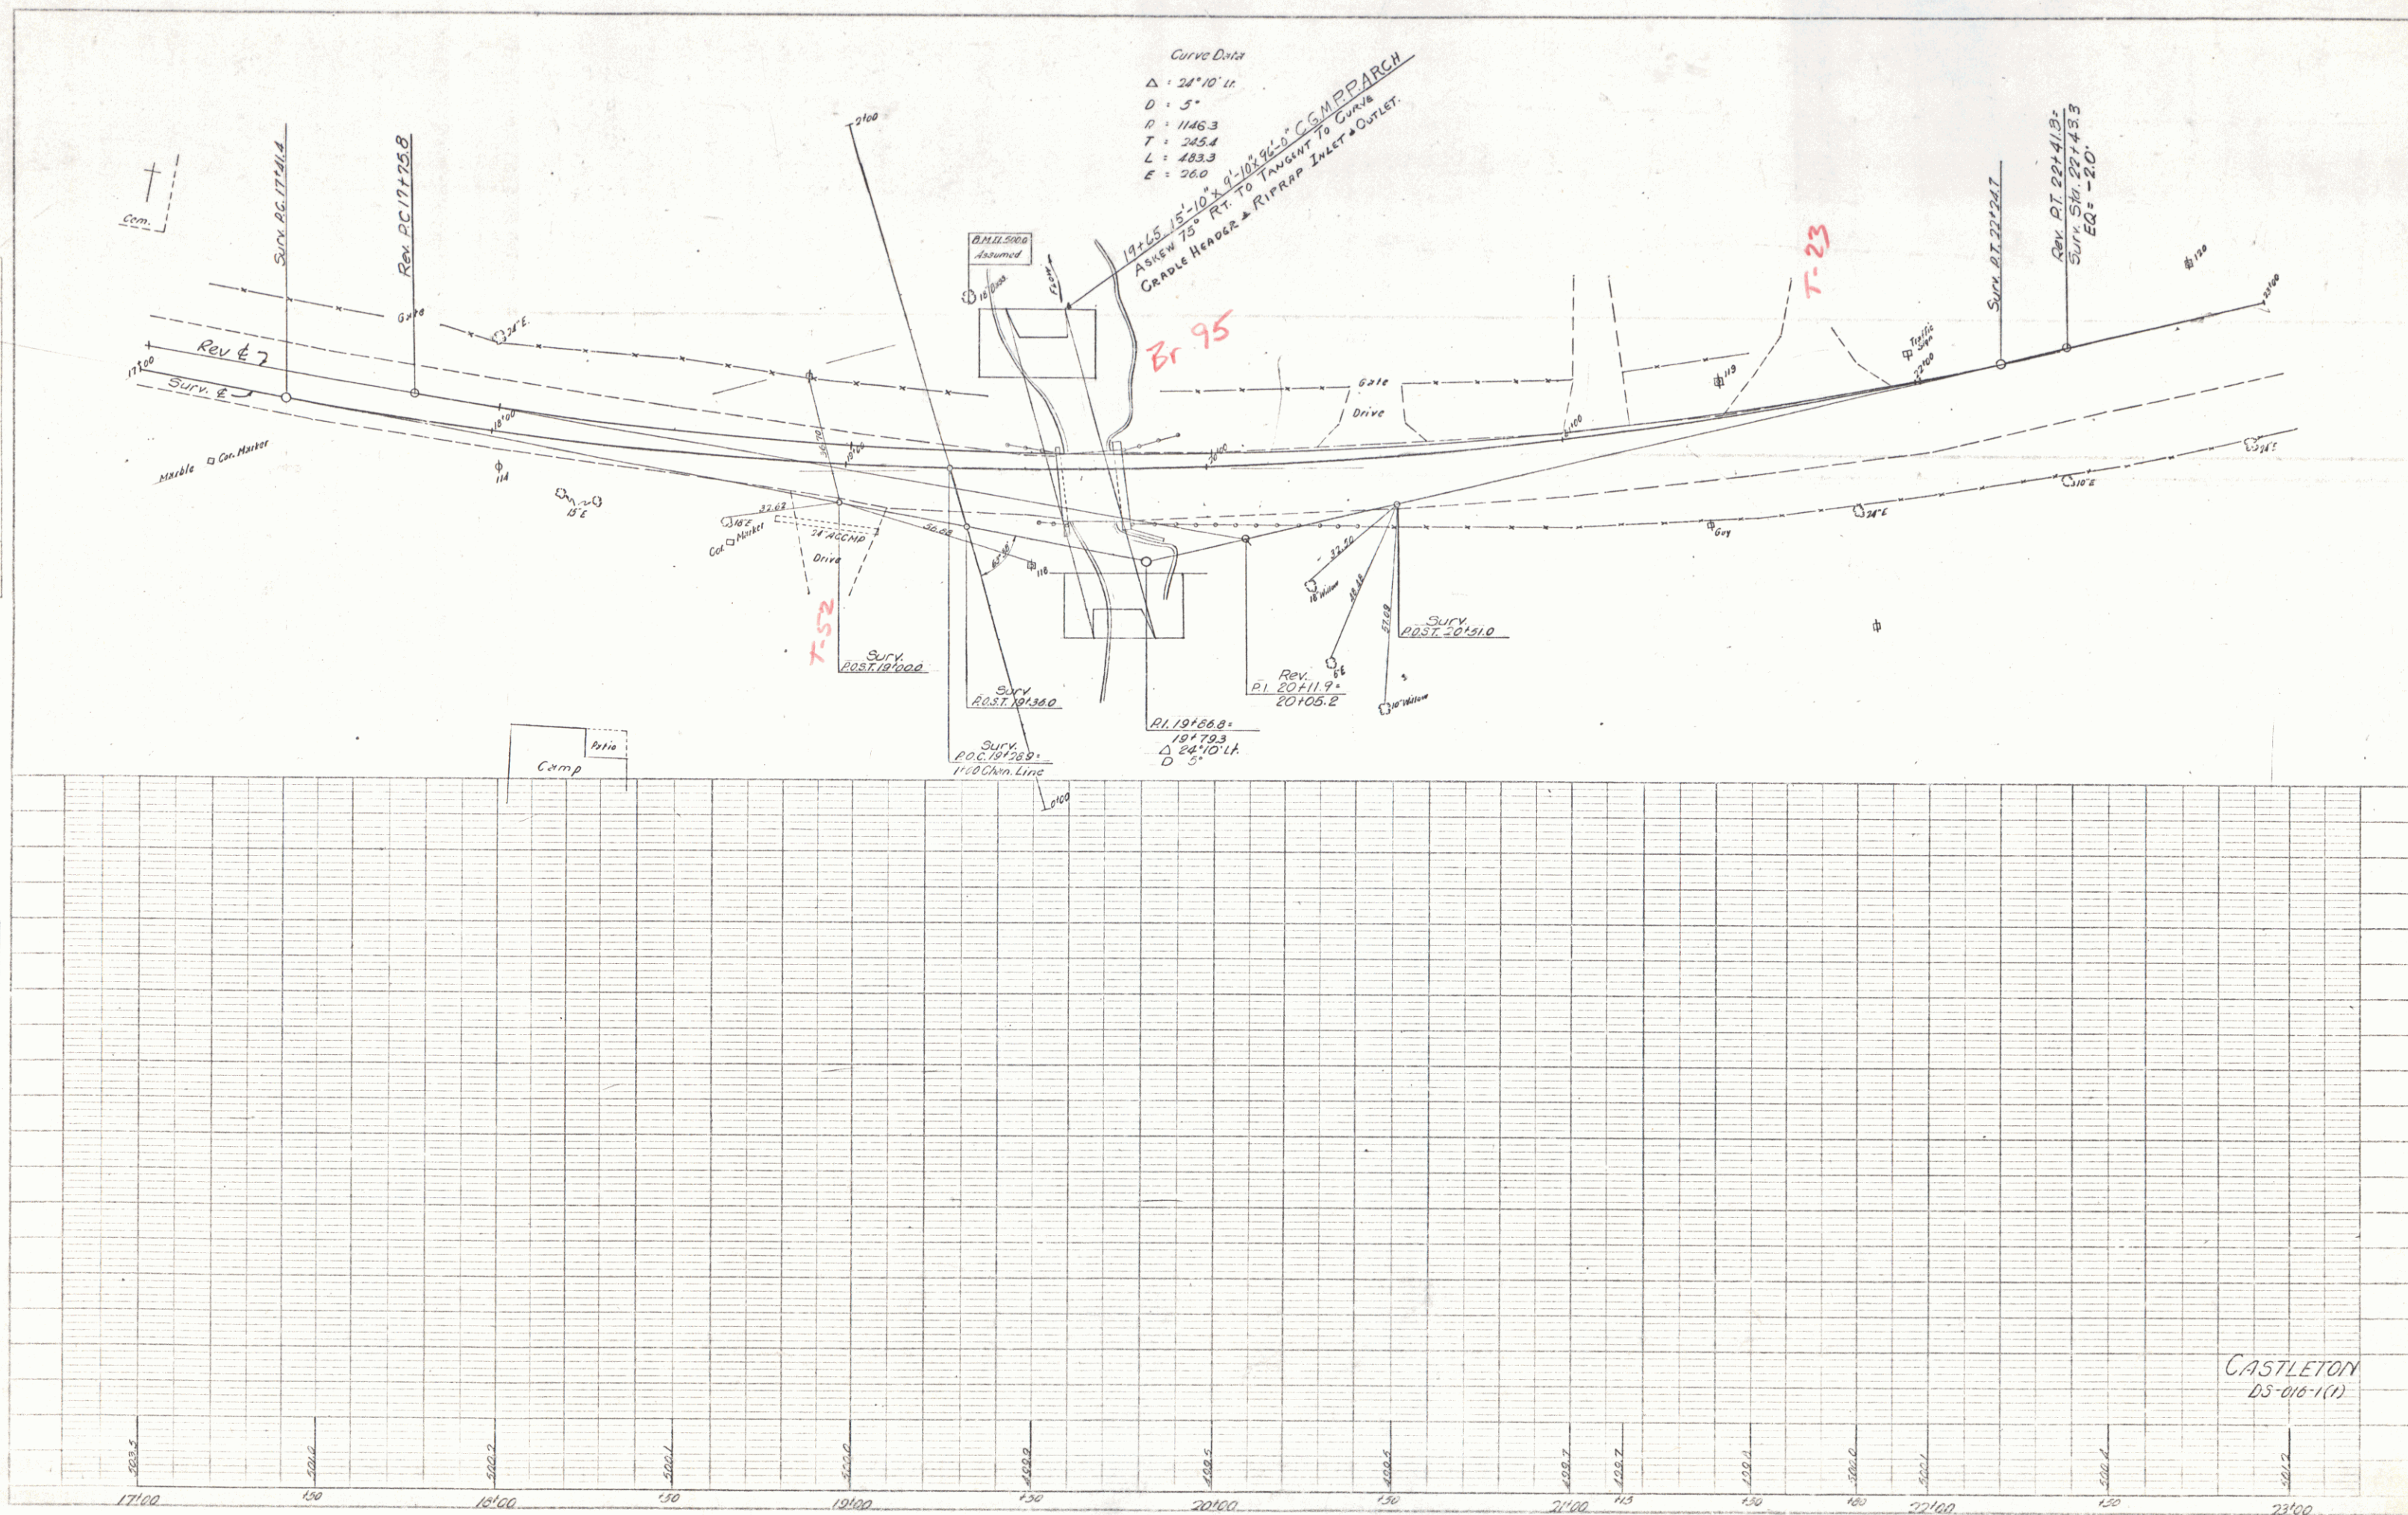

CASTLETON
 DS-016-1(1)

Sheet 15A