

VT 62

VT 62

INDEX OF SHEETS

1	TITLE SHEET	
2	QUANTITY SHEET	
3	PLAN AND PROFILE SHEETS	
4	PLAN AND PROFILE SHEETS	
STATE OF VERMONT
DEPARTMENT OF HIGHWAYS
Proposed Improvement



TOWN OF BERLIN
COUNTY OF WASHINGTON
ROUTE U.S. 302 SPUR
INTERSTATE ROUTE 89--U.S. ROUTE 302 ROAD

BEGINNING AT A POINT 2.259 MILES WESTERLY OF THE JUNCTION
OF BERLIN STATE HIGHWAY AND U.S. ROUTE 302 AND EXTENDING
EASTERLY 1.241 MILES.


LENGTH OF ROADWAY 6,550.00 FEET = 1.241 MILES
LENGTH OF PROJECT 6,550.00 FEET = 1.241 MILES

DHV (1970)	610
ADT (1970)	4060
ADT (1987)	7830
DHV (1987)	1175
D T V	51.5%
	7%
	50

Route: VT 62
Project F126-119
PIN: 00R398
Date: 03/28/1968

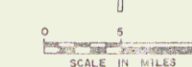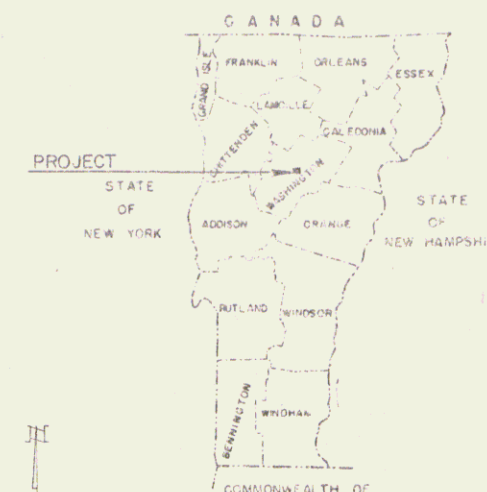

CONTRACTOR: *Collection's Sons & Gravel Co., Inc.*
SHEET: *1* OF *2*
DATE: *3/28/68*

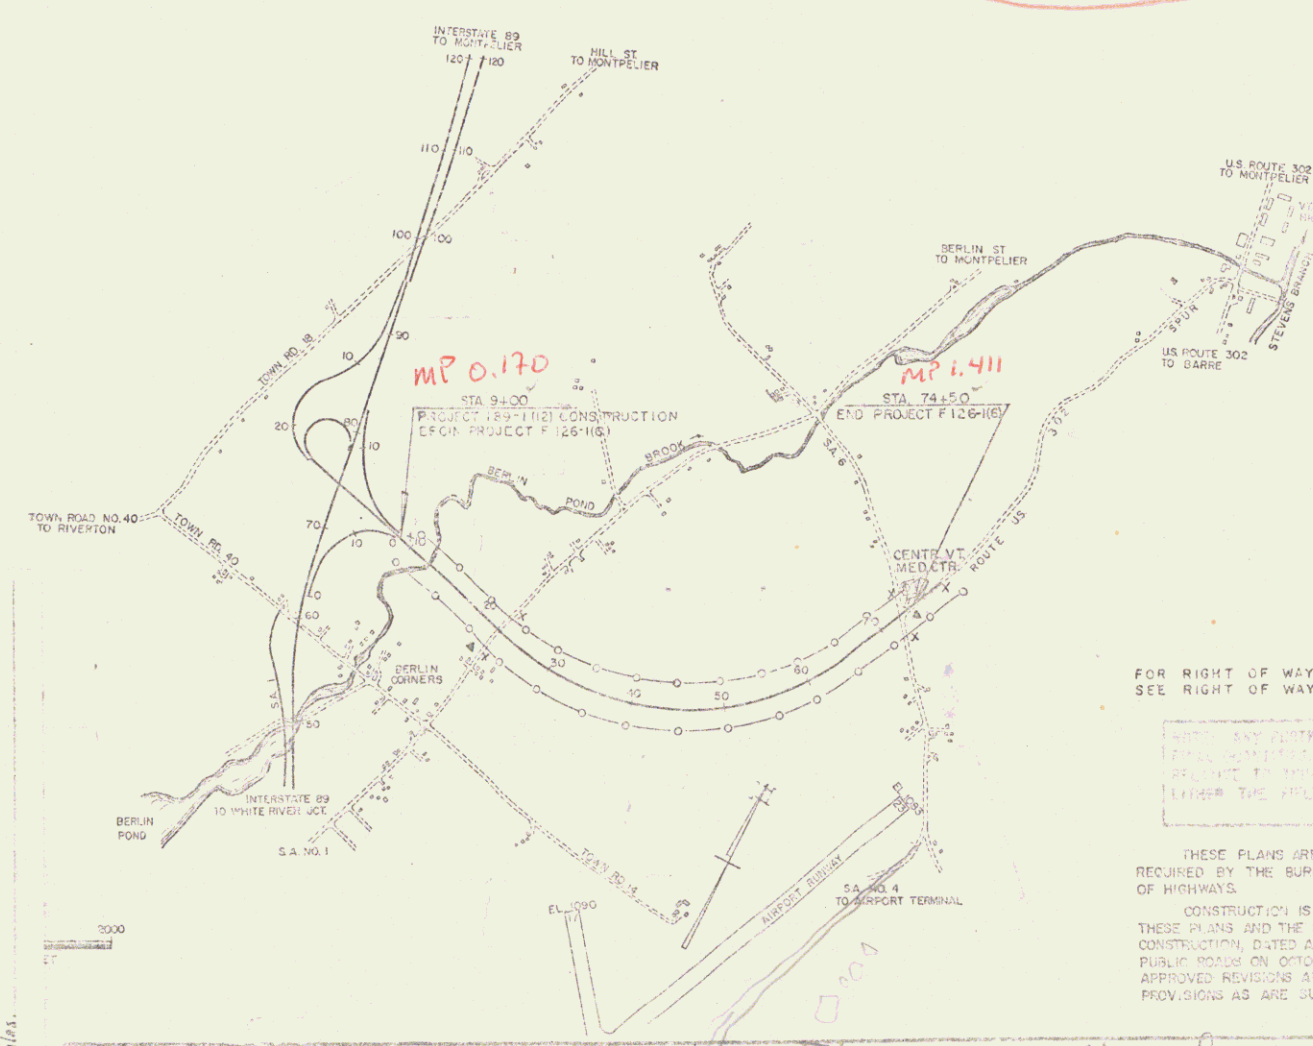

RIGHT-OF-WAY	---
TOPOGRAPHY	---
POINTS OF ACCESS	---
LIMITED ACCESS	---
COUNTY LINE	---
TOWN LINE	---
FENCE LINE	---
STONE WALL	---
UNFENCED PROPERTY	---
GUARD RAIL	---
TRAVELED WAY	---
RAILROAD	---
RETAINING WALL	---
CENTER LINE	---
SURVEY LINE	---
CULVERT	---
DRAIN INLET	---
WATER POLE	---
POWER POLE	---
TELEPHONE POLE	---
TRUSS	---
BRIDGE	---

CONSTRUCTION IDENTIFICATION SK	
GROUND ELEVATION	---
GRADE ELEVATION	---
CURVE DATA	
DEFLECTION OF ANGLE	---
DEGREE OF CURVE	---
RADIUS OF CURVE	---
TANGENT DISTANCE	---
LENGTH OF CURVE	---
EXTERNAL DISTANCE	---
POINT OF INTERSECTION	---
POINT OF CURVE	---
POINT OF TANGENT	---
POINT ON TANGENT	---
POINT ON CURVE	---

PROJECT: *BERLIN*
SHEET: *1* OF *2*
DATE: *3/28/68*

RIGHT-OF-WAY DIVISION
TOWN FILE

PERPETUAL
Town of *VT 62*
(To Be Returned To R.O.W. Division)

FOR RIGHT OF WAY DETAILS FOR THIS PROJECT
SEE RIGHT OF WAY PLANS FOR THIS PROJECT

THESE PLANS ARE SUBJECT TO SUCH REVISIONS AS MAY BE
REQUIRED BY THE BUREAU OF PUBLIC ROADS OR THE COMMISSIONER
OF HIGHWAYS.

DEPARTMENT OF TRANSPORTATION
BUREAU OF PUBLIC ROADS

APPROVED: <i>[Signature]</i> DATE: <i>3/28/68</i>	APPROVED: <i>[Signature]</i> DATE: <i>3/28/68</i>	APPROVED: <i>[Signature]</i> DATE: <i>3/28/68</i>	APPROVED: <i>[Signature]</i> DATE: <i>3/28/68</i>	APPROVED: <i>[Signature]</i> DATE: <i>3/28/68</i>	APPROVED: <i>[Signature]</i> DATE: <i>3/28/68</i>
--	--	--	--	--	--

PROJECT: *F 126-119*
SHEET: *1* OF *2*