


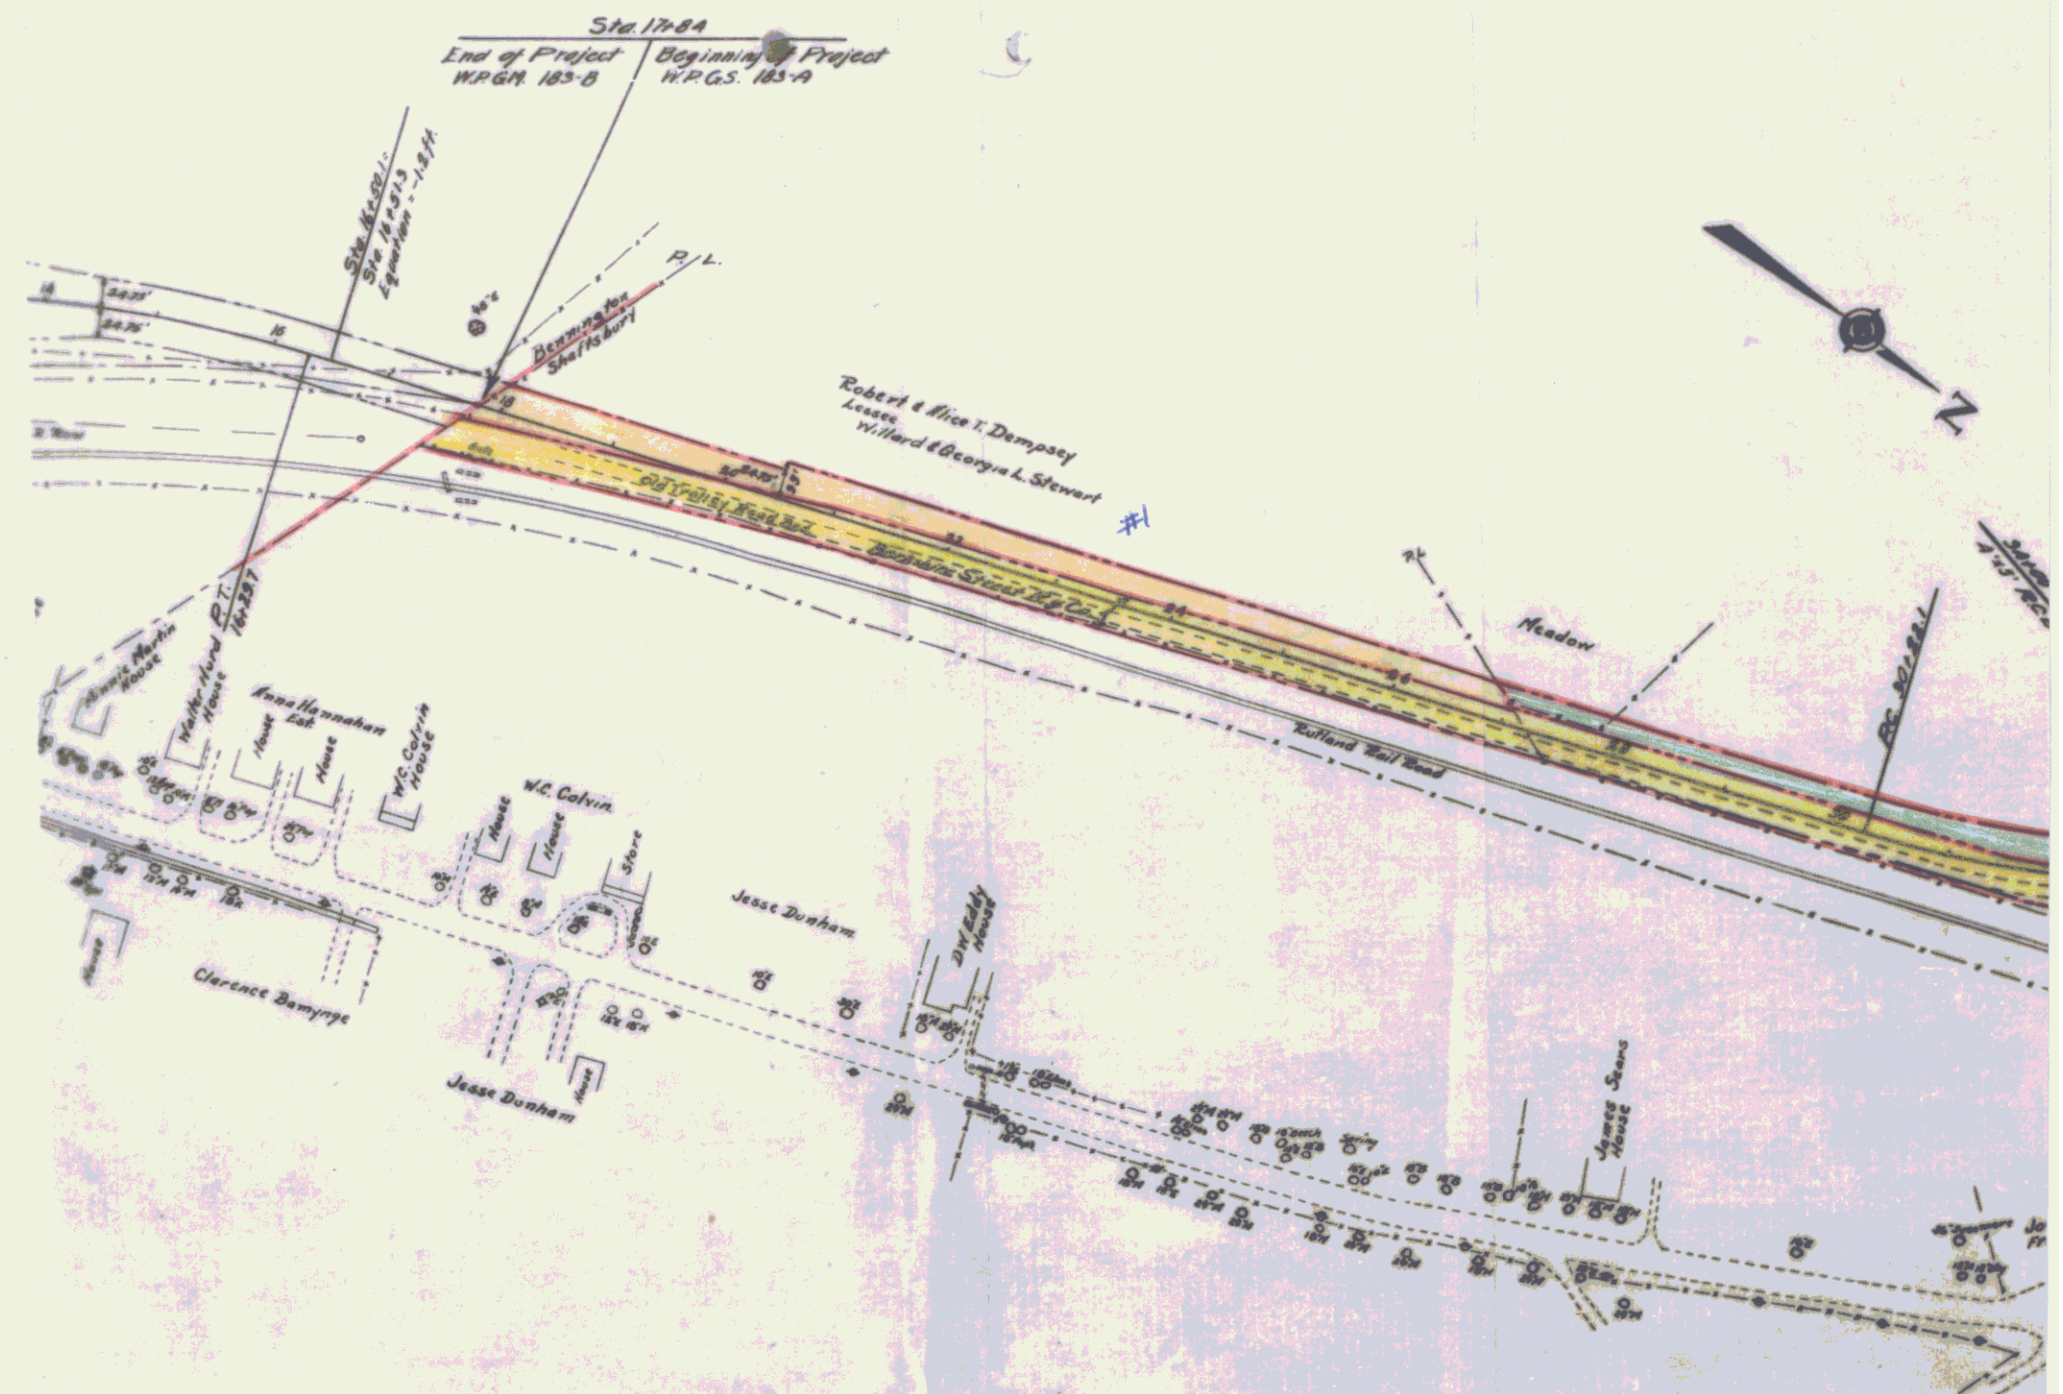

SHEET 5A