


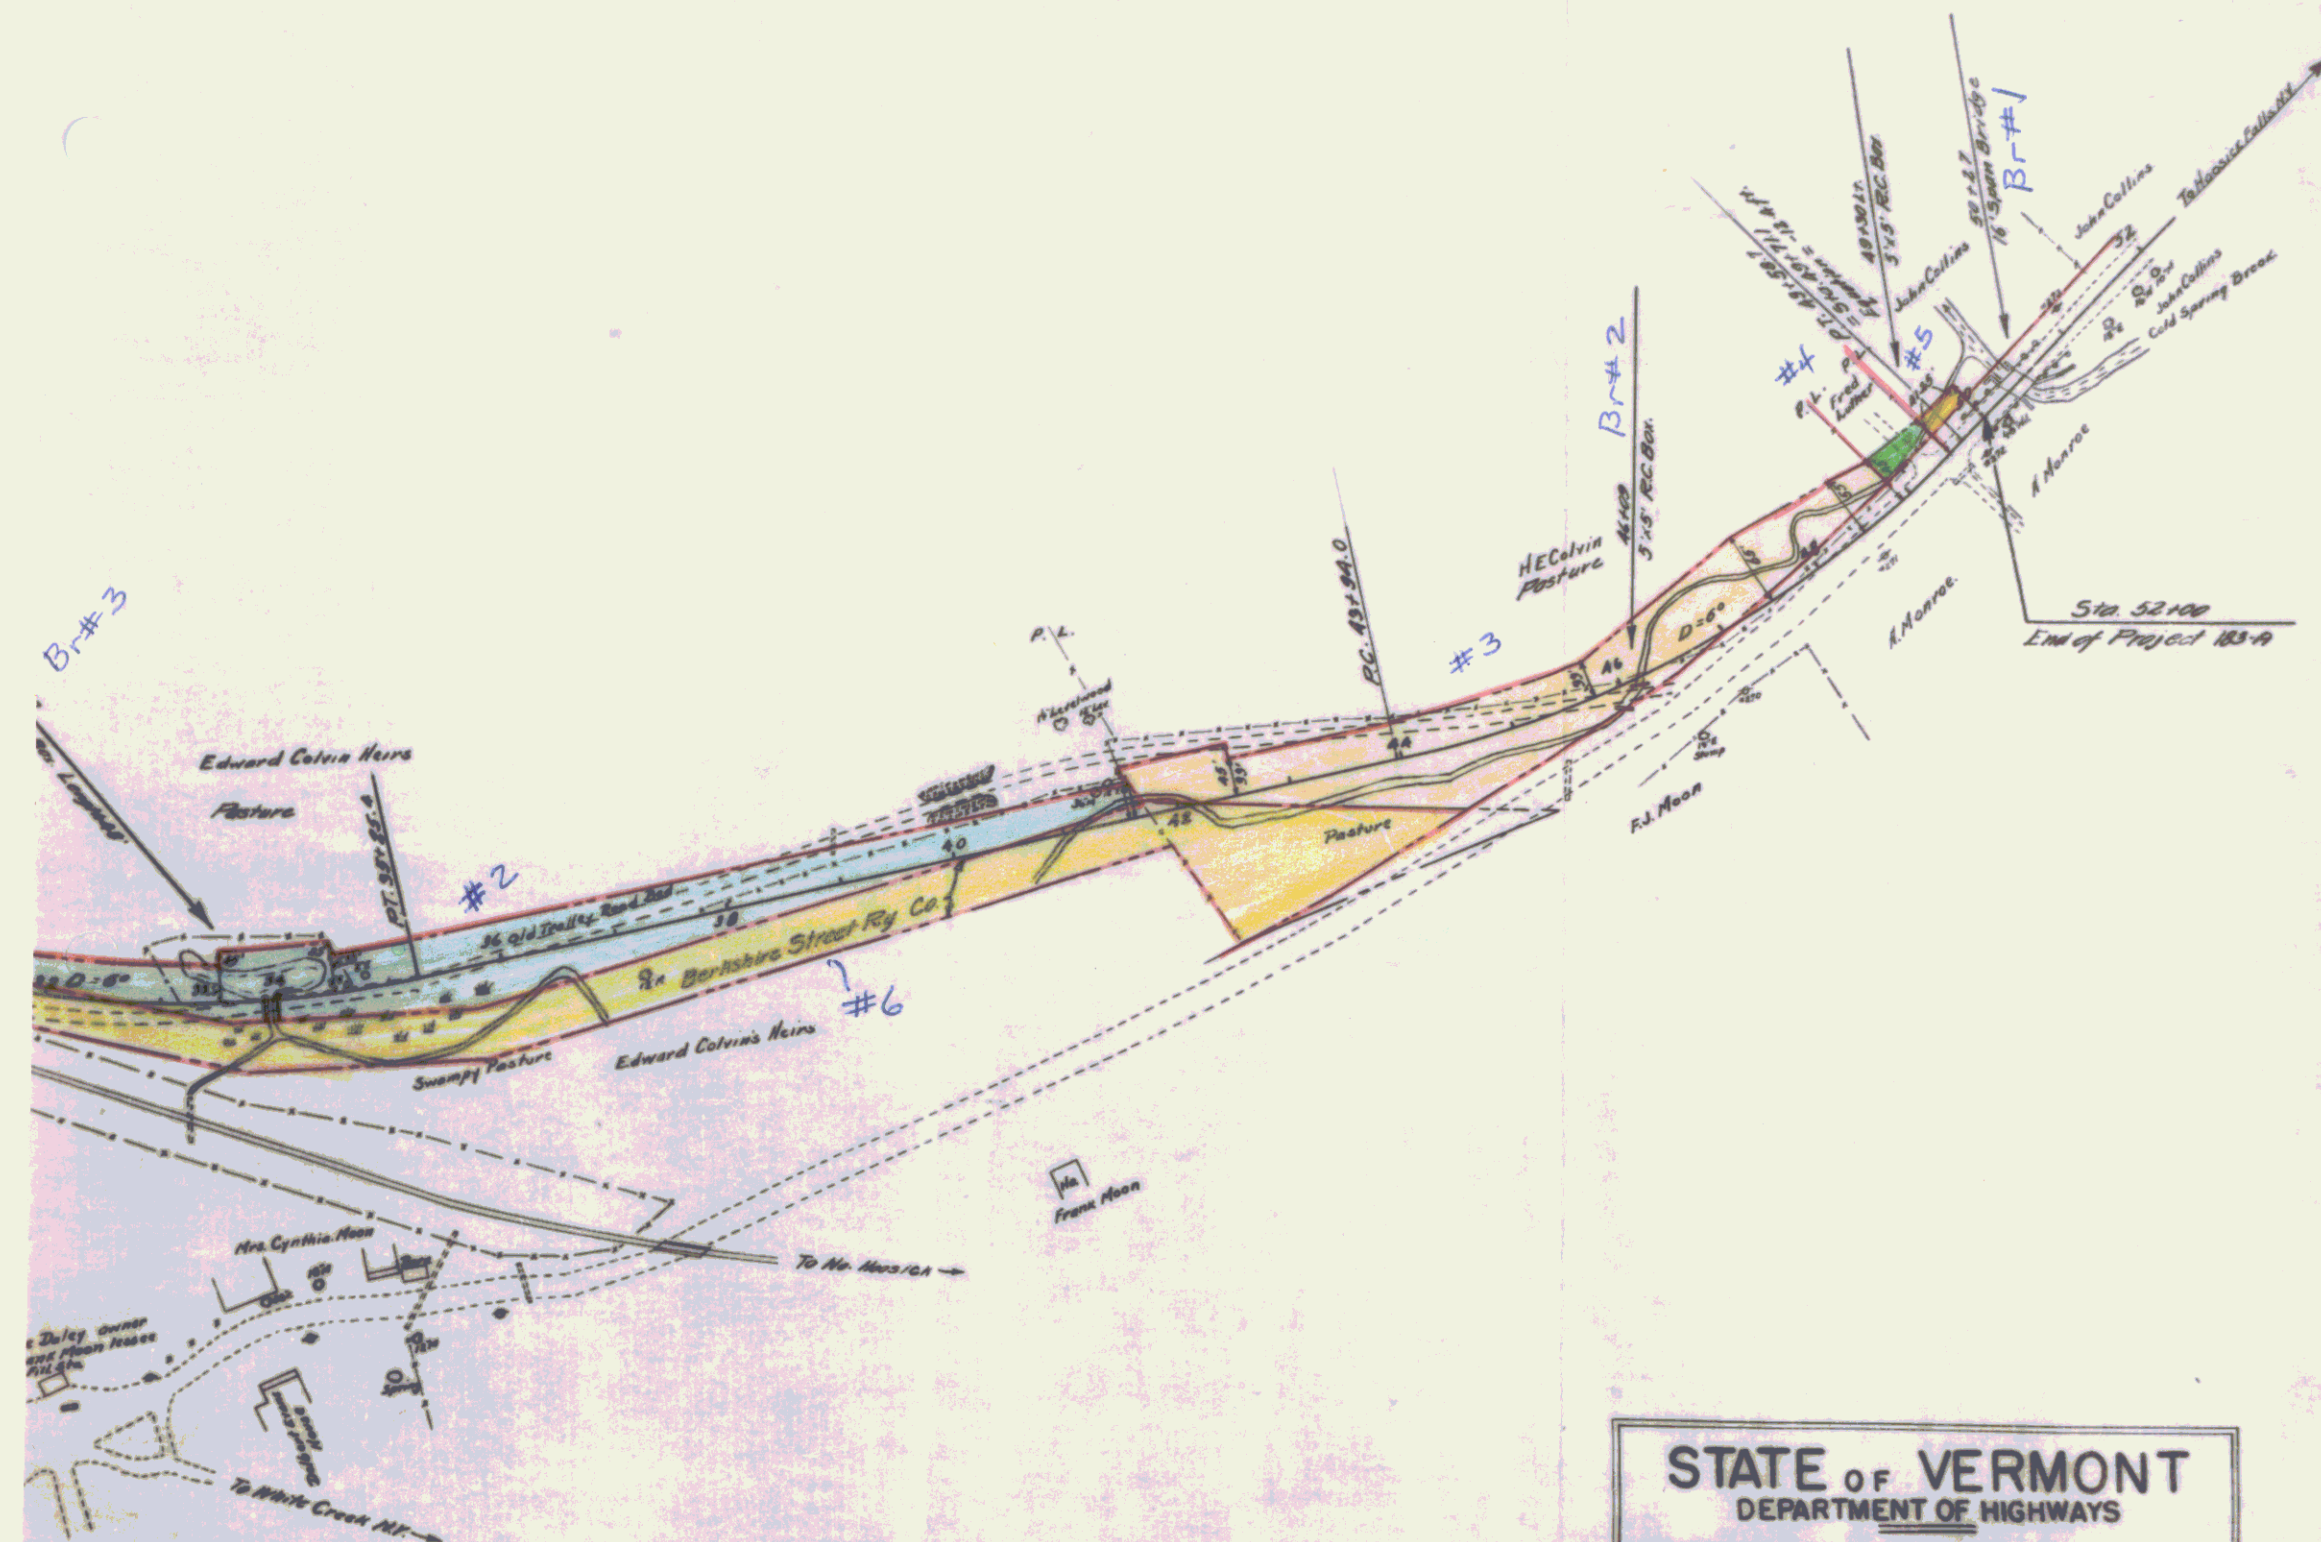

STATE OF VERMONT
 DEPARTMENT OF HIGHWAYS
 BENNINGTON-HOOSICK FALLS, N.Y. ROAD
 ROUTE 67A
 U.S. WORKS PROGRAM GRADE MUNICIPAL
 PROJECT-W.P.G.M.1838-A
 SKETCH MAP SHOWING ELIMINATION
 OF TWO GRADE CROSSINGS BY RELOC-
 ATION OF HIGHWAY IN TOWNS OF
 BENNINGTON & SHAFTSBURY
 SCALE 1" = 100'

SHEET 6A

6