


W Rte
67

GUARD RAIL

STA. TO STA.	SIDE LENGTH	ANCHORS
7+00	8+12	LT. 24
8+58	10+59	LT. 200
7+68	7+81	RT. 16
8+28	9+74	RT. 152
TOTAL ROADWAY		392

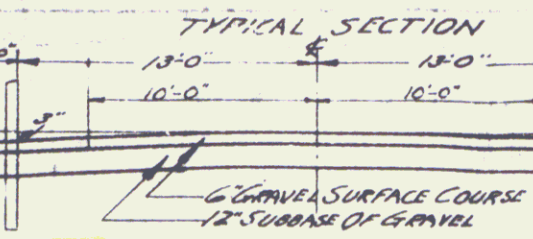

TOWN OF SHAFTSBURY
Project PWA 1020-3-FF
Pin # 00R405
Route VT67
Date 7/4/1939

STA. 6+50 BEGINNING OF PROJECT
PWA VT. DOCKET 1380-3-FF
MP 2.944

STA. 11+00 END OF PROJECT
PWA VT. DOCKET 1020-3-FF
MP 2.859

Parcel Instrument Date Grantor Grantor Recorded Remarks
A G.C.D. 1-20-39 Smith & Exton Harris 5/11/39 238 1-24-39 CH. 1182

BRIDGE DATA

	PRESENT	PROPOSED
TYPE	I-BM-WOOD FRAME	T-BEAM
SPANS	1 @ 17' CLEAR	1 @ 23' 0.0'
CLEAR HEIGHT	4'-0"	5'-3"
WATER WAY	16'-0"	30'-4"
LENGTH OVER RAIL	21'	43'
ROADWAY WIDTH	16'-5"	24'-4.5" W

LIST OF SHEETS

SHEET No.	DESCRIPTION
1	PLAN & PROFILE
2	ROUTING DETAILS
3	SUPERSTRUCTURE DETAILS
4	53 7/8" STANDARD BALUSTRADE RAIL
5	53 7/8" BALUSTRADE LIGHTS
6	53 7/8" BALUSTRADE DETAILS & L.L. GEN. NOTES
7	5 3/8" CABLE GUARD RAIL
8-10	CROSS SECTIONS


QUANTITIES

ITEM NO.	DESCRIPTION	QUANTITY
10 1/2	COMMON EXCAV. INCL. BORROW	600 CY
15	CHANNEL EXCAV.	1100 CY
16	STRUCTURE EXCAV.	175 CY
18	MAINTENANCE OF TRAFFIC	1 L.S.
19	SUB-BASE OF GRAVEL	660 CY
22	GRAVEL SURFACE COURSE	200 CY
41 A	CONCRETE CLASS "A"	115 CY
42	REINFORCING STEEL	27125 LBS
36	TEMPORARY BRIDGES	1 L.S.
37	REMOVAL OF PRESENT SUPERSTRUC.	1 L.S.
43	BALUSTRADE RAIL	53 7/8" L.S.
44 A	HEAVY STONE FILL	4 1/2 CY
80 A	CABLE GUARD RAIL	53 7/8" L.S.
80 B	ANCHORS FOR CABLE GUARD RAIL	5 EA

RIGHT-OF-WAY
TOWN OF SHAFTSBURY
(To Be Returned)
MM2

RECOMMENDED
APPROVED
CHIEF ENGINEER

CONSTRUCT SATISFACTORY
SHEET 1
Original
APPROVED: 1938

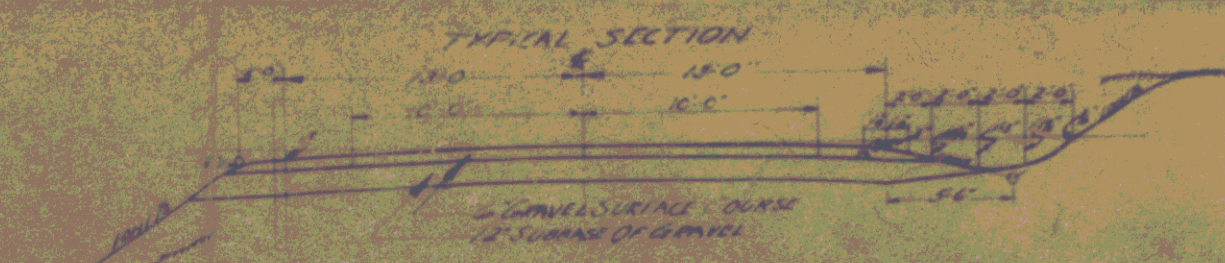

Parcel	Instrument	Date	Grantor	Grantee	Recorded	Remarks
					Shofsbury	

[illegible]

QUANTITIES	
1	680 CY
2	7100 CY
3	173 CY
4	1 LS
5	460 CY
6	200 CY
7	119 CY
8	2725 LBS
9	1 LS
10	1 LS
11	84 LF
12	440 CY
13	392 LF
14	4 LF



RECOMMENDED [REDACTED]
[REDACTED]
DISTRICT ENGINEER
BUREAU OF PUBLIC WORKS
RECOMMENDED FOR APPROVAL [REDACTED]
[REDACTED]
CHIEF ENGINEER
BUREAU OF PUBLIC WORKS
APPROVED [REDACTED]
[REDACTED]
BUREAU OF PUBLIC WORKS

APPROVED _____ 938
DISTRICT HIGHWAY COMMISSIONER
CORRECT
W. T. Duff
BRIDGE ENGINEER
APPROVED _____ 938
H. E. Lantz
COMMISSIONER OF HIGHWAYS

SHEET 1A

